


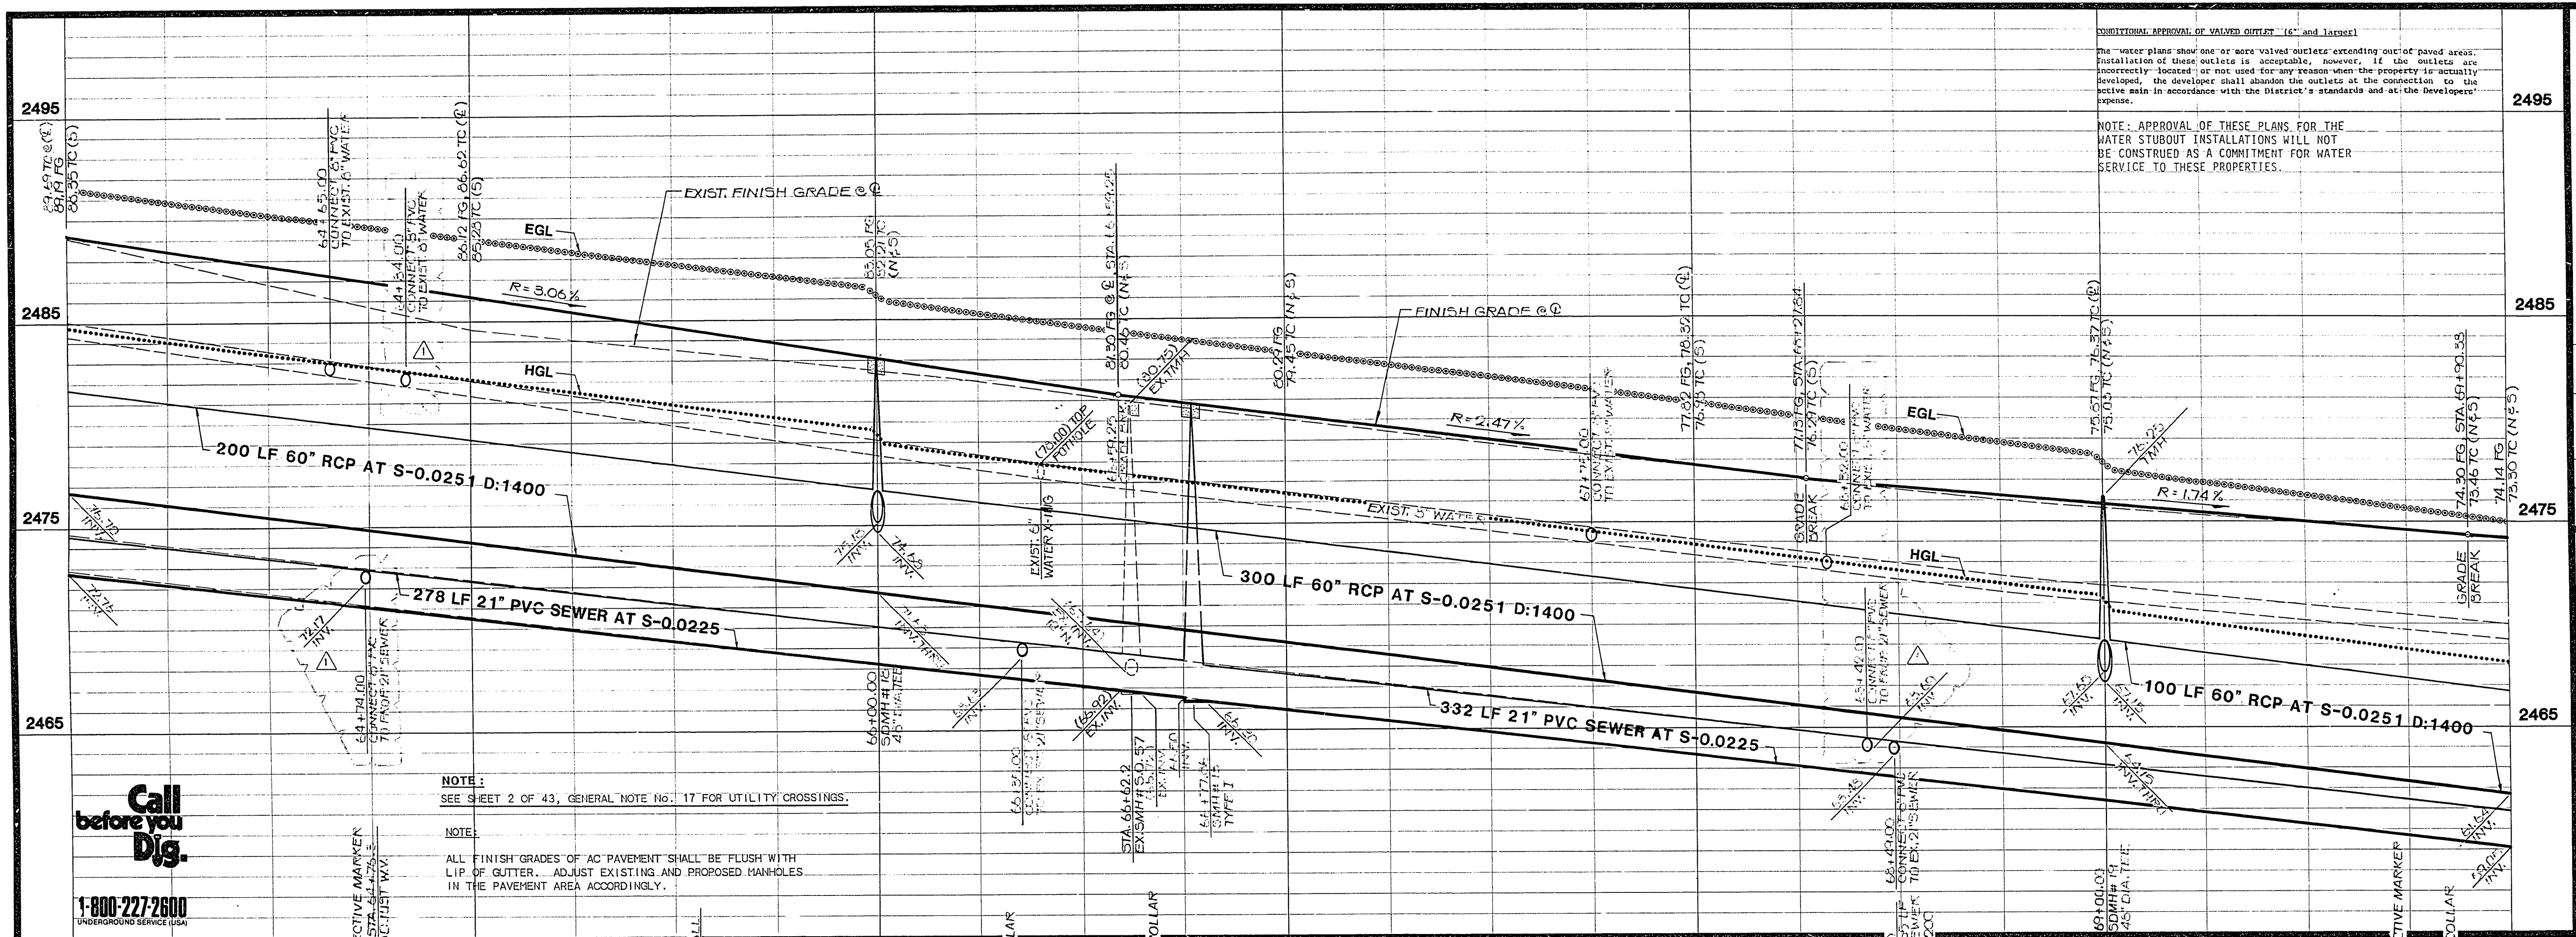

REVISION


NO.	DATE	BY	REVISION
1	05-05-93	DW	ADD SEW. & WATER L&S, REV. PROPERTY OWNER NAME & ADDRESS





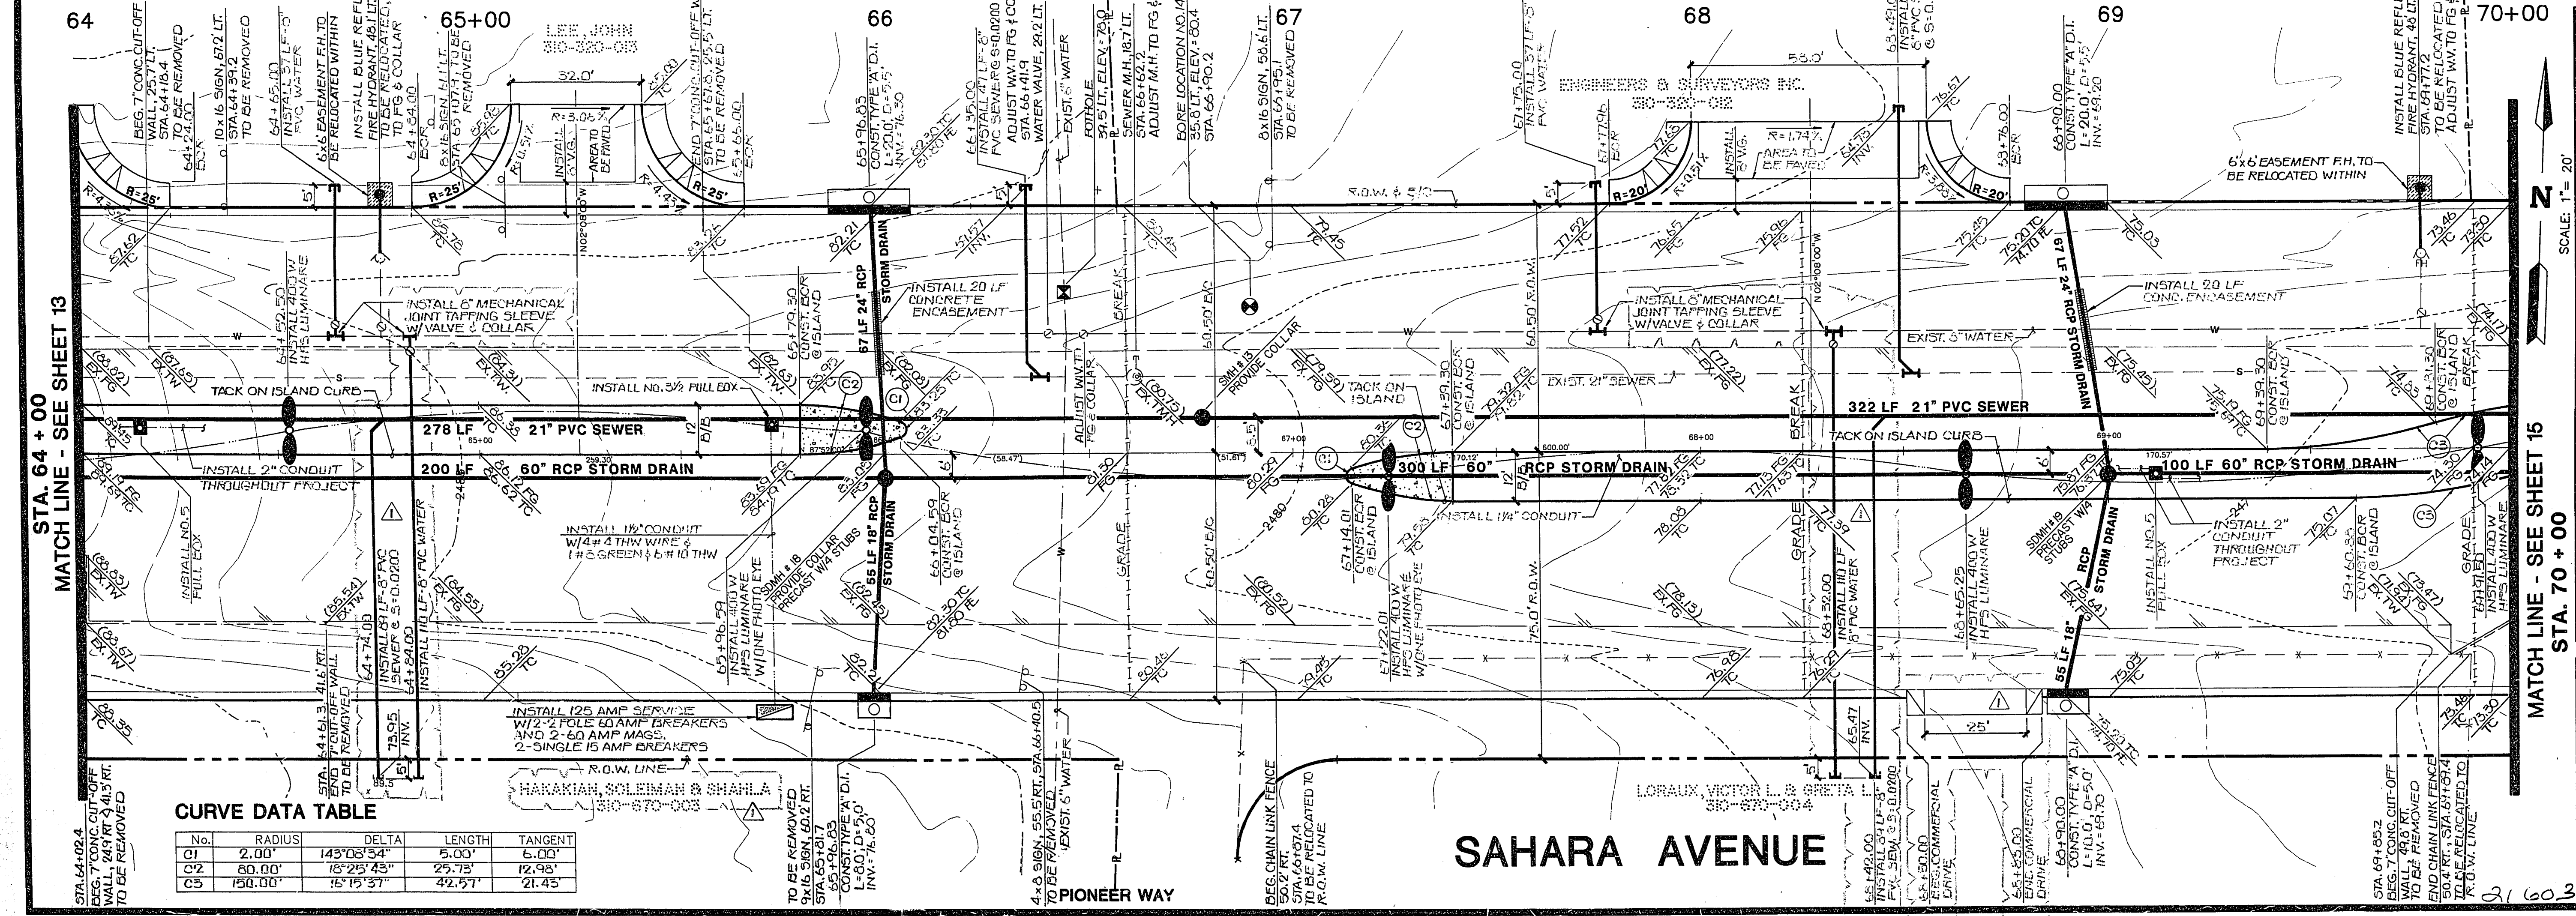

STA. 64 + 00 MATCH LINE - SEE SHEET 13

STA. 70 + 00 MATCH LINE - SEE SHEET 15

SCALE: 1" = 20'

STREET & SEWER PLAN & PROFILE

(STA. 64+00 TO STA. 70+00)

PROJECT: S.D. 1427 - SAHARA AVENUE (DURANGO DRIVE TO RAINBOW BOULEVARD)

W.O. #: 130-9520

BY: CHAO/BLOOM

DATE: 5/91

SCALE: HORIZ. 1" = 4' VERT. 1" = 20'

C.L.V. DRAWING NO. 14/43

107-V-2036