5-2-73

125609

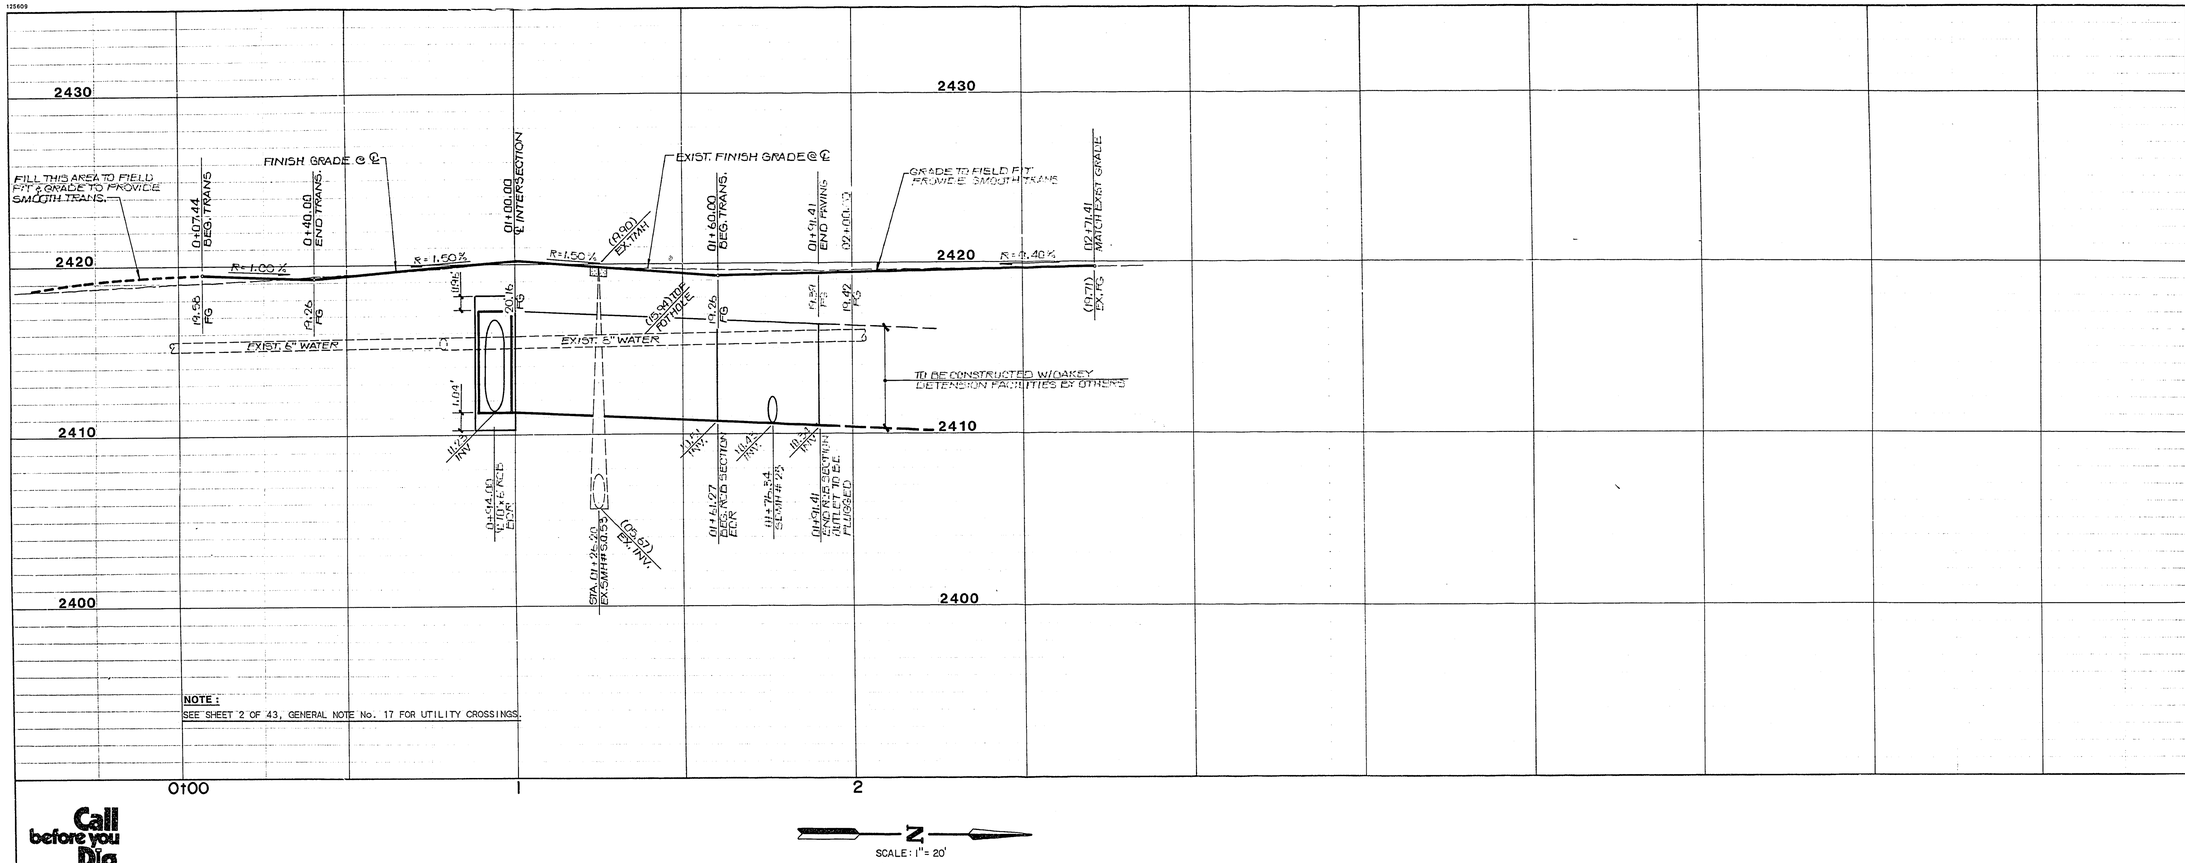

NOTE:
SEE SHEET 2 OF 43, GENERAL NOTE No. 17 FOR UTILITY CROSSINGS.

Call before you Dig.
1-800-227-2600
(UNDERGROUND SERVICE ALERT)

SCALE: 1" = 20'

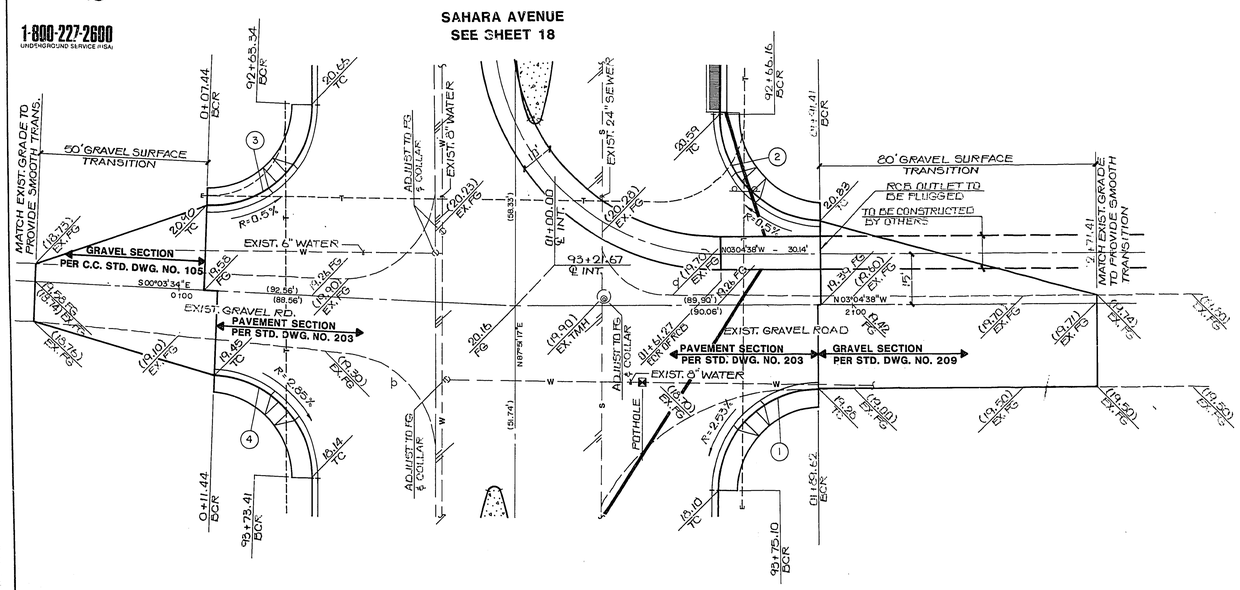

MONTESSOURI STREET

CURVE DATA TABLE

No.	RADIUS	DELTA	LENGTH	TANGENT
1	30.00'	89°04'05"	46.63'	29.52'
2	30.00'	90°55'55"	47.61'	30.49'
3	30.00'	92°05'09"	48.22'	31.11'
4	30.00'	87°54'51"	46.03'	28.93'

REV	DATE	BY	REVISION

ESI ENGINEERS & SURVEYORS INC.
7018 W. Charleston Blvd. Las Vegas, Nevada 89117 (702) 363-6415
LICENSED PROFESSIONAL ENGINEER STATE OF NEVADA
ZONGHI
No. 9230
6/23/92
SUBMITTED BY:

TITLE: INTERSECTION PLAN & PROFILE
(MONTESSOURI STREET & PIONEER WAY)

PROJECT: S.I.D. 1427 - SAHARA AVENUE
(DURANGO DRIVE TO RAINBOW BOULEVARD)

WO NO.	130-9520
BY	BLOOM
DATE	9/91
SCALE	VERT.: 1" = 4' HORIZ.: 1" = 20'

C.L.V. DRAWING NO. 107-V-2036

28/43

21 603

"As Built" 107-V2036