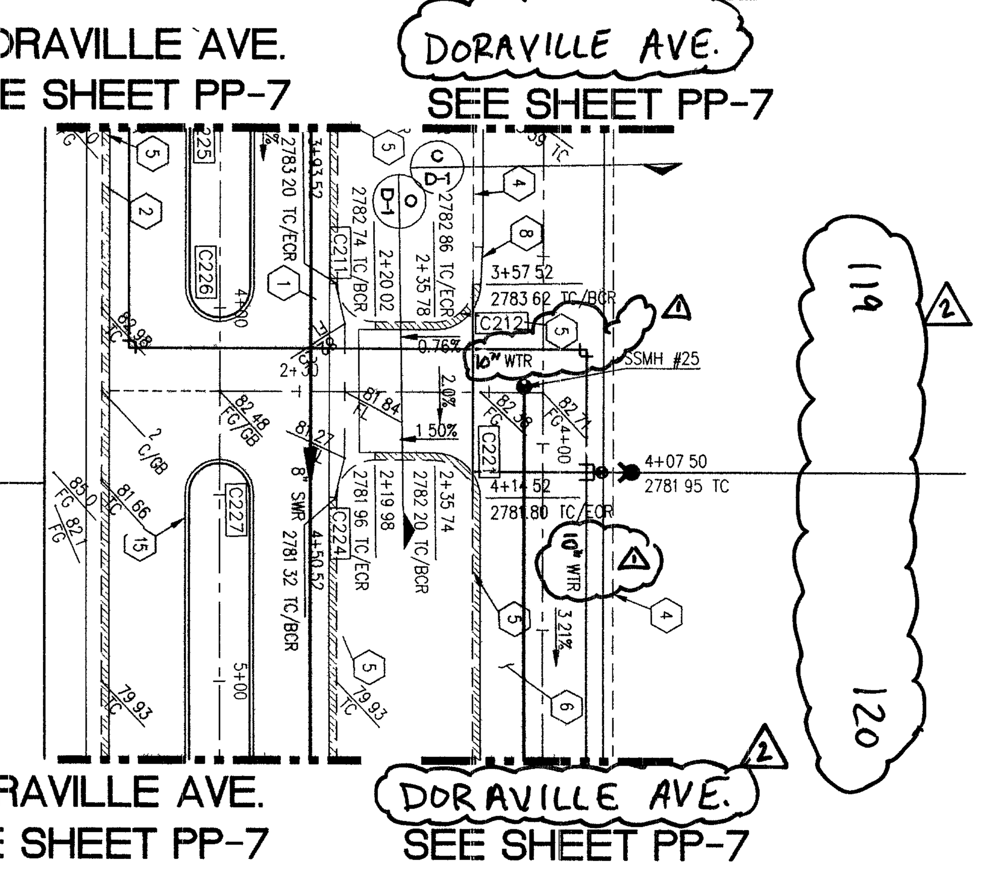

DORAVILLE AVE. PLAN

(37' PRIVATE ROADWAY ESMT, P U E & CLV PUBLIC SEWER ESMT)

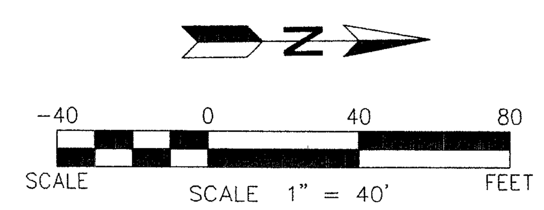

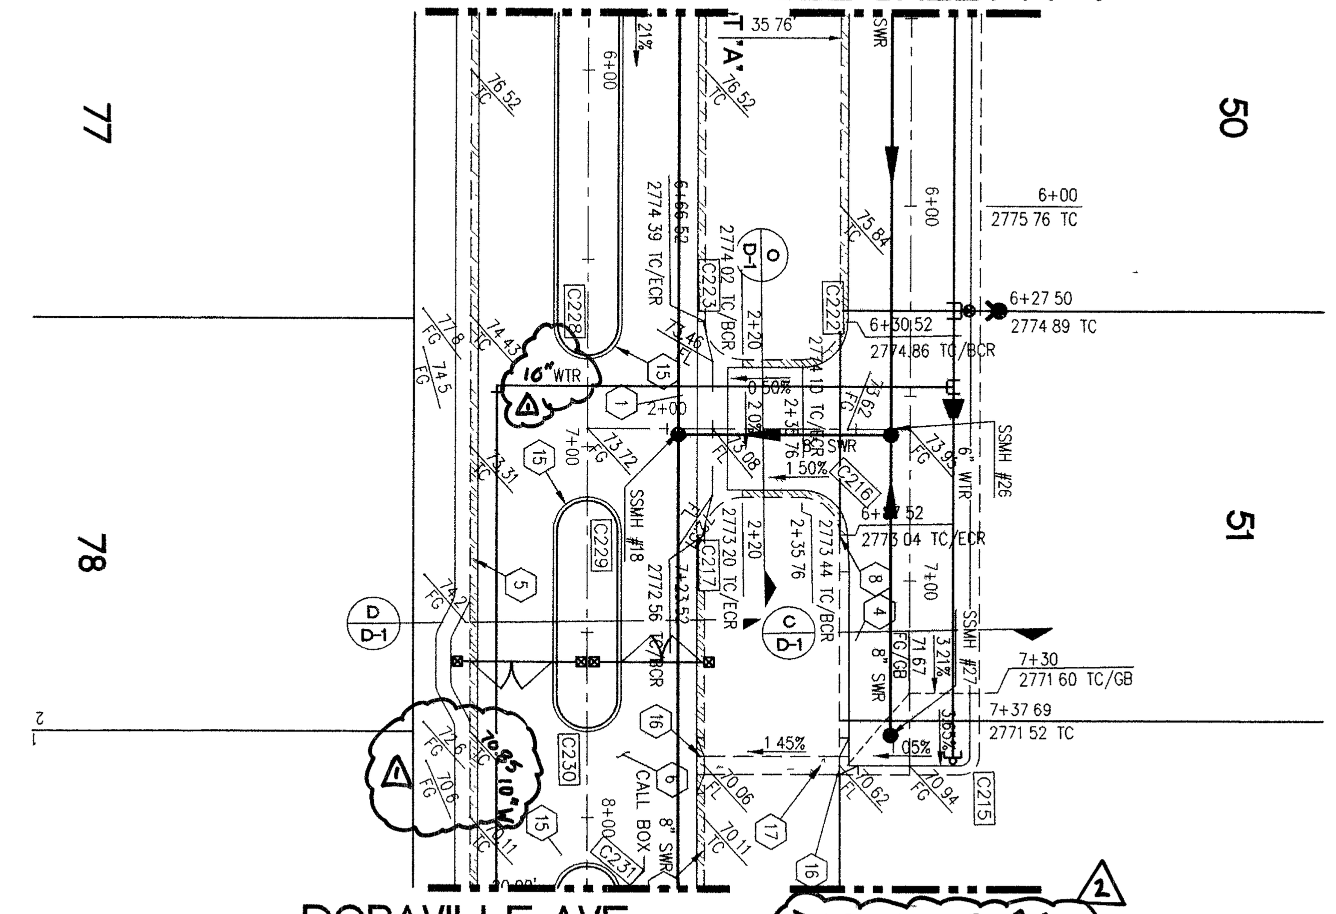

DORAVILLE AVE. PLAN

(37' PRIVATE ROADWAY ESMT, P U E & CLV PUBLIC SEWER ESMT)

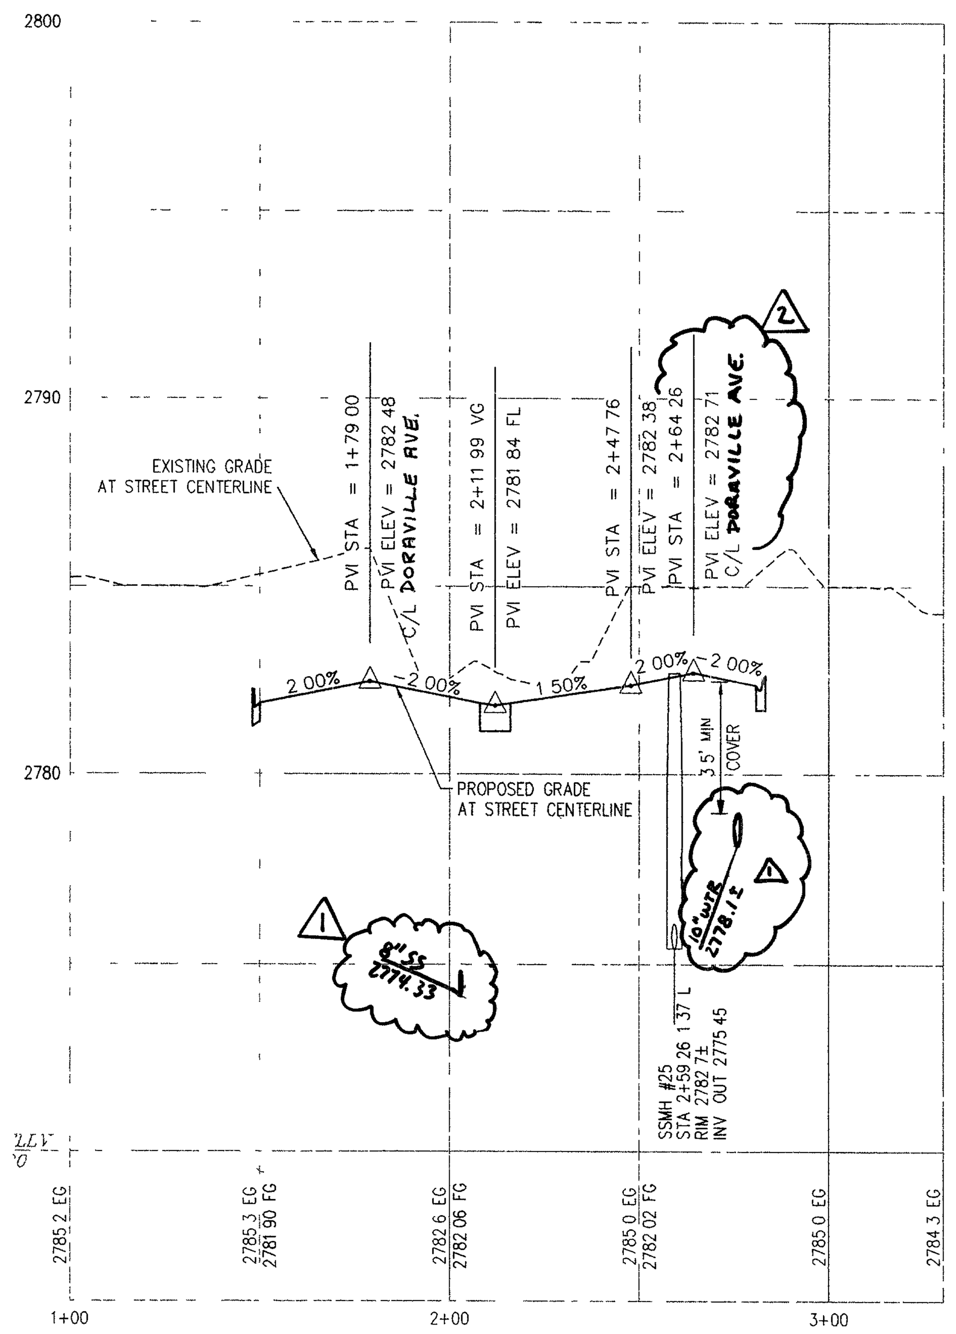

PROFILE

HOR . 1"=40'
VERT : 1"=4'

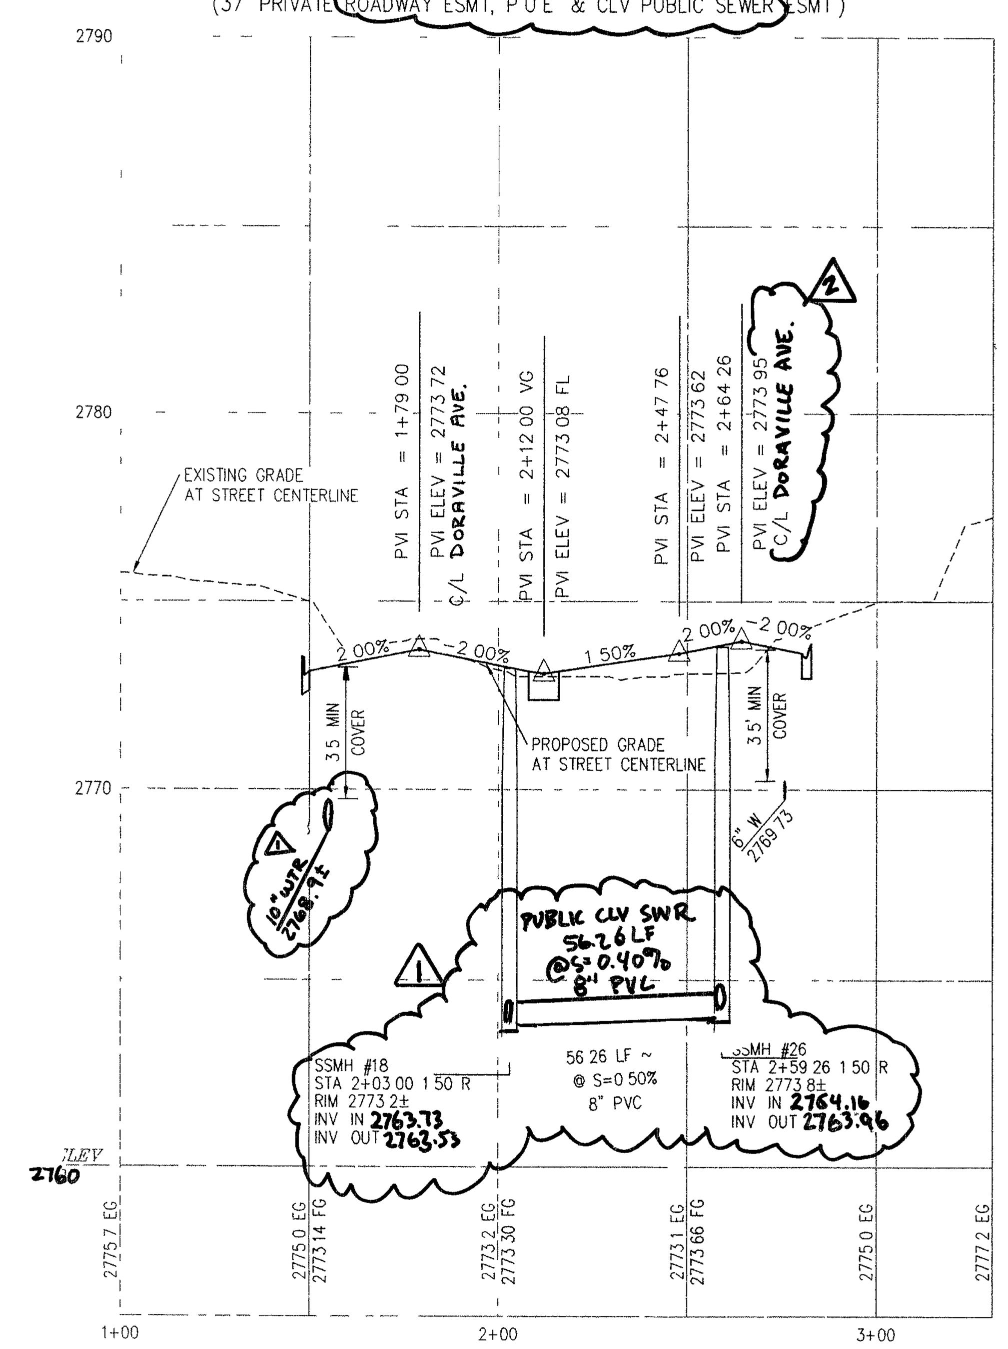

PROFILE

HOR 1"=40'
VERT : 1"=4'

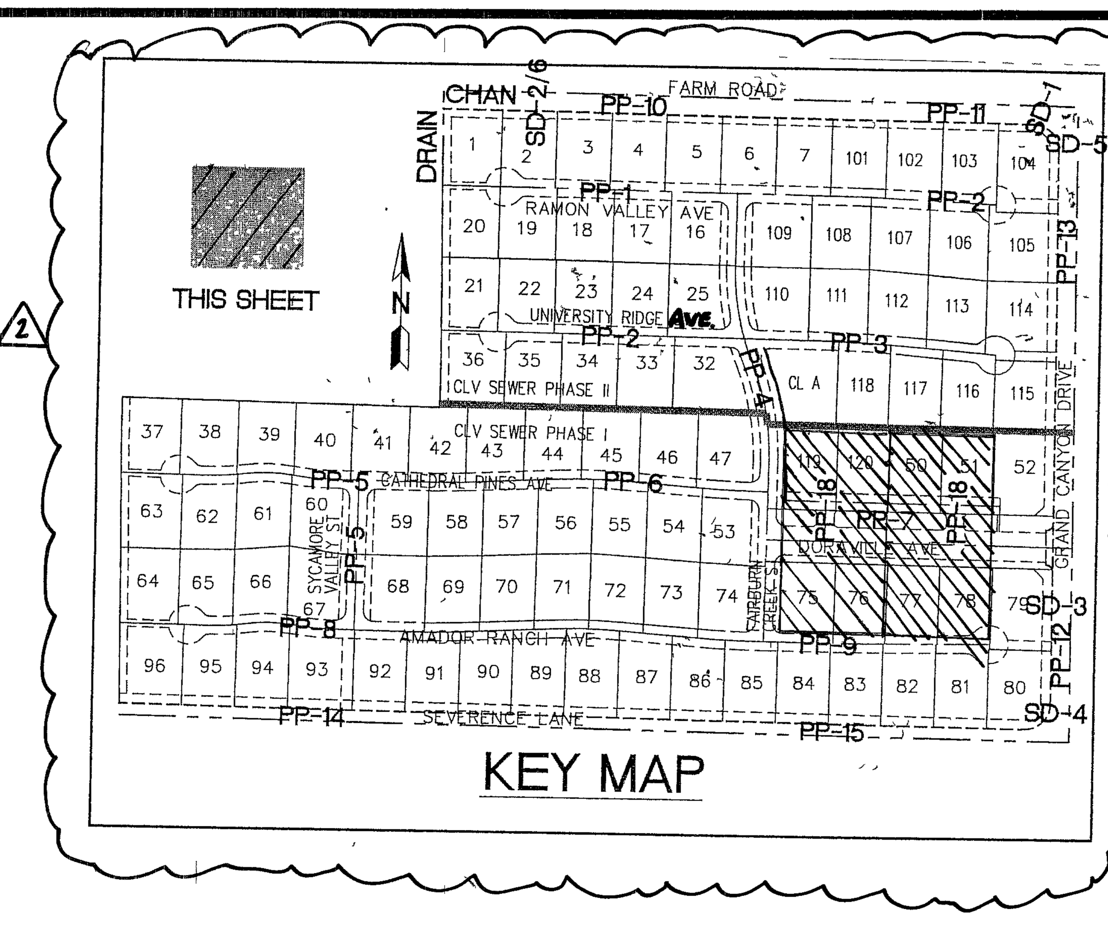

KEY MAP

CONSTRUCTION NOTES

1	CONSTRUCT 8' WIDE CROSS GUTTER PER DETAIL CCAUSD #228 (SEE DETAIL ON SHEET D-2)
2	CONSTRUCT 4' WIDE BY 4" THICK SIDEWALK PER CCAUSD #234
3	CONSTRUCT SIDEWALK RAMPS USING ARMOR TILE TRUNCATED DOMES OR EQUIVALENT PER CCAUSD #235, CASE I
4	CONSTRUCT ROLL CURB PER DETAIL CCAUSD #2 7A
5	CONSTRUCT "L" TYPE CURB PER CCAUSD #216
6	CONSTRUCT 2" AC ON 4" TYPE II A B ON 6" TYPE I OR NATIVE, SEE SECTION "C", SHEET D-1
7	SAWCUT, REMOVE AND REPLACE EXISTING PAVEMENT PER PROP STREET SECTION
8	CONSTRUCT 10' TRANSITION FROM ROLL CURB TO "L" CURB SEE DETAIL "X", SHEET D-2
9	CONSTRUCT 5' WIDE BY 4" THICK SIDEWALK PER CCAUSD #234
10	CONTRACTOR TO VERIFY ELEV OF EXIST CURB AND GUTTER, PVMT, STORM DRAIN, RETAINING WALL ELEVATIONS, AND SDWK PRIOR TO CONST NOTIFY ENGINEER OF ANY CONFLICTS
14	CONST SIDEWALK UNDERDRAIN PER CCAUSD NO 236
15	CONST "A" TYPE MEDIAN CURB PER CCAUSD #219
16	CONST DEPRESSED CURB PER CCAUSD #227
17	CONST BLOCK WALL OPENING PER SECTION "C", SHEET D-4
18	CONST 4" AC ON 4" TYPE II A B ON 9" TYPE I SEE SECTION "A", SHEET D-1
19	CONST 4" AC ON 4" TYPE II A B ON 9" TYPE I SEE SECTION "G", SHEET D-3
20	CONST 4" AC ON 4" TYPE II A B ON 9" TYPE I SEE SECTION "E", SHEET D-1
21	CONST 3" AC ON 9" TYPE II A B, SEE SECTION "B", SHEET D-1
22	CONST 3" AC ON 9" TYPE II A B, SEE SECTION "B", SHEET D-3
23	CONSTRUCT CONC CUTOFF WALL PER SECTION "C", SHEET D-3
24	CONCRETE ENCASEMENT PER UDACS SEC 2 19
25	CONST BLOCK WALL OPENING PER DETAIL "D" ON SHT D-6

BACK OF CURB CURVE TABLE

CURVE	LENGTH	RADIUS	DELTA	TANGENT
C211	15 71	10 00	90°00'00"	10 00
C212	15 71	10 00	90°00'00"	10 00
C215	7 85	5 00	90°00'00"	5 00
C216	15 71	10 00	90°00'00"	10 00
C217	15 71	10 00	90°00'00"	10 00
C221	15 71	10 00	90°00'00"	10 00
C222	15 71	10 00	90°00'00"	10 00
C223	15 71	10 00	90°00'00"	10 00
C224	15 71	10 00	90°00'00"	10 00
C225	25 13	8 00	180°00'00"	–
C226	25 13	8 00	180°00'00"	–
C227	25 13	8 00	180°00'00"	–
C228	25 13	8 00	180°00'00"	–
C229	25 13	8 00	180°00'00"	–
C230	25 13	8 00	180°00'00"	–
C231	25 13	8 00	180°00'00"	–

EASEMENT NOTES

1. 37' DRAINAGE EASEMENT, LVVWD WATER EASEMENT, PUBLIC UTILITY EASEMENT (TO BE MAINTAINED BY H O A) AND CLV PUBLIC SEWER EASEMENT

DENOTES AREA TO BE COVERED BY (1) EASEMENT CALLOUT

2. 20' DRAINAGE EASEMENT (TO BE MAINTAINED BY H O A) AND CLV PUBLIC SEWER EASEMENT
3. DRAINAGE EASEMENT TO BE PRIVATELY MAINTAINED BY H O A (SEE DIMENSION ON PLAN FOR EASEMENT WIDTH)

BENCHMARK

BENCHMARK FOUND CITY OF LAS VEGAS RIVET AND ROUND PLATE IN CONCRETE CYLINDER, SOUTHEAST CORNER OF ELKHORN RD AND CONQUISTADOR ST

BM NO 66 STATION 8LV90 19NNW6 ELEVATION = 2803 77 (NAVD 88)

BASIS OF BEARING

THE BASIS OF BEARINGS FOR THIS SURVEY IS BASED ON THE FOUND AND HELD MONUMENTS MARKING THE SOUTHERLY LINE OF THE SOUTHWEST QUARTER (SW1/4) OF THE SOUTHEAST QUARTER (SE1/4) OF SECTION 13, T19S, R60E, MDM, CLARK COUNTY, NEVADA PER RECORD OF SURVEY BOOK 123, PAGE 32, CLARK COUNTY RECORDER'S OFFICE AS SOUTH 88°46'46" EAST

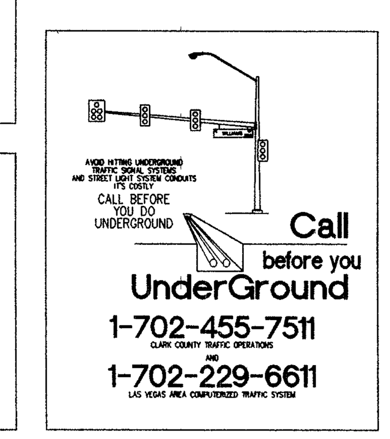

CLARK COUNTY DEPARTMENT OF DEVELOPMENT SERVICES ACCEPTANCE OF PLANS FOR FILING

BY ______________________

ACCEPTANCE OF THESE PLANS FOR FILLING SHALL NOT BE CONSTRUED TO BE A PERMIT FOR OR AN APPROVAL OF ANY VIOLATION OF ANY OF THE PROVISIONS OF THE STATE OR COUNTY LAWS AND/OR SPECIFICATIONS CLARK COUNTY SHALL BE HELD FREE FROM DAMAGES WHICH MAY RESULT FROM THE CONSTRUCTION OF THE IMPROVEMENTS FROM THE ENGINEERING DESIGN DEPICTED HEREIN

NOTE POWER POLES AND/OR OTHER EXISTING FACILITIES NOT IN PROPER LOCATION BASED ON PROPOSED IMPROVEMENTS SHOWN HEREON WILL BE RELOCATED AT NO EXPENSE TO CLARK COUNTY

SLATER HANIFAN GROUP
CONSULTING ENGINEERS & PLANNERS
5740 S ARVILLE STREET #216, LAS VEGAS, NV 89118
PHONE (702) 284-5300 FAX (702) 284-5399

NO.	DESCRIPTION	DATE	BY	APP.
1	REVISED WTR AND SWR MAINS	08/22/05	GAJ/LWJD	8/29/05
2	REVISED LOT NUMBERS, STREET NAMES + KEY MAP	4/10/06		

CLARK COUNTY, NEVADA JC 9/01/05 JH 5/15/06

PINNACLE HOMES

SABLE CREEK
DORAVILLE AVE. PLAN AND PROFILE
DORAVILLE AVE. PLAN AND PROFILE

SECTION 18
TOWNSHIP 19 SOUTH
RANGE 60 EAST, M.D.M.

DATE: 07/07/05
DRAFTER: DMB
DESIGNER: DMB
CHECKED: TJS

PROJECT NO.
PIN0402-001

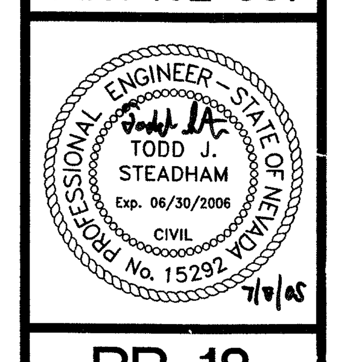

PP-18
SHEET 31 OF 44

CLV DWG #307V930
CC HTE# 05-7995

File J \PIN0402-50ac\Dwg\Improv\PIN0402-PLPR dwg Jul 08, 2005 - 09 19

81758 RGm 82961 RGm 92131