


RECORD OF SURVEY

MONUMENT TIE MAP

CENTERLINE AND REFERENCE MONUMENT PERPETUATION FOR THE SAHARA AVENUE BRT. LYING WITHIN SECTIONS 1,2,3,4,5,6,7,8,9,10,11,12 OF TOWNSHIP 21 SOUTH, RANGE 60 EAST, M.D.M. AND SECTIONS 1,2,3,4,5,6,7,8,9,10,11,12 OF TOWNSHIP 21 SOUTH, RANGE 61 EAST, M.D.M. CITY OF LAS VEGAS, CLARK COUNTY, NEVADA

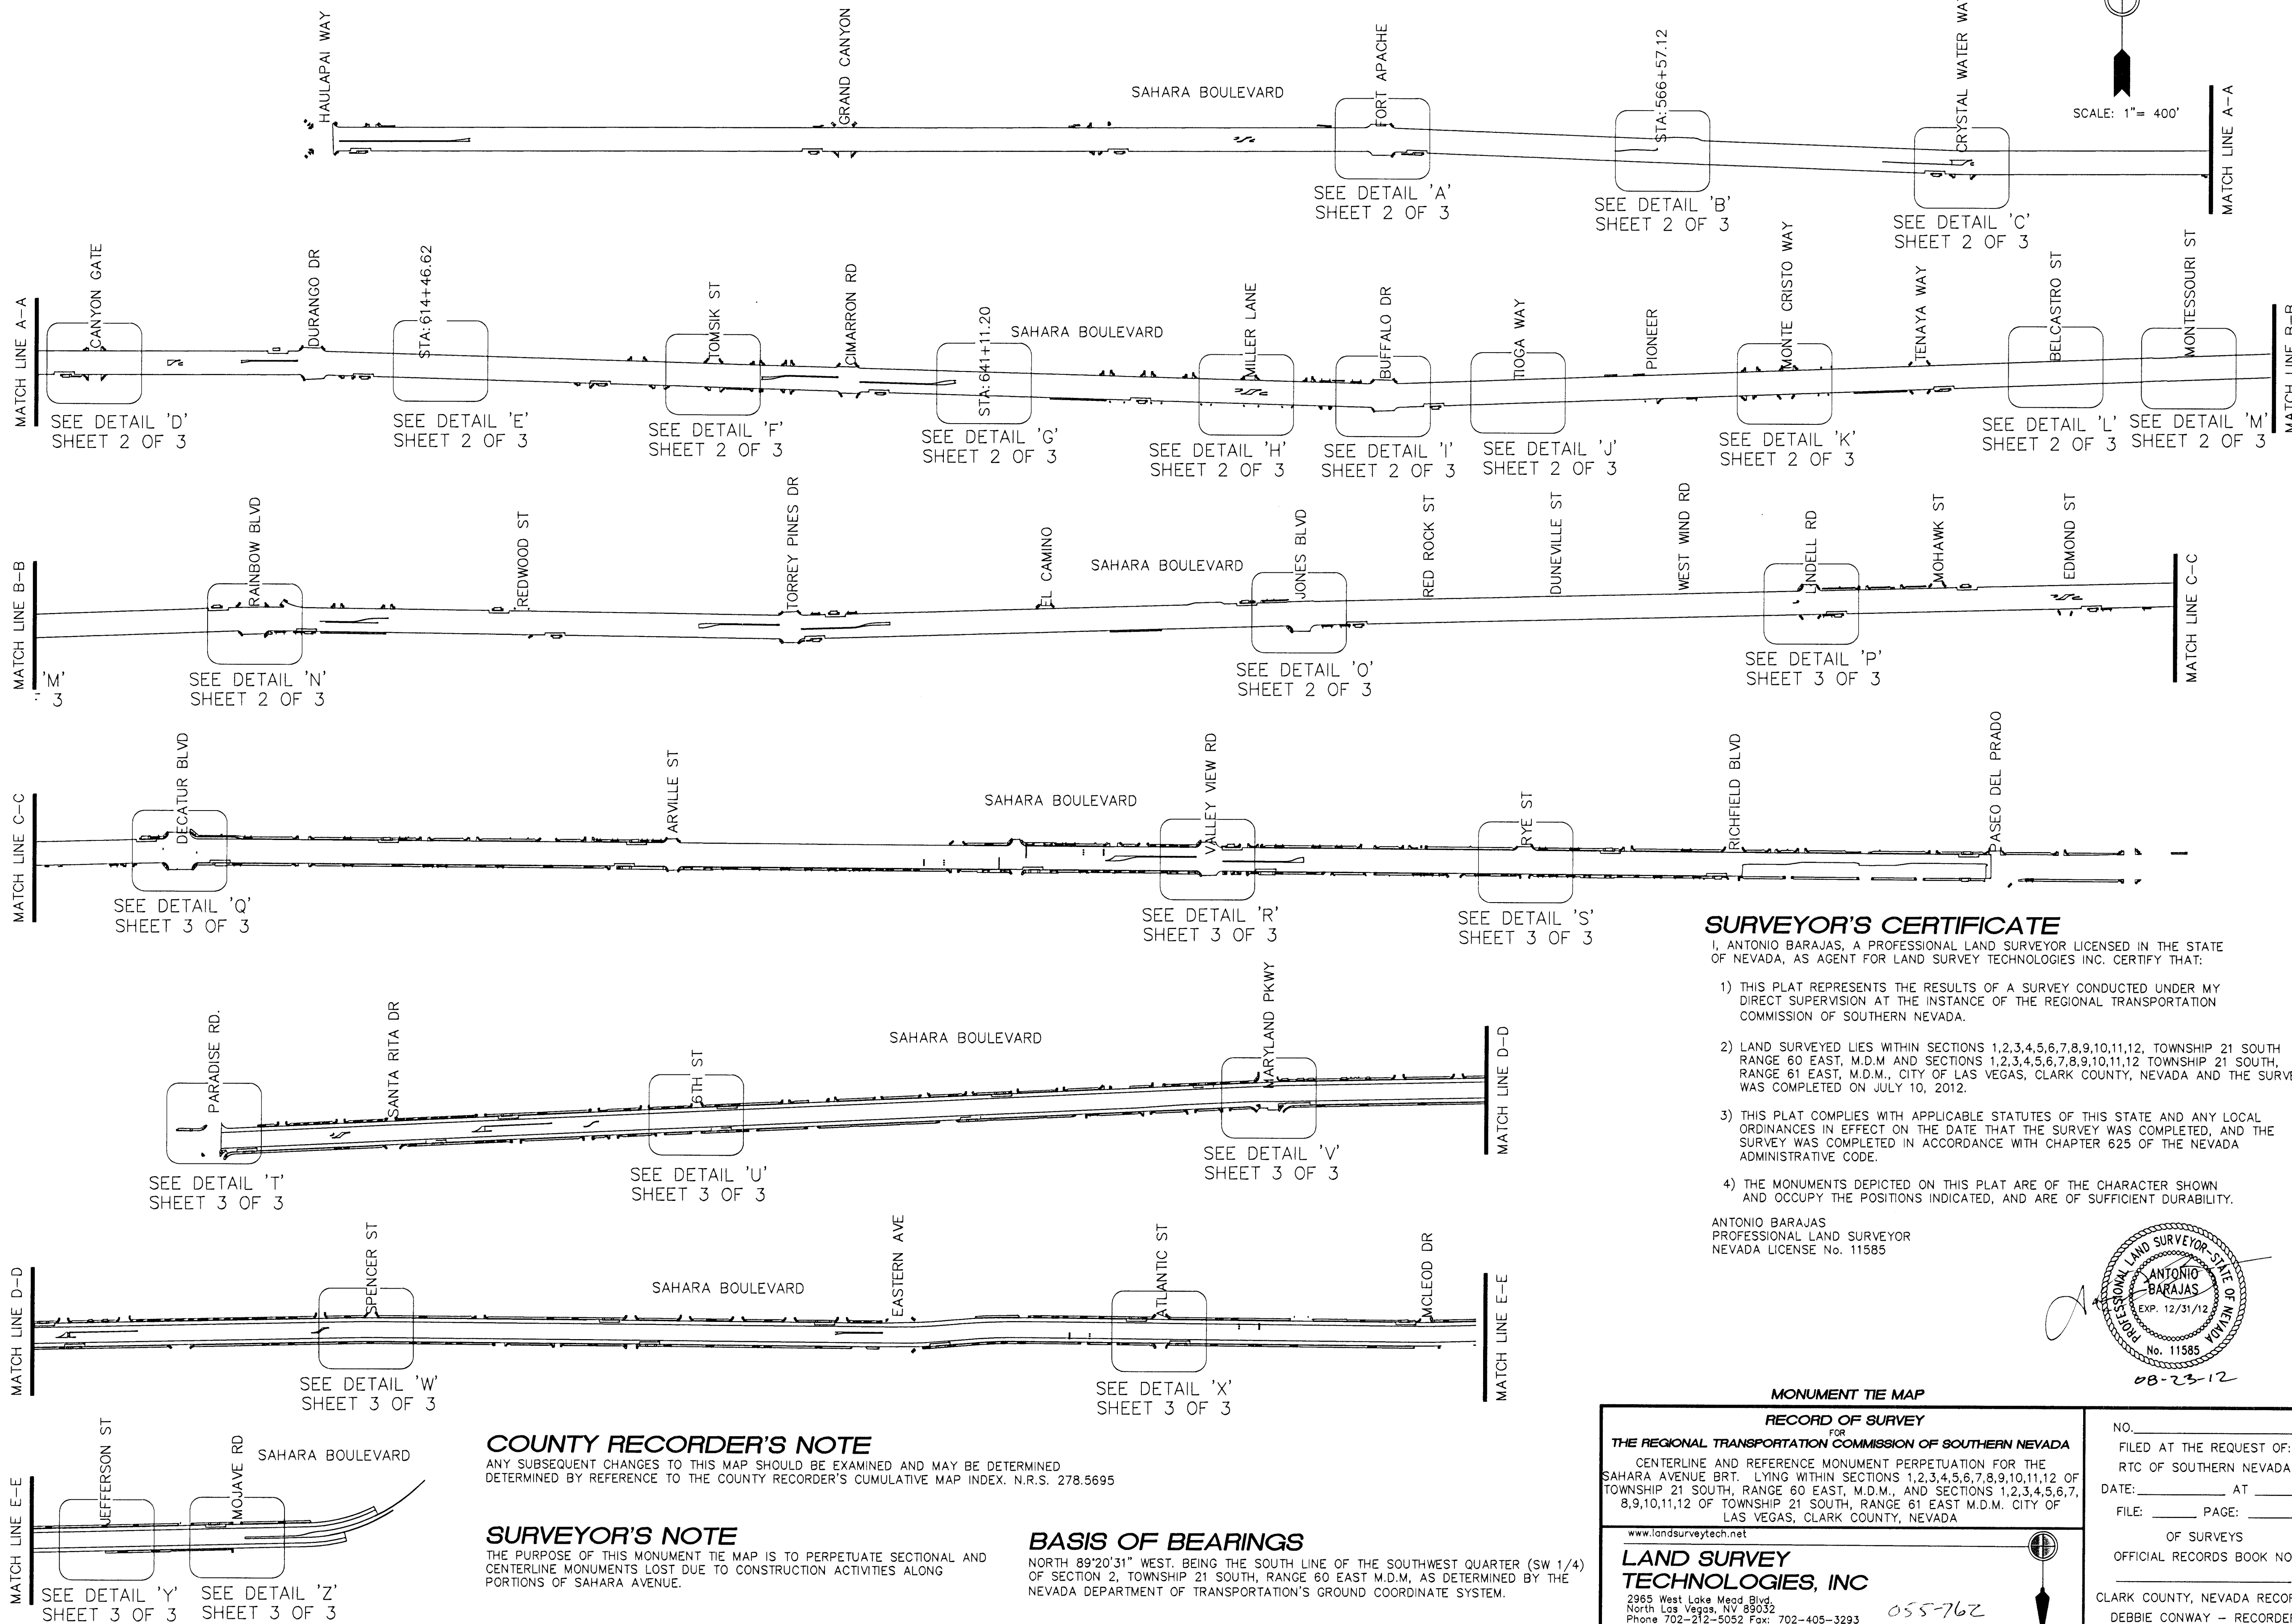


SURVEYOR'S CERTIFICATE

I, ANTONIO BARAJAS, A PROFESSIONAL LAND SURVEYOR LICENSED IN THE STATE OF NEVADA, AS AGENT FOR LAND SURVEY TECHNOLOGIES INC. CERTIFY THAT:

- 1) THIS PLAT REPRESENTS THE RESULTS OF A SURVEY CONDUCTED UNDER MY DIRECT SUPERVISION AT THE INSTANCE OF THE REGIONAL TRANSPORTATION COMMISSION OF SOUTHERN NEVADA.
- 2) LAND SURVEYED LIES WITHIN SECTIONS 1,2,3,4,5,6,7,8,9,10,11,12, TOWNSHIP 21 SOUTH, RANGE 60 EAST, M.D.M. AND SECTIONS 1,2,3,4,5,6,7,8,9,10,11,12, TOWNSHIP 21 SOUTH, RANGE 61 EAST, M.D.M., CITY OF LAS VEGAS, CLARK COUNTY, NEVADA AND THE SURVEY WAS COMPLETED ON JULY 10, 2012.
- 3) THIS PLAT COMPLIES WITH APPLICABLE STATUTES OF THIS STATE AND ANY LOCAL ORDINANCES IN EFFECT ON THE DATE THAT THE SURVEY WAS COMPLETED, AND THE SURVEY WAS COMPLETED IN ACCORDANCE WITH CHAPTER 625 OF THE NEVADA ADMINISTRATIVE CODE.
- 4) THE MONUMENTS DEPICTED ON THIS PLAT ARE OF THE CHARACTER SHOWN AND OCCUPY THE POSITIONS INDICATED, AND ARE OF SUFFICIENT DURABILITY.

ANTONIO BARAJAS
PROFESSIONAL LAND SURVEYOR
NEVADA LICENSE NO. 11585

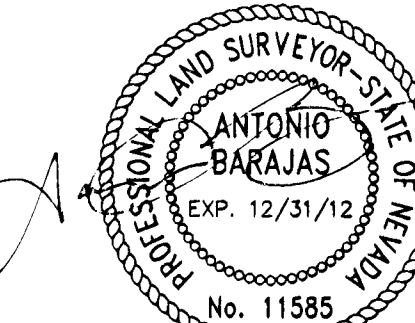

08-23-12

COUNTY RECORDER'S NOTE

ANY SUBSEQUENT CHANGES TO THIS MAP SHOULD BE EXAMINED AND MAY BE DETERMINED DETERMINED BY REFERENCE TO THE COUNTY RECORDER'S CUMULATIVE MAP INDEX. N.R.S. 278.5695

SURVEYOR'S NOTE

THE PURPOSE OF THIS MONUMENT TIE MAP IS TO PERPETUATE SECTIONAL AND CENTERLINE MONUMENTS LOST DUE TO CONSTRUCTION ACTIVITIES ALONG PORTIONS OF SAHARA AVENUE.

BASIS OF BEARINGS

NORTH 89°20'31" WEST, BEING THE SOUTH LINE OF THE SOUTHWEST QUARTER (SW 1/4) OF SECTION 2, TOWNSHIP 21 SOUTH, RANGE 60 EAST M.D.M. AS DETERMINED BY THE NEVADA DEPARTMENT OF TRANSPORTATION'S GROUND COORDINATE SYSTEM.

MONUMENT TIE MAP

RECORD OF SURVEY

FOR THE REGIONAL TRANSPORTATION COMMISSION OF SOUTHERN NEVADA

CENTERLINE AND REFERENCE MONUMENT PERPETUATION FOR THE SAHARA AVENUE BRT. LYING WITHIN SECTIONS 1,2,3,4,5,6,7,8,9,10,11,12 OF TOWNSHIP 21 SOUTH, RANGE 60 EAST, M.D.M., AND SECTIONS 1,2,3,4,5,6,7,8,9,10,11,12 OF TOWNSHIP 21 SOUTH, RANGE 61 EAST M.D.M. CITY OF LAS VEGAS, CLARK COUNTY, NEVADA

www.landsurveytech.net

LAND SURVEY
TECHNOLOGIES, INC.

2965 West Lake Mead Blvd.
North Las Vegas, NV 89032
Phone 702-212-5052 Fax: 702-405-3293

DATE: 07/10/12 JOB#: 11-5014.001

SHEET 1 OF 3

NO. _____
FILED AT THE REQUEST OF:
RTC OF SOUTHERN NEVADA
DATE: _____ AT _____
FILE: _____ PAGE: _____
OF SURVEYS
OFFICIAL RECORDS BOOK NO. _____
CLARK COUNTY, NEVADA RECORDS
DEBBIE CONWAY - RECORDER
FEE: _____ DEPUTY _____

FILE _____ PAGE _____

SHEET 1 OF 3