



RECORD OF SURVEY

MONUMENT TIE MAP


CENTERLINE AND REFERENCE MONUMENT PERPETUATION FOR THE SAHARA AVENUE BRT. LYING WITHIN SECTIONS 1,2,3,4,5,6,7,8,9,10,11,12 OF TOWNSHIP 21 SOUTH, RANGE 60 EAST, M.D.M. AND SECTIONS 1,2,3,4,5,6,7,8,9,10,11,12 OF TOWNSHIP 21 SOUTH, RANGE 61 EAST, M.D.M. CITY OF LAS VEGAS, CLARK COUNTY, NEVADA

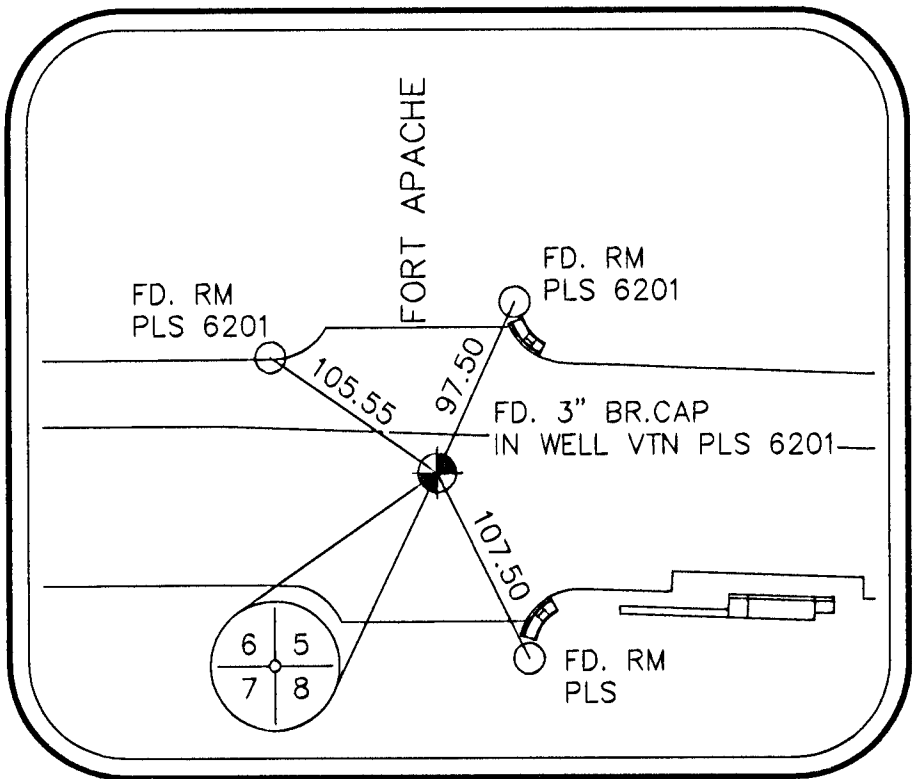


DETAIL "A"
NOT TO SCALE

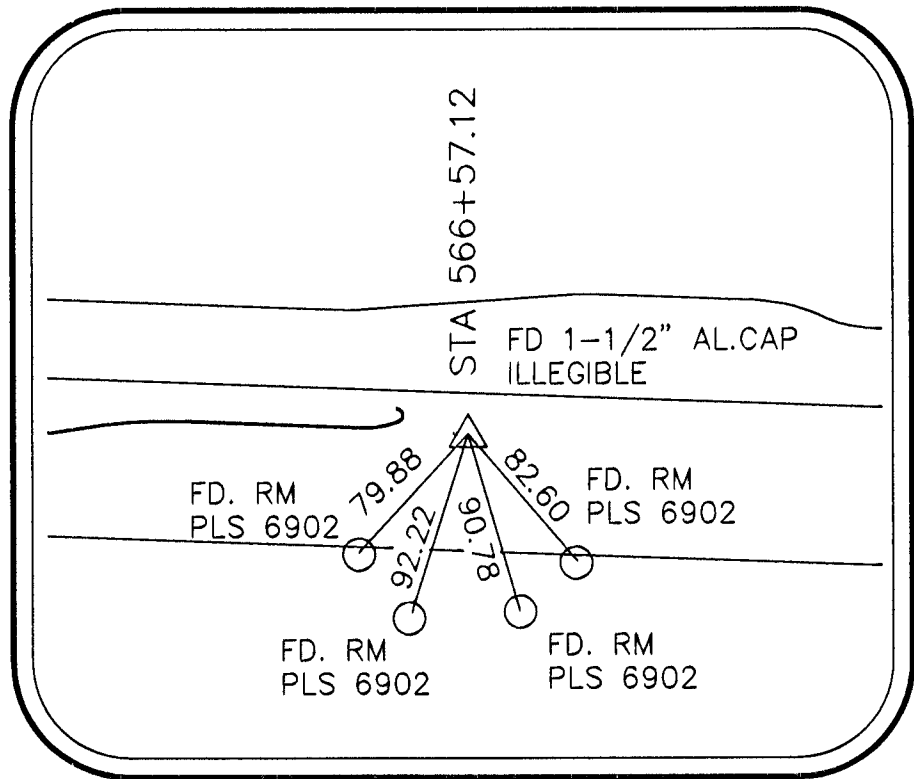


DETAIL "B"
NOT TO SCALE

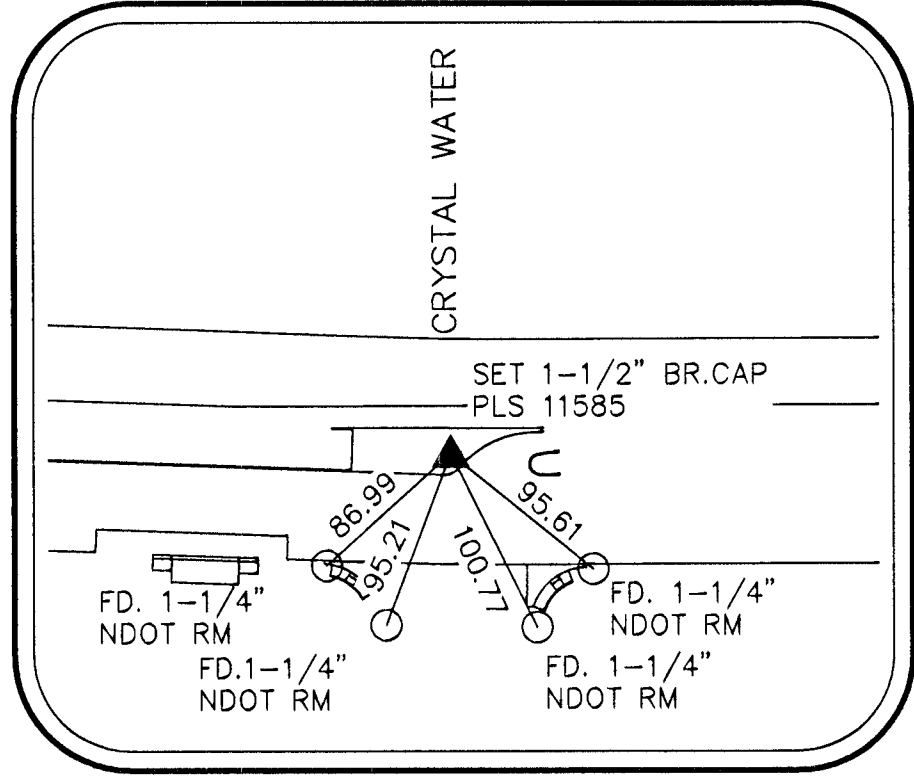


DETAIL "C"
NOT TO SCALE

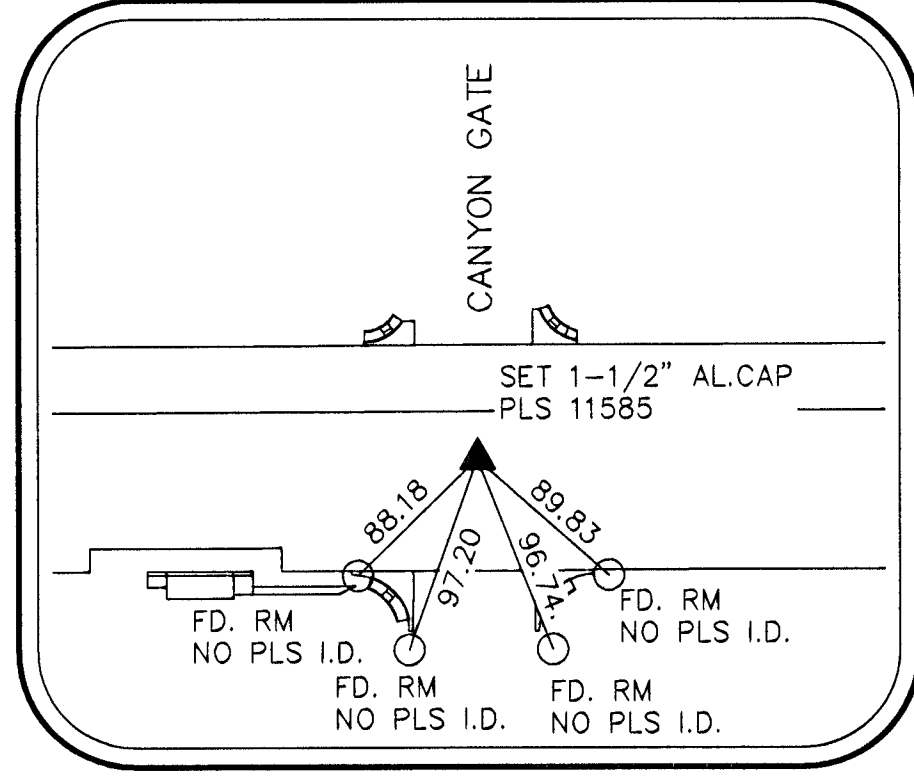


DETAIL "D"
NOT TO SCALE

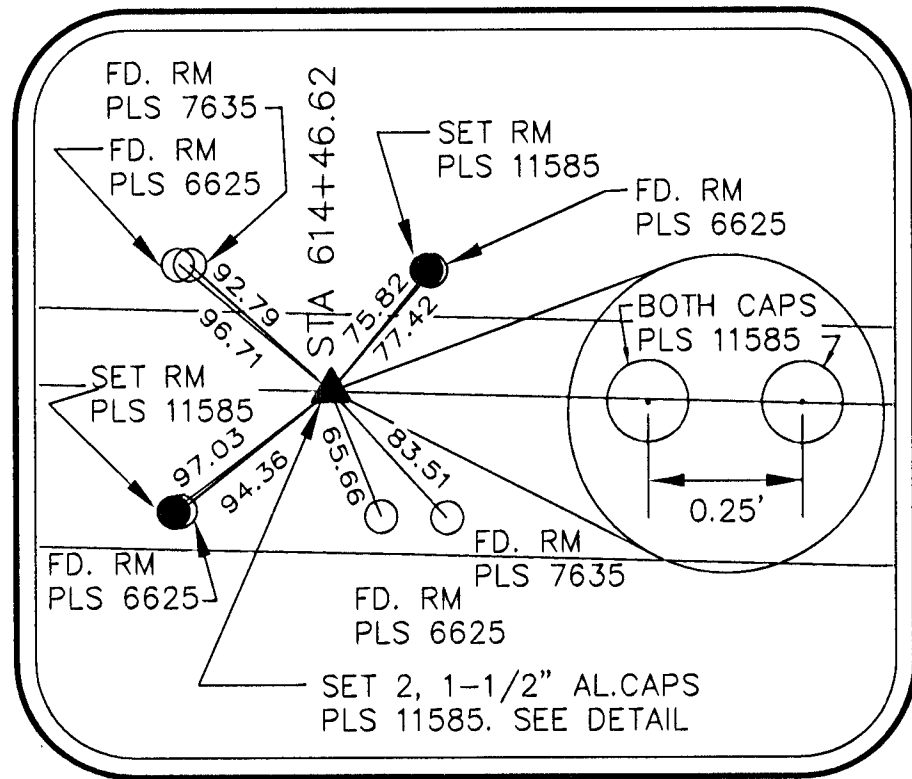


DETAIL "E"
NOT TO SCALE

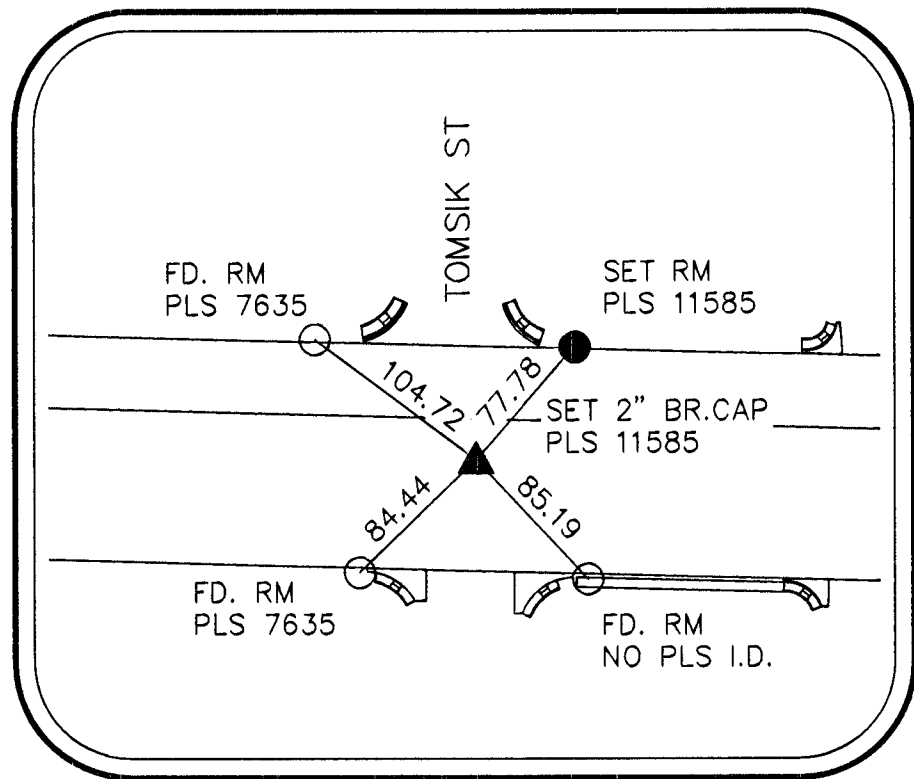


DETAIL "F"
NOT TO SCALE

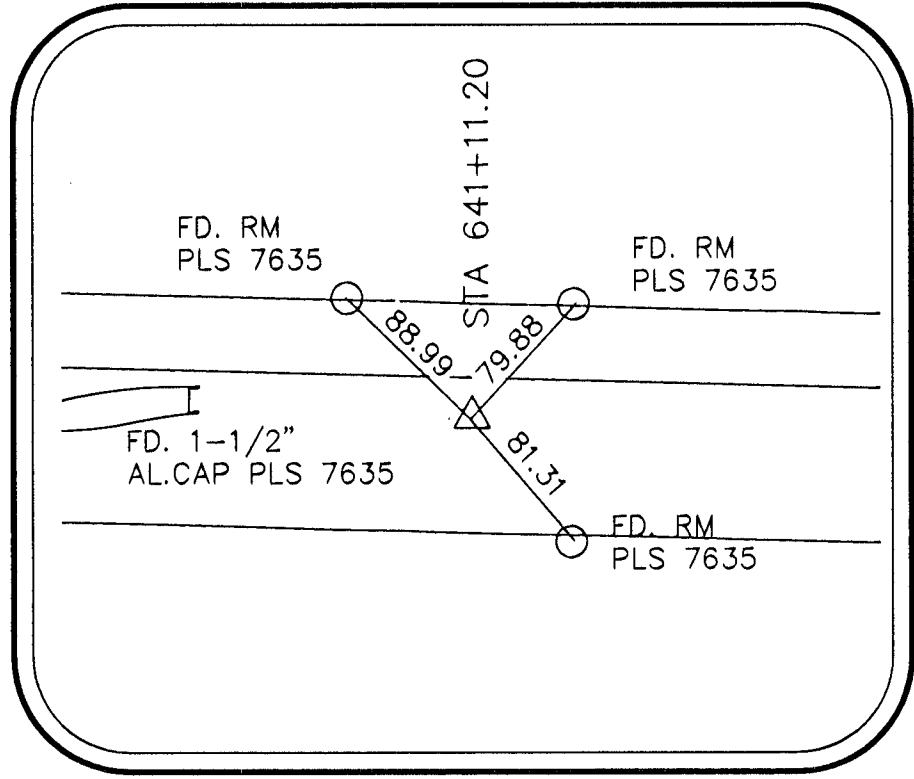


DETAIL "G"
NOT TO SCALE

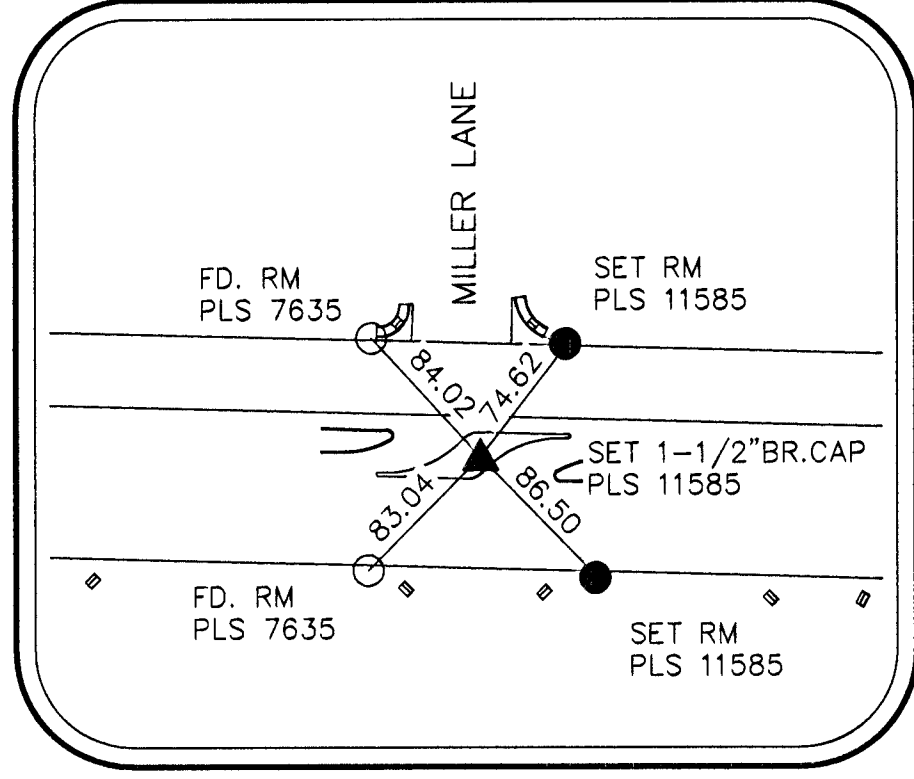


DETAIL "H"
NOT TO SCALE

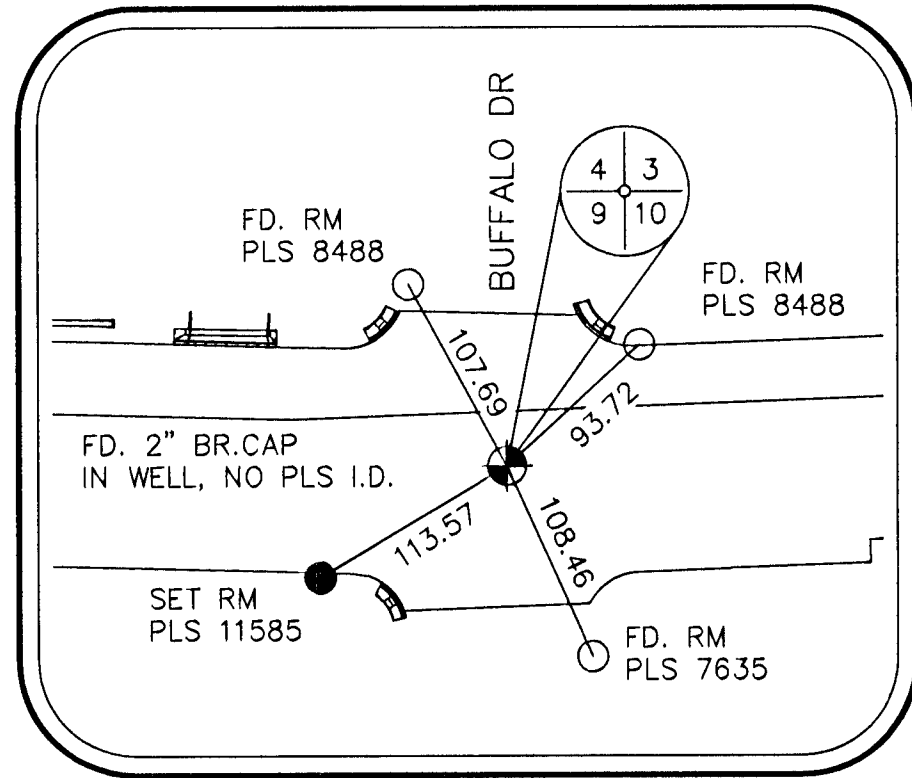


DETAIL "I"
NOT TO SCALE

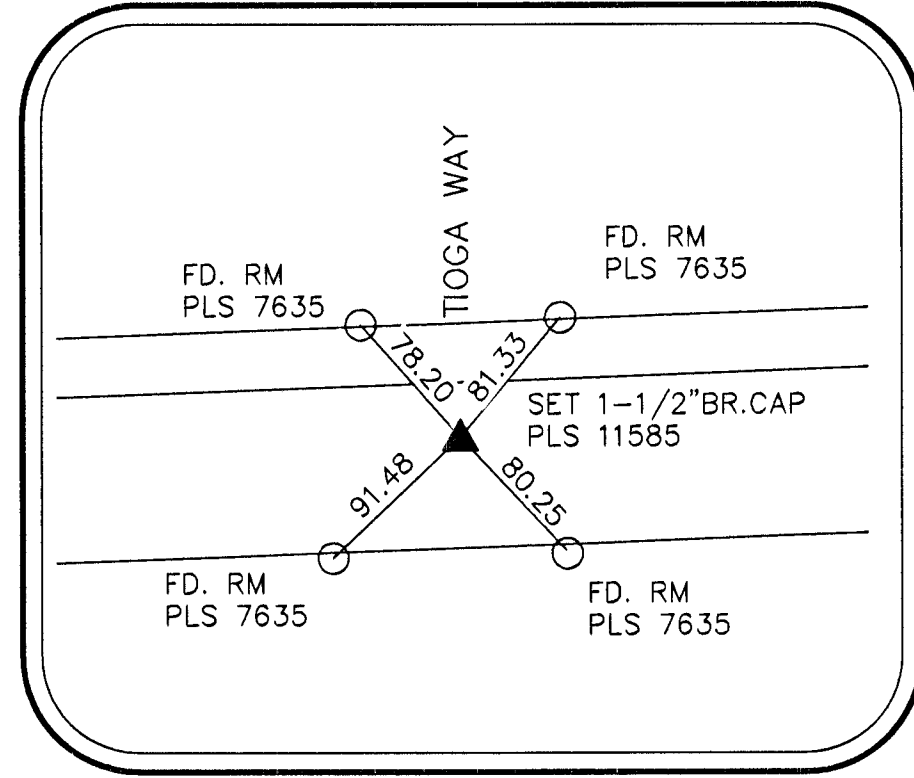


DETAIL "J"
NOT TO SCALE

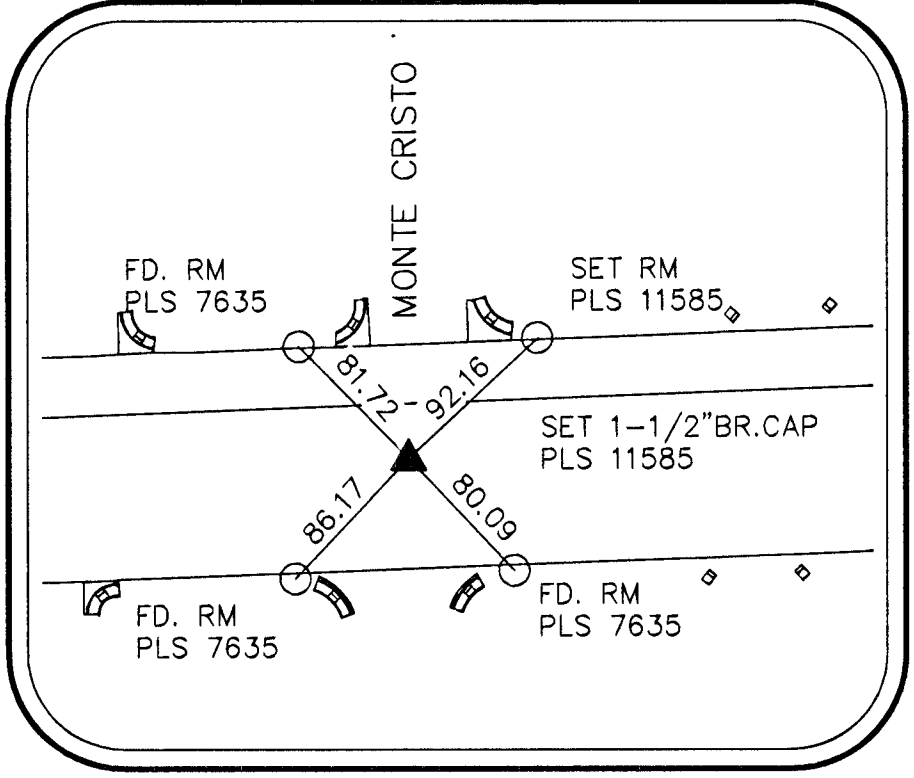


DETAIL "K"
NOT TO SCALE

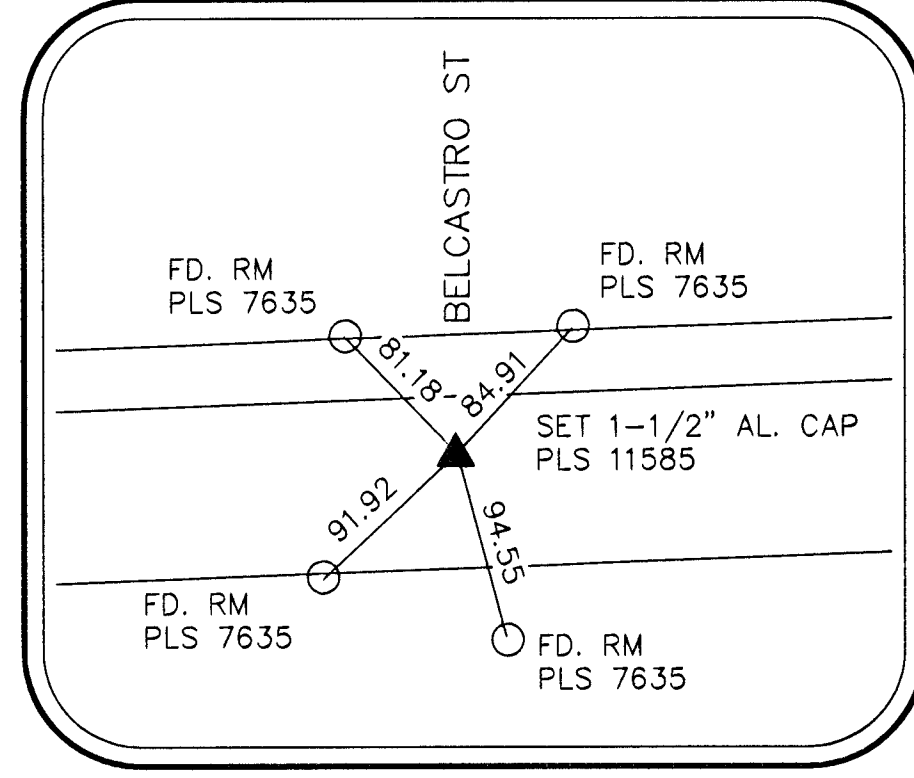


DETAIL "L"
NOT TO SCALE

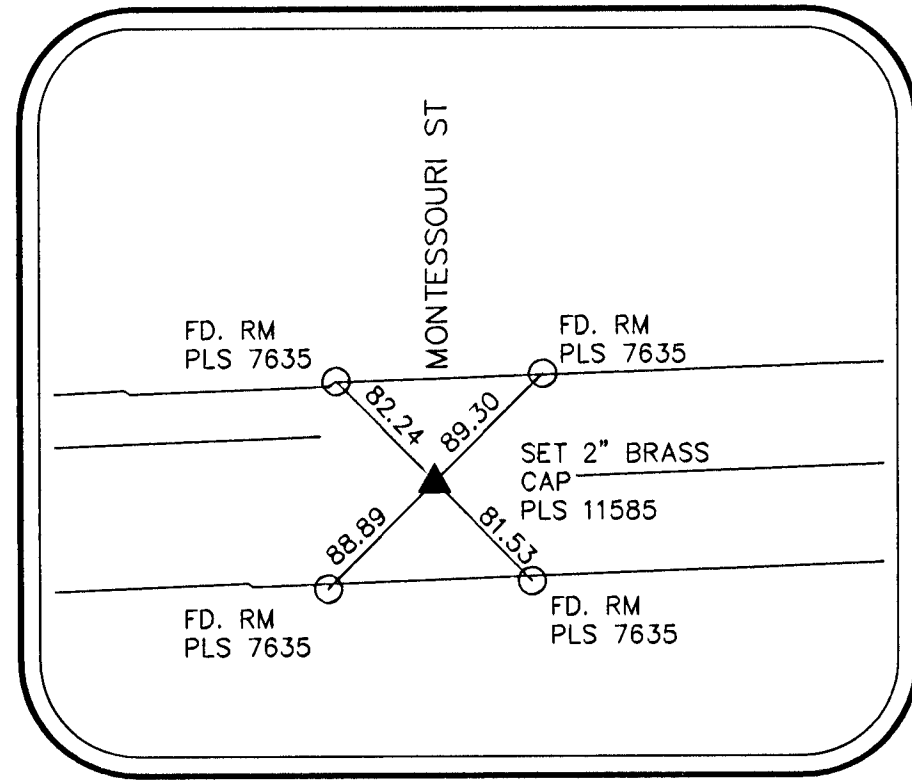



DETAIL "M"
NOT TO SCALE

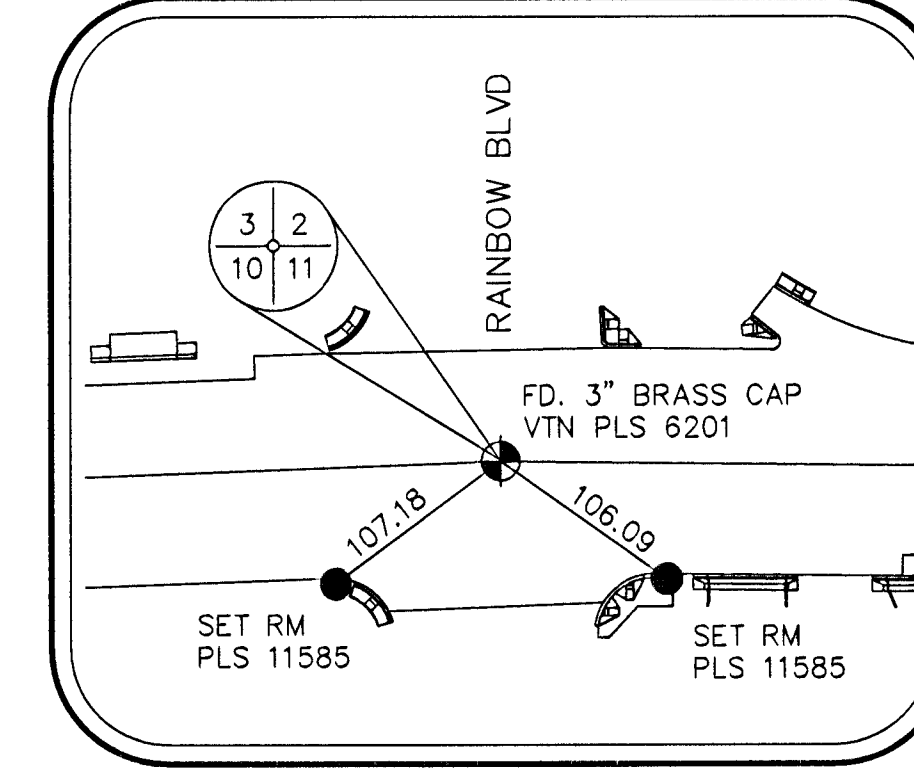

DETAIL "N"
NOT TO SCALE

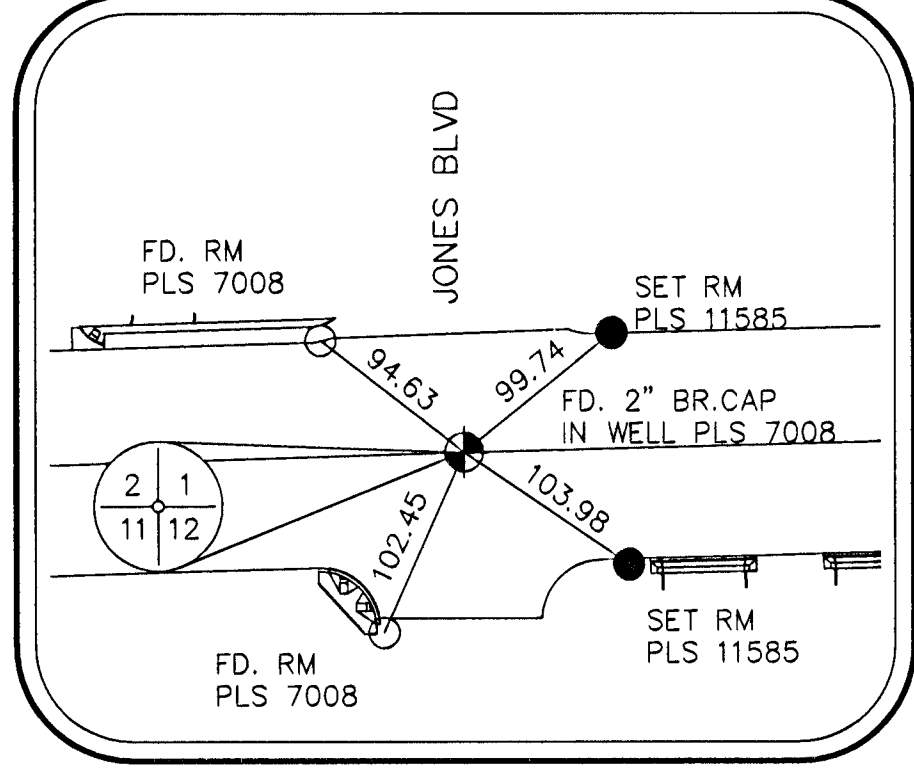

DETAIL "O"
NOT TO SCALE

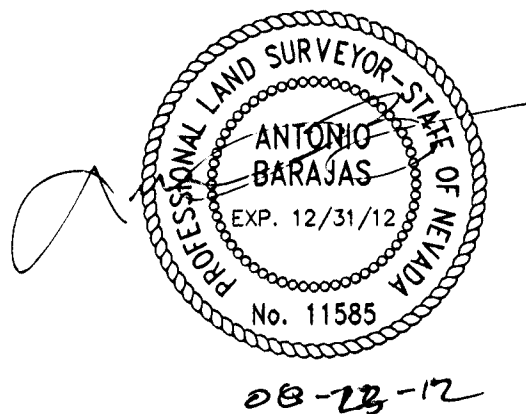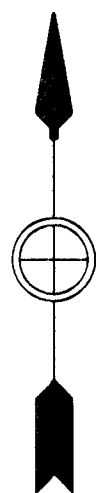

055-762