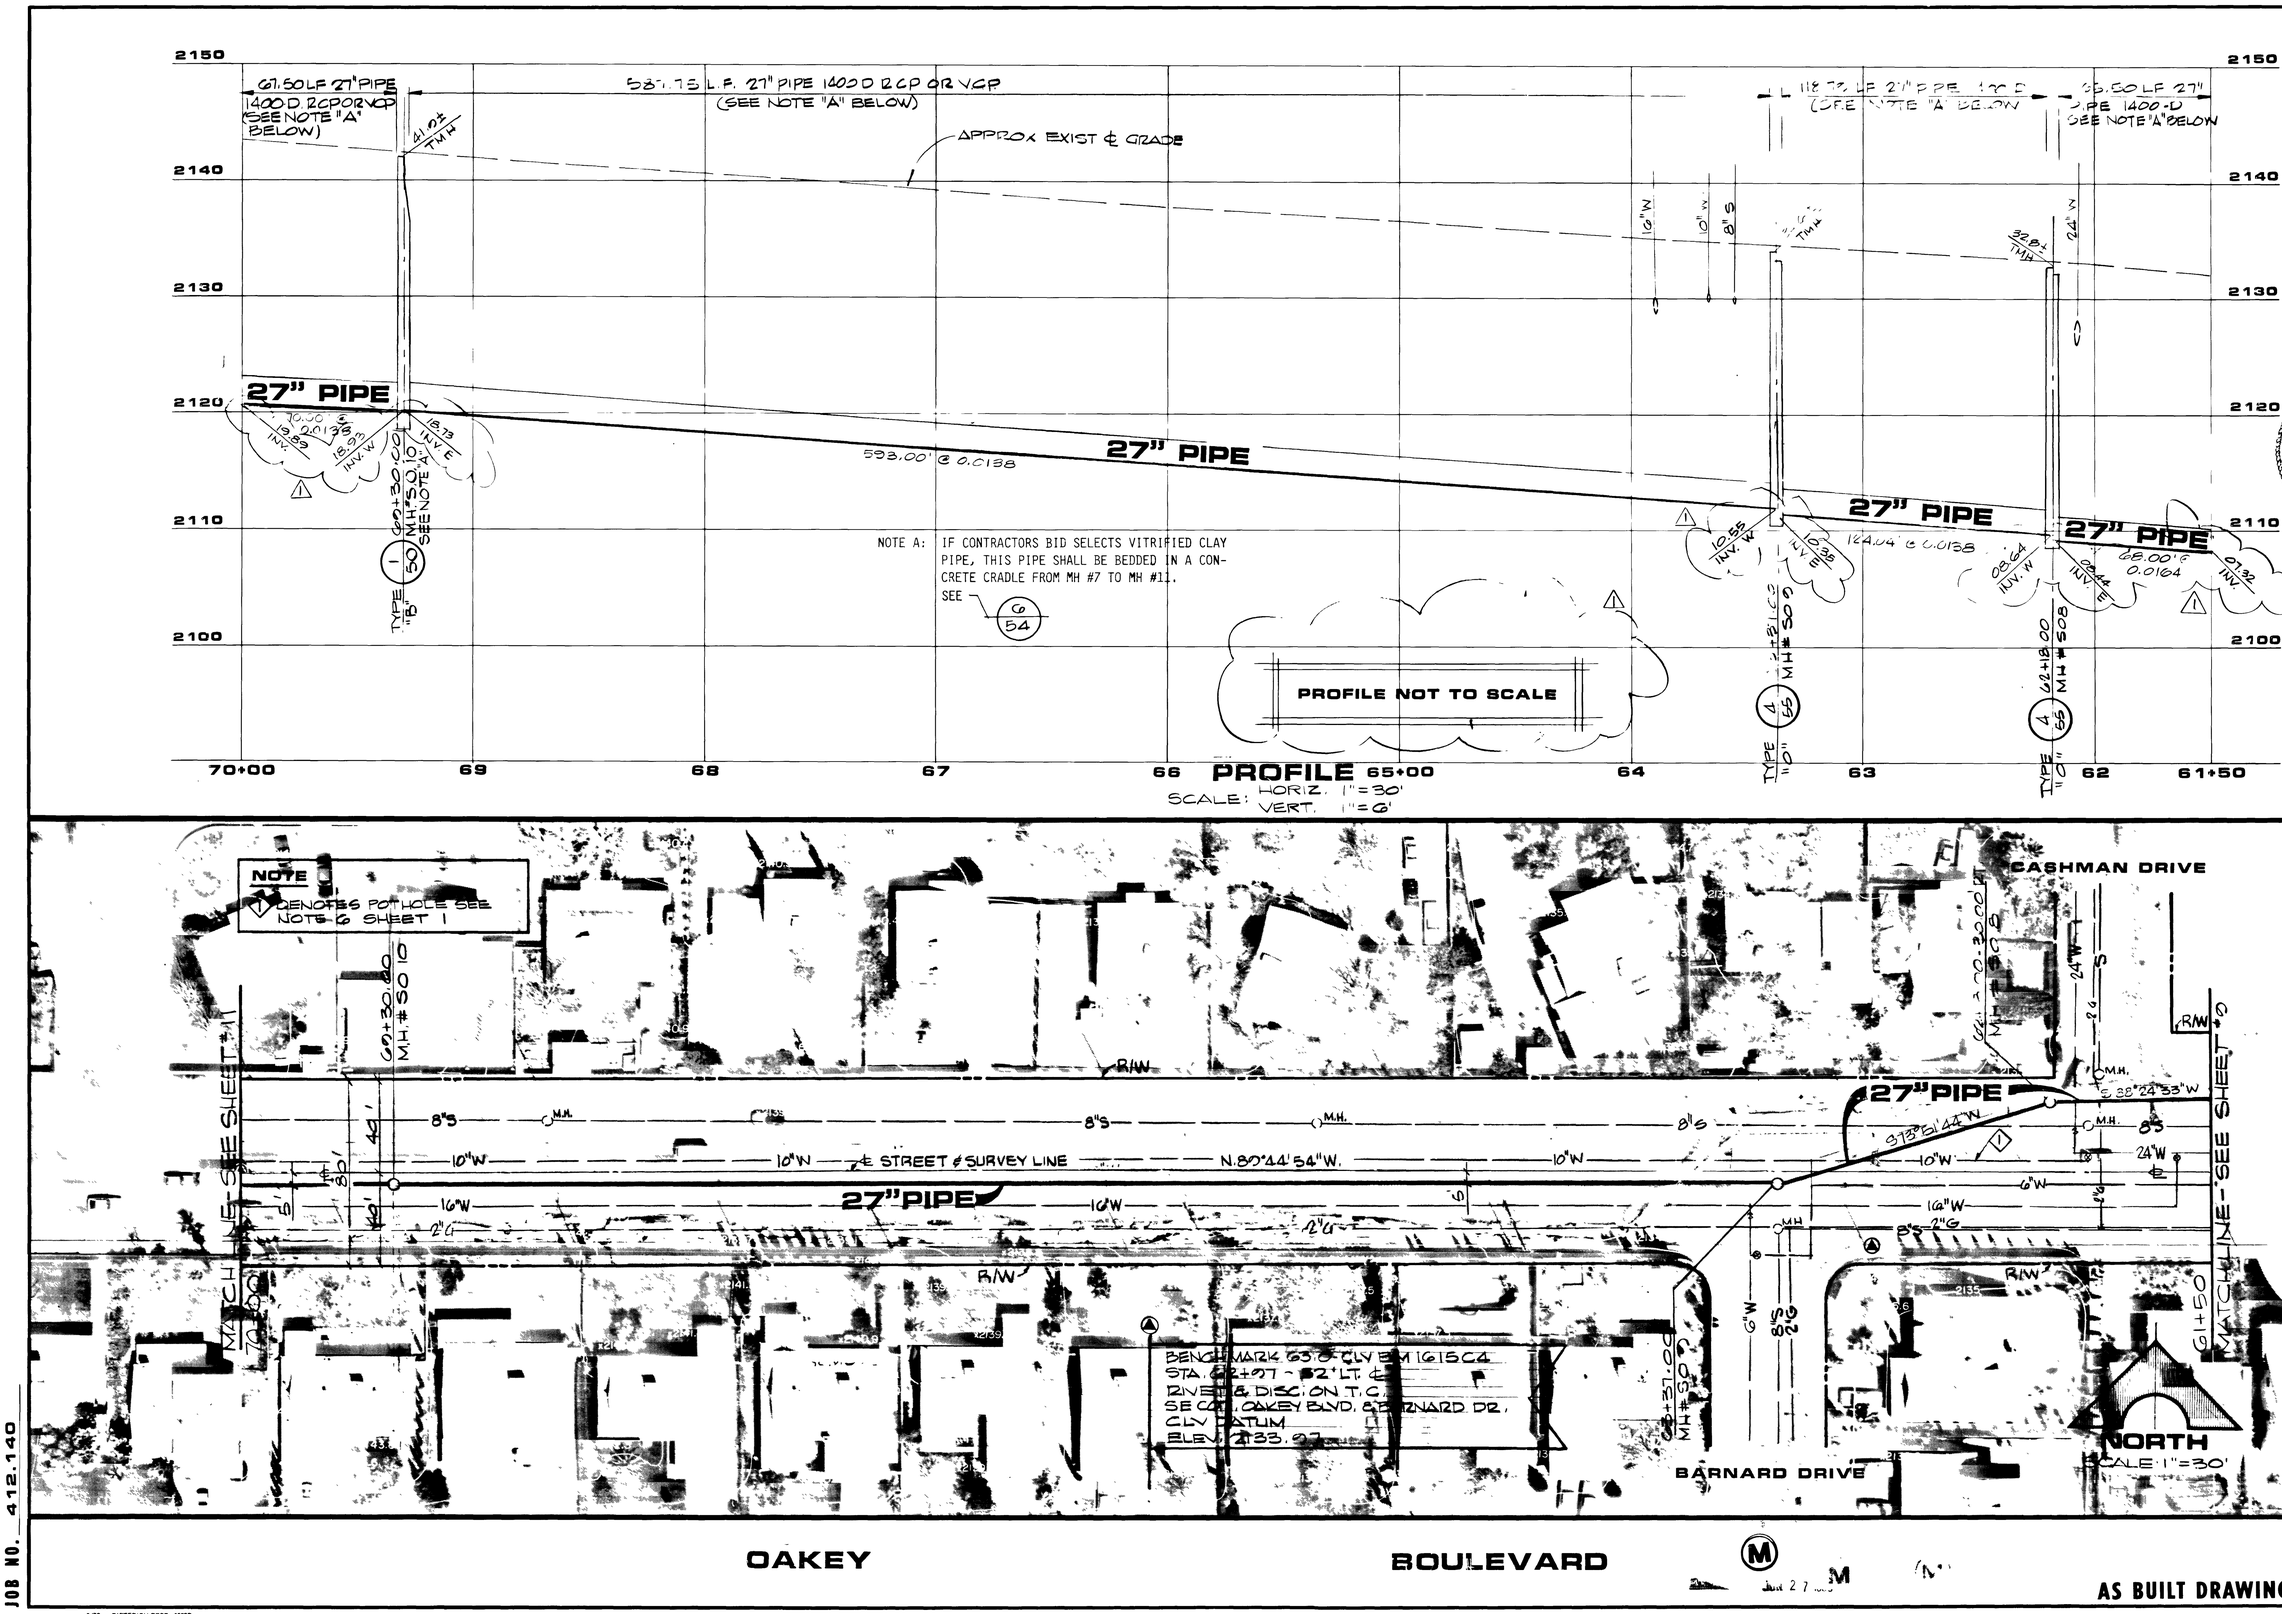

REV	DATE	DESCRIPTION
1	1/6/84	DUE TO 84' SEWER PIPELINE
2	4/10/86	"AS BUILT" - NO REVISIONS

R.E. NO. 2/25/86 DATE

REGISTERED PROFESSIONAL ENGINEER - STATE OF NEVADA - MICHAEL D. ROSS CIVIL

G. C. WALLACE
Consulting Engineers, Inc.
1100 East Sahara Ave. • Las Vegas, Nevada 89104 • 732-3330

Department of Public Services
BAHARA - OAKEY SEWER INTERCEPTOR
PLAN & PROFILE 61+50 TO 70+00

SHEET **10** OF 55 SHEETS

AS BUILT DRAWING

JOB NO. 412.140

9/78 DIETERICH-POST 6532B

307-V 563 25-1-86

 
PROFILE NOT TO SCALE
PROFILE
OAKEY
BOULEVARD
AS BUILT DRAWING
B.C. WALLACE
Consulting Engineers, Inc.
10