



JOB NO. 412.140

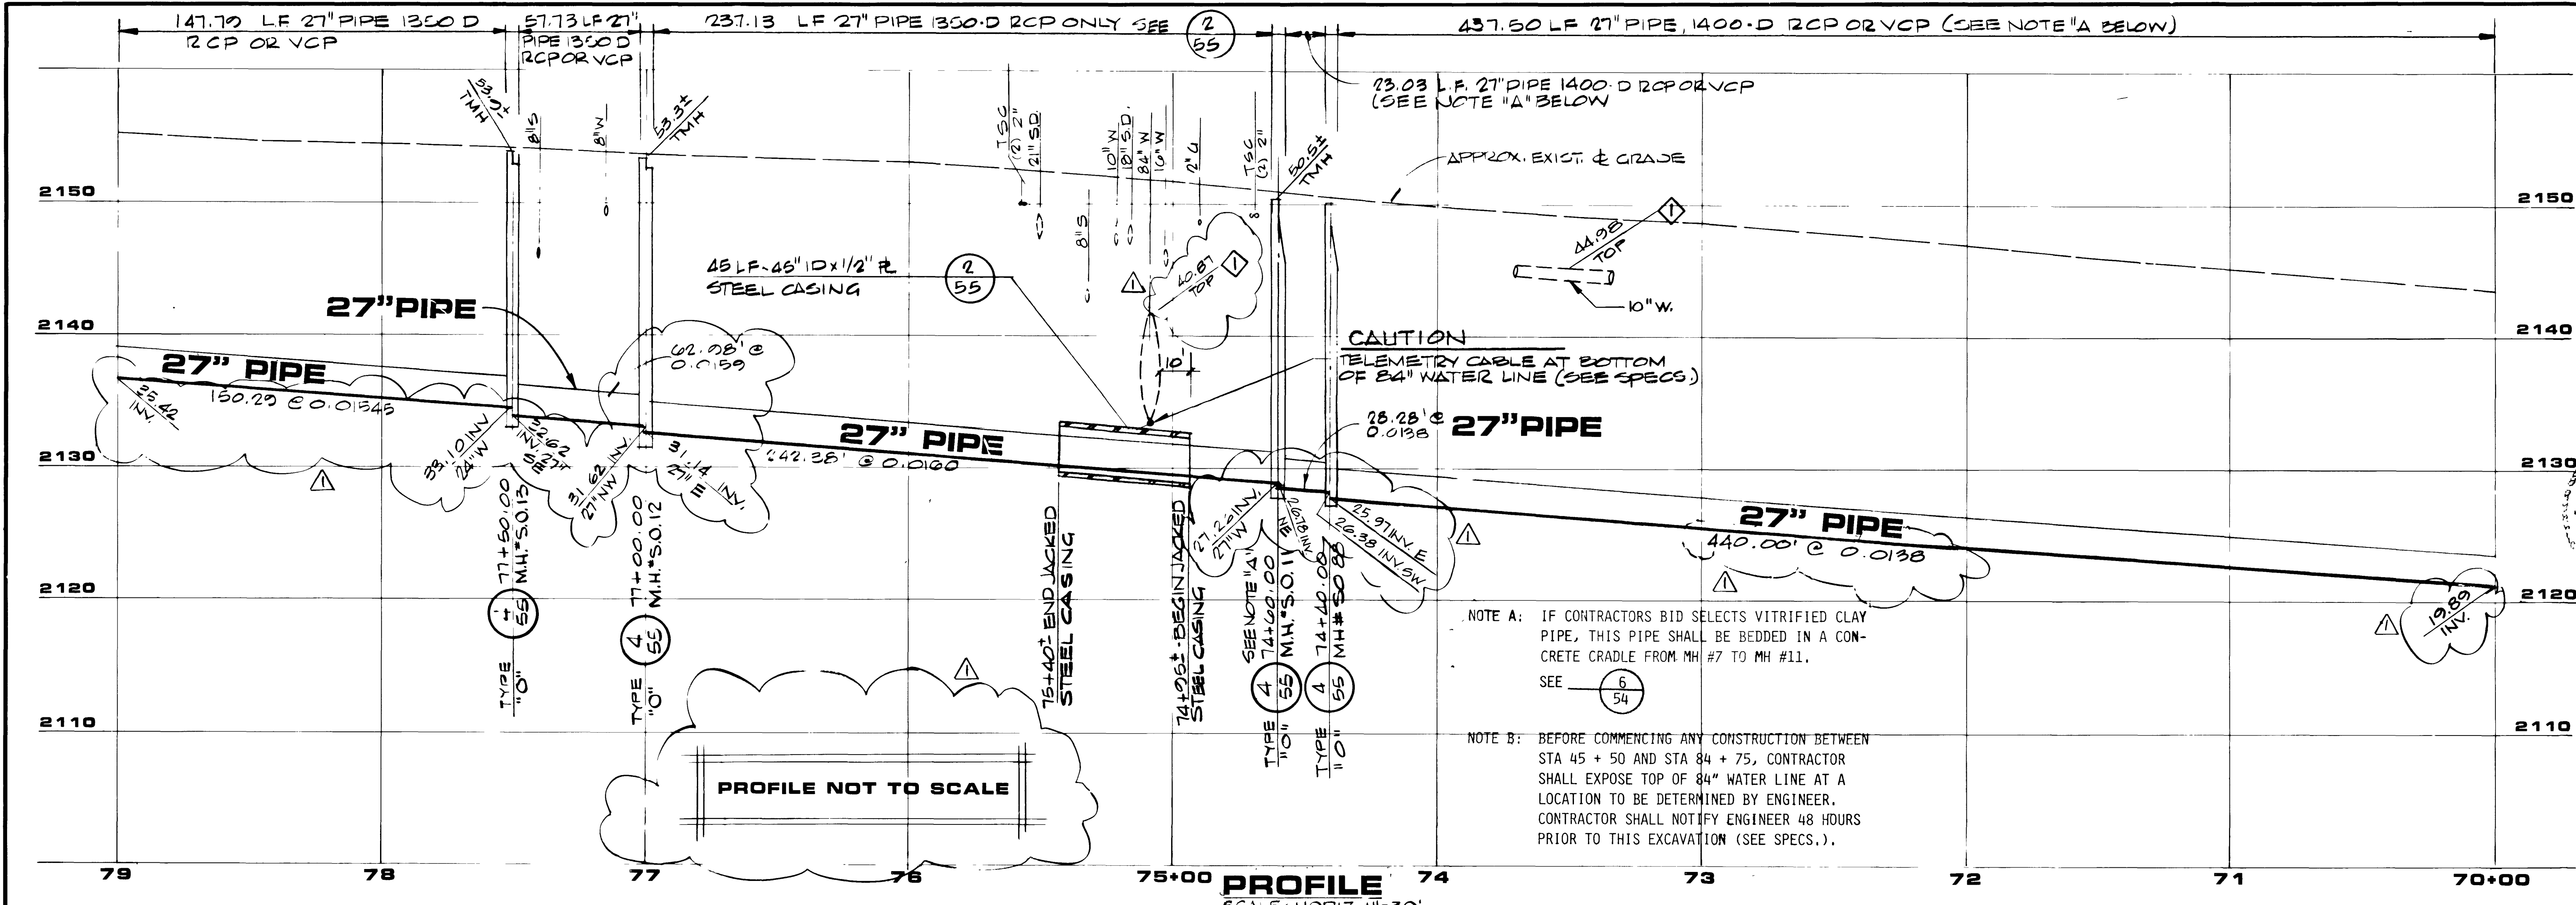


NOTE A: IF CONTRACTORS BID SELECTS VITRIFIED CLAY PIPE, THIS PIPE SHALL BE BEDDED IN A CONCRETE CRADLE FROM MH #7 TO MH #11. SEE 6 54

NOTE B: BEFORE COMMENCING ANY CONSTRUCTION BETWEEN STA 45 + 50 AND STA 84 + 75, CONTRACTOR SHALL EXPOSE TOP OF 84" WATER LINE AT A LOCATION TO BE DETERMINED BY ENGINEER. CONTRACTOR SHALL NOTIFY ENGINEER 48 HOURS PRIOR TO THIS EXCAVATION (SEE SPECS.).

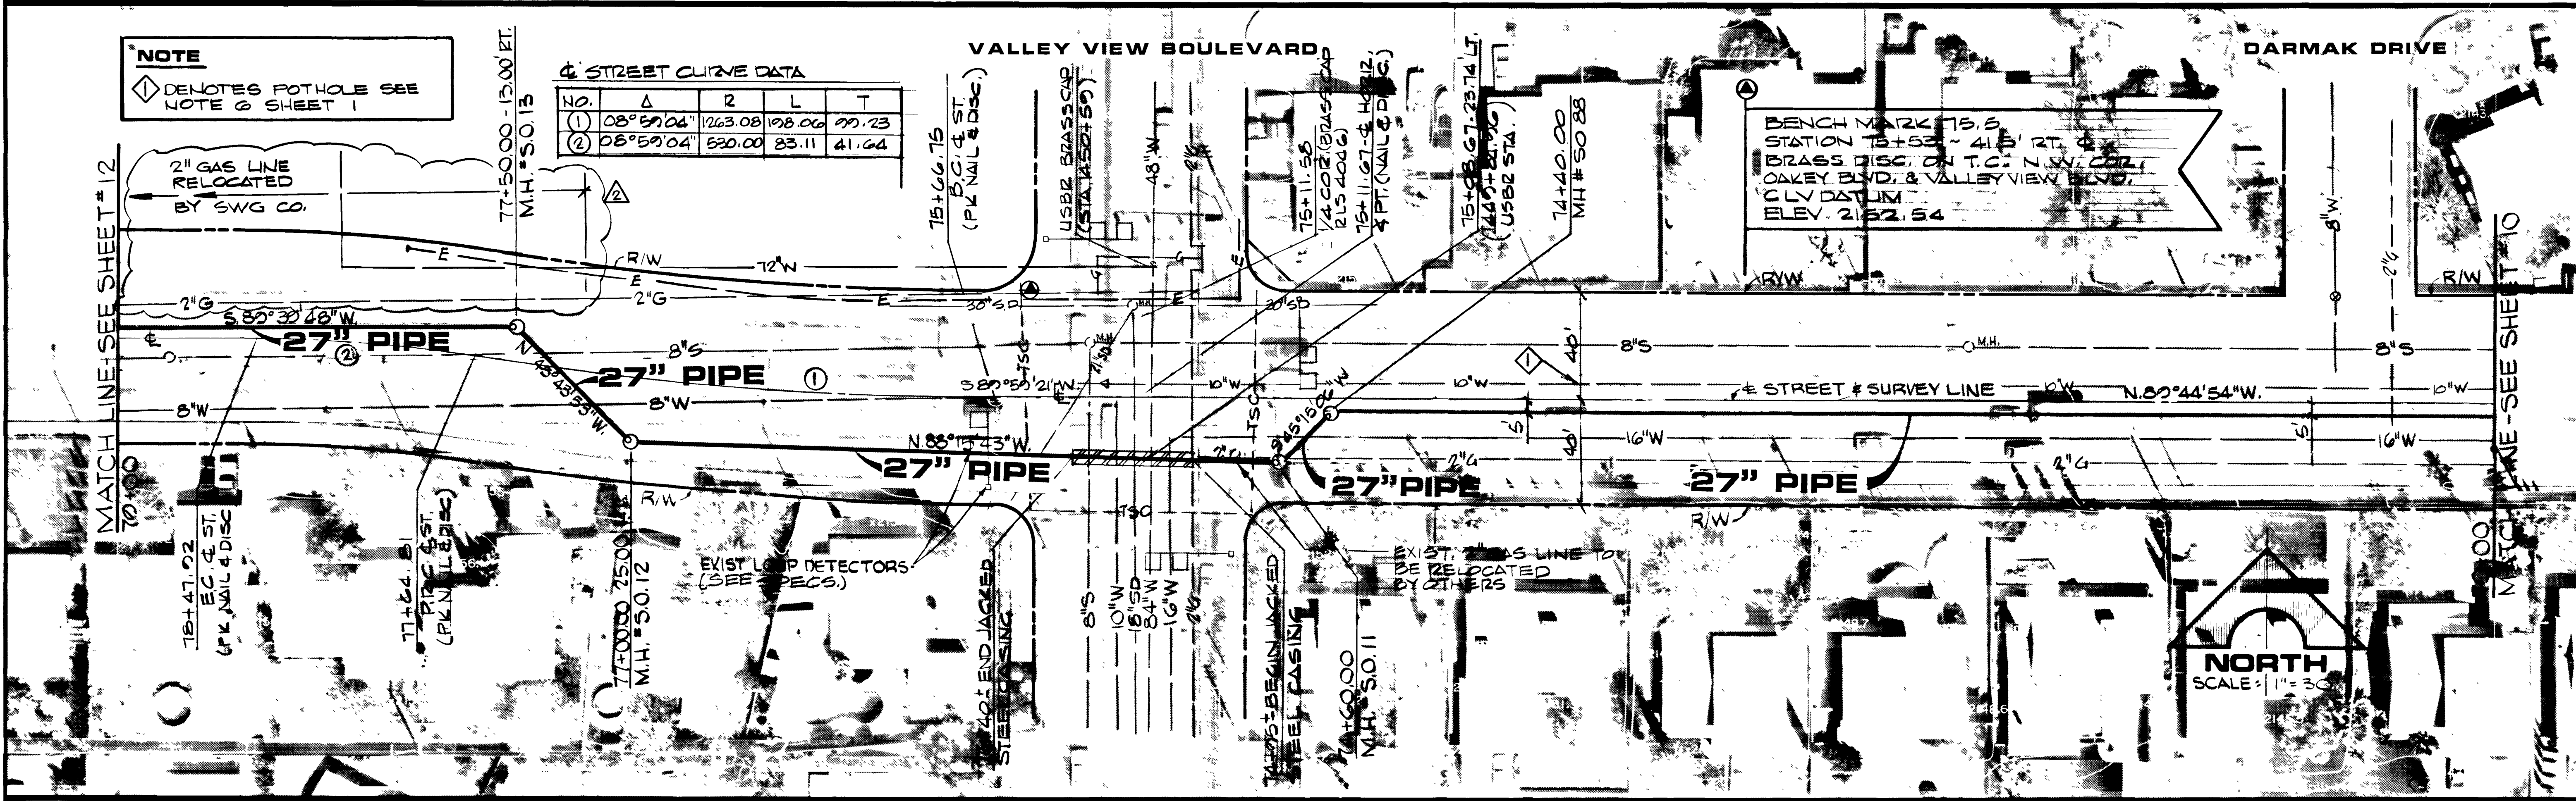




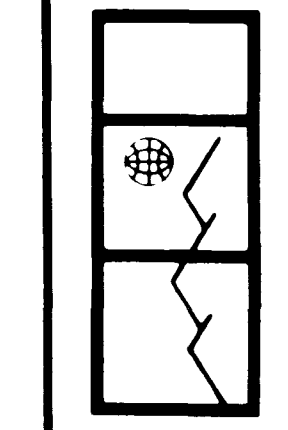


G. G. WALLACE
Consulting Engineers, Inc.
1100 East Sahara Ave. • Las Vegas, Nevada 89104 • 732-3330

Department of Public Services
SAHARA - OAKLEY SEWER INTERCEPTOR
PLAN & PROFILE 70+00 TO 79+00

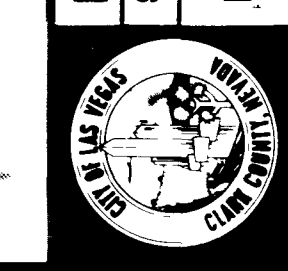

SHEET
11
OF 65 SHEETS

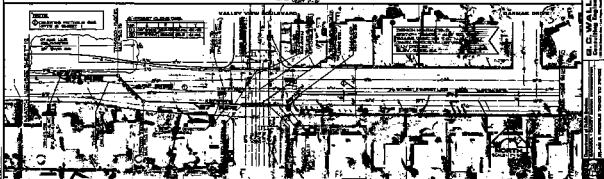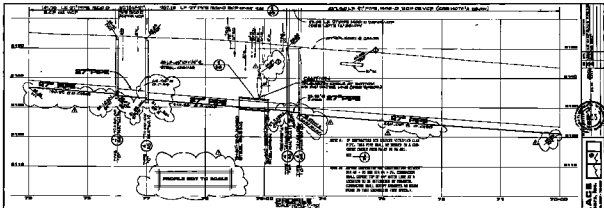

 11