


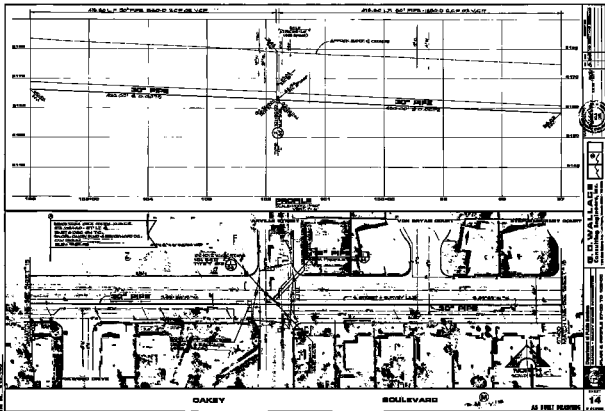

G.D. WALLACE
 Consulting Engineer, Inc.


Sheet
14


307-4 000

39-1-42