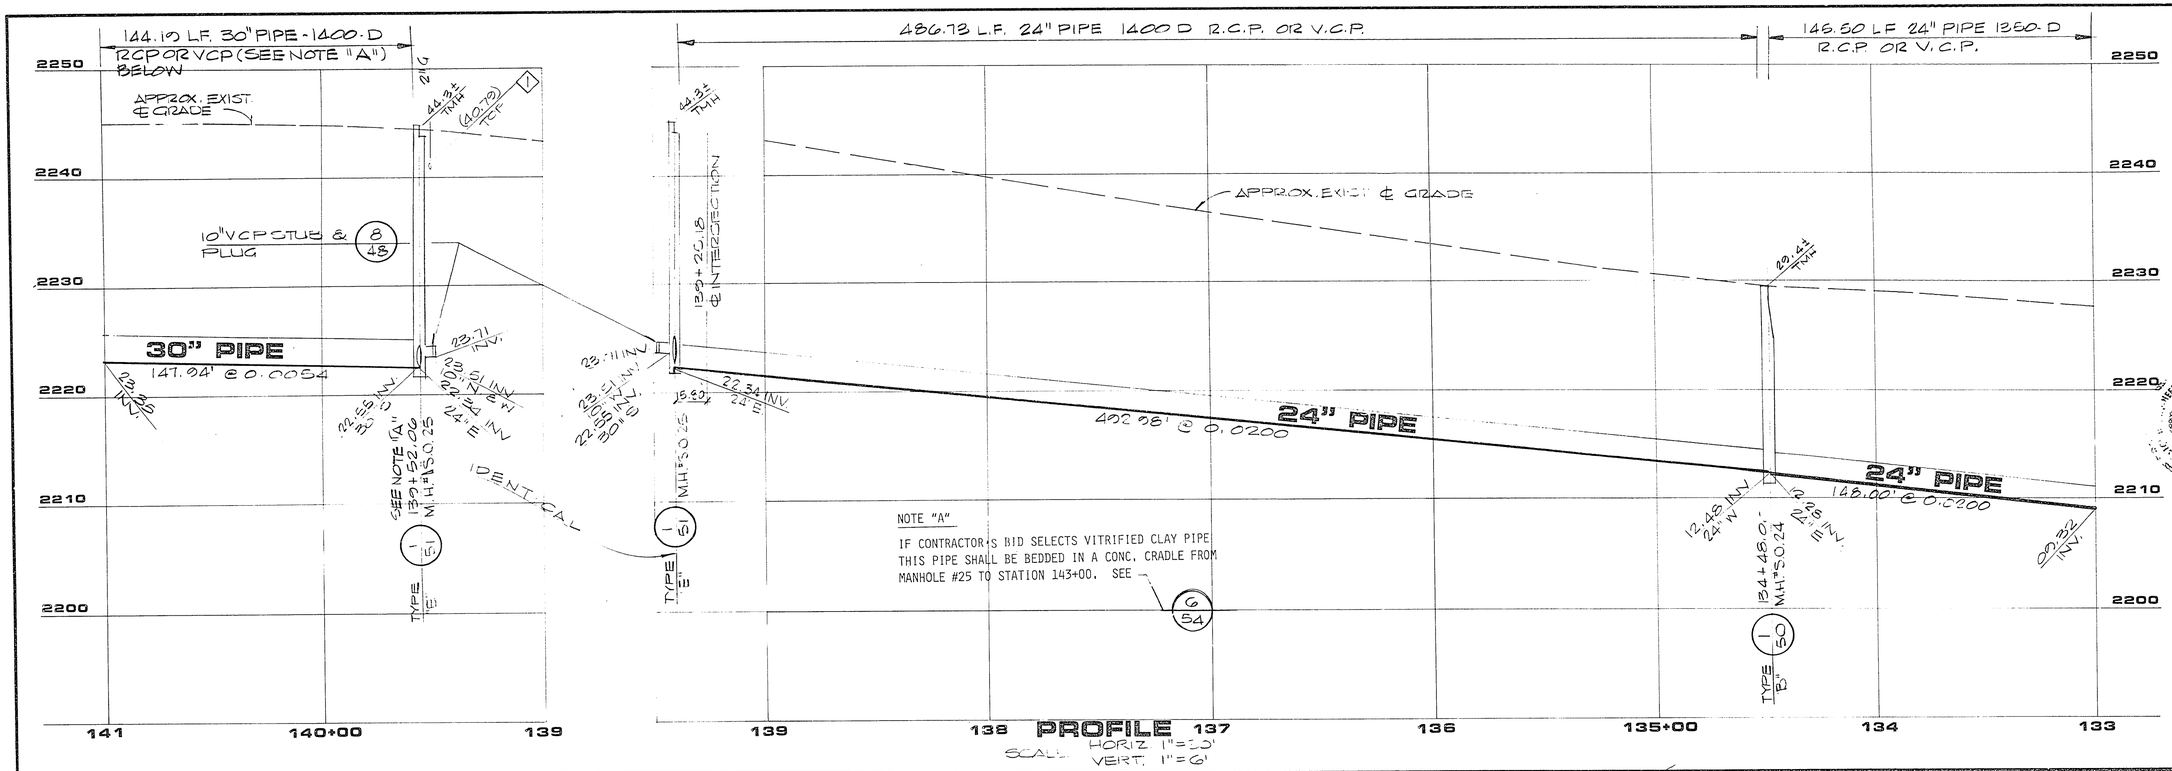

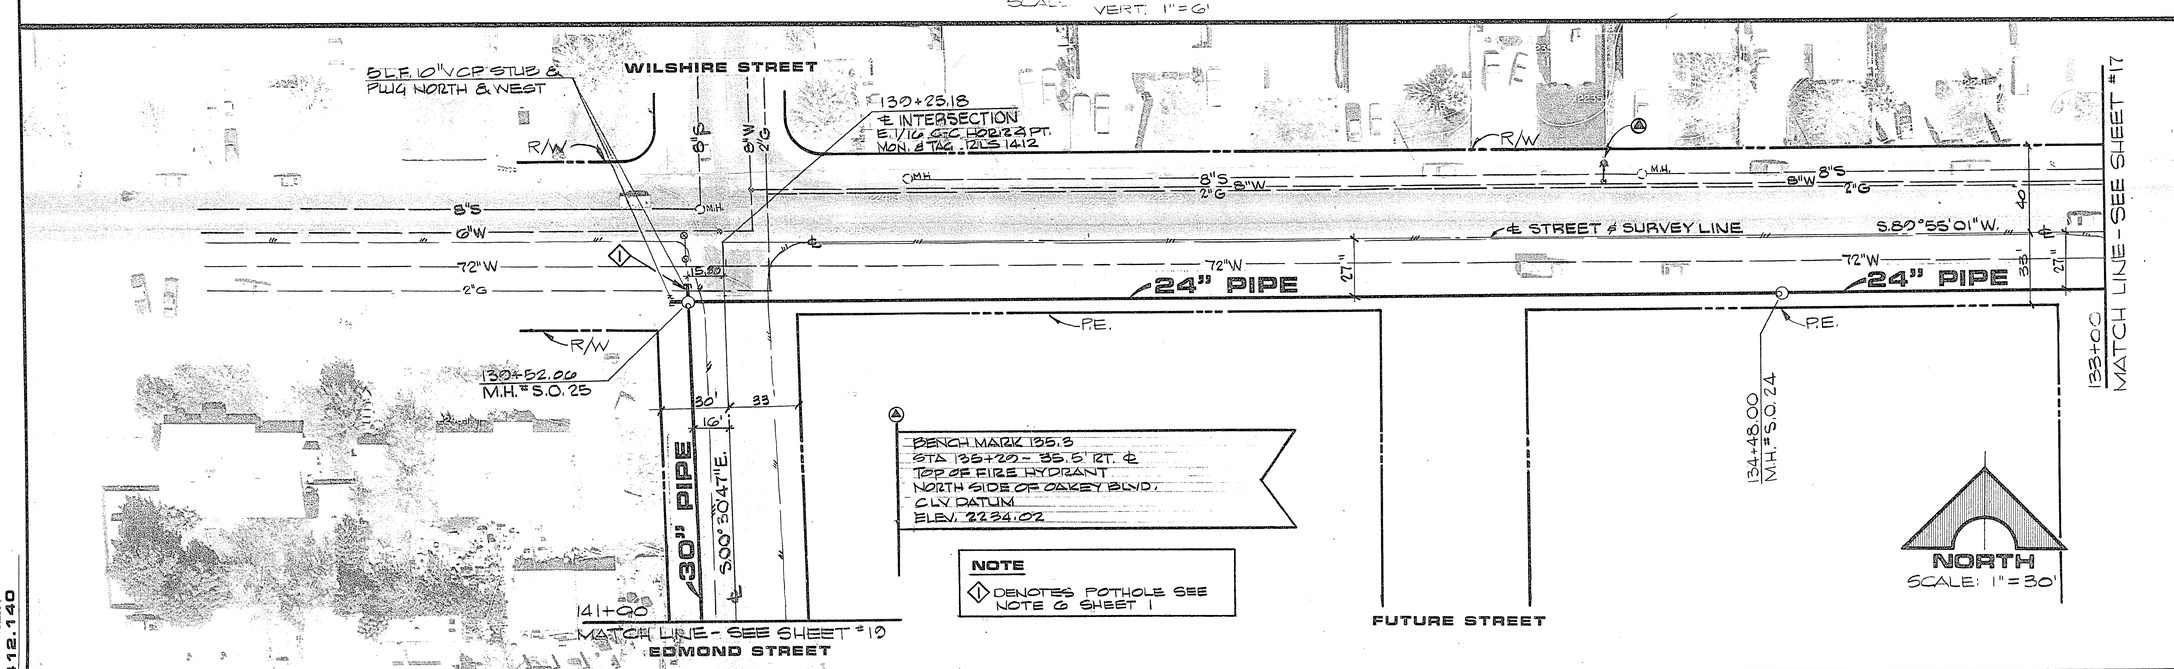

AS BUILT DRAWING

REV	DATE	DESCRIPTION
1	11/10/95	"AS BUILT" - NO REVISIONS

R.E. NO. DATE

REVIEWED BY: MICHAEL D. GRAY 12/12/95

G. C. WALLACE
Consulting Engineers, Inc.
1100 East Sahara Ave. • Las Vegas, Nevada 89104 • 732-3330

Department of Public Services
SAHARA - OAKEY SEWER INTERCEPTOR
PLAN & PROFILE 133+00 TO 141+00

SHEET 18 OF 65 SHEETS

JOB NO. 412.140

9/78 DIETERICH-POST 65328

307-V563 2-1-94