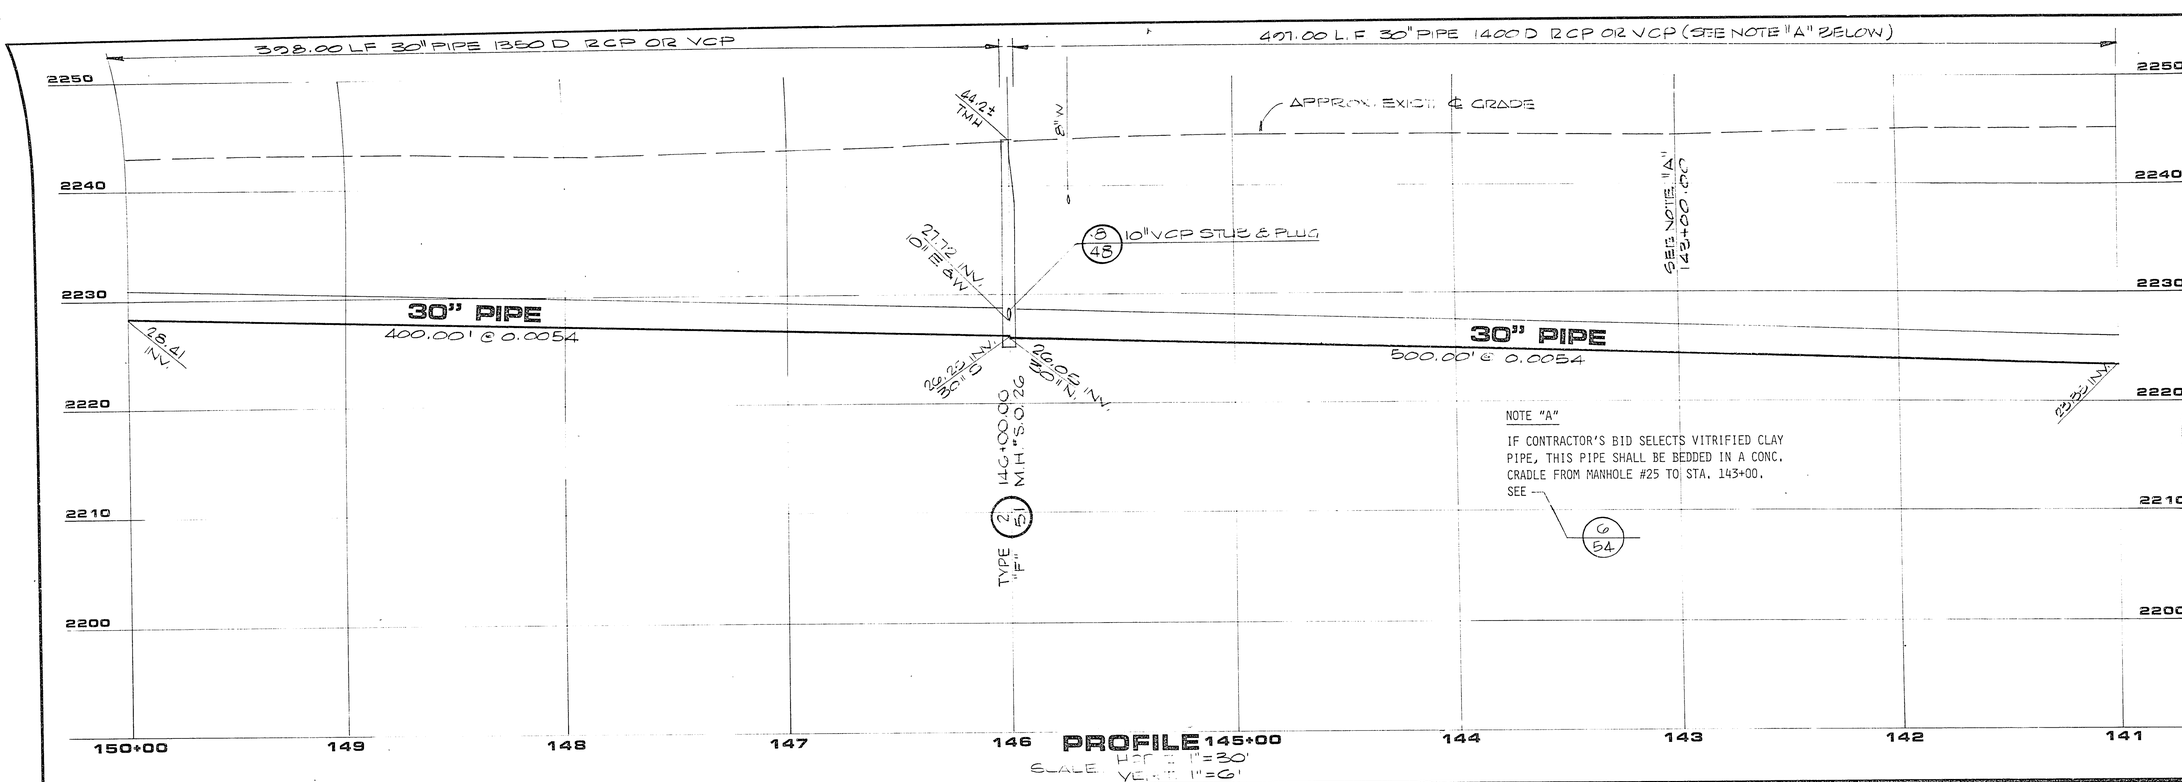

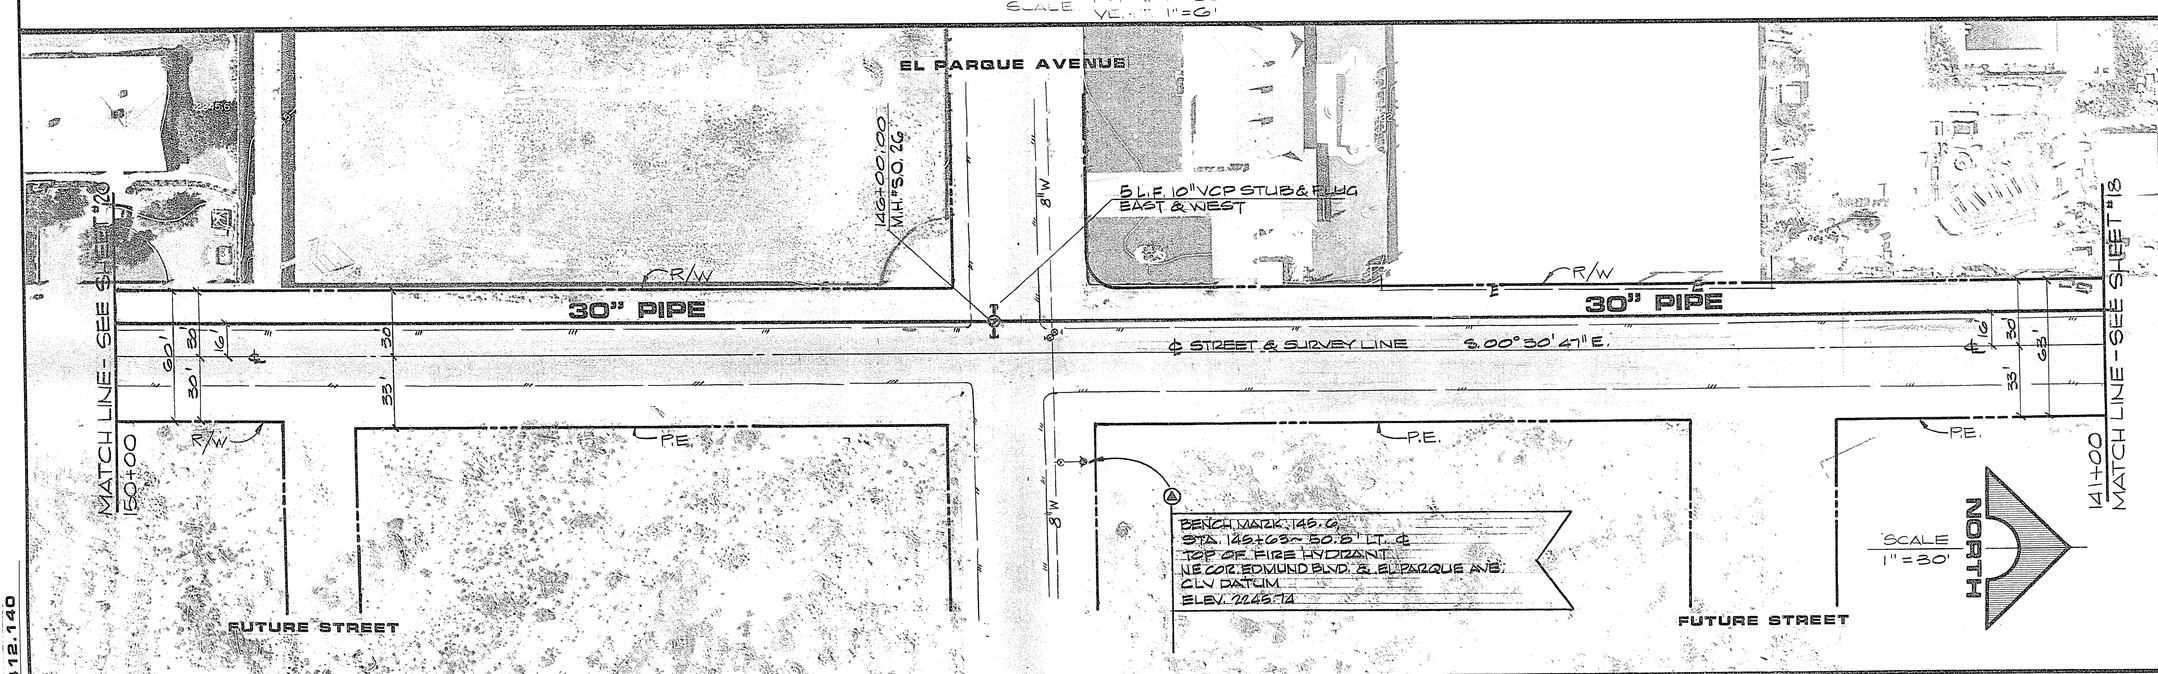

AS BUILT DRAWING

REV	DATE	DESCRIPTION
1	4/19/95	"AS BUILT" - NO REVISIONS

RE. NO. DATE

REGISTERED PROFESSIONAL ENGINEER STATE OF NEVADA

G. C. WALLACE
Consulting Engineers, Inc.
1100 East Sahara Ave. • Las Vegas, Nevada 89104 • 732-3330

Department of Public Services
SAHARA - OAKEY SEWER INTERCEPTOR
PLAN & PROFILE 141+00 TO 150+00

SHEET 19 OF 66 SHEETS

JOB NO. 412.140

9/78 DIETERICH-POST 6532B

307-V 563

3-21-95