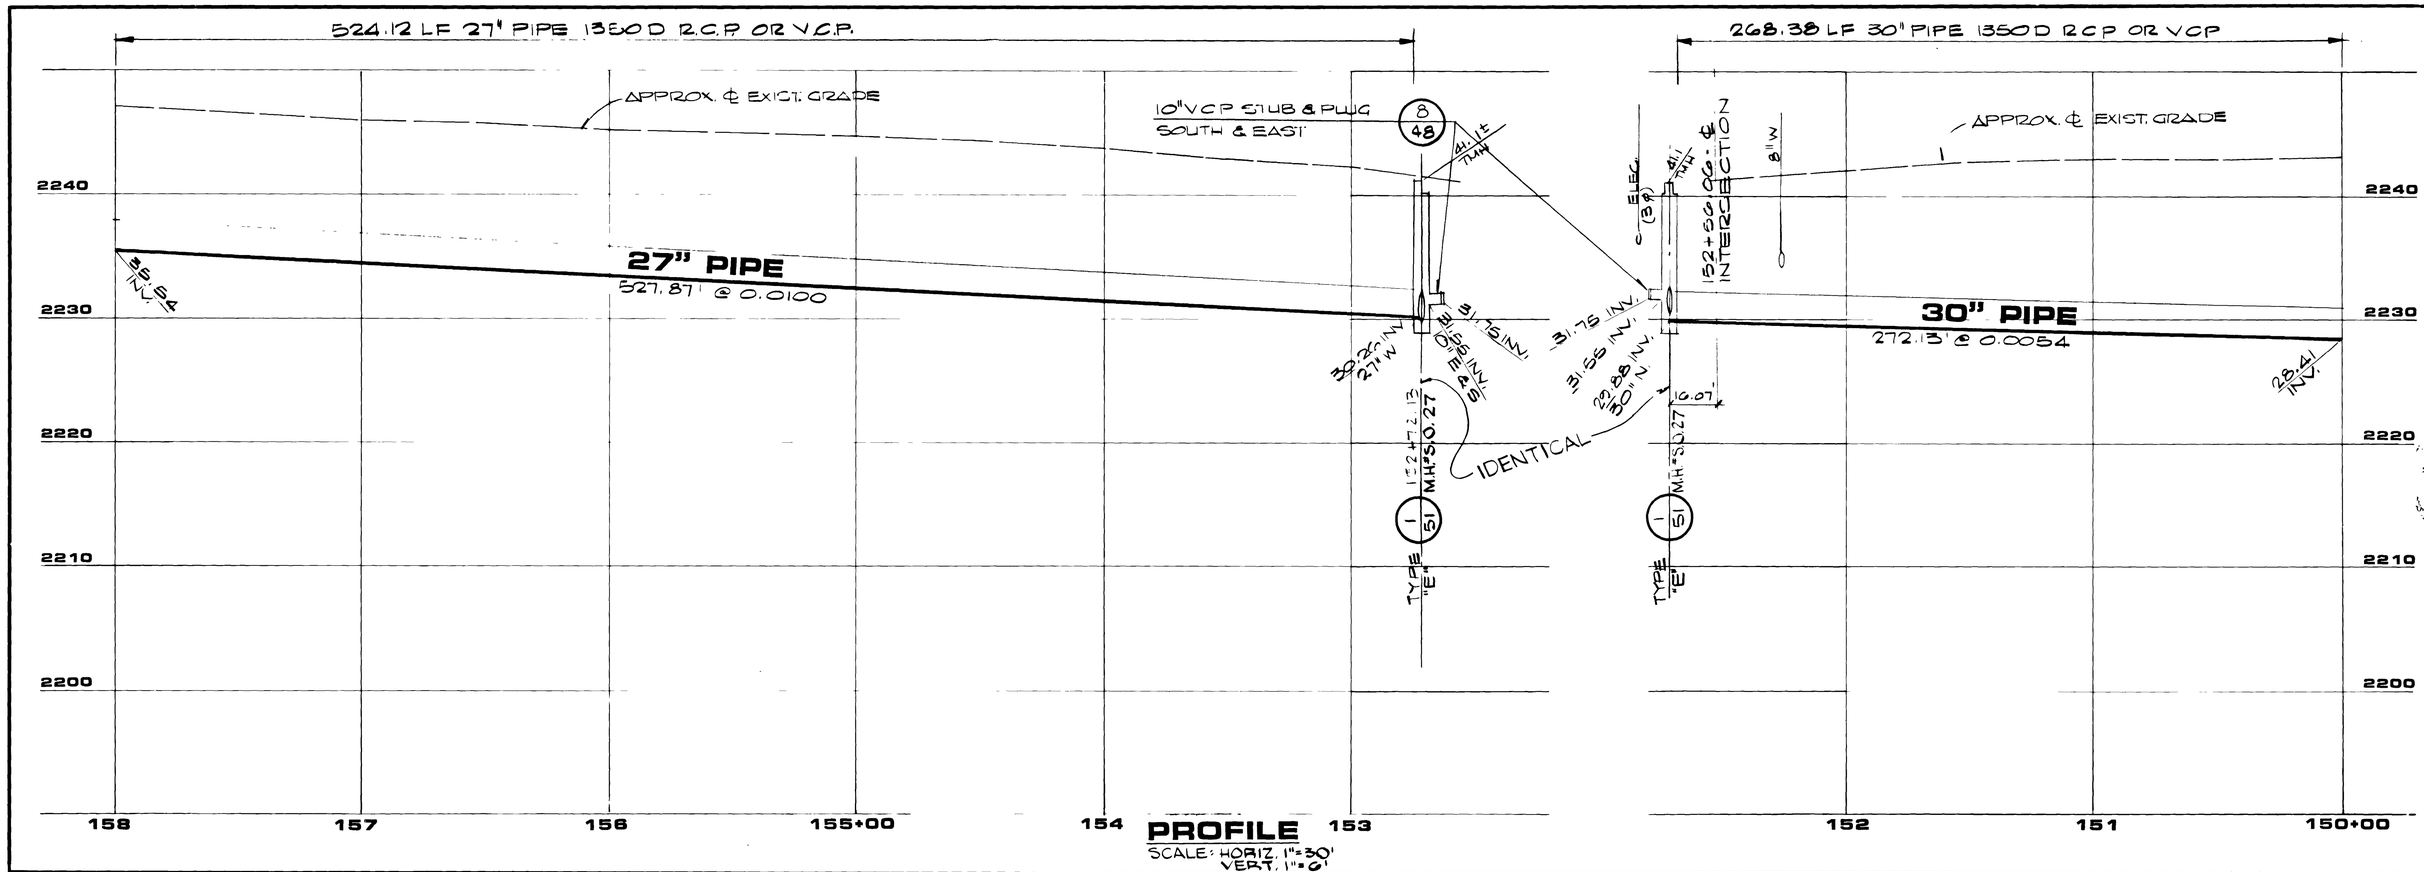

PROFILE
SCALE: HORIZ. 1"=30'
VERT. 1"=6'

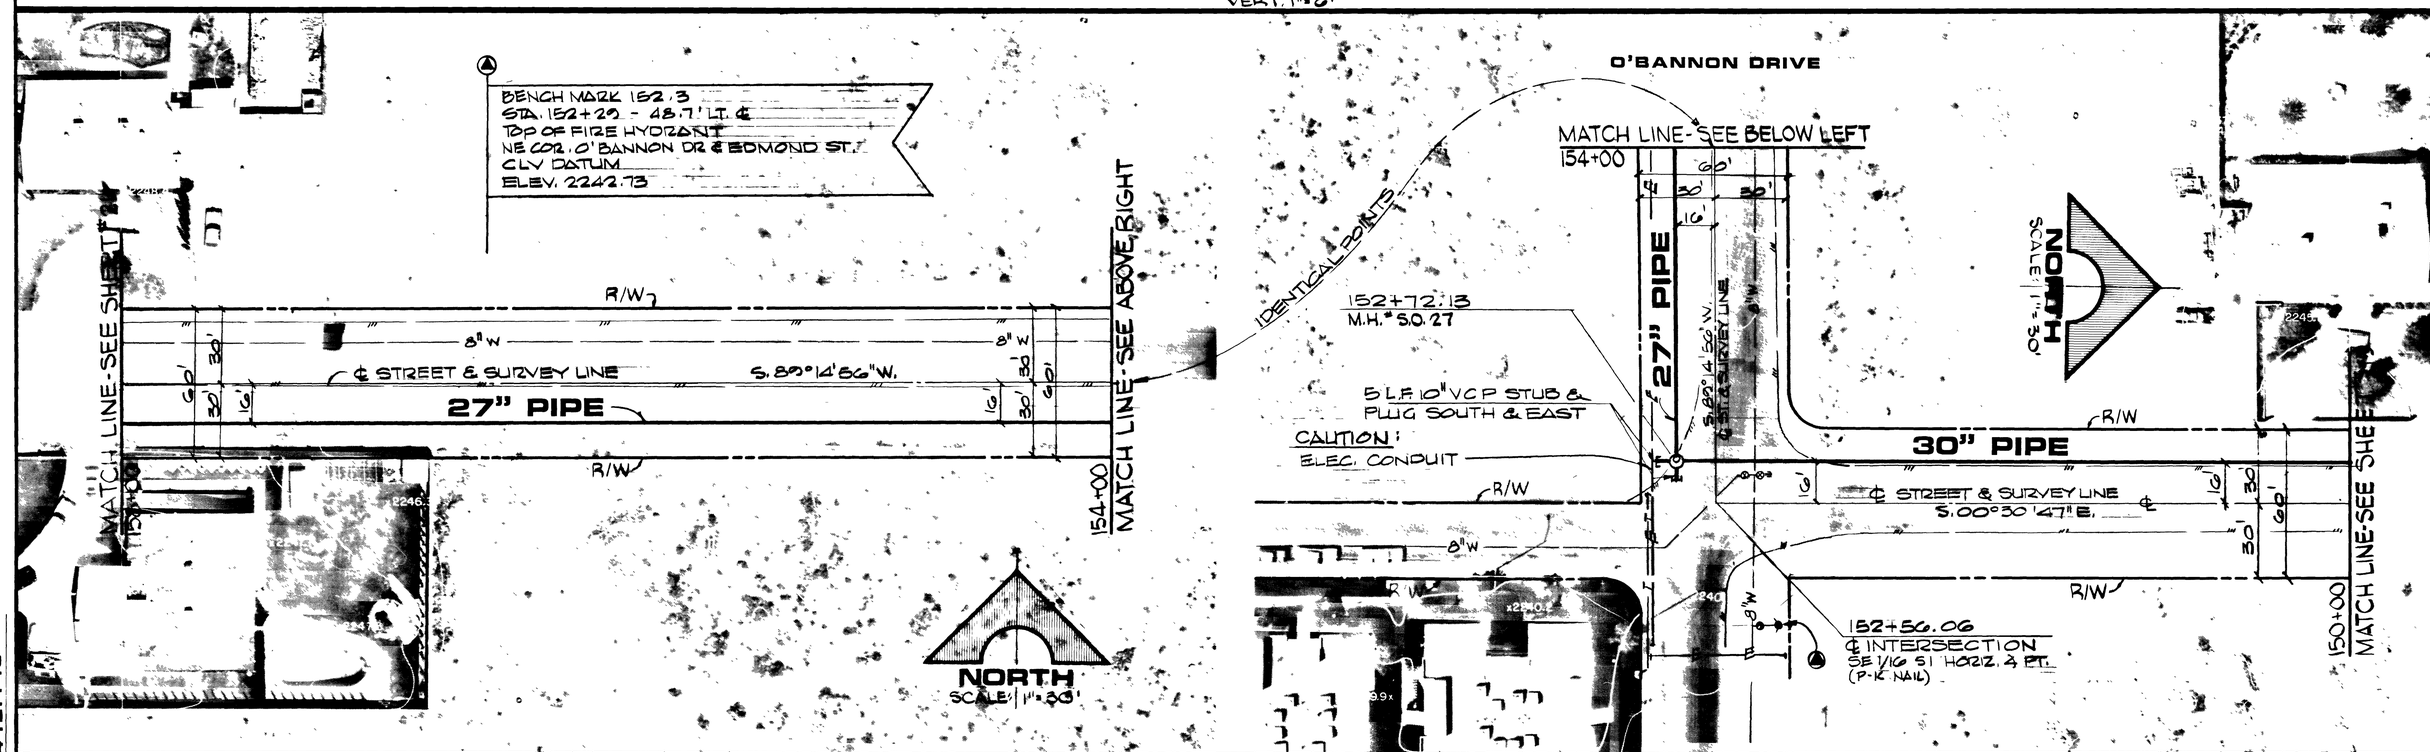

O'BANNON DRIVE EDMOND STREET

AS BUILT DRAWING

REV	DATE	DESCRIPTION
1	4/08/85	"AS BUILT" - LD REVISIONS

R.E. NO. DATE

G. C. WALLACE
Consulting Engineers, Inc.
1100 East Sahara Ave. - Las Vegas, Nevada 89104 - 732-3330

Department of Public Services
SAHARA - OAKEY SEWER INTERCEPTOR
PLAN & PROFILE 150+00 TO 158+00

SHEET 20 OF 65 SHEETS

JOB NO. 412.140

307-V 563

22-1-96