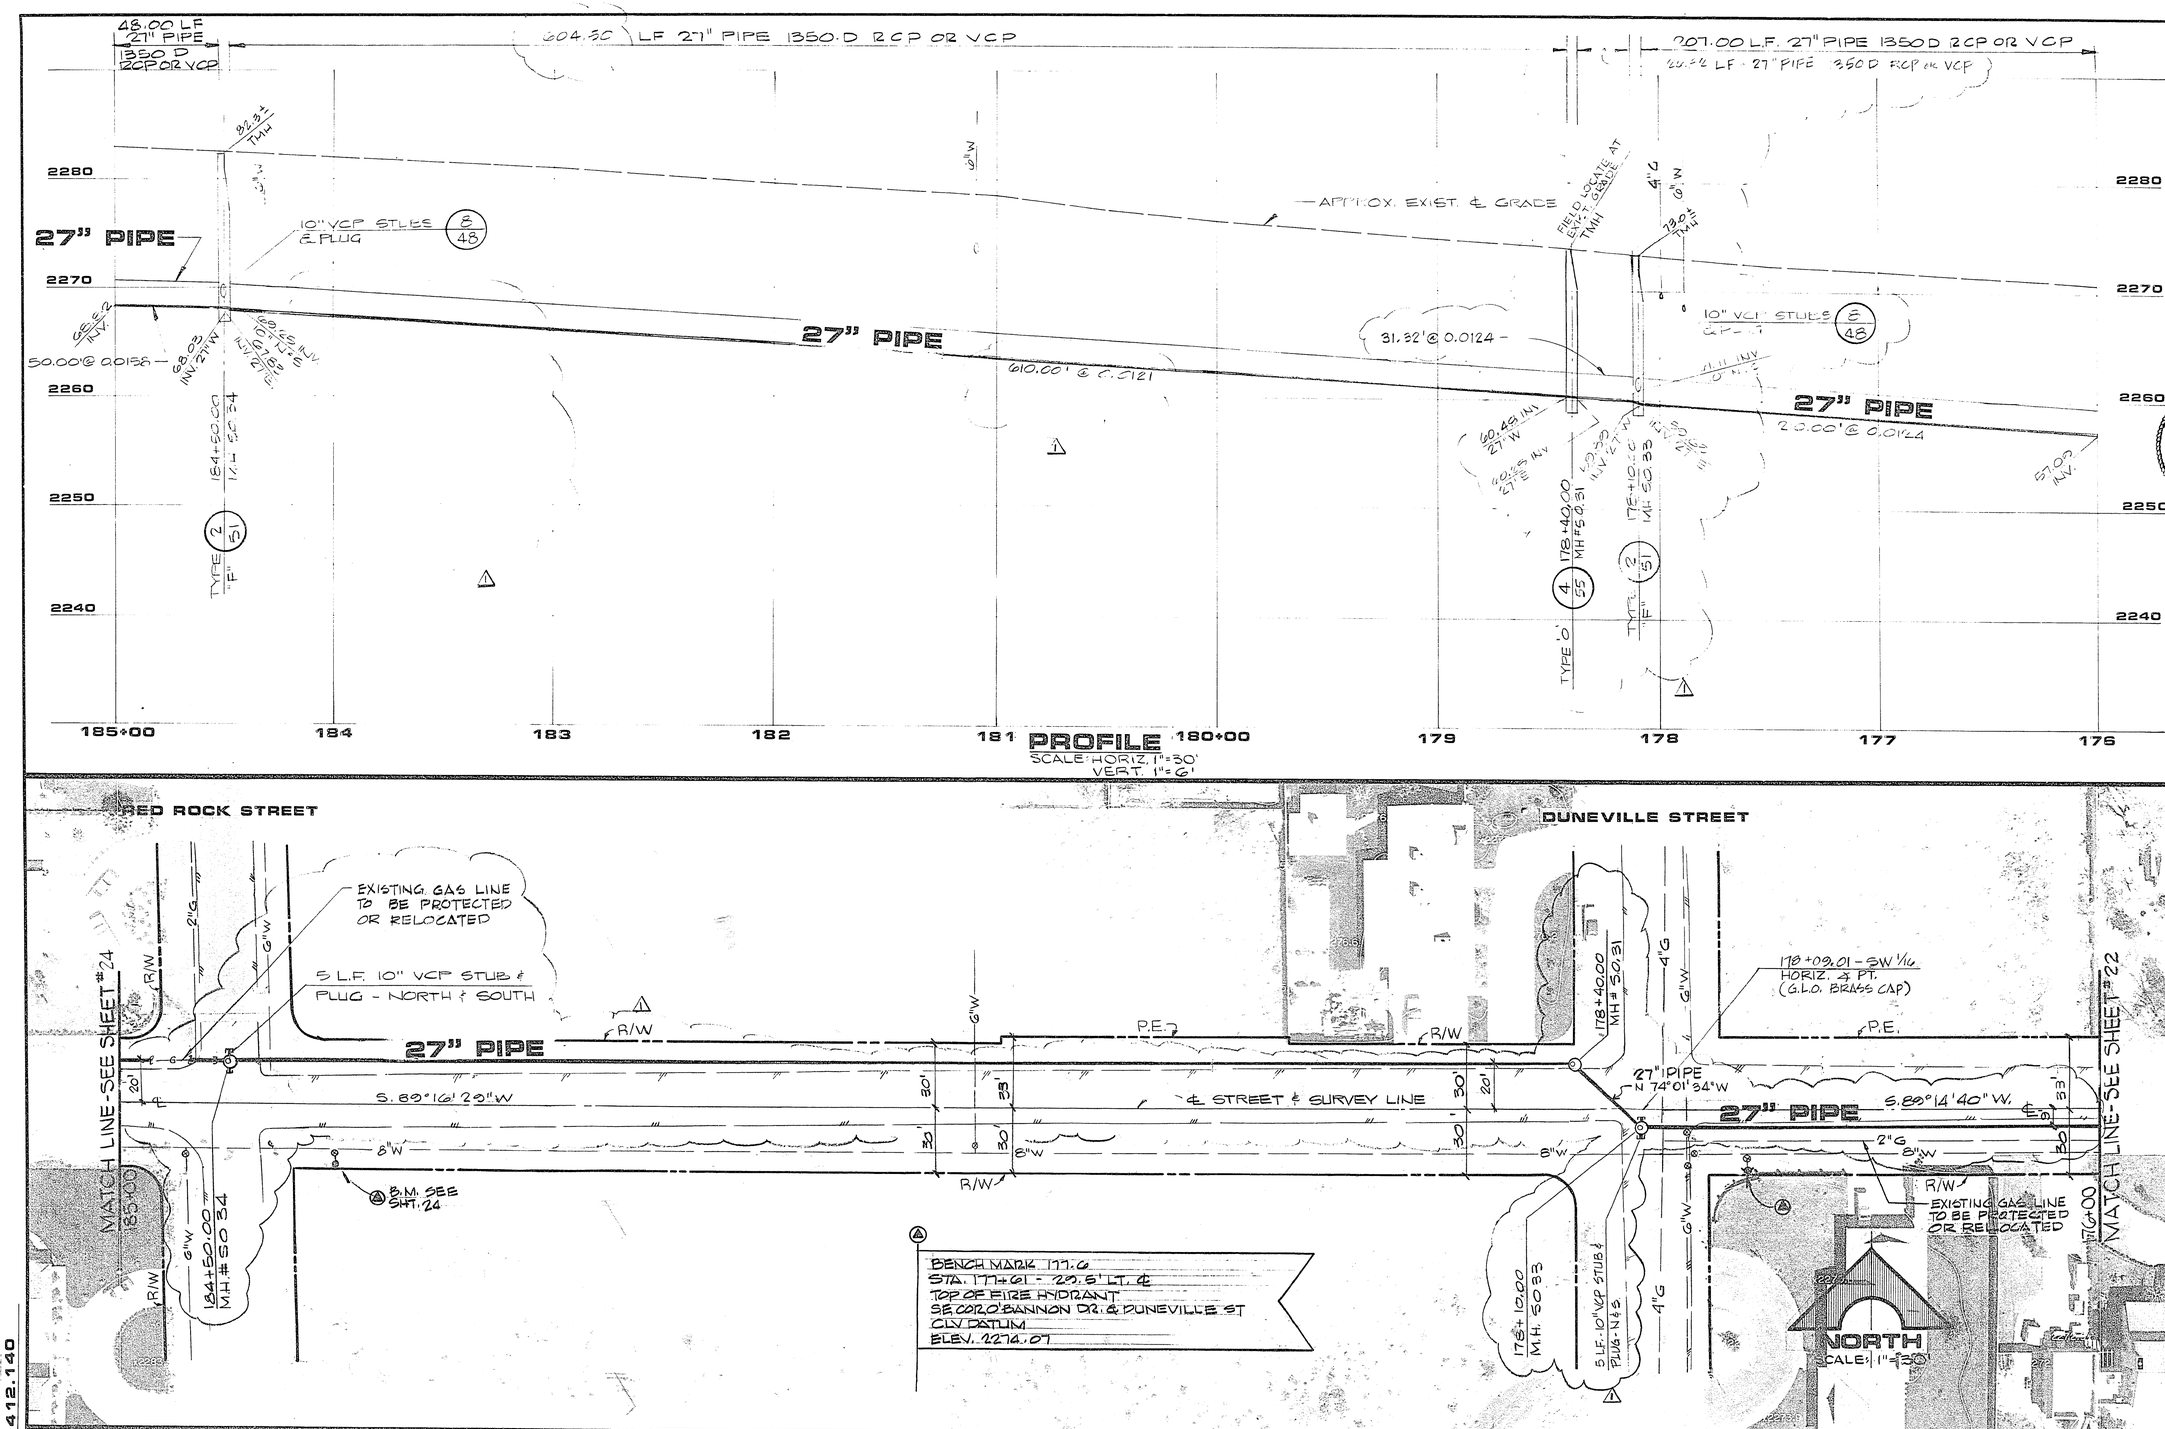

JOB NO. 412.140

AS BUILT DRAWING

REV	DATE	DESCRIPTION
1	8/6/96	FIELD ADJUSTMENT
2	1/10/96	"AS BUILT" - NO REVISIONS

R.E. NO. 7-25-97 DATE

REGISTERED PROFESSIONAL ENGINEER - STATE OF NEVADA - MICHAEL D. ROSS - CIVIL

G. C. WALLACE
Consulting Engineers, Inc.
1100 East Sahara Ave. • Las Vegas, Nevada 89104 • 732-3330

Department of Public Services
SAHARA - OAKEY SEWER INTERCEPTOR
PLAN & PROFILE 176+00 TO 185+00

SHEET 23 OF 65 SHEETS

307-V 563

9/78 DIETERICH-POST 65328