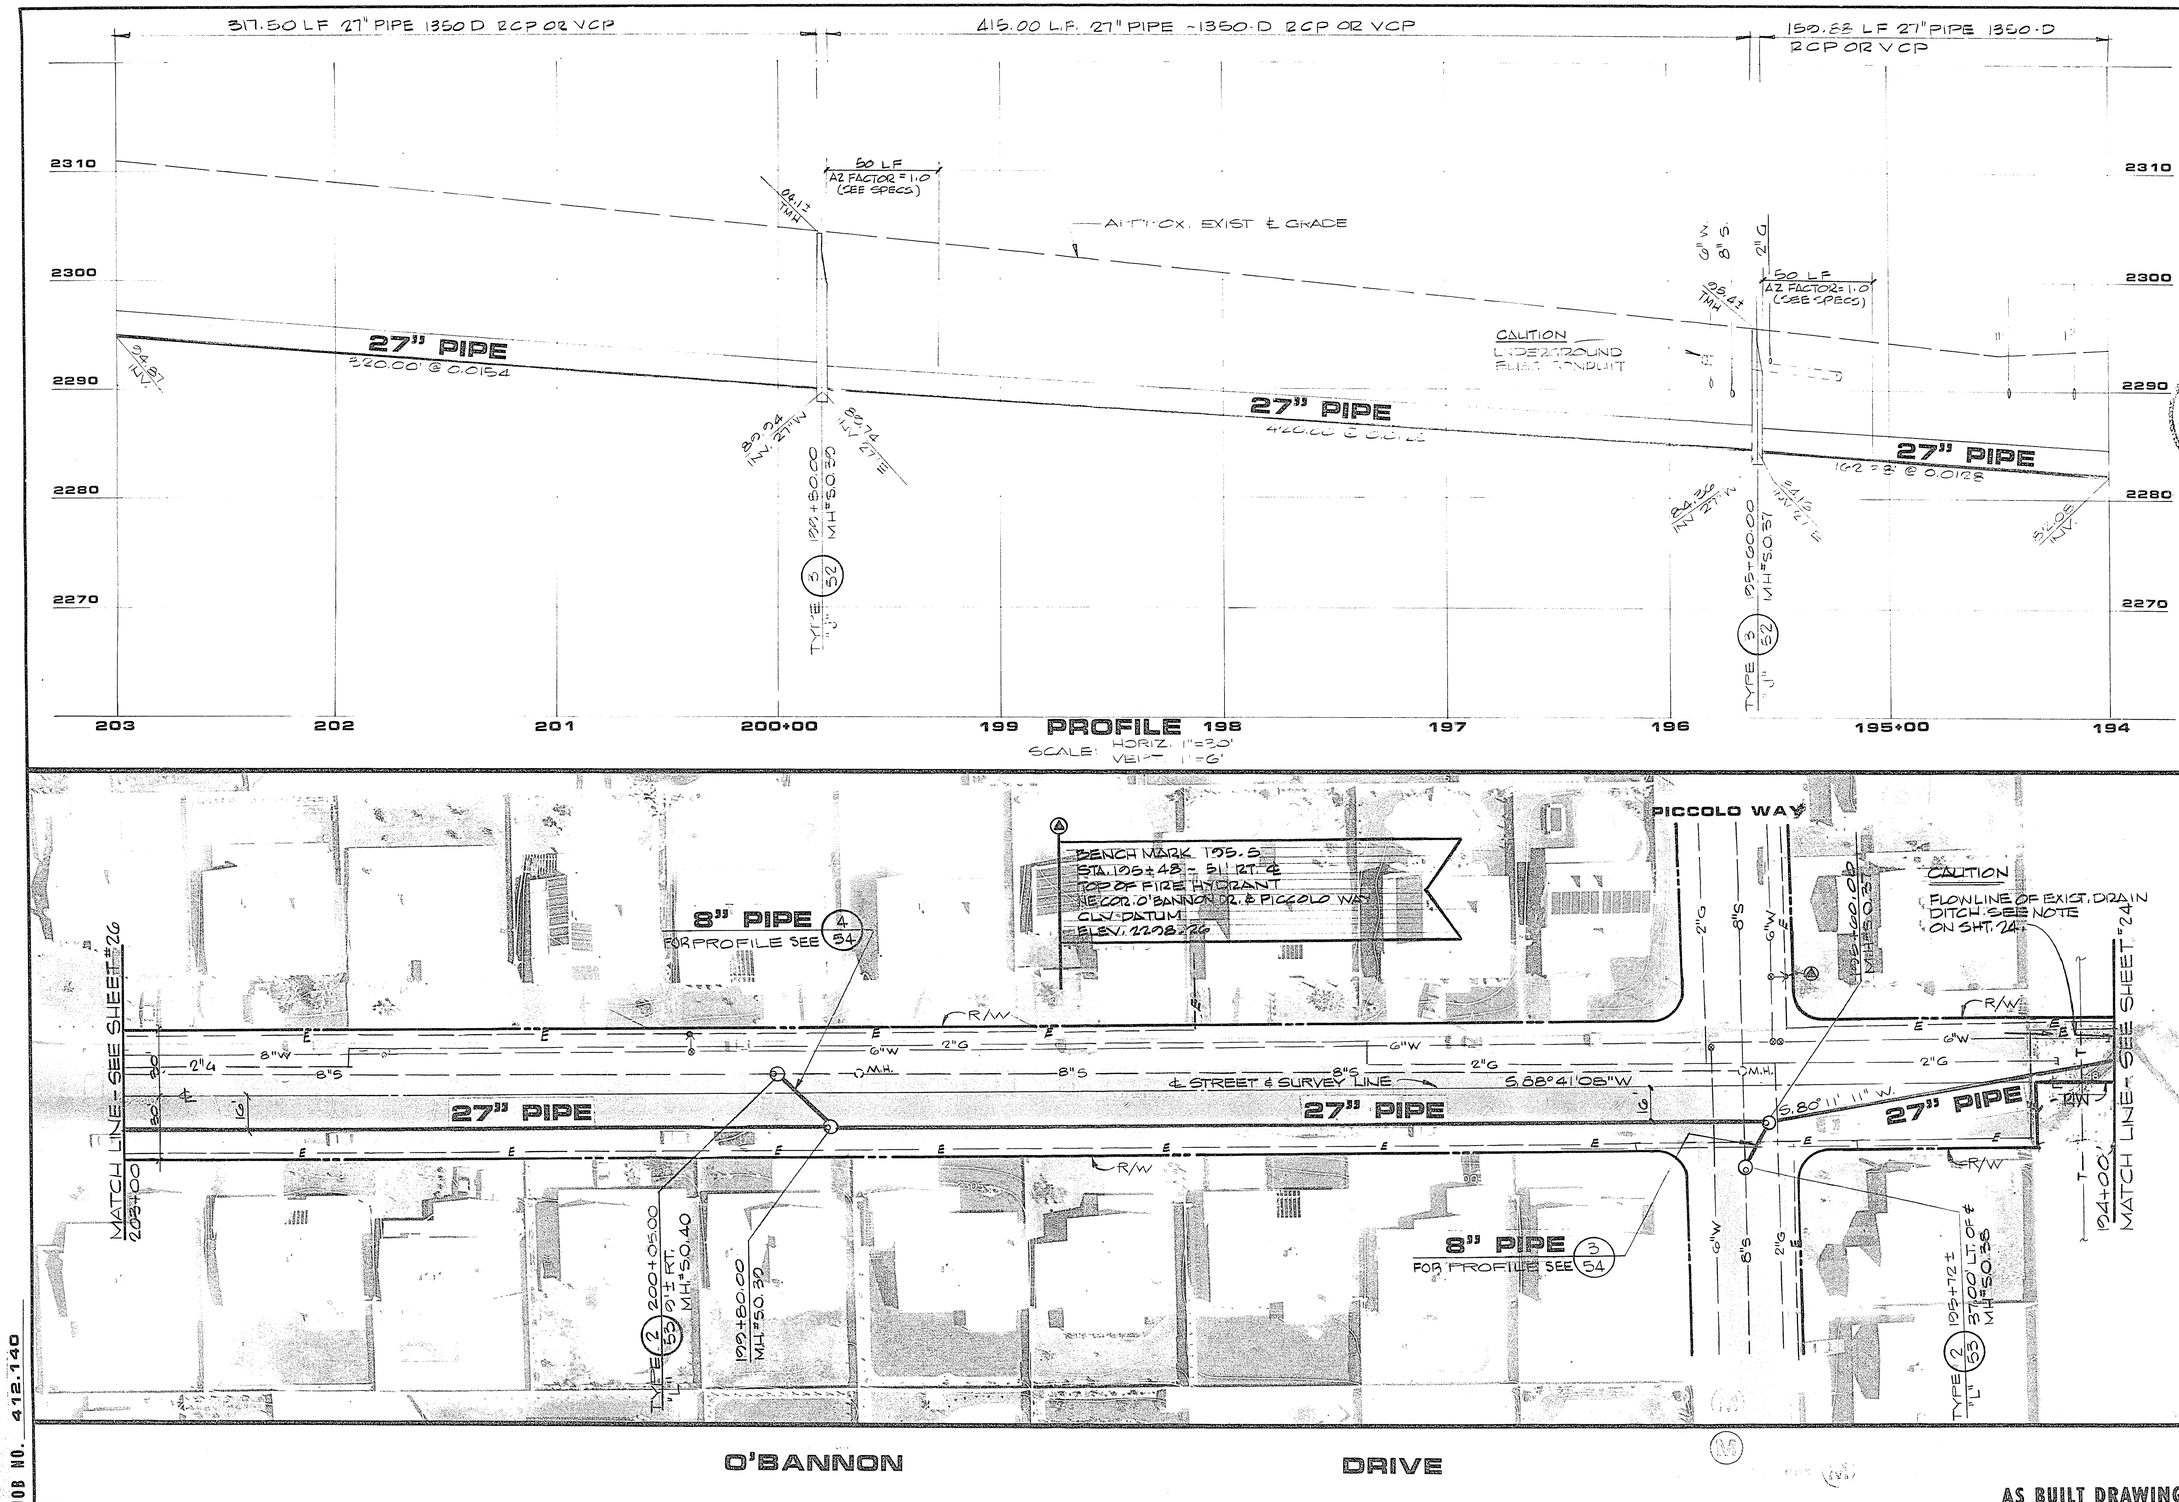

REV	DATE	DESCRIPTION
1	4/19/85	"AS BUILT" - NO REVISIONS

R.E. NO. 7-2-10 DATE

HEREBY CERTIFY THAT THIS PLAN WAS PREPARED BY ME OR UNDER MY SUPERVISION AND THAT I AM A REGISTERED PROFESSIONAL ENGINEER UNDER THE LAWS OF THE STATE OF NEVADA
MICHAEL D. ROSS
CIVIL
No. 9262

G. C. WALLACE
Consulting Engineers, Inc.
1100 East Sahara Ave. · Las Vegas, Nevada 89104 · 732-3330

Department of Public Services
SAHARA - OAKEY SEWER INTERCEPTOR
PLAN & PROFILE 194+00 TO 203+00

SHEET
25
OF 65 SHEETS

JOB NO. 412.140

9/78 DIETERICH-POST 65328

307-V563

72-1-101