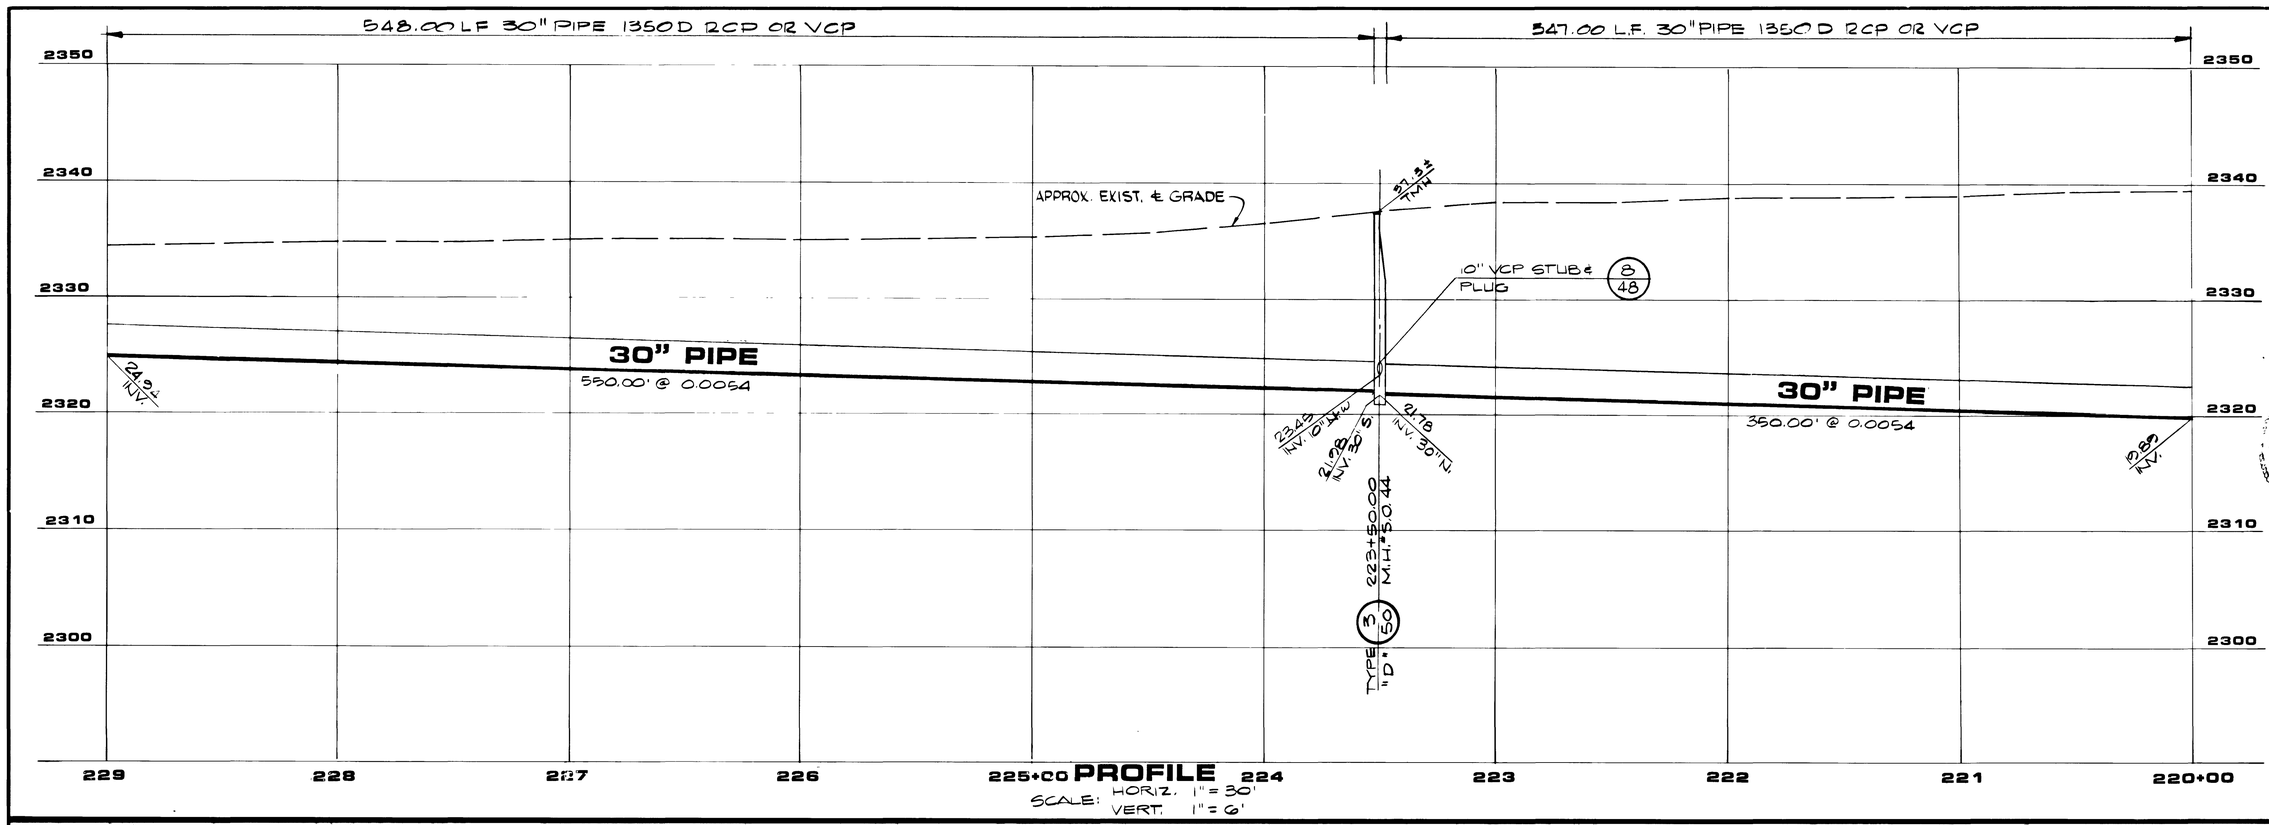

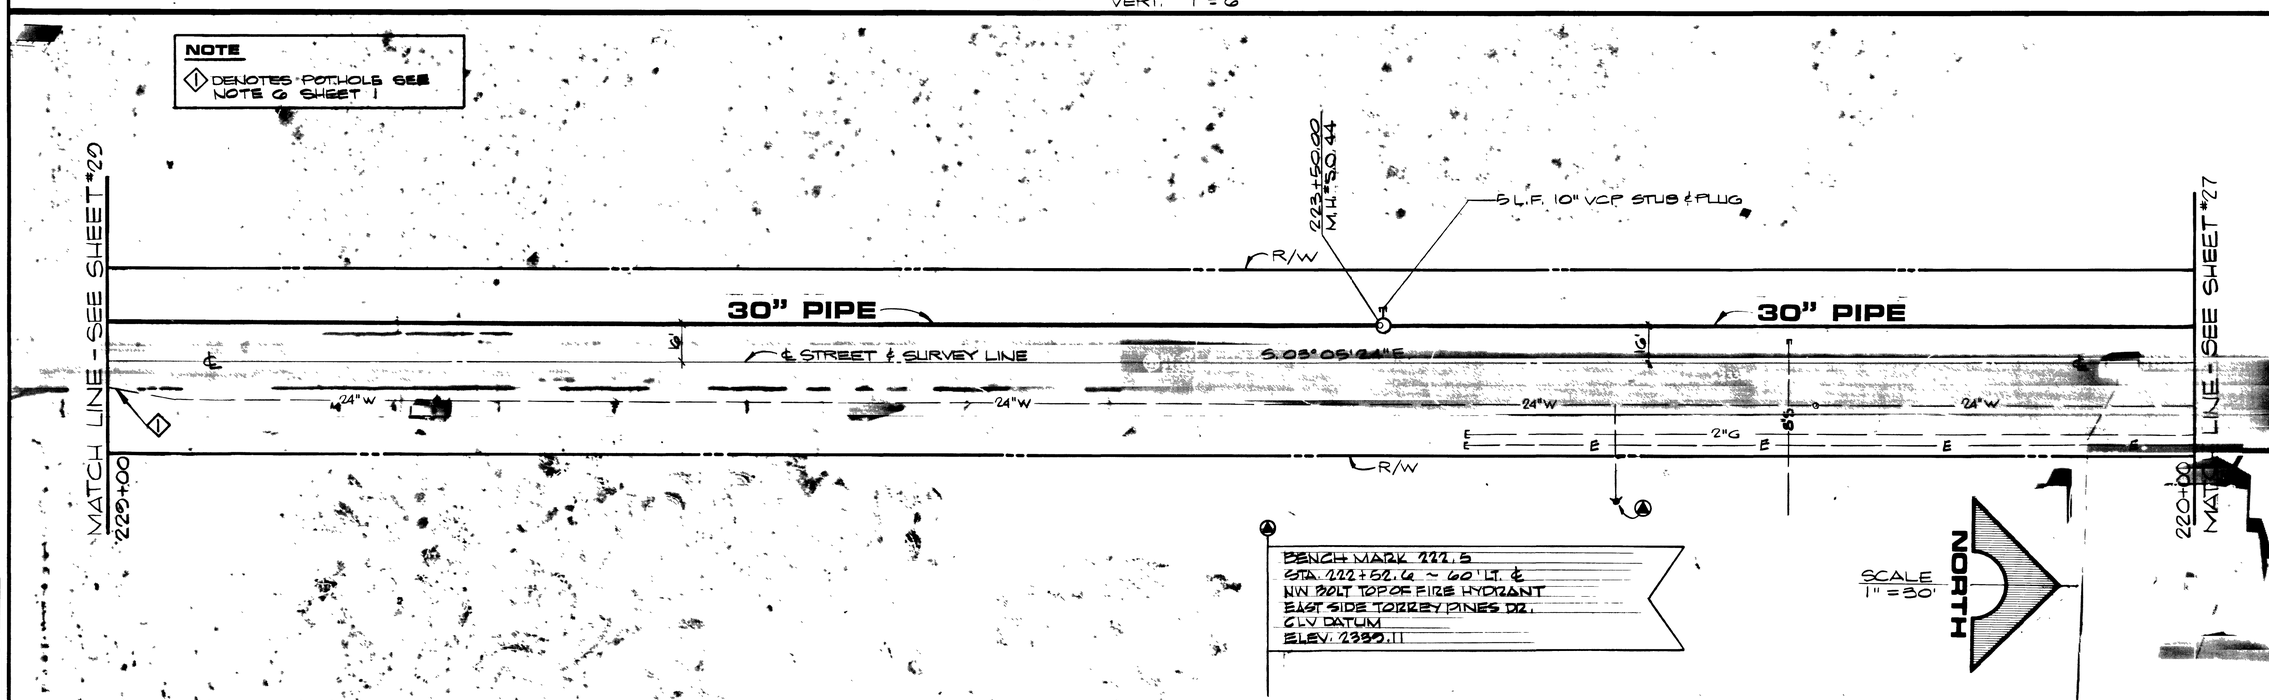

TORREY PINES DRIVE

AS BUILT DRAWING

JUN 2 1986

REV	DATE	DESCRIPTION
1	4/28/85	"AS BUILT" - NO REVISIONS

R.E. NO. 22-1-104 DATE

R.E. NO. MICHAEL D. ROSS CIVIL

G. C. WALLACE
Consulting Engineers, Inc.
1100 East Sahara Ave. • Las Vegas, Nevada 89104 • 732-3330

Department of Public Services
SAHARA - DAKEY SEWER INTERCEPTOR
PLAN & PROFILE 220+00 TO 229+00

SHEET 28 OF 65 SHEETS

JOB NO. 412.140

9/78 DIETERICH-POST 66339

307-V 563 22-1-104

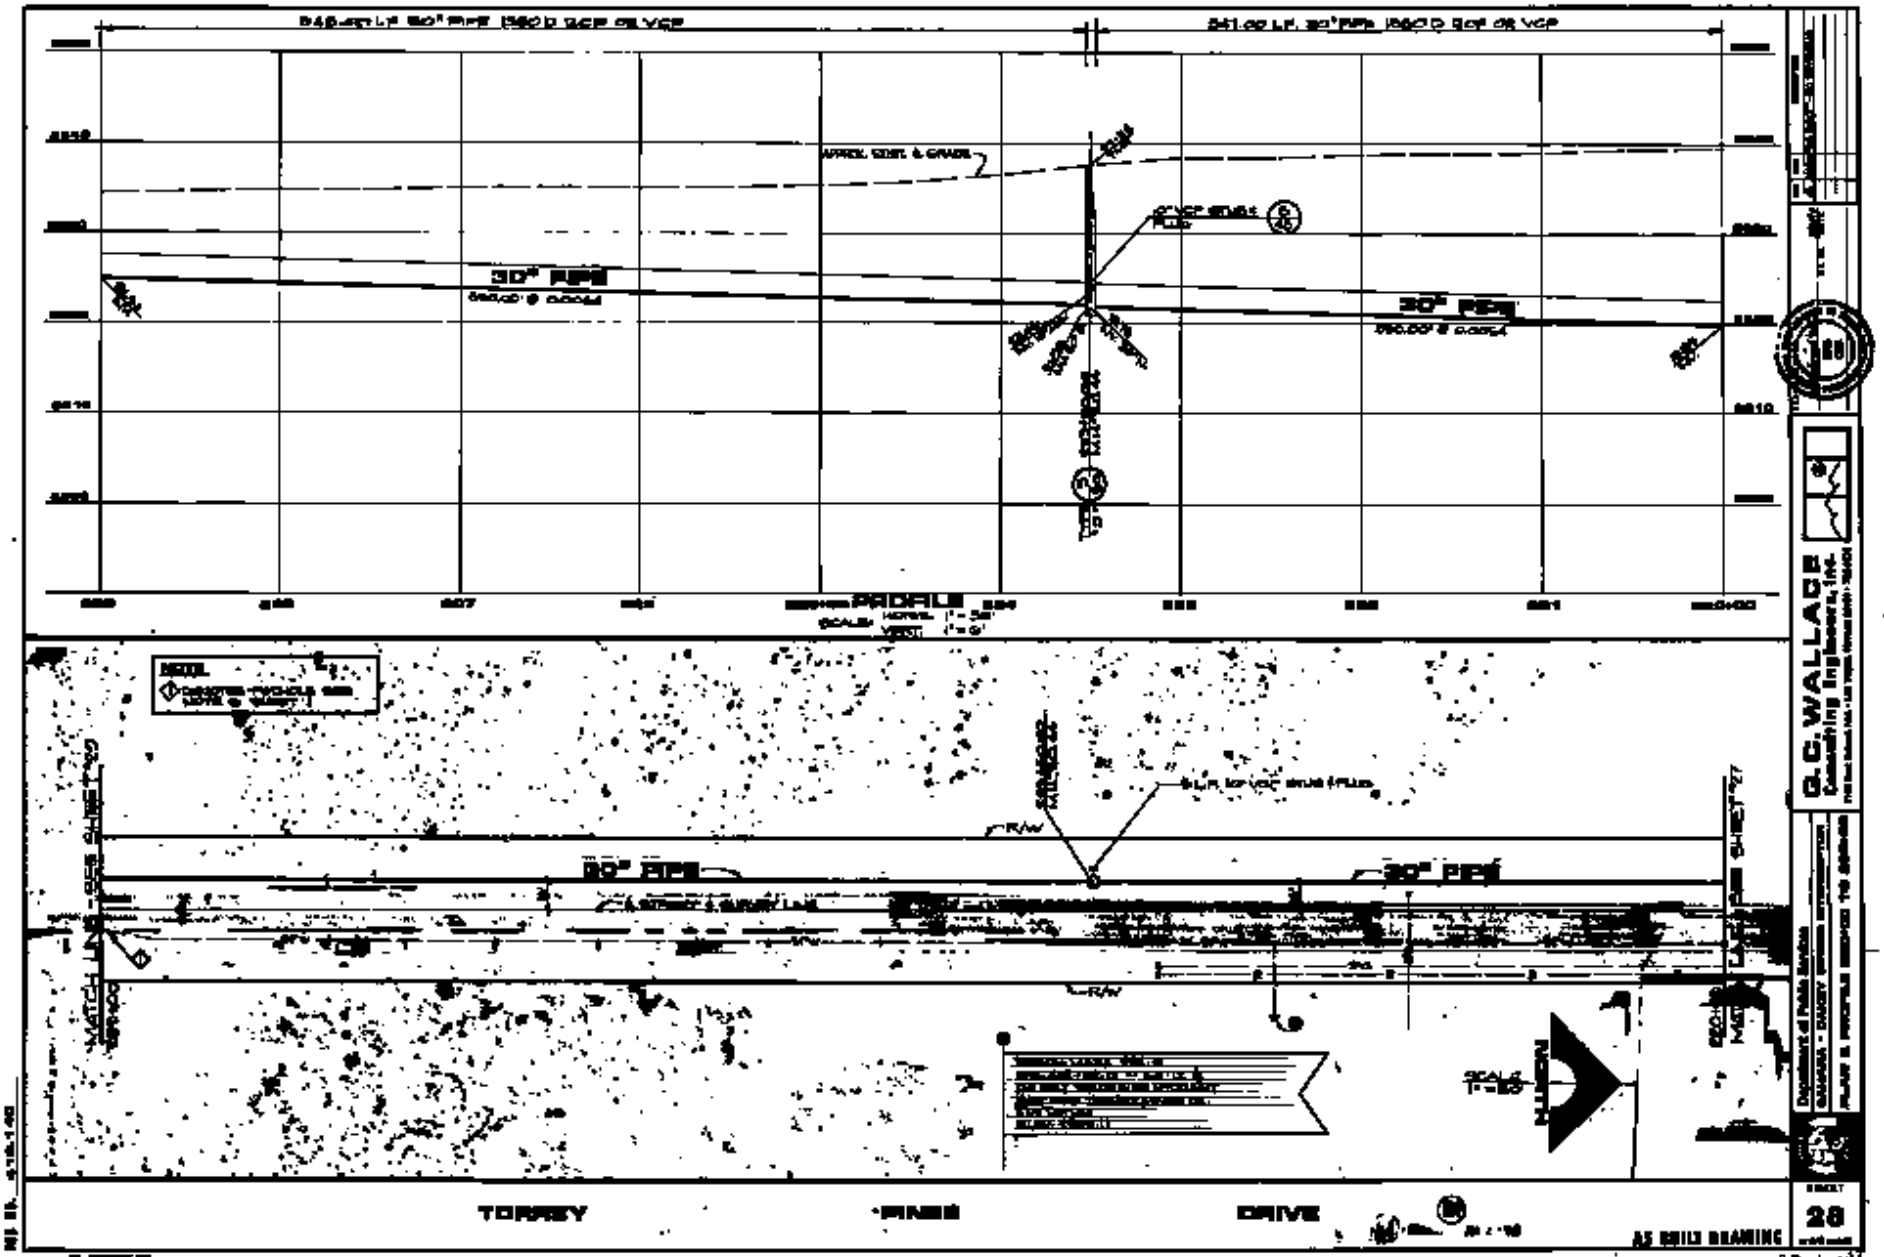
PROFILE
TORREY
PINES
DRIVE
AS BUILT DRAWING
G.C. WALLACE
Consulting Engineers, Inc.
28