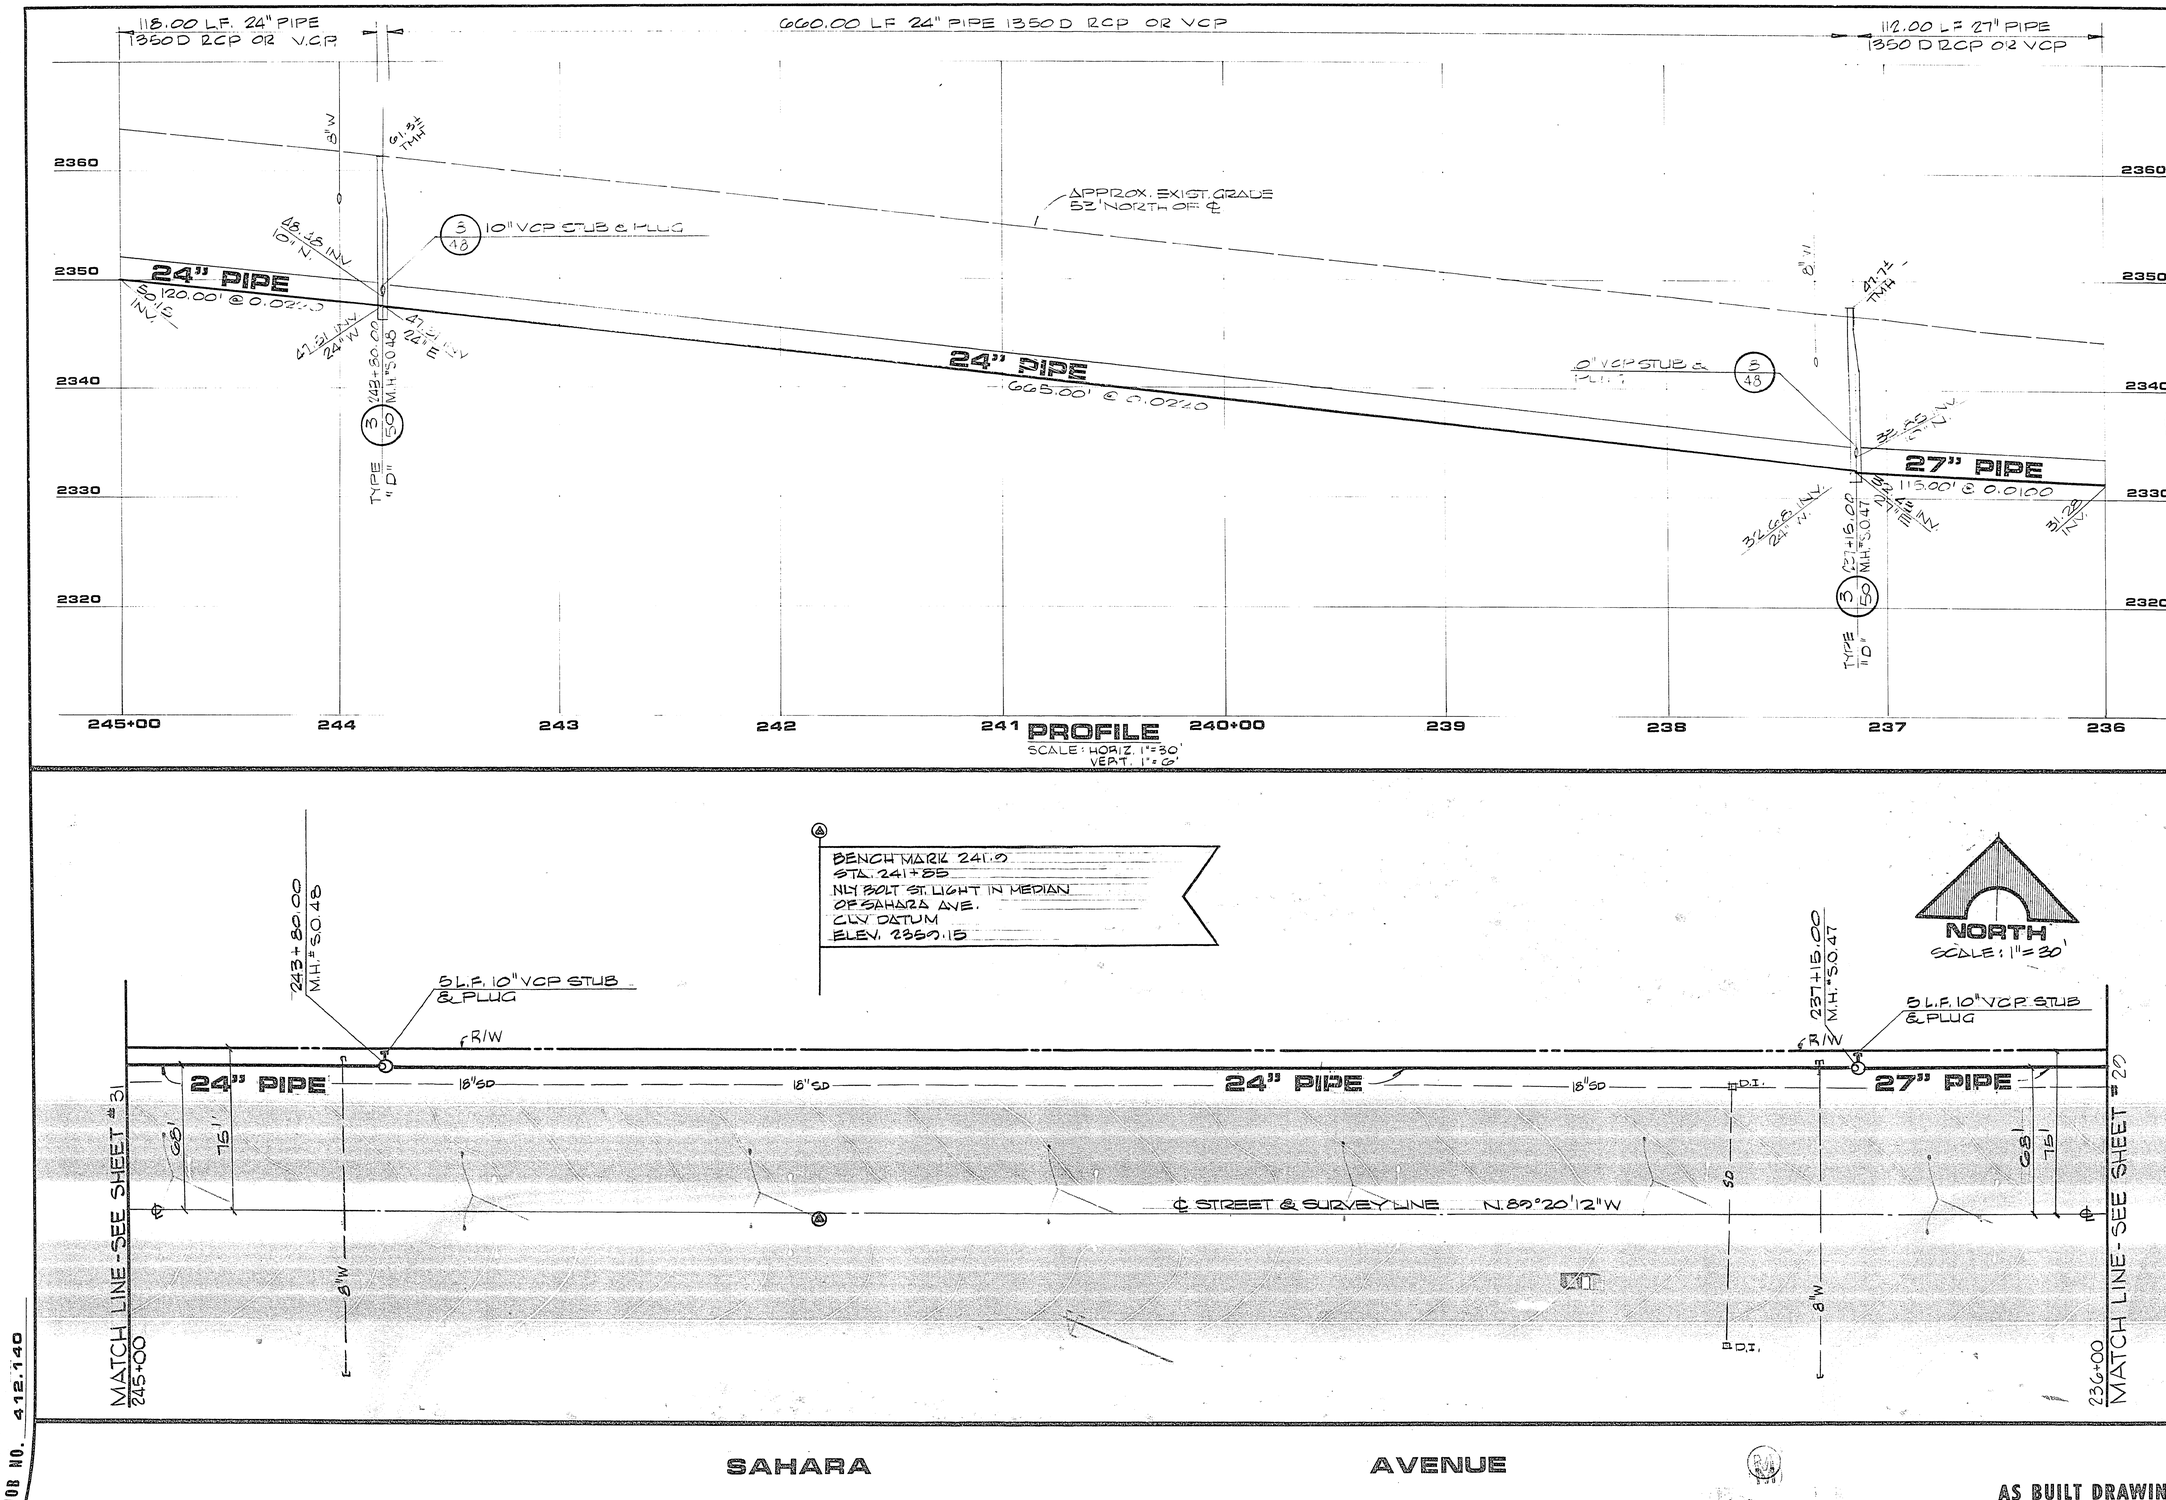

JOB NO. 412.140

AS BUILT DRAWING

REV	DATE	DESCRIPTION
1	4/19/86	"AS BUILT" - NO REVISIONS

R.E. NO. DATE

DOCUMENT NO. 7210

REGISTERED PROFESSIONAL ENGINEER
JAMES C. BOSS
C.V.I.

G. C. WALLACE
Consulting Engineers, Inc.
1100 East Sahara Ave. - Las Vegas, Nevada 89104 - 732-3330

Department of Public Services
SAHARA - OAKEY SEWER INTERCEPTOR
PLAN & PROFILE 236+00 TO 245+00

SHEET 30 OF 68 SHEETS

9/78 DIETERICH-POST 65328

307-V 563 27-1-86