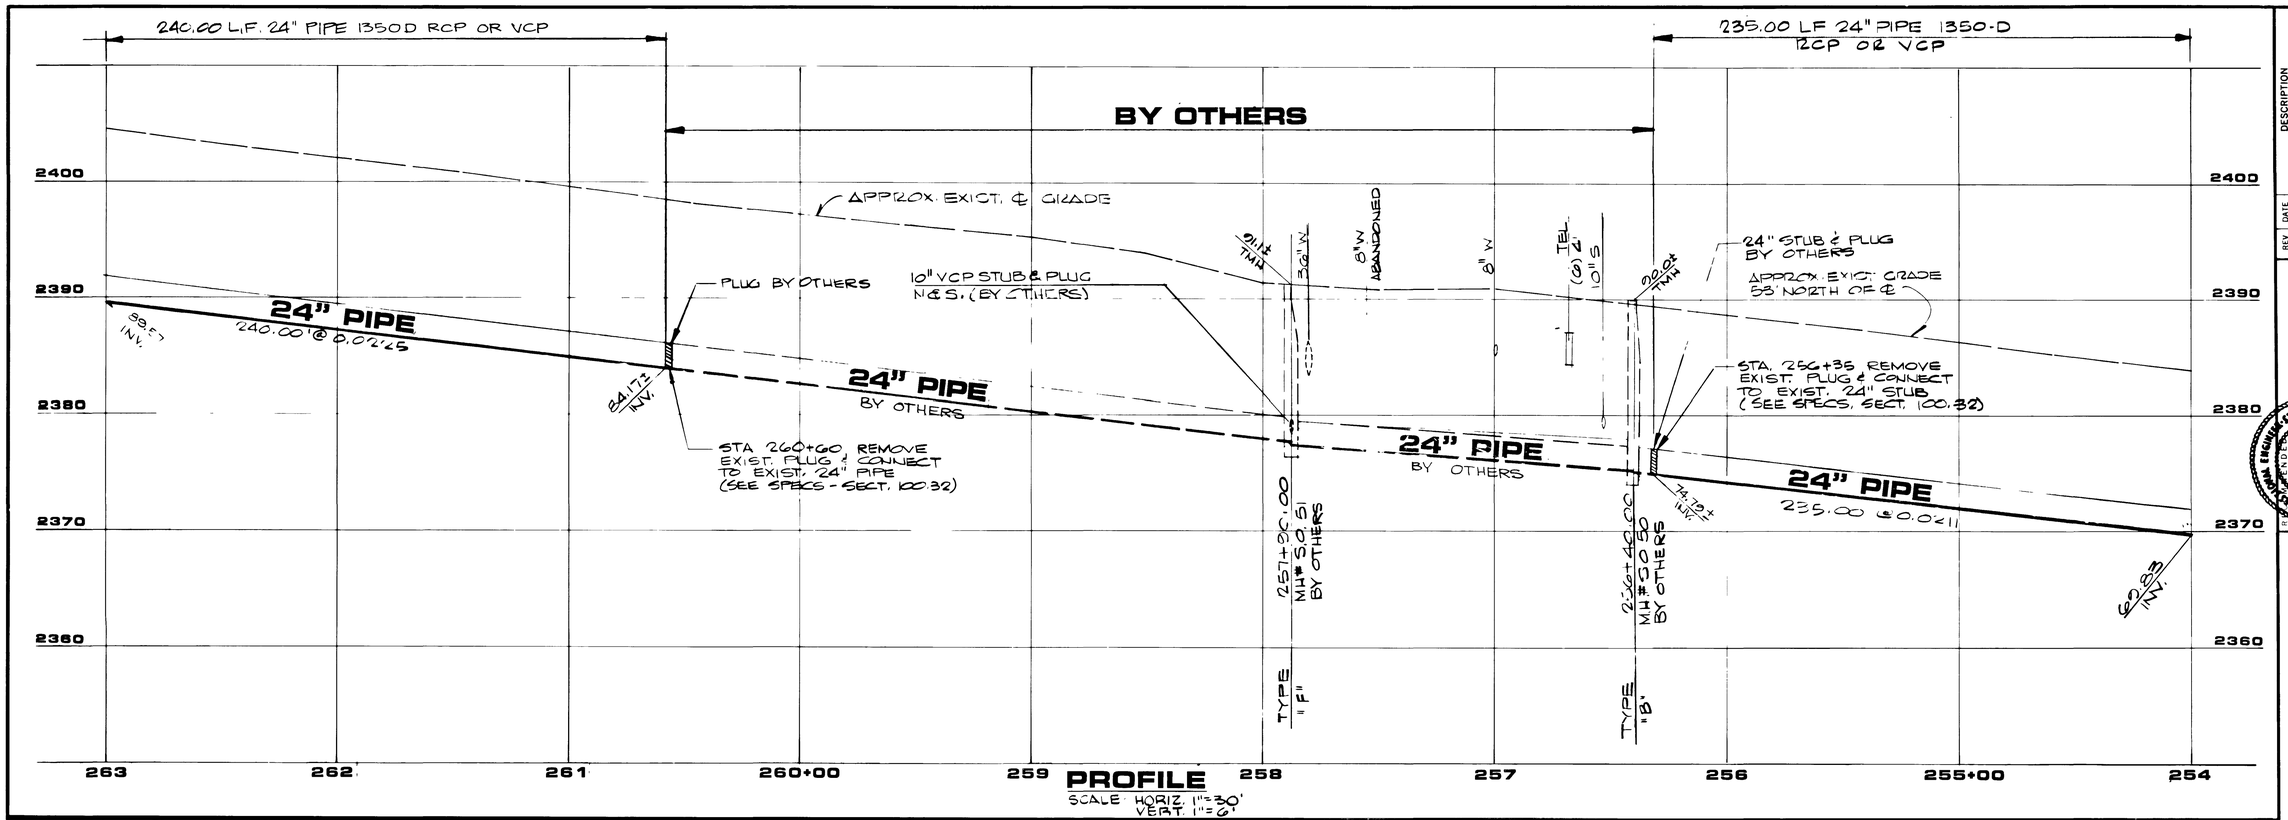

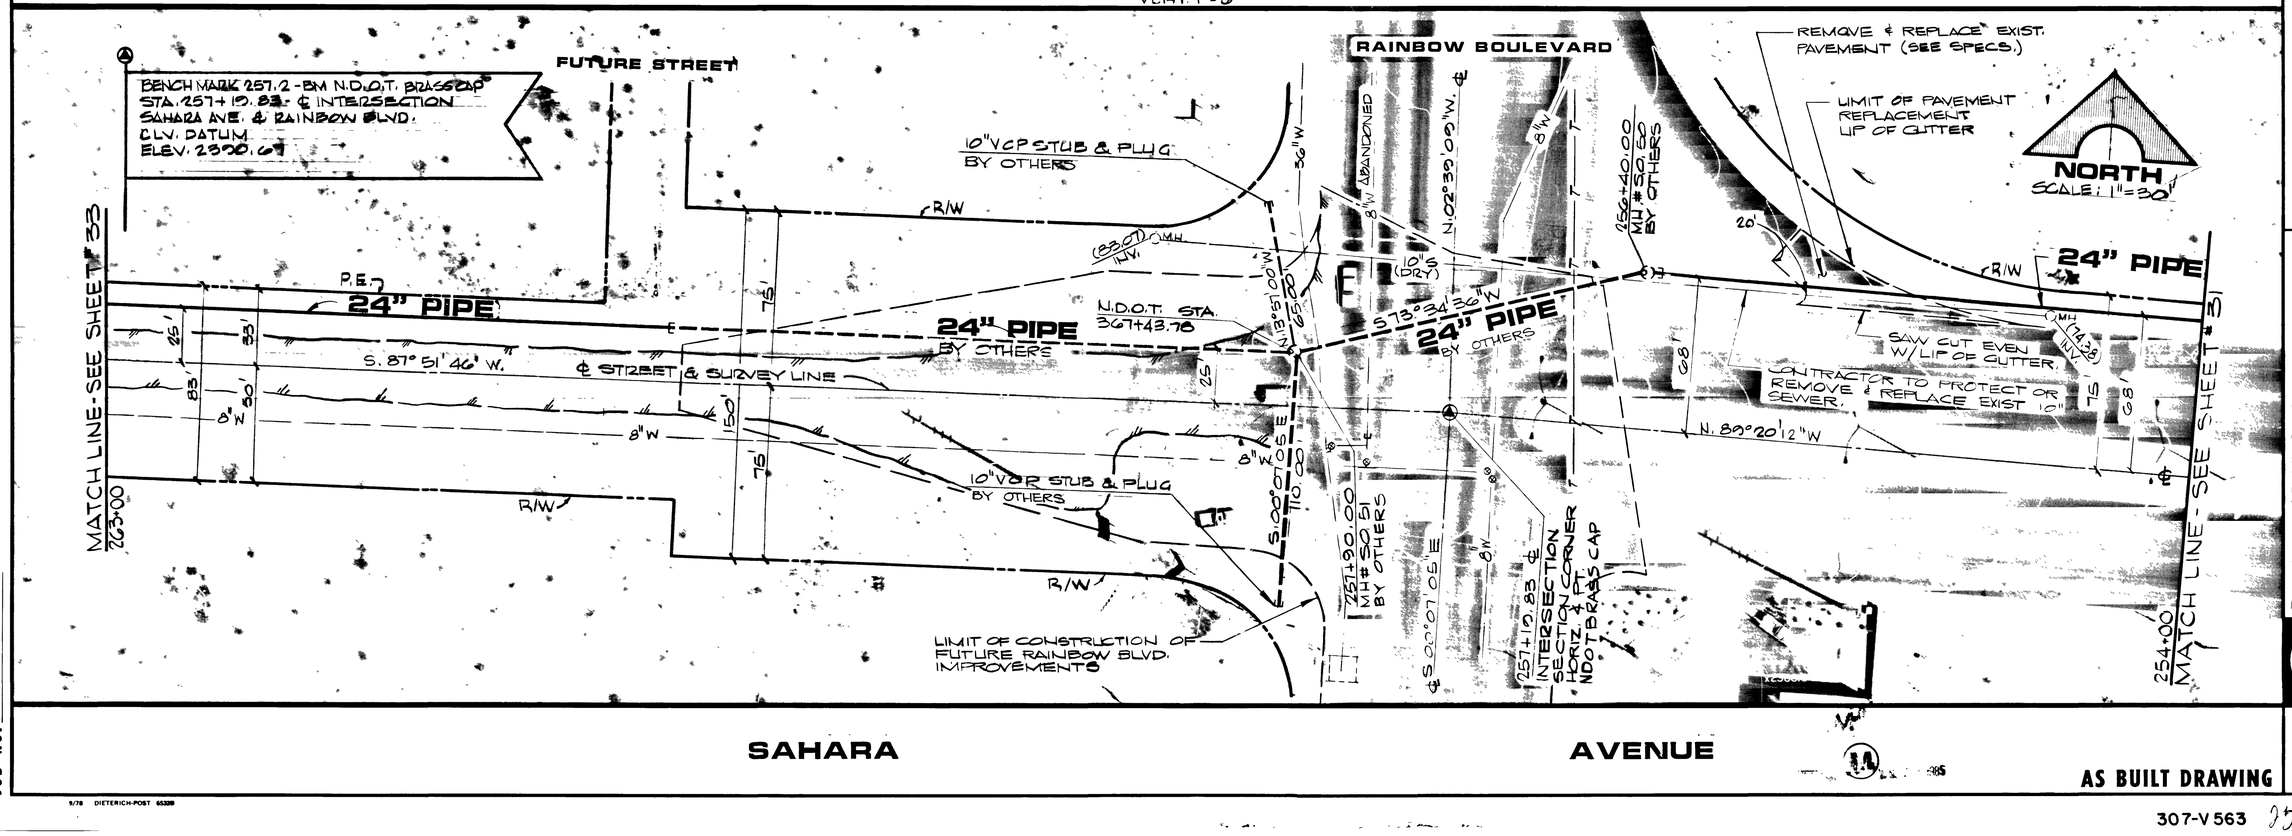

REV	DATE	DESCRIPTION
1	4/10/86	"AS BUILT" - NO REVISIONS

R.E. NO. 7326 DATE

STATE OF NEVADA — REGISTERED PROFESSIONAL ENGINEER — NO. 7326 — WILLIAM D. BOSS — CIVIL

G. C. WALLACE
Consulting Engineers, Inc.
1100 East Sahara Ave. - Las Vegas, Nevada 89104 - 732-3330

Department of Public Services
SAHARA - OAKEY SEWER INTERCEPTOR
PLAN & PROFILE 254+00 TO 263+00

SHEET 32 OF 65 SHEETS

AS BUILT DRAWING

JOB NO. 412.140

9/78 DIETERICH-POST 65320

307-V563 25-1-108

BY OTHERS

PROFILE

RAINBOW BOULEVARD

SAHARA AVENUE

AS BUILT DRAWING



SHEET 32