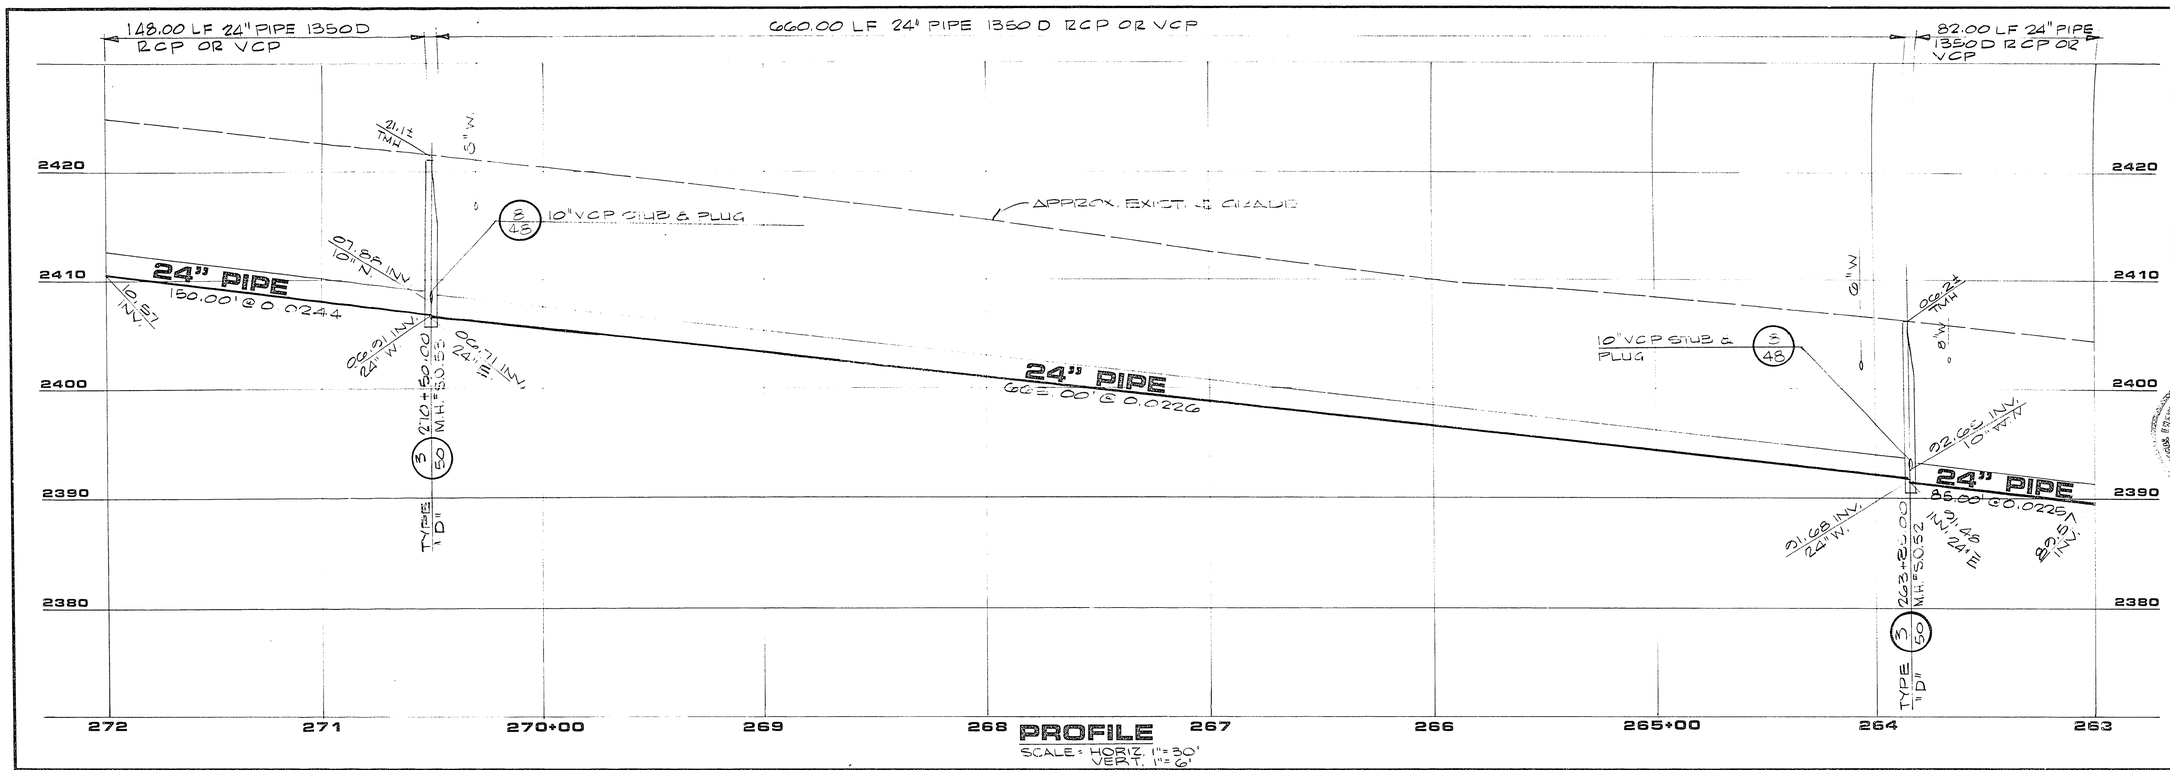

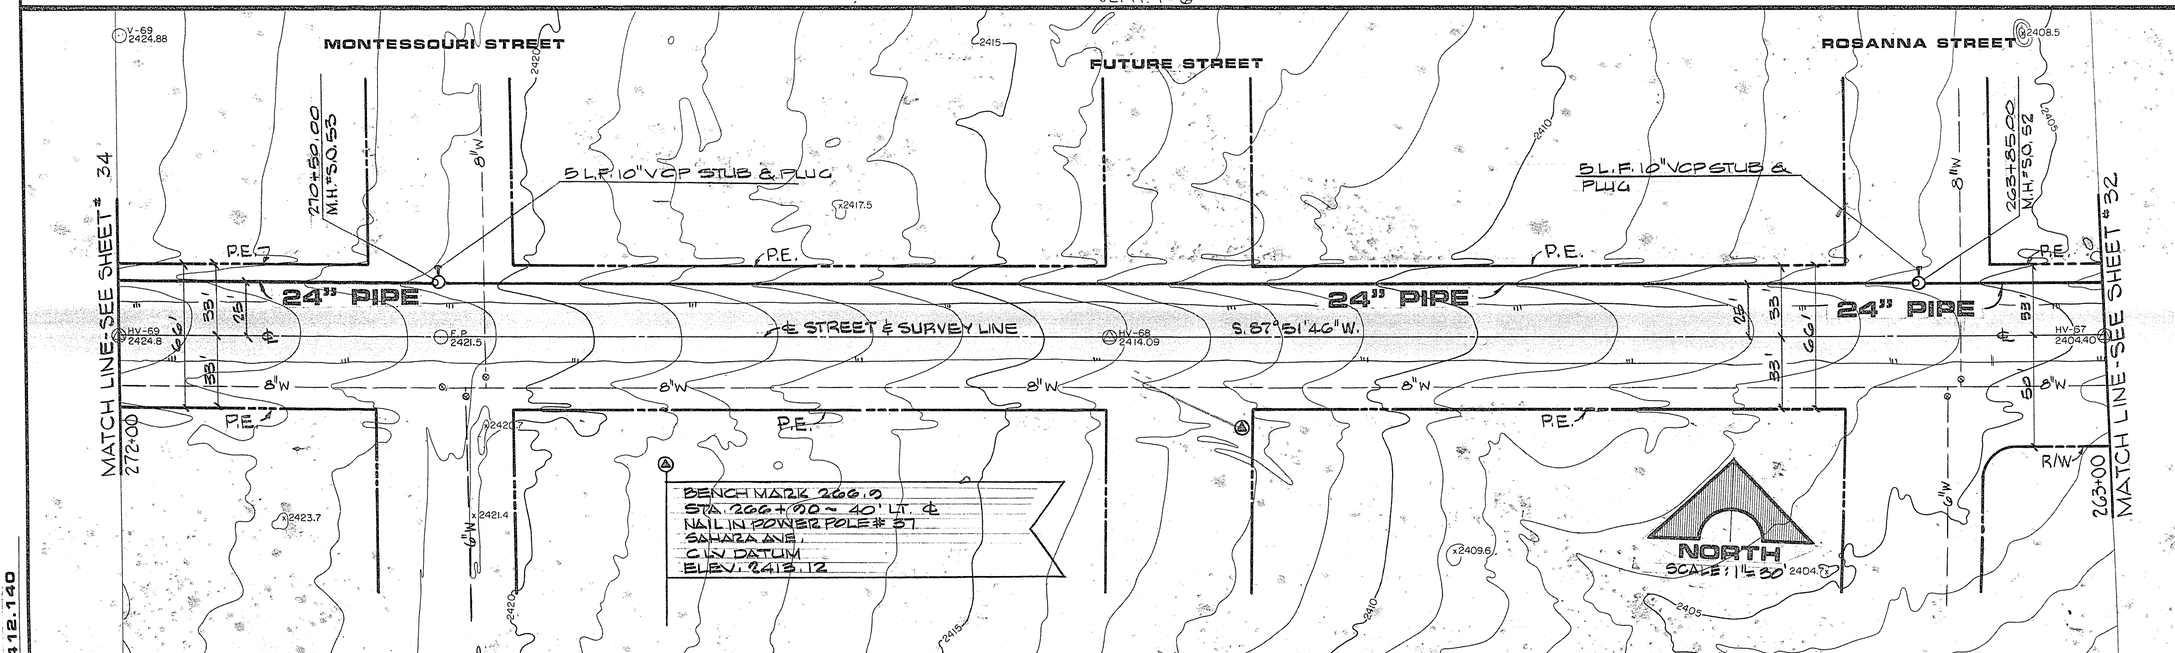

AS BUILT DRAWING

REV	DATE	DESCRIPTION
1	11/1/83	"AS BUILT" - NO REVISIONS

R.E. NO. 7/21/83 DATE

G. C. WALLACE
Consulting Engineers, Inc.
1100 East Sahara Ave. • Las Vegas, Nevada 89104 • 732-3330

Department of Public Services
SAHARA - OAKEY SEWER INTERCEPTOR
PLAN & PROFILE 263+00 TO 272+00

SHEET 33 OF 65 SHEETS

JOB NO. 412.140

9/78 DIETERICH-POST 6532B

307-V 563 93-1-14