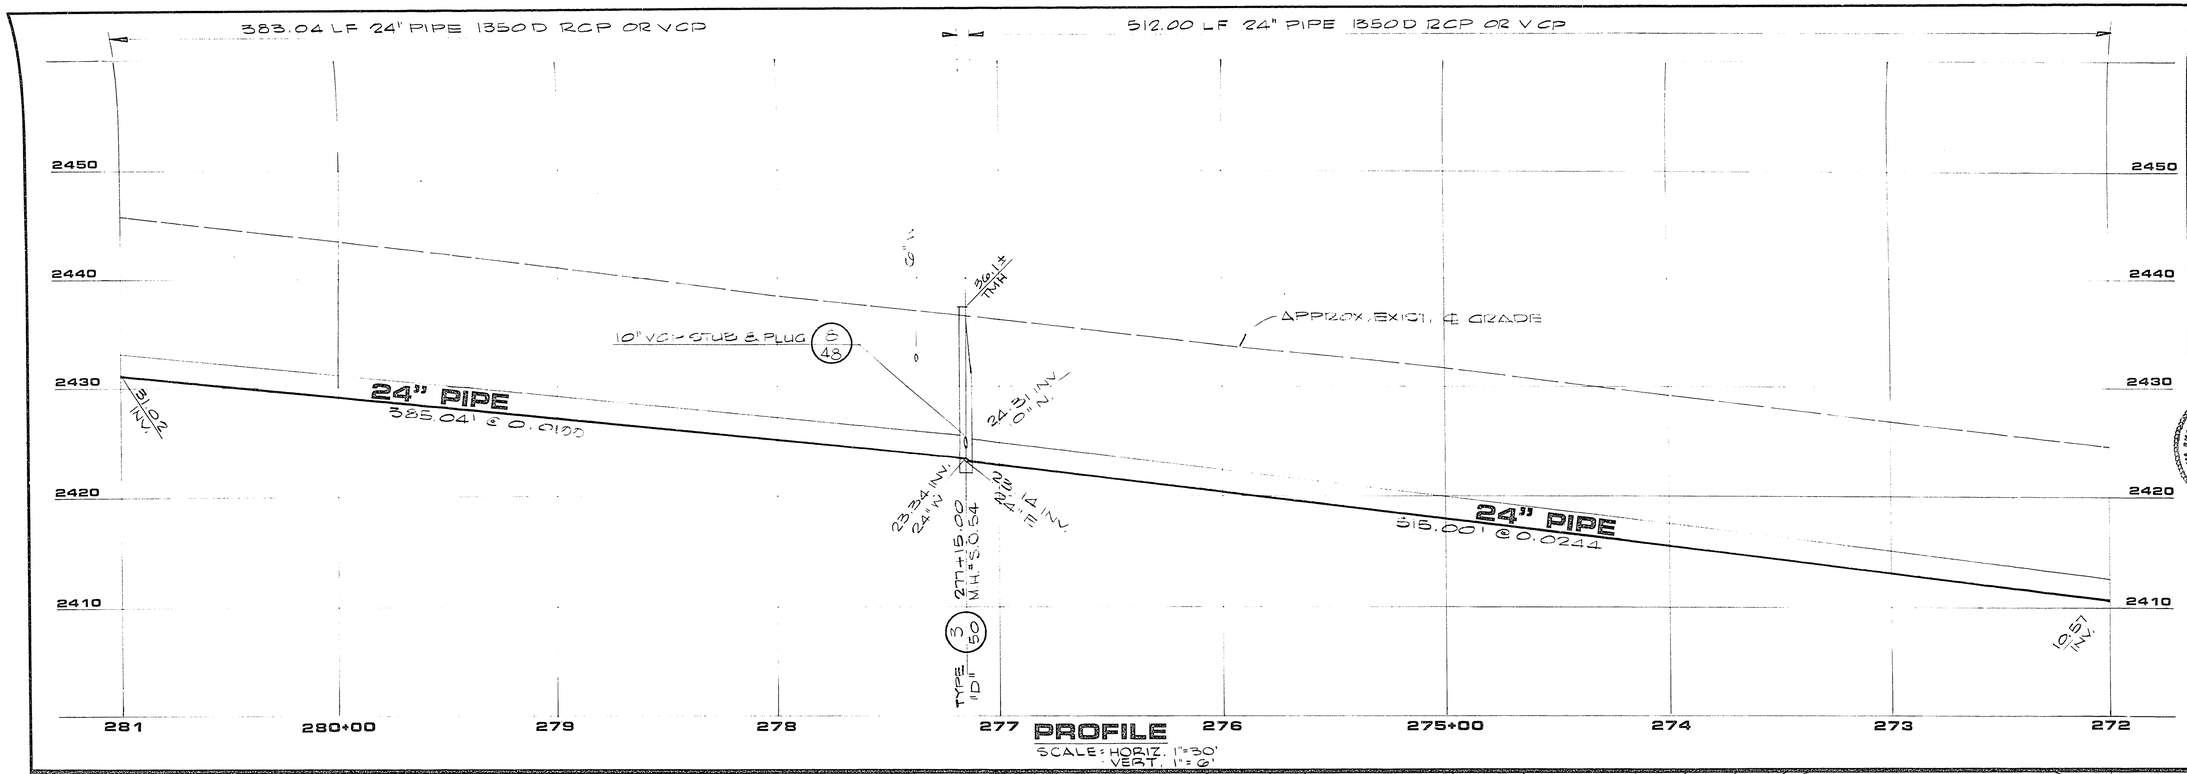

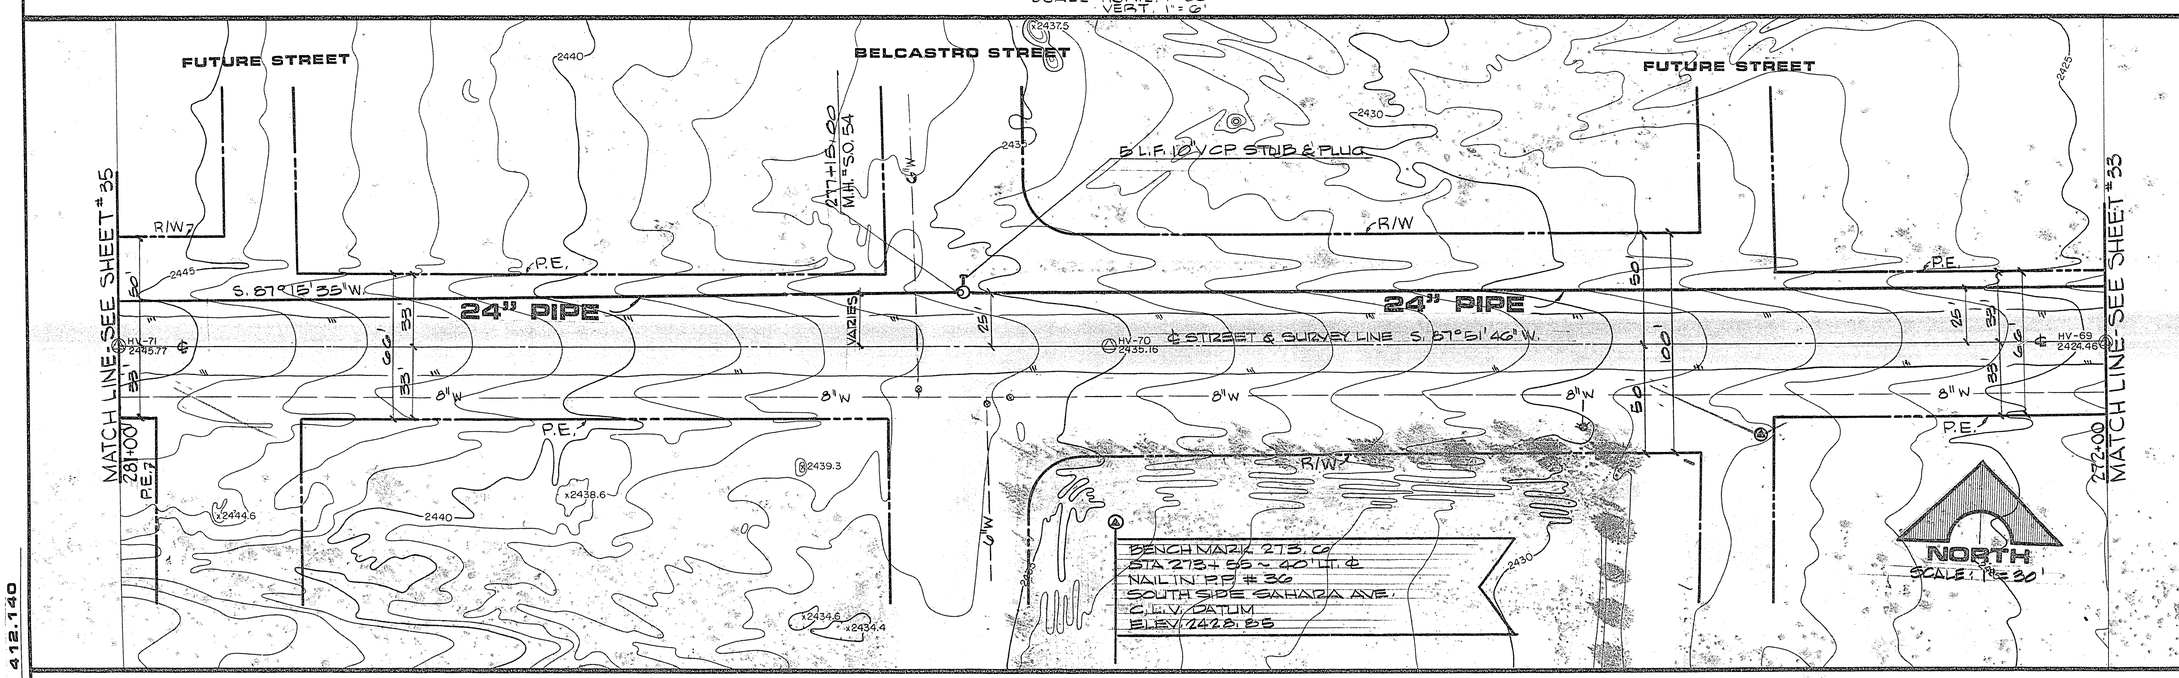

REV	DATE	DESCRIPTION
1	11/6/88	"AS BUILT" - NO REVISIONS

R.E. NO. 7/6/93 DATE

STATE OF NEVADA
REGISTERED PROFESSIONAL ENGINEER
MICHAEL D. ROSS
CIVIL

G. C. WALLACE
Consulting Engineers, Inc.
1100 East Sahara Ave. • Las Vegas, Nevada 89104 • 732-3330

Department of Public Services
SAHARA - OAKEY SEWER INTERCEPTOR
PLAN & PROFILE 272+00 TO 281+00

SHEET 34 OF 65 SHEETS

AS BUILT DRAWING

JOB NO. 412.140

9/78 DIETERICH-POST 6532B

307-V 563 22-1-110