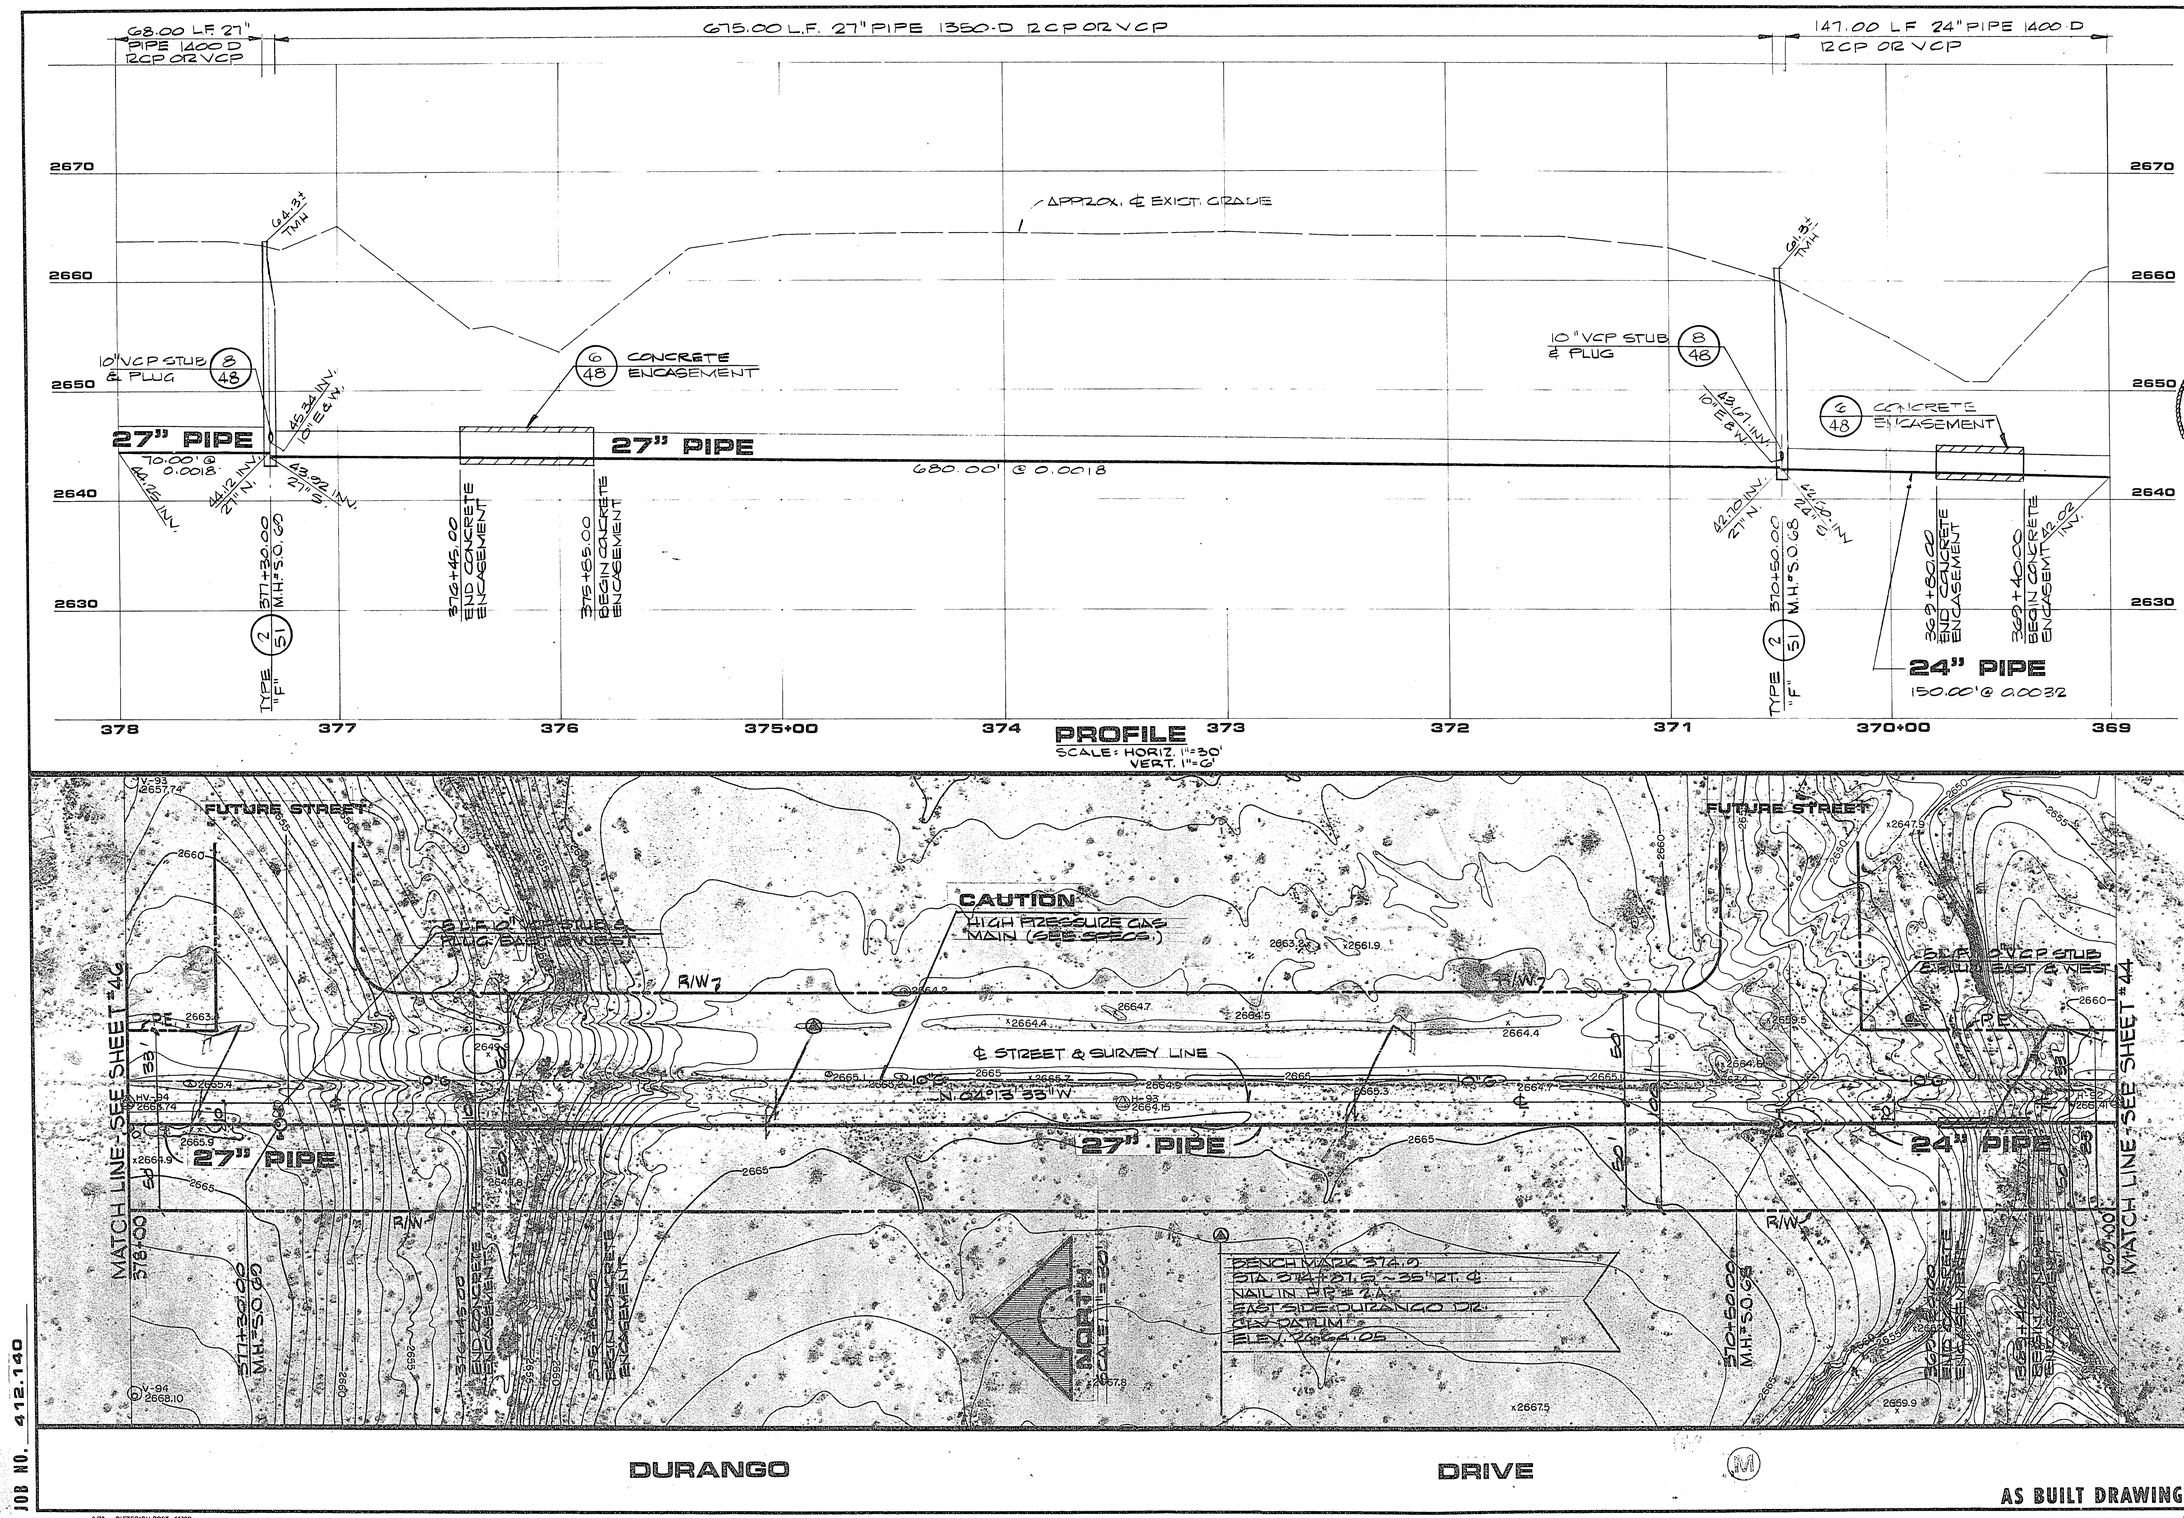

AS BUILT DRAWING

REV	DATE	DESCRIPTION
1	4/19/88	"AS BUILT" - NO REVISIONS

R.E. NO. DATE

REGISTERED PROFESSIONAL ENGINEER STATE OF NEVADA MICHAEL D. ROSS CIVIL No. 6818

G. C. WALLACE
Consulting Engineers, Inc.
1100 East Sahara Ave. - Las Vegas, Nevada 89104 - 732-3330

Department of Public Services
SAHARA - OAKEY SEWER INTERCEPTOR
PLAN & PROFILE 369+00 TO 378+00

SHEET 45 OF 55 SHEETS

JOB NO. 412.140

9/73 DIETERICH-POST 65328

307-V 563