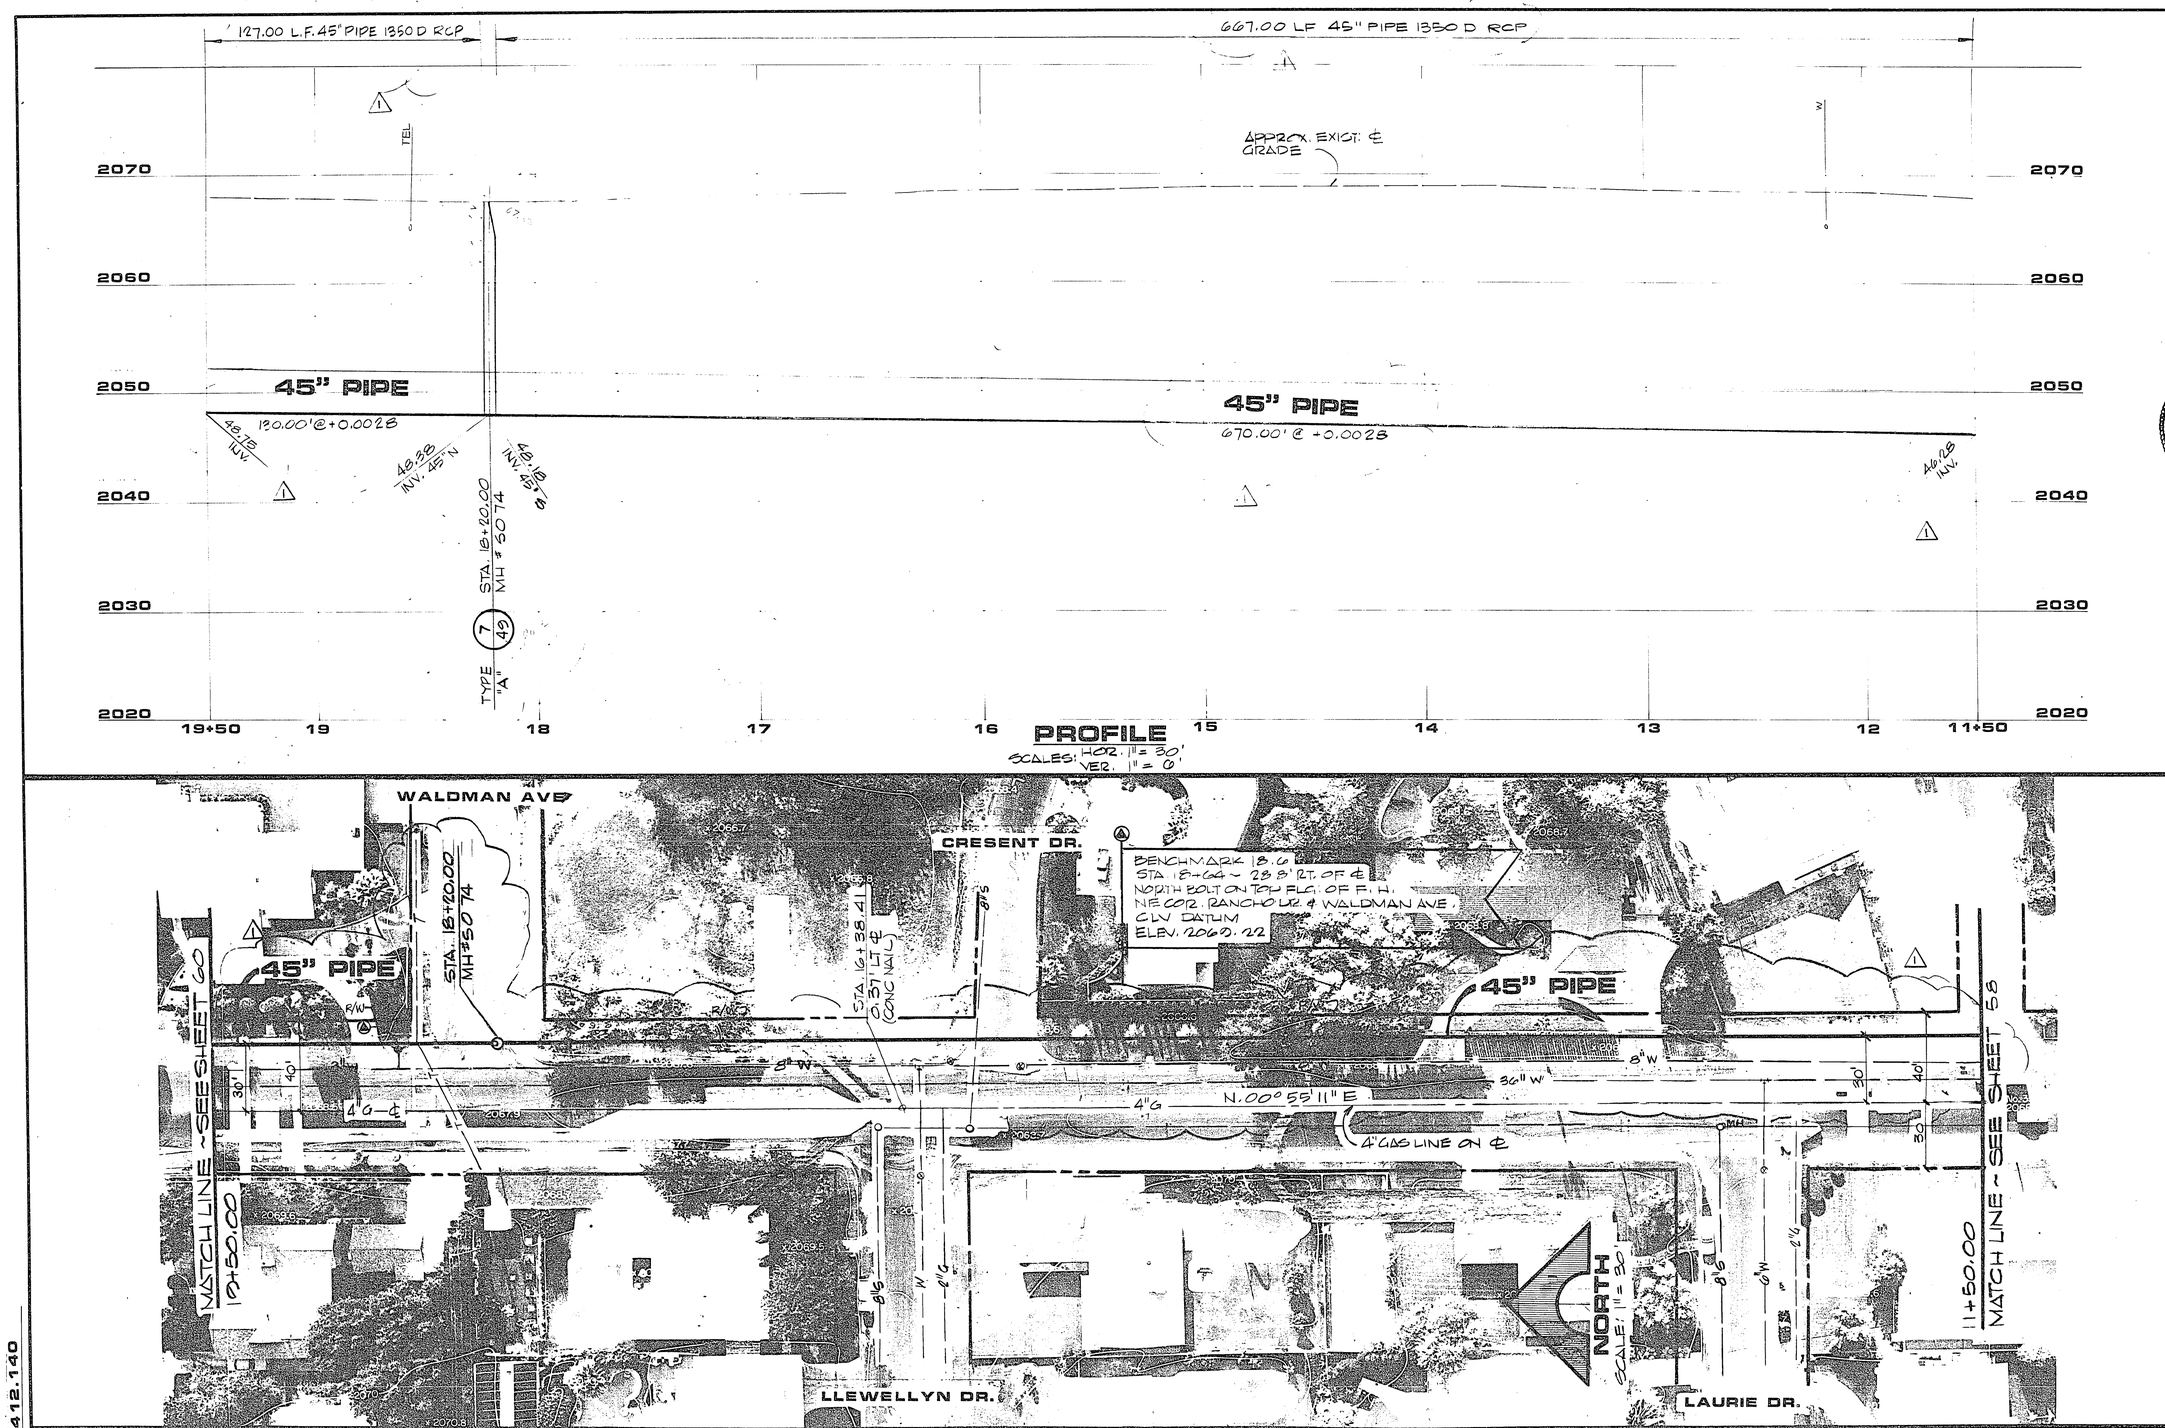

AS BUILT DRAWING

REV	DATE	DESCRIPTION
1	10/10/84	CHANGED PIPE AND EAST R/W
2	4/19/85	"AS BUILT" - NO REVISIONS

R.E. NO. 7/25/83 DATE

PROFESSIONAL ENGINEER - STATE OF NEVADA
MICHAEL D. ROSS
CIVIL
REGISTERED PROFESSIONAL ENGINEER

G. C. WALLACE
Consulting Engineers, Inc.
1100 East Sahara Ave. • Las Vegas, Nevada 89104 • 732-3330

Department of Public Services
SAHARA-OAKEY SEWER INTERCEPTOR
PLAN & PROFILE
RANCHO DR. STA. 11+50 TO 19+50

SHEET 59 OF 65 SHEETS

JOB NO. 412.140

9/78 DIETERICH-POST 6532B

307-V563

22-1-135