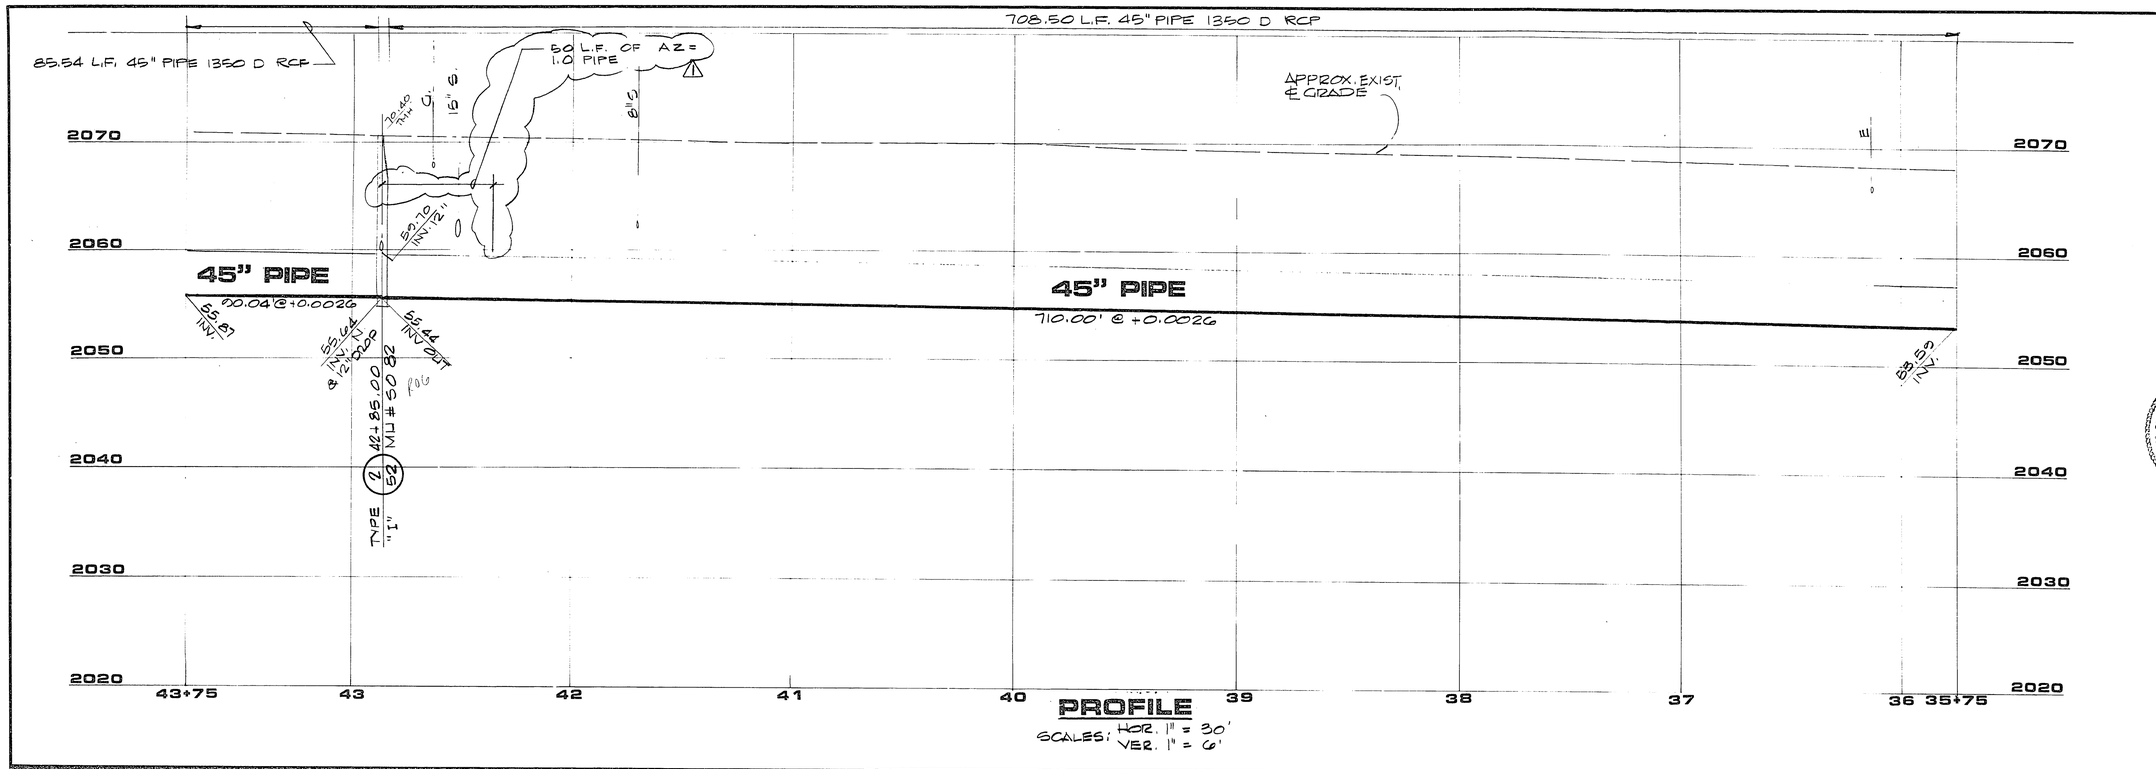

PROFILE

SCALES: HOR. 1" = 30'
VER. 1" = 6'

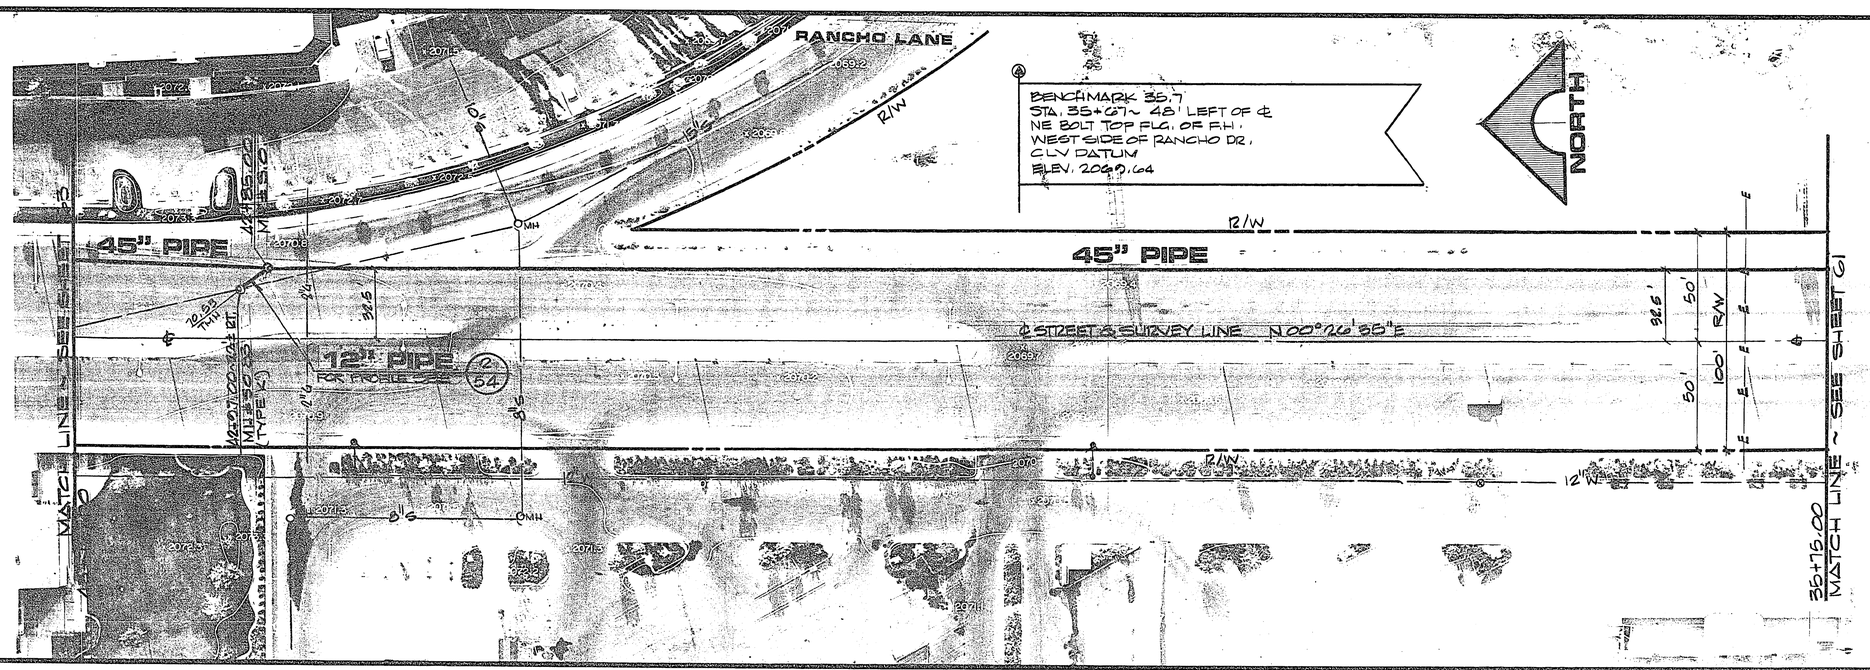

AS BUILT DRAWING

REV	DATE	DESCRIPTION
1	1/10/85	"AS BUILT"

R.E. NO. 7/10/85 DATE

R.E. CONSULTANT ENGINEER MICHAEL R. ROSS CIVIL

G. C. WALLACE
Consulting Engineers, Inc.
1100 East Sahara Ave. · Las Vegas, Nevada 89104 · 732-3330

Department of Public Services
SAHARA-OAKEY SEWER INTERCEPTOR
PLAN & PROFILE
RANCHO DR. STA. 35+75 TO 43+75

SHEET 62 OF 65 SHEETS

JOB NO. 412.140

9/78 DIETERICH-POST 6532B

307-V563 22-1-136