NOTES

1. CONTRACTOR TO CONSTRUCT RELIEF LINE FLOWING FROM SAHARA-OAKEY SEWER INTERCEPTOR TO EXISTING 8" VCP SEWER NEAR OAKEY BLVD. AND CAMPBELL DR.
2. SANITARY SEWER SERVICE TO RESIDENCES FLOWING INTO THE EXISTING 8" LINE MAY NOT BE INTERRUPTED. CONTRACTOR SHALL BE RESPONSIBLE FOR ANY DAMAGES TO PRIVATE RESIDENCES.
3. CONTRACTOR SHALL PLUG THE 27" PIPE AS SHOWN ON THE PLANS ONLY UPON THE DIRECTION OF THE ENGINEER. PLUG SHALL BE VANDERLANS & SON, INC. (LODI, CA.) SERIES LS 27" OR ENGINEER APPROVED EQUAL. PLUG WILL BE REMOVED BY AND BECOME THE PROPERTY OF THE CITY. PLUG SHALL INCLUDE VALVE STEM AND PRESSURE GAUGE INSTALLED NEAR STREET GRADE.

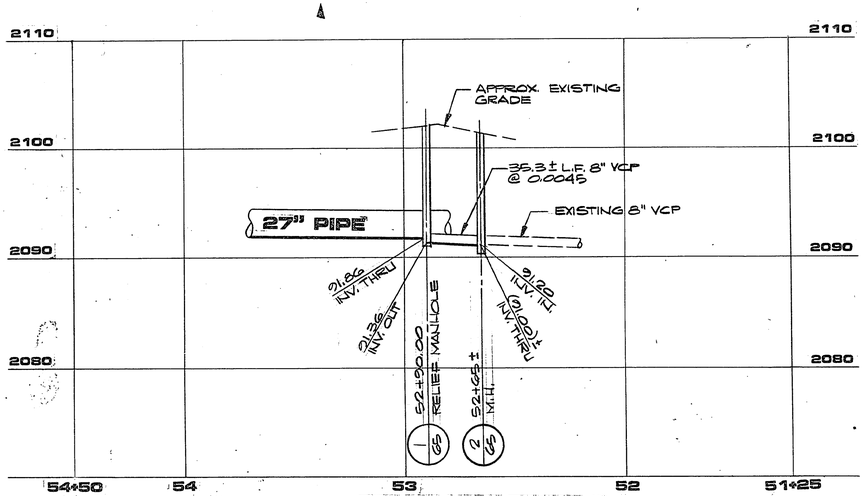

RELIEF LINE PROFILE

SCALE: HORIZ. 1" = 30'
VERT. 1" = 6'

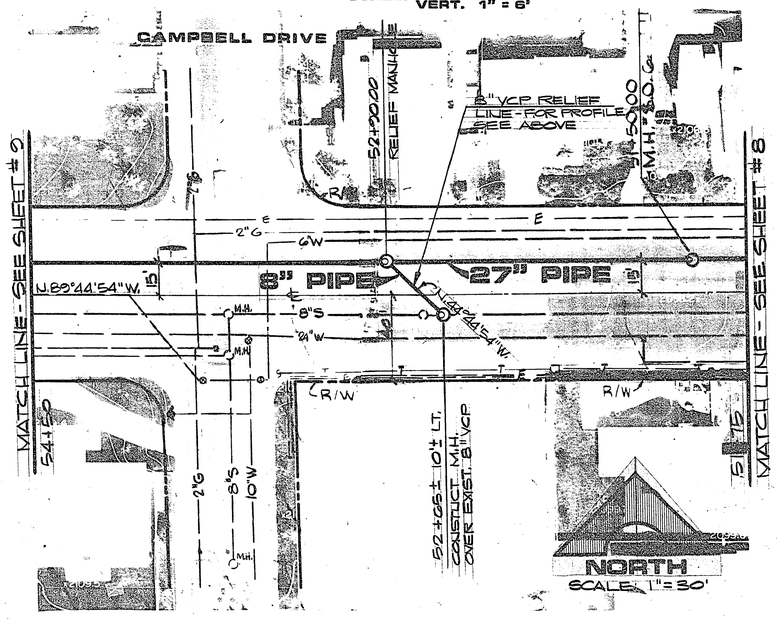

OAKEY BOULEVARD

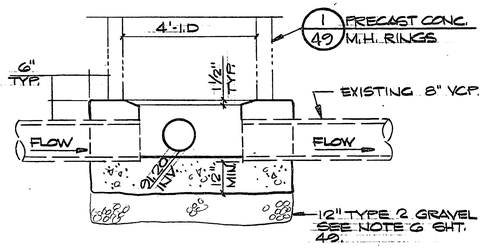

SECTION B/65

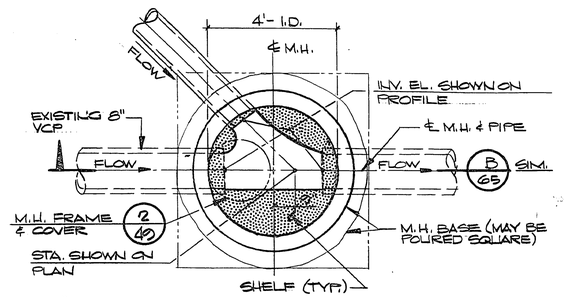

PLAN

S.S. MANHOLE TYPE "B" 2/65

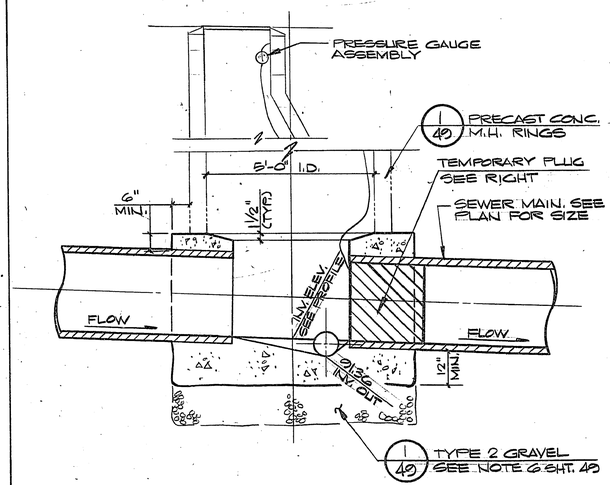

SECTION A/65

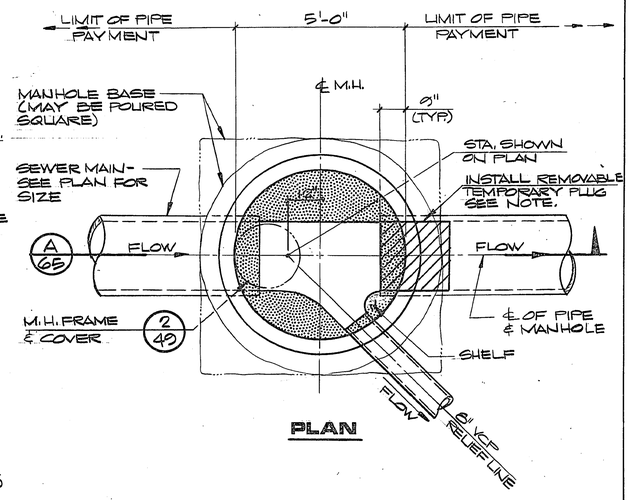

PLAN

RELIEF MANHOLE 1/65

AS BUILT DRAWING

REV	DATE	DESCRIPTION
1	11/9/83	"AS BUILT" - NO REVISIONS

R.E. NO. — DATE 11/28/83

RECOMMENDED FOR APPROVAL — CITY OF LAS VEGAS ENGINEERING DIVISION — APPROVED — 8855 CITE

G. C. WALLACE
Consulting Engineers, Inc.
1100 East Sahara Ave. · Las Vegas, Nevada 89104 · 732-3390

Department of Public Services
SAHARA - OAKEY SEWER INTERCEPTOR
OAKEY INTERCEPTOR RELIEF LINE
BID SCHEDULE 2 BID ALTERNATE 1

SHEET 65 OF 65 SHEETS

JOB NO.

5/78 DIETERICH-POST 65328

307-V 563

DD-1-147