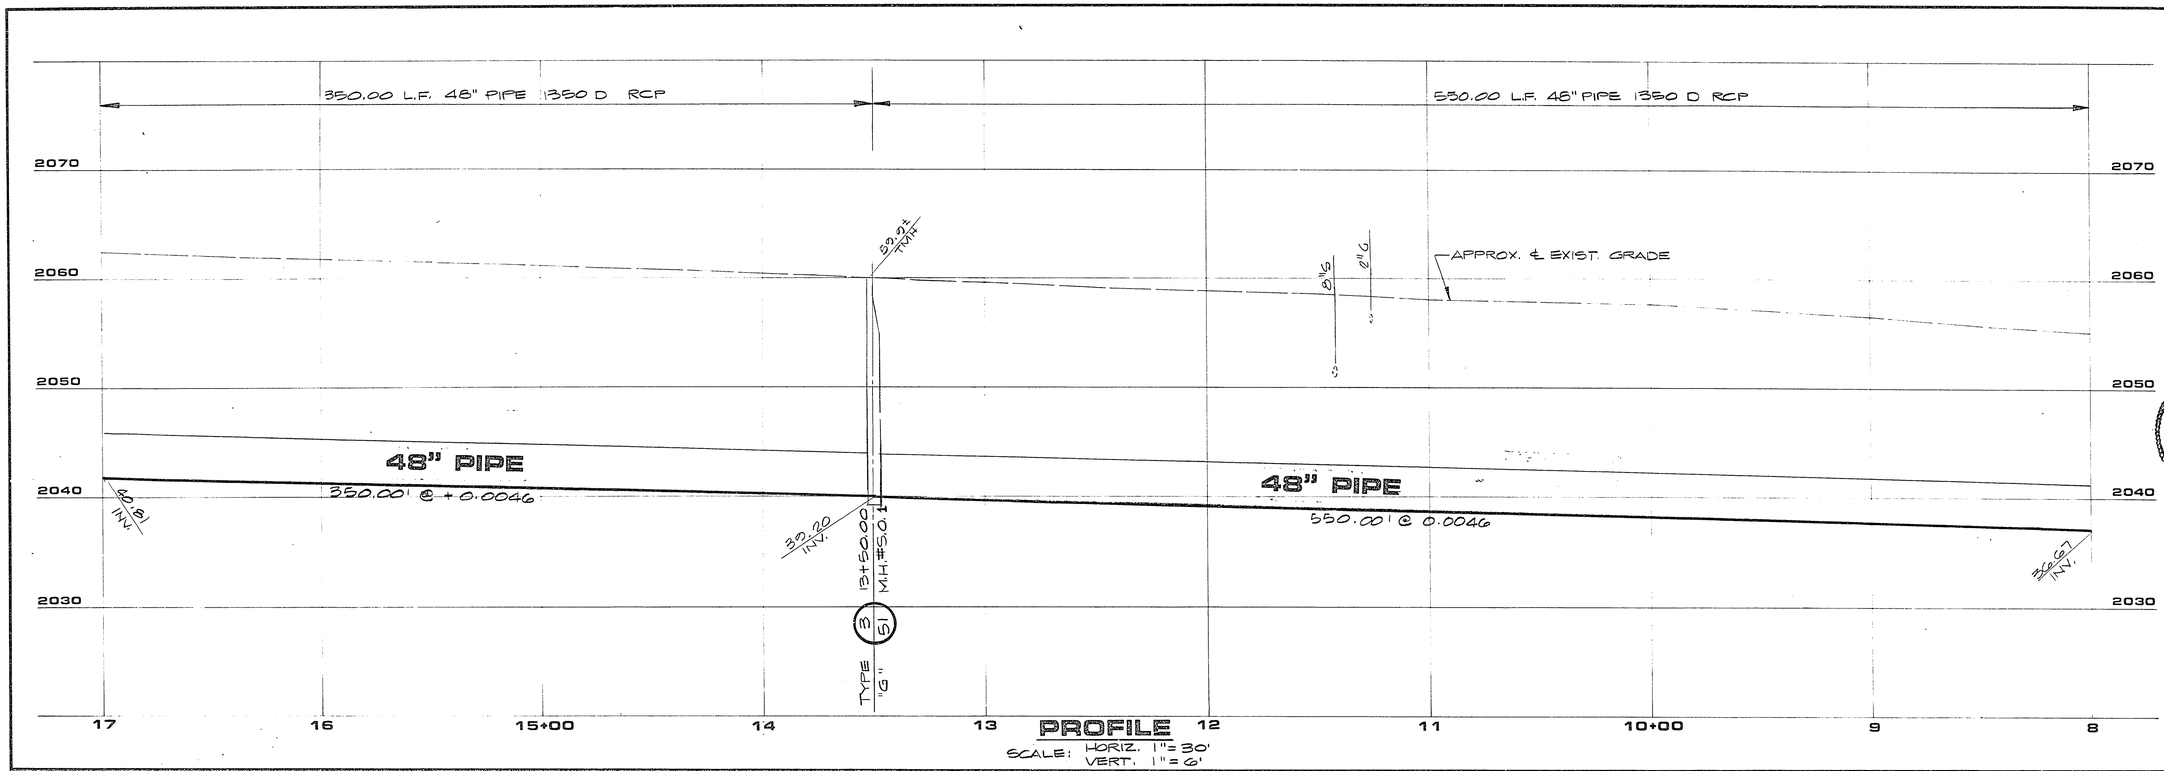

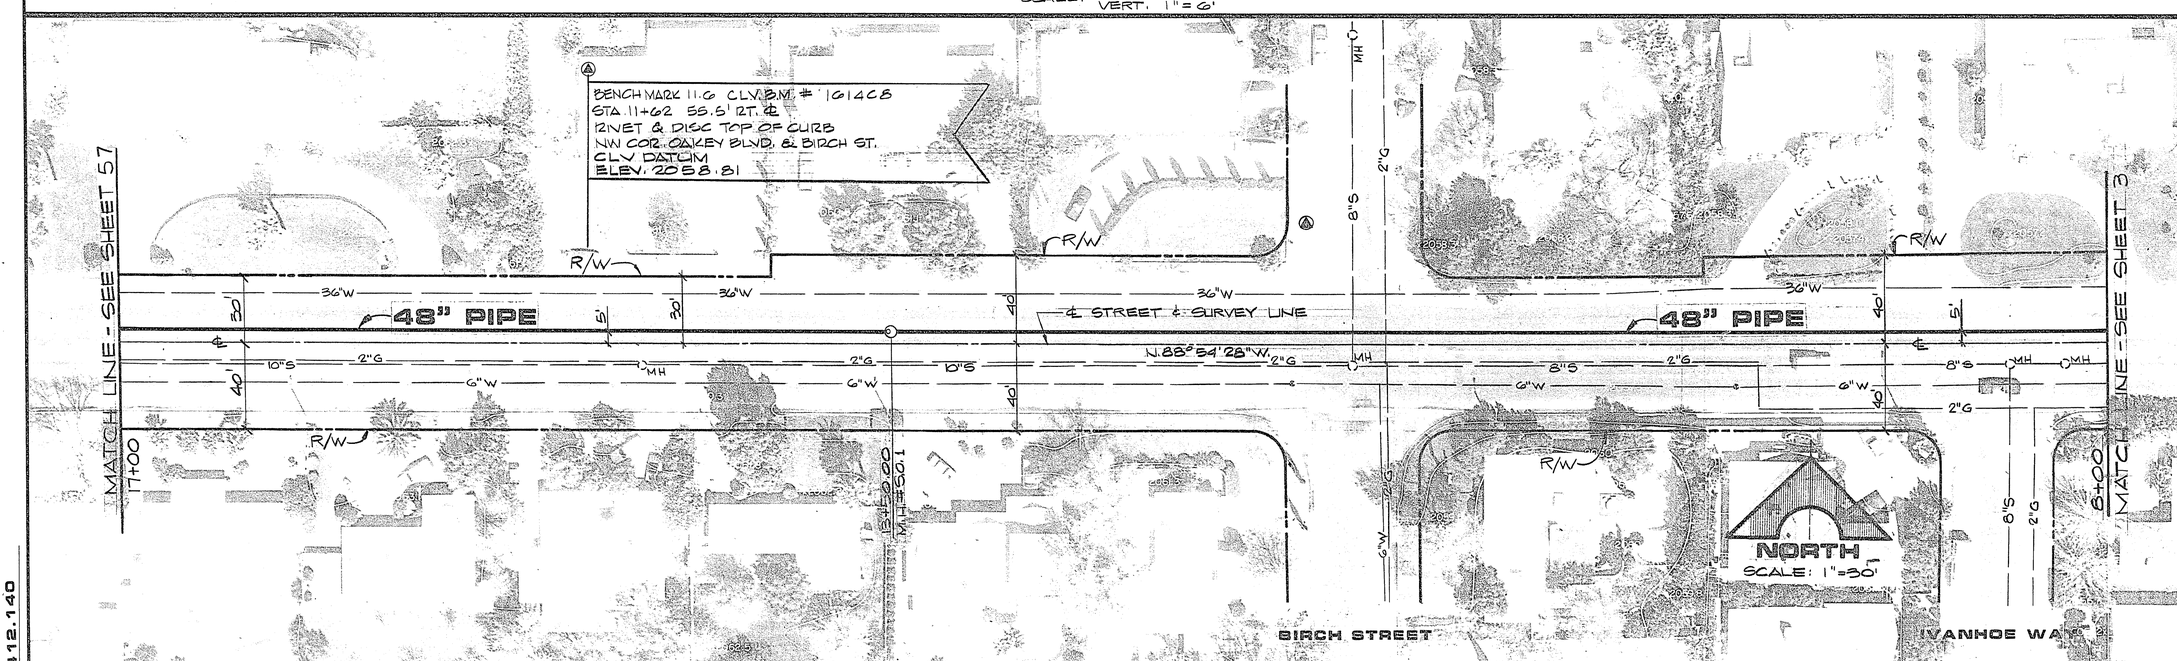

AS BUILT DRAWING

JOB NO. 412.140

9/78 DIETERICH-POST 65328

307-V563 12-1-90

REV	DATE	DESCRIPTION
1	1/6/86	"AS BUILT", NO REVISIONS

R.E. NO. DATE

REGISTERED PROFESSIONAL ENGINEER - STATE OF NEVADA
MICHAEL D. ROSS
CIVIL
NO. 6218

G. C. WALLACE
Consulting Engineers, Inc.
1100 East Sahara Ave. • Las Vegas, Nevada 89104 • 732-3330

Department of Public Services
SAHARA - OAKEY SEWER INTERCEPTOR
PLAN & PROFILE 8+00 TO 17+00

SHEET 4 OF 65 SHEETS