





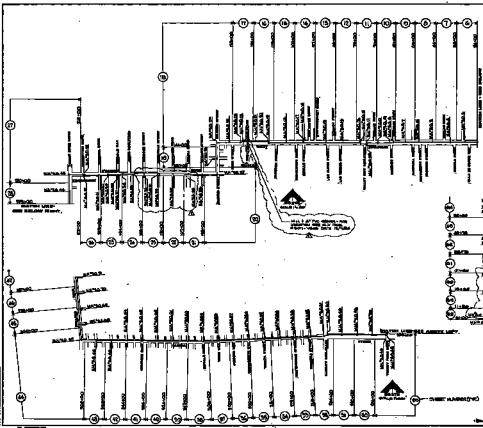


**REVISIONS**

DESIGNED BY  
**ENGINEERING DEPARTMENT**



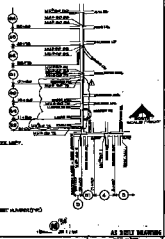

**G.C. WALLACE**  
Consulting Engineer, Inc.  


