

VALLEY VIEW BLVD.

NOT A PART


WONG PROPERTY

NOT A PART

WONG PROPERTY

B.C.R.
Radius = 75.00'
Δ = 90°00'00"

NORTH

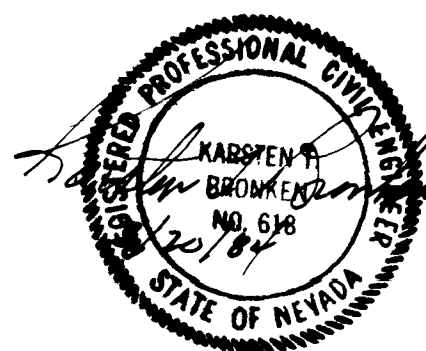

* Re-located Comm. Drive
4/11/85 A.P.S.

6/10/81

○ New 100 W.H.P.S.
○ Existing Streetlights

NOT A PART

NOTE: All Grades
New Finish Grade

HORIZONTAL SCALE 1" = 30.00'
VERTICAL SCALE 1" = 5.00'

SAHARA AVENUE

TAMRICH DRIVE

SAHARA AVENUE

TAMRICH DR.

WONG PROPERTY

NOT A PART

NORTH

TAMRICH DRIVE

DRIVE


SAHARA AVENUE

SAHARA WEST - SHOPPING CENTER

107-V1300

SHEET 2 OF 2 SHEETS

1-3-148

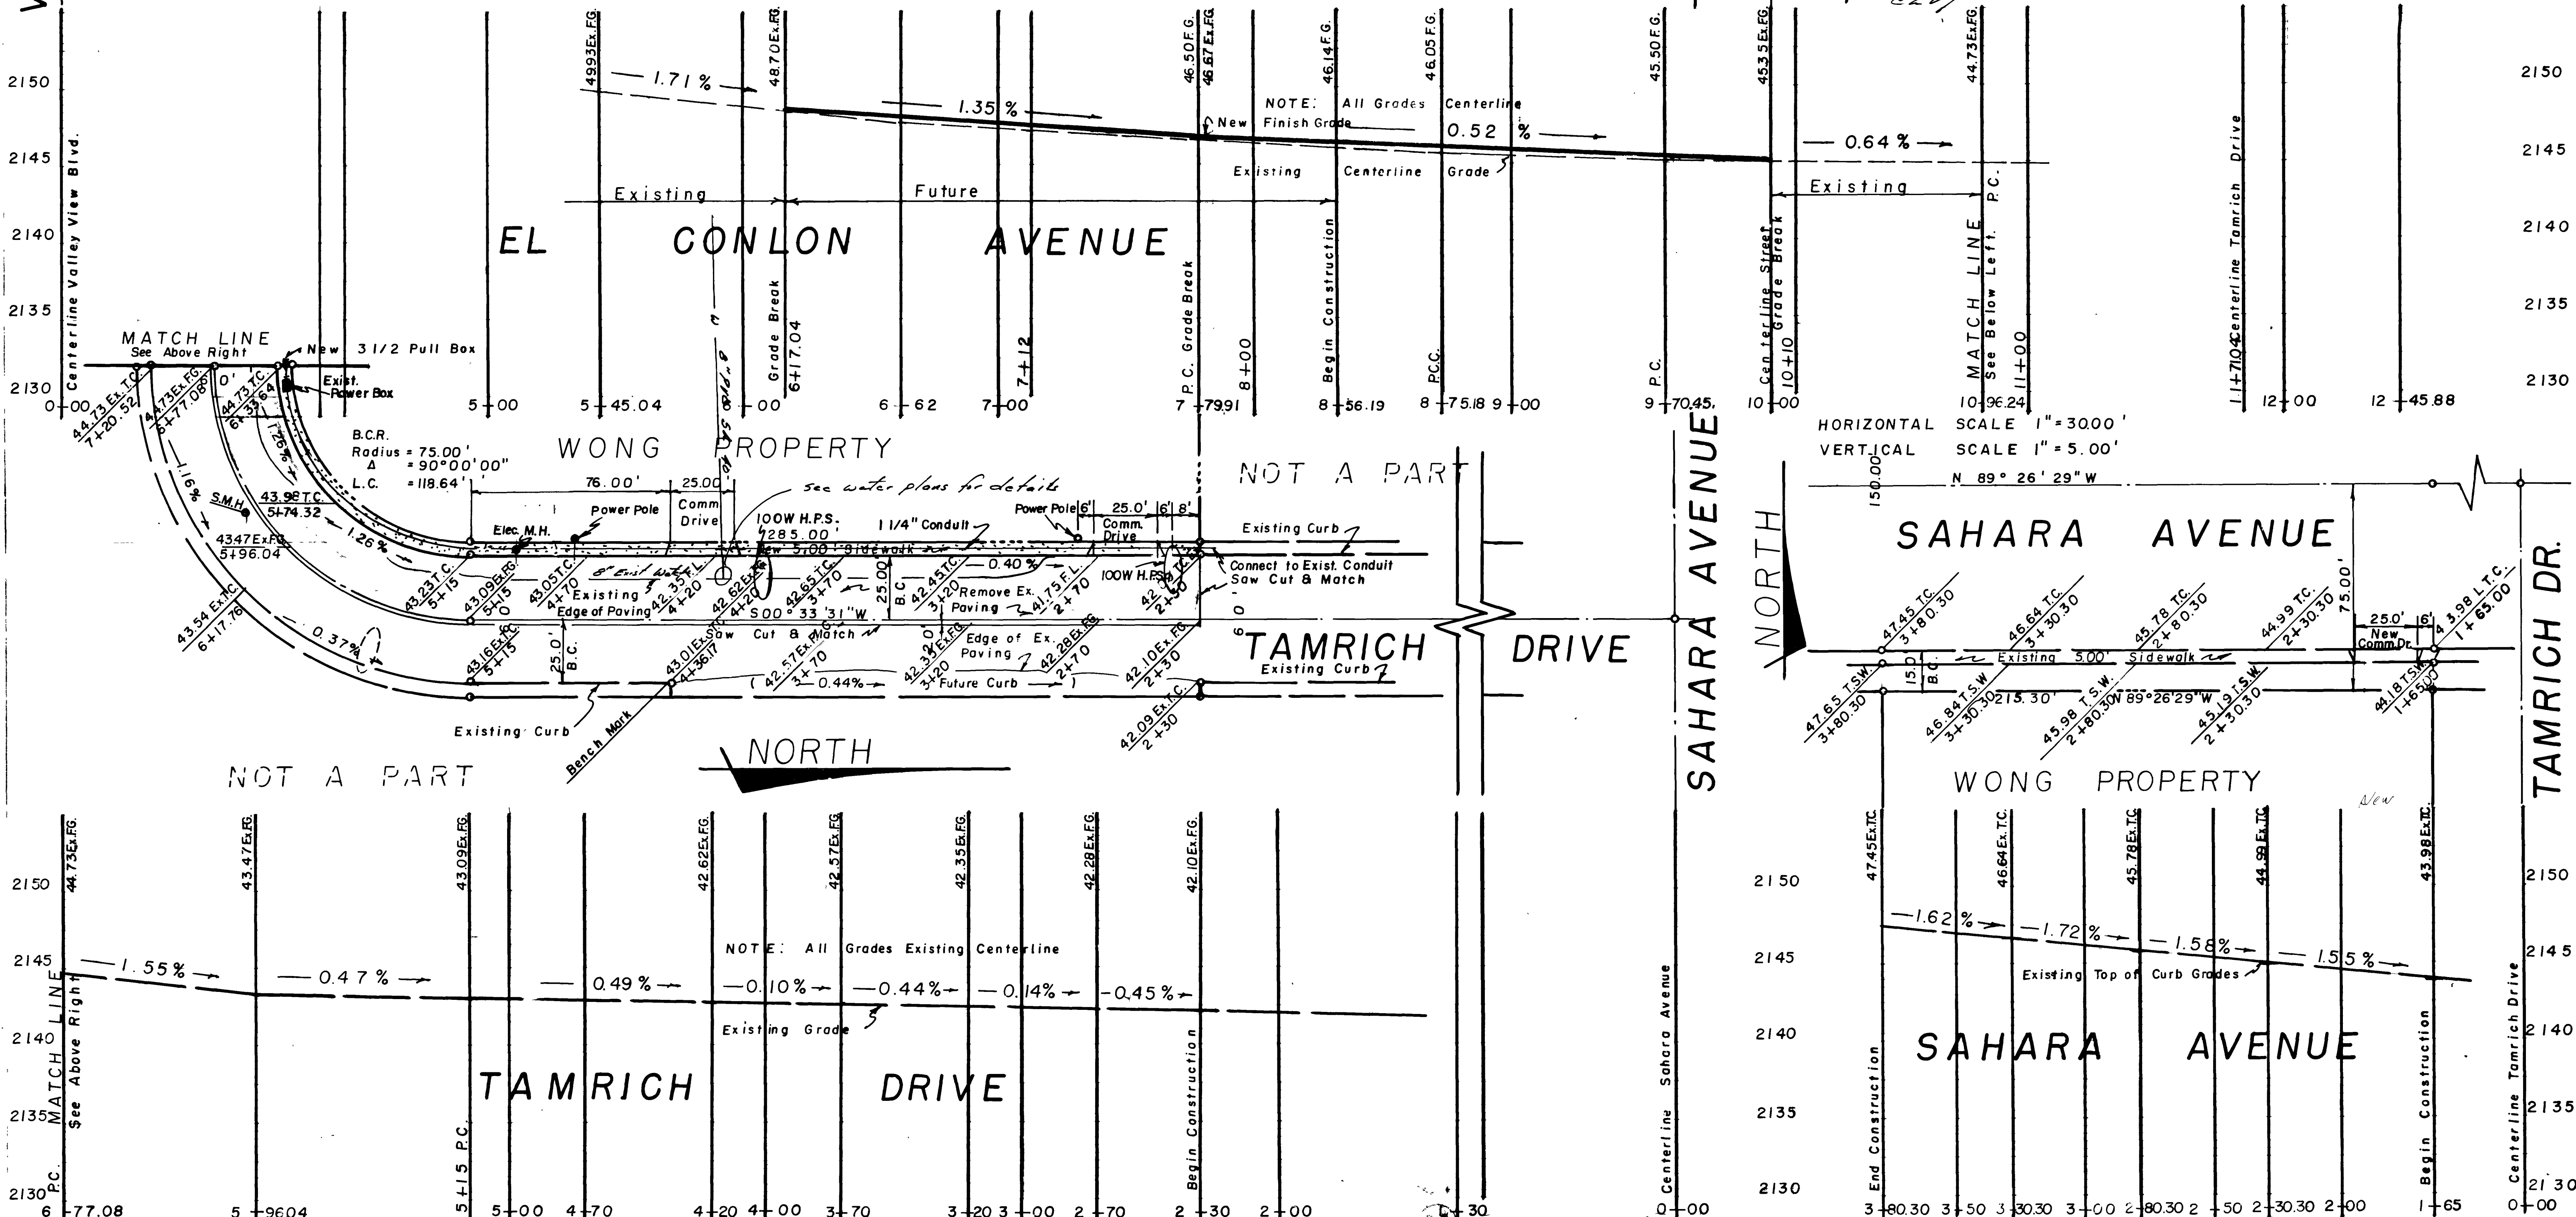

VALLEY VIEW BLVD.

NOT A PART

WONG PROPERTY

WONG PROPERTY

NOT A PART

EL CONLON AVENUE

WONG PROPERTY

NOT A PART

TAMRICH DRIVE

NOT A PART

NORTH

TAMRICH DRIVE

DRIVE

SAHARA AVENUE

NORTH

SAHARA AVENUE

WONG PROPERTY

SAHARA AVENUE

NORTH

TAMRICH DR

SAHARA WEST - SHOPPING CENTER 107-VIS00