


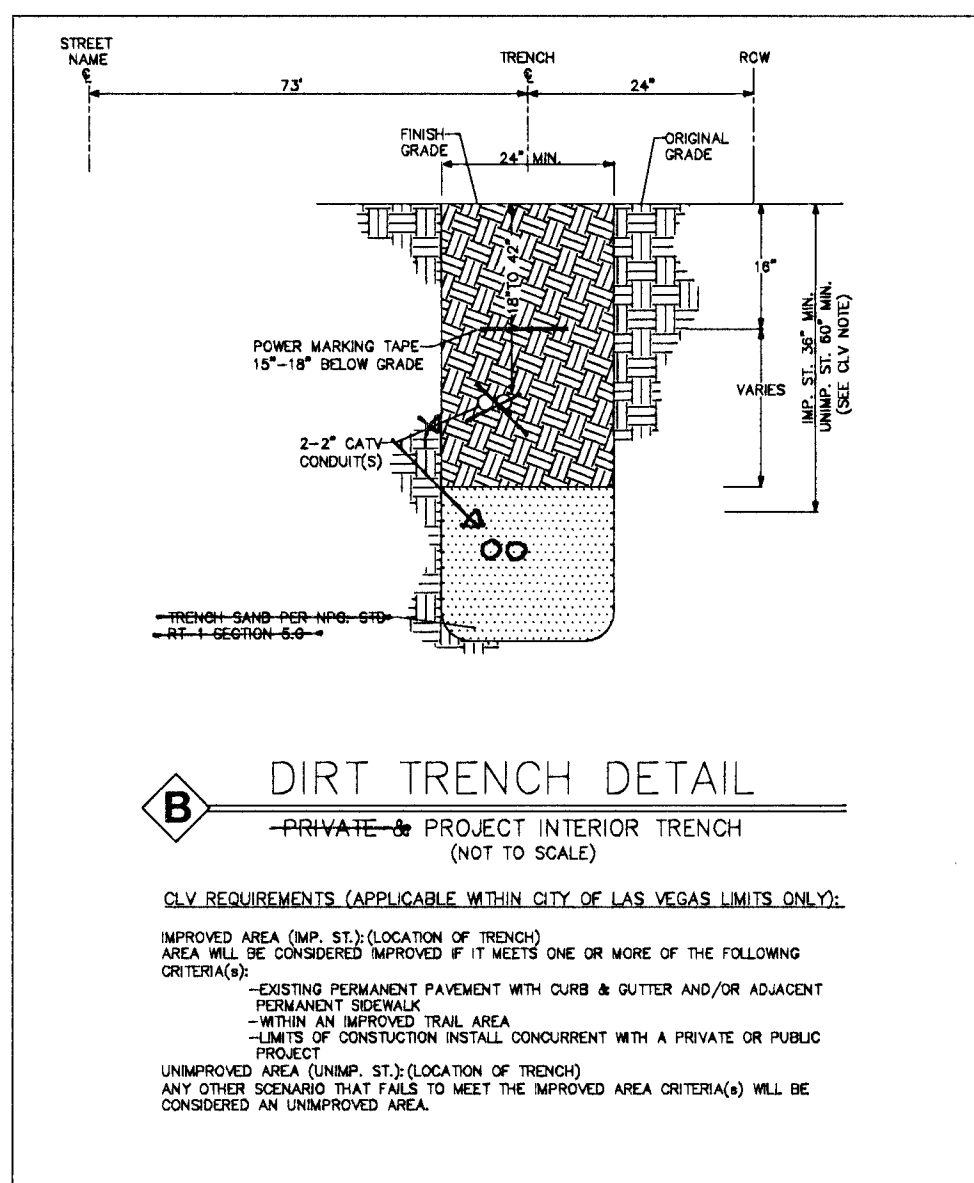

DISCLAIMER NOTE

UTILITY LOCATIONS SHOWN HEREON ARE APPROXIMATE ONLY. IT SHALL BE THE CONTRACTOR'S RESPONSIBILITY TO DETERMINE THE EXACT HORIZONTAL AND VERTICAL LOCATION OF ALL EXISTING UNDERGROUND AND OVERHEAD UTILITIES PRIOR TO COMMENCEMENT OF CONSTRUCTION. NO REPRESENTATION IS MADE THAT ALL EXISTING UTILITIES ARE SHOWN HEREON. THE ENGINEER ASSUMES NO RESPONSIBILITY FOR UTILITIES NOT SHOWN OR UTILITIES NOT SHOWN IN THEIR PROPER LOCATIONS.

AVOID HITTING UNDERGROUND
TRAFFIC SIGNALS, POWER AND
STREET LIGHT SYSTEM CONDUITS
IT'S COSTLY

**CALL BEFORE
YOU DO
UNDERGROUND**

**BEFORE YOU
UNDERGROUND**
1-702-435-7511
CLARK COUNTY TRAFFIC OPERATIONS
AND
1-702-432-5300
LAS VEGAS AREA COMPUTORIZED SYSTEM

AVOID CUTTING UNDERGROUND
UTILITY LINES IT'S COSTLY.

**BEFORE YOU DIG
OR 1-800-227-2600
UNDERGROUND SERVICE (USA)**

AVOID OVERHEAD POWER
LINE CONTACT

**CALL
BEFORE YOU
OVERHEAD**

1-702-227-2928
NEVADA POWER ENVIRONMENT AND
SAFETY SERVICE DEPARTMENT

TOTAL BORE
TOTAL DIRT TRENCH
TOTAL ASPHALT TRENCH

60'
432'
56'

TOTAL TRENCH

548'

SIDEWALK REMOVAL/REPAIR

TOTAL S/W PANELS
TOTAL LINEAR FOOTAGE

—
—

