

WEST SAHARA AVENUE


ALL EXISTING LANDSCAPING, IRRIGATION, LANDSCAPE LIGHTING AND ELECTRICAL CONDUIT TO BE REMOVED FROM WITHIN THE SAHARA AVENUE RIGHT OF WAY MEASURING 8.50' FROM THE BACK OF SIDEWALK. RESTORE THE EXISTING 3/4" DECOMPOSED GRANITE IN THIS AREA TO A 2" LAYER.

SITE VISIBILITY ZONES TYPICAL - NO PLANTS ALLOWED OVER 24" IN HEIGHT AS MEASURED FROM THE TOP OF CURB

ONLY PROPOSED LANDSCAPING ON THIS PLAN SHALL BE IN THE SAHARA AVENUE RIGHT OF WAY (CLOUDED AREAS). IRRIGATION BY DRIP EMITTERS ONLY.


ALL EXISTING LANDSCAPING, IRRIGATION, LANDSCAPE LIGHTING AND ELECTRICAL CONDUIT TO BE REMOVED FROM WITHIN THE SAHARA AVENUE RIGHT OF WAY MEASURING 8.50' FROM THE BACK OF SIDEWALK. RESTORE THE EXISTING 3/4" DECOMPOSED GRANITE IN THIS AREA TO A 2" LAYER.

PLANTING PLAN

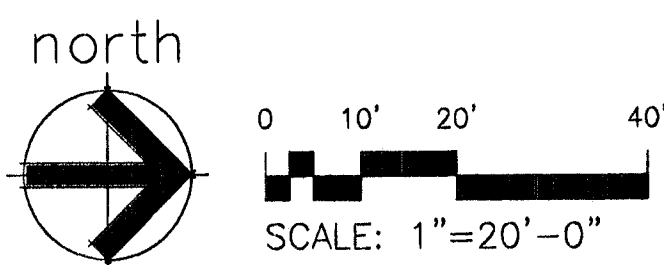

PLANT SYMBOL	SCHEDULE BOTANICAL NAME	COMMON NAME	QTY.	SIZE	REMARKS
TREES					
	BUTA CAPITATA	PINDO PALM	30	15 GAL	
	CHAMAECYPARIS HUMILIS	MEDITERRANEAN FAN PALM	18	15 GAL	3 TO 4 TRUNKS SUBMIT PHOTOS FOR APPROVAL
	SOPHORA SECUNDIFLORA	TEXAS MTN LAUREL	31	24" BOX	
	WASHINGTONIA ROBUSTA	MEXICAN FAN PALM	10	12'-0"	SKINNED, 10' BROWN TRUNK
	QUERCUS ILEX	HOLLY OAK	17	24" BOX	STD. TRUNK - 4" CLEAR TRUNK
	ESTABLISHED TREES & SHRUBS		N/A	AS SHOWN PER PLAN	
	ESTABLISHED MEXICAN FAN PALMS		N/A	N/A	THE CONTRACTOR IS TO REMOVE 4 EX. PALM TREES NOT SHOWN AT THE MAIN ENTRY
SHRUBS					
	ABELIA GRANDIFLORA	GLOSSY ABELIA	30	5 GAL	
	CYCAS REVOLUTA	SAGO PALM	23	7 GAL	
	EUONYMUS JAPONICUS 'GREEN SPIRE'	GREEN SPIRE EUONYMUS	128	5 GAL	
	PITTOSPORUM TOBIRA 'WHEELER'S'	WHEELER'S DWARF MOCKORANGE	111	5 GAL	
GROUNDCOVERS					
	LANTANA SPECIES 'NEW GOLD'	NEW GOLD LANTANA	73	1 GAL	
	TEUCRUM CHAMAEDRYS	BUSH GERMANDER	321	1 GAL	
	TRACHELOSPERMUM	STAR JASMINE	29	5 GAL	
ACCENTS					
	YUCCA PALLIDA	PALE LEAF YUCCA	154	5 GAL	
	DASYLIXON QUADRANGULATUM	TOOTHLESS DESERT SPOON	70	5 GAL	

- LANDSCAPE NOTES:
1. CITY OF LAS VEGAS STANDARDS TO BE FOLLOWED.
 2. ALL PLANTER AREAS TO RECEIVE A 2" LAYER OF 3/4" SCREENED CRUSHED GRANITE ROCK GROUNDCOVER, 'CANYON CORAL RED' COLOR, FROM MINERAL PARK DECORATIVE ROCK, OR EQUAL.
 3. PLANT QUANTITIES SHOWN ON PLANT SCHEDULE ARE FOR REFERENCE ONLY. CONTRACTOR TO VERIFY ALL PLANT QUANTITIES.

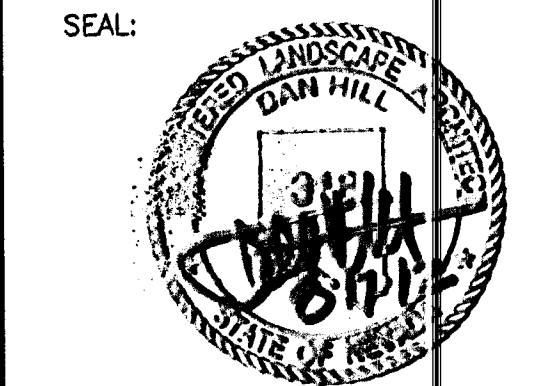

CONSULTANT:

HILL CLARK
& ASSOCIATES
LANDSCAPE ARCHITECTURE
74 N. Peas Road, Ste. B
Henderson, NV 89074
P: (702) 260-9356
F: (702) 260-9357

DRAWINGS AND SPECIFICATIONS AS INSTRUMENTS OF SERVICE ARE AND SHALL REMAIN PROPERTY OF THE DESIGN PROFESSIONAL. COPIES OF THE DRAWINGS AND SPECIFICATIONS REMAINED BY THE CLIENT ARE TO BE UTILIZED ONLY FOR THE USE AND FOR OCCUPANCY OF THE PROJECT FOR WHICH THEY WERE DESIGNED AND NOT FOR CONSTRUCTION OF ANY OTHER PROJECTS. ANY REPRODUCTION OR TRANSMISSION OF ANY PARTS OF THESE DRAWINGS OR SPECIFICATIONS WITHOUT THE WRITTEN CONSENT OF THE DESIGN PROFESSIONAL IS PROHIBITED. PENALTY FOR VIOLATION: \$500 PER PAGE. HILL-NA-683-1108

PROJECT NAME:

PLANET MAZDA LAS VEGAS
6950 WEST SAHARA AVENUE - LAS VEGAS, NV 89117

SHEET TITLE:

LANDSCAPE PLAN

REV.	DESCRIPTION	DATE

Project No: 2011- 21
Drawn By:
Date: 08-13-2012
Scale:
Sheet No: (8 of 8)

L2.01

14-46359
Dwg 10715898