



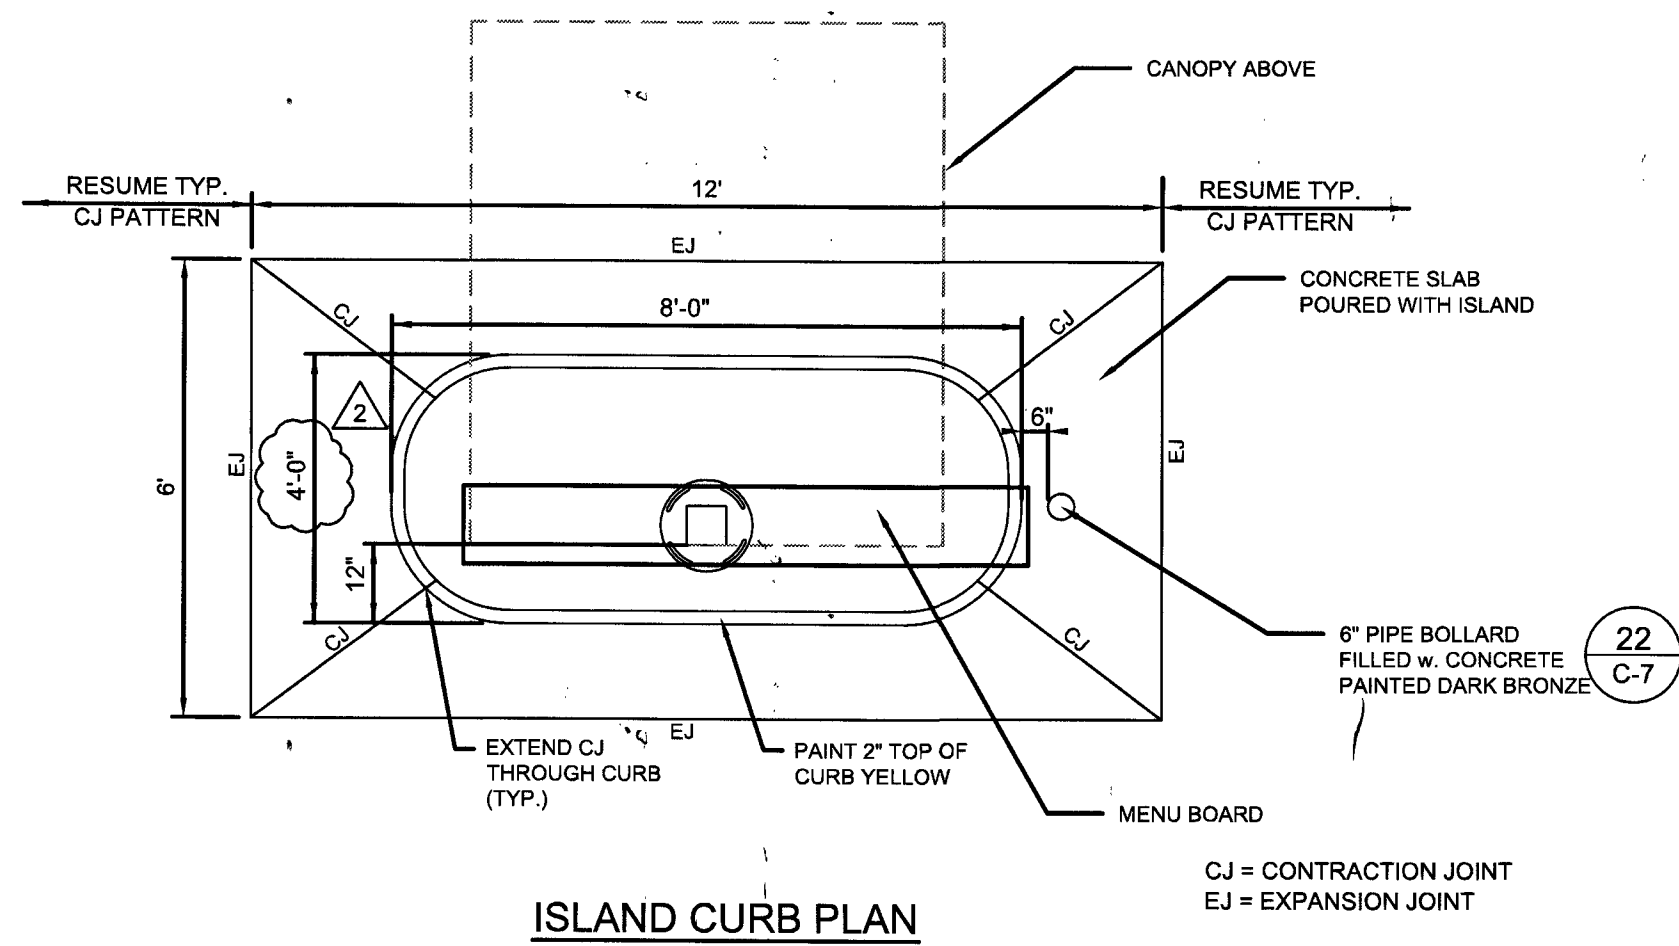


ISLAND CURB PLAN

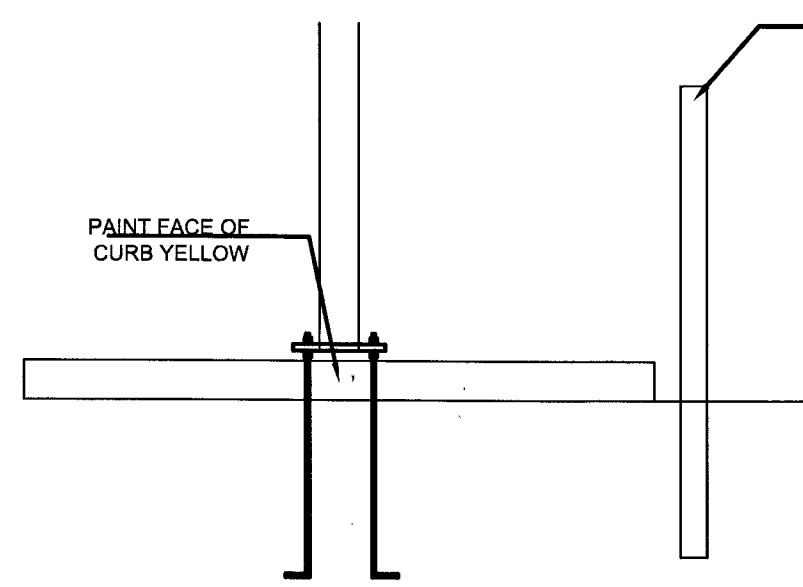


ISLAND CURB ELEVATION

25 DRIVE THRU ORDER POINT ISLAND CURB
NOT TO SCALE

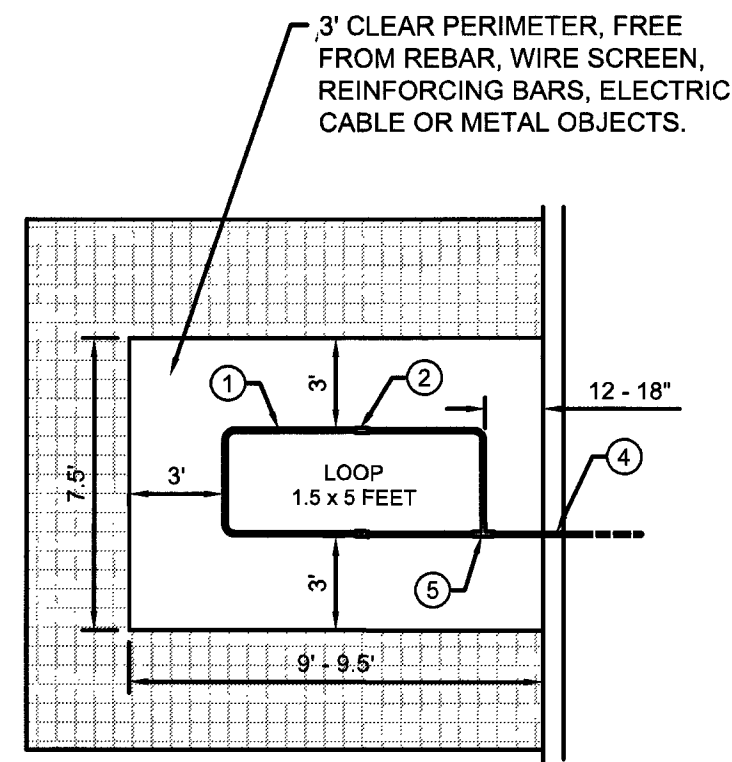


PLAN VIEW

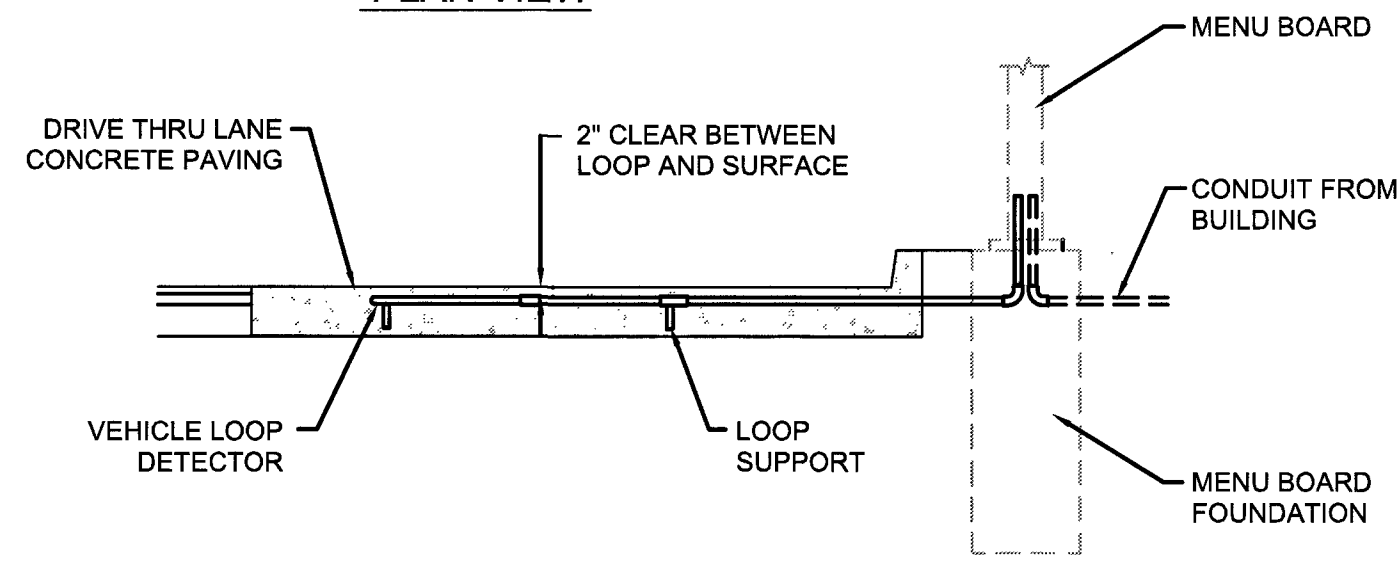

SECTION VIEW

NOTES:
1. LOOP DETECTOR IS MODEL NO. VDL100 VEHICLE DETECTION LOOP MANUFACTURED BY MH ELECTRONICS, INC.
2. FOLLOW MANUFACTURER'S RECOMMENDATIONS FOR INSTALLATION.


26 MENU BOARD LOOP DETECTION SYSTEM
NOT TO SCALE

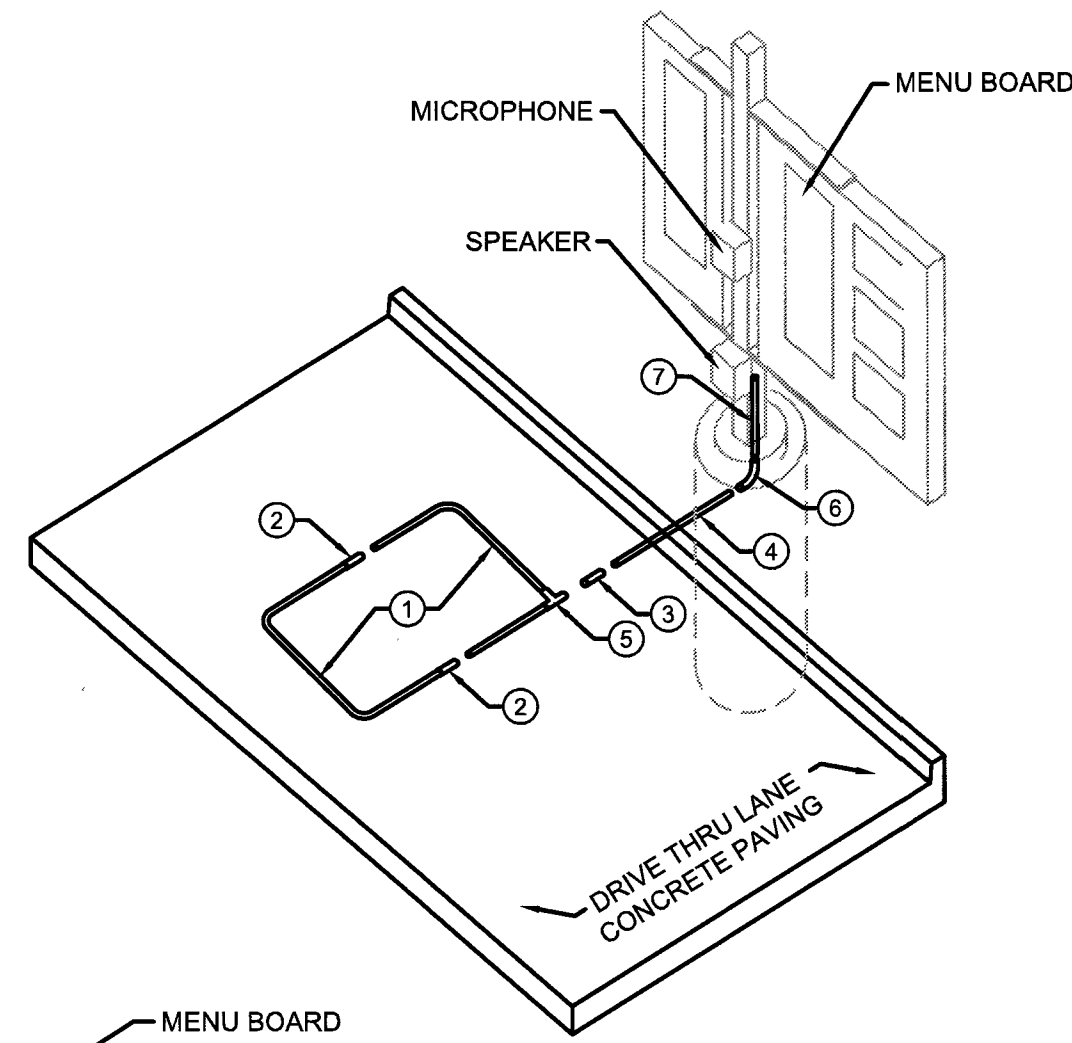


ISOMETRIC VIEW

PARTS LIST


- 1 PREFAB (FOLDED) LOOP (1.5' x 5')
- 2 1/2" PVC COUPLING
- 3 1/2" PVC SLEEVE COUPLING
- 4 1/2" PVC TUBING (3' LENGTH)
- 5 1/2" PVC CORNER FITTING
- 6 1/2" PVC 90° ELBOW
- 7 1/2" PVC TUBING (2' LENGTH)

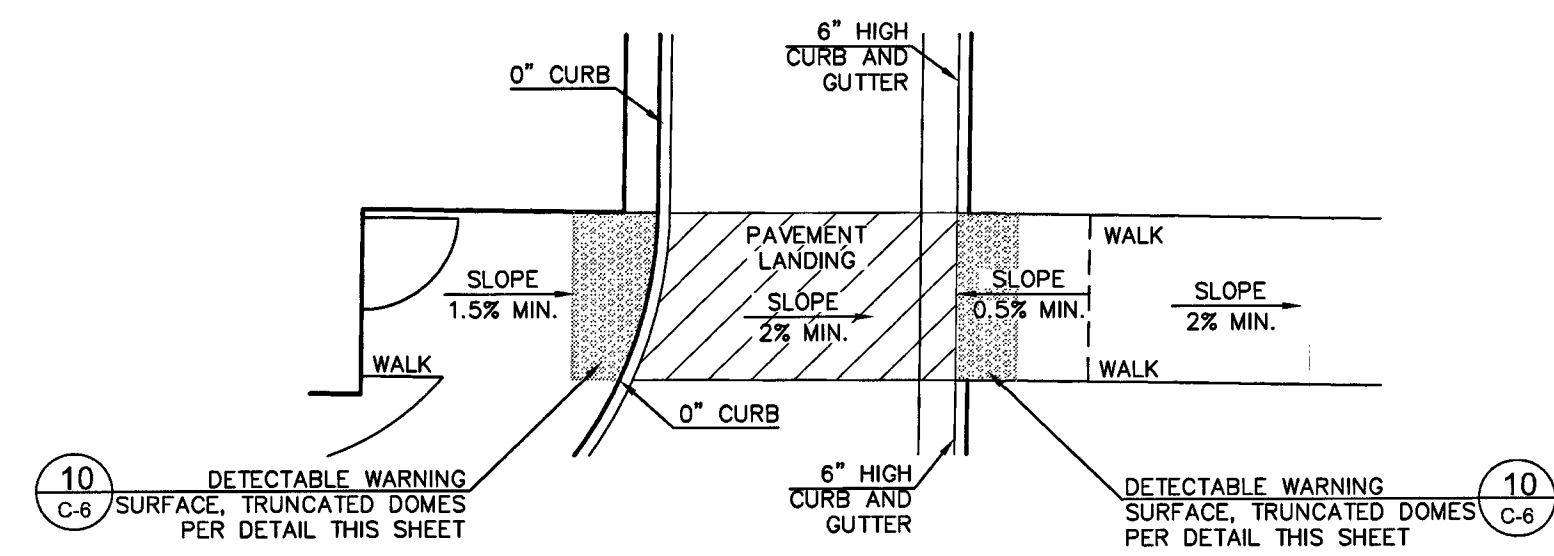


27 ACCESSIBLE ROUTE
NOT TO SCALE

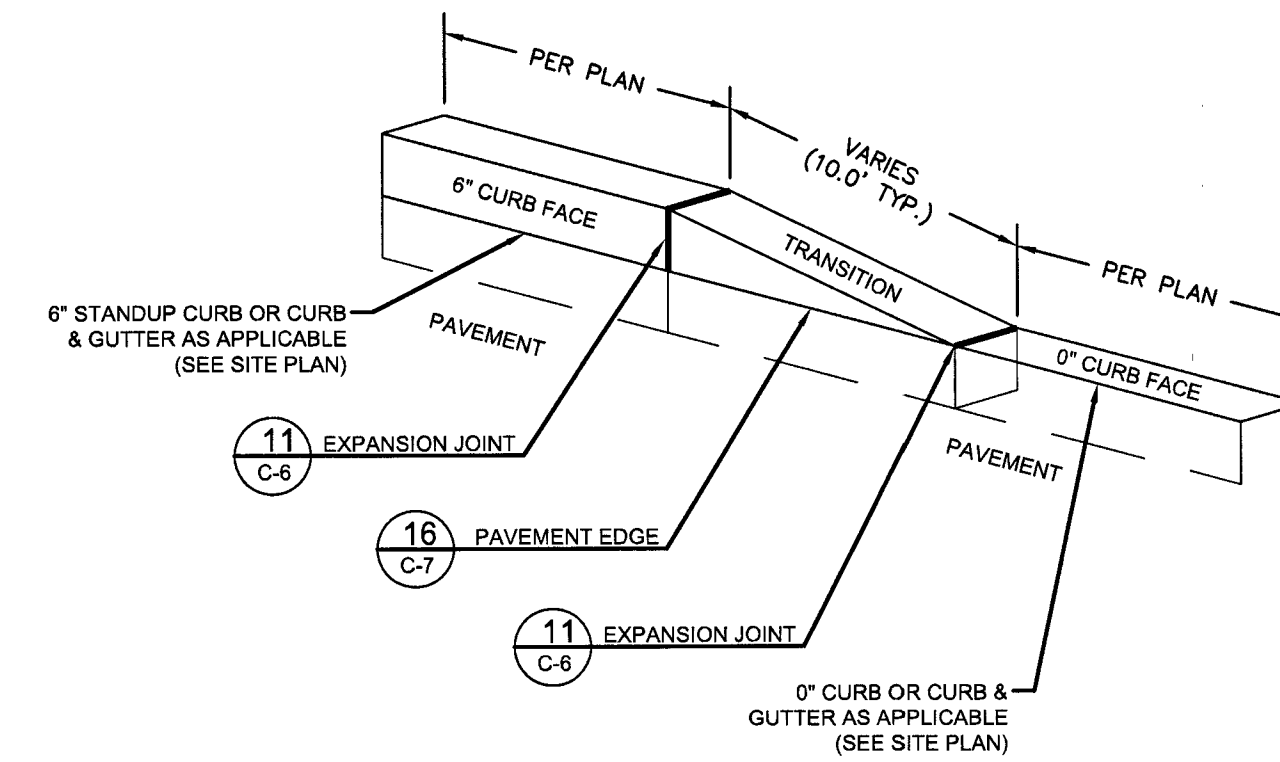

30 TRANSITION 6" CURB TO 0" CURB
NOT TO SCALE

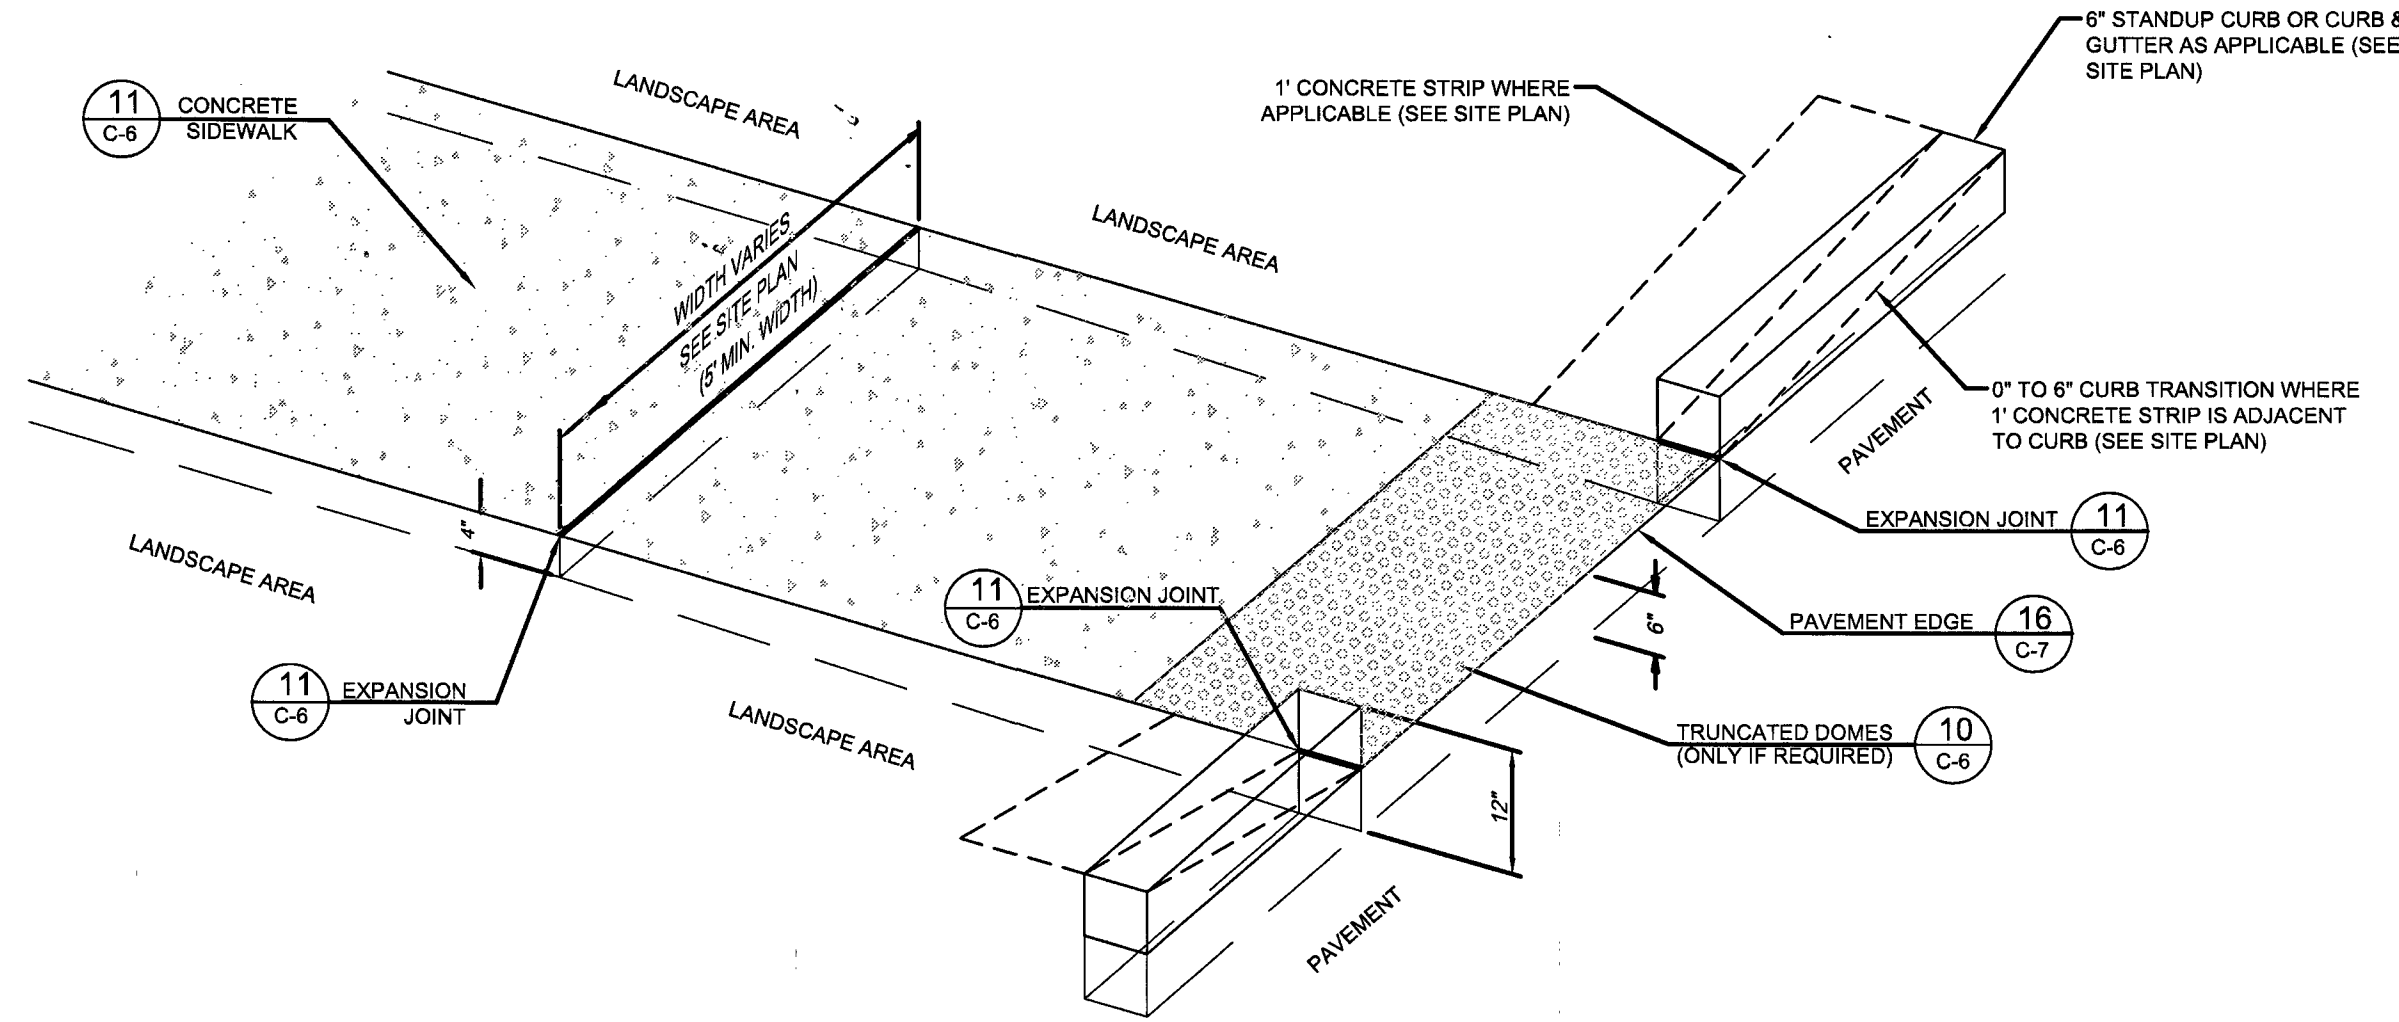


28 SIDEWALK CURB OPENING
NOT TO SCALE

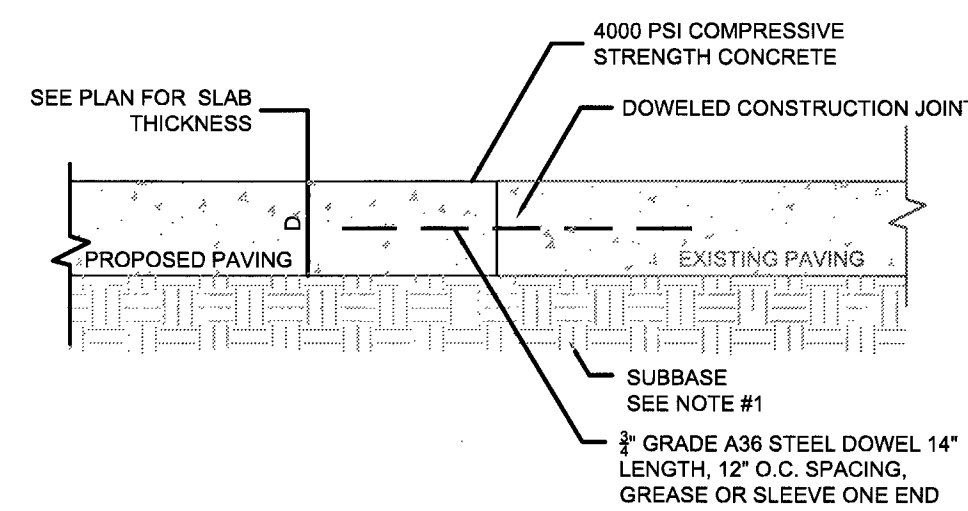


29 TRANSVERSE AND LONGITUDINAL DOWELED CONSTRUCTION JOINT
NOT TO SCALE


NOTE:
1. GENERAL CONTRACTOR SHALL REFERENCE GEOTECHNICAL REPORT FOR PAVEMENT SECTION REQUIREMENTS.

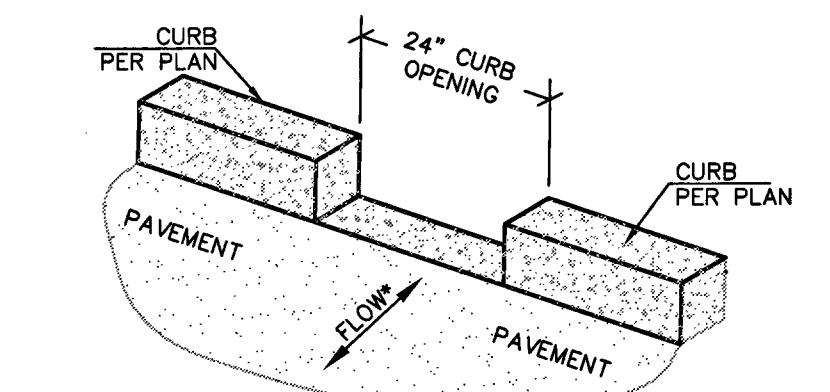

31 2.0' CURB OPENING
NOT TO SCALE

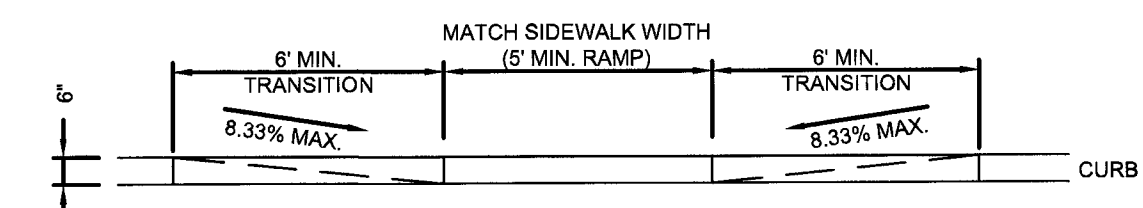


32 CURB RAMP w/ FLARED SIDES
NOT TO SCALE

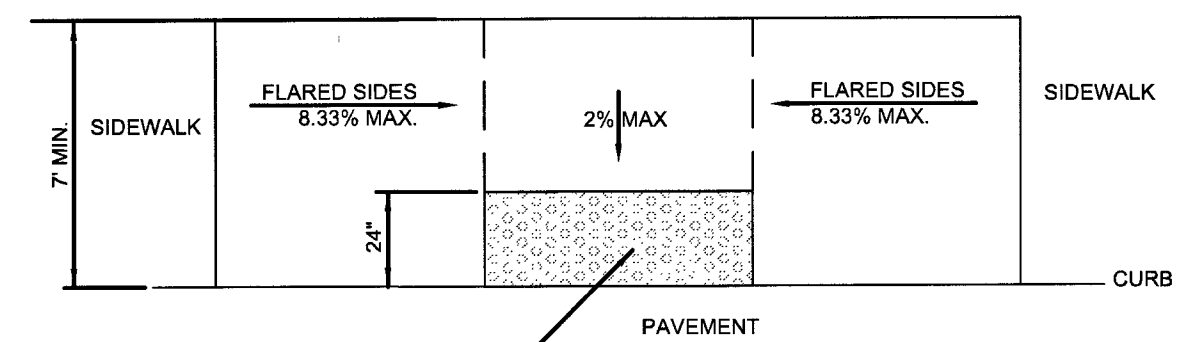

10 TRUNCATED DOMES
C-6 (ONLY IF REQUIRED)

32 CURB RAMP w/ FLARED SIDES
NOT TO SCALE

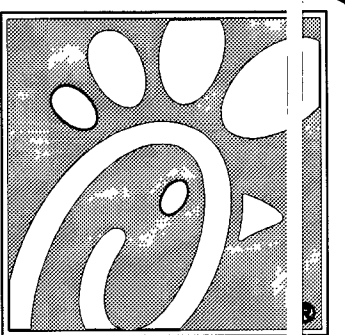

Chick-fil-A

5200 Buffington Rd.
Atlanta Georgia
30349-2998


Revisions:

Mark	Date	By	As
2	6/30/16	AS	CLIENT REV

10/24/16 AM

Mark	Date	By
△		

Mark	Date	By
△		

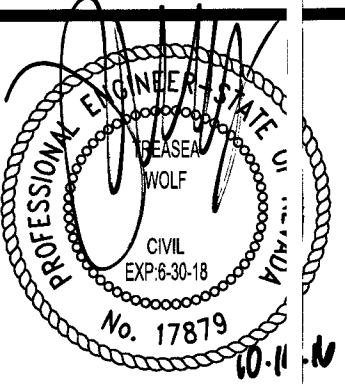

Kimley-Horn
6871 LAS VEGAS BLVD. S. SUITE 320, LAS VEGAS, NV 89119
PHONE: 702-862-3600
WWW.KIMLEY-HORN.COM

STORE
SAHARA @ I-15

NEC SAHARA @
S. RANCHO DR
LAS VEGAS, NV

SHEET TITLE
SITE DETAILS 4

VERSION: R
ISSUE DATE:

Job No. : 14-65

Store : 03729

Date : 10/13/16

Drawn By : F

Checked By: TW

Sheet

C-8

8 OF 10 SHEETS



CLV DRAWING NO. 107V6579 H62229