



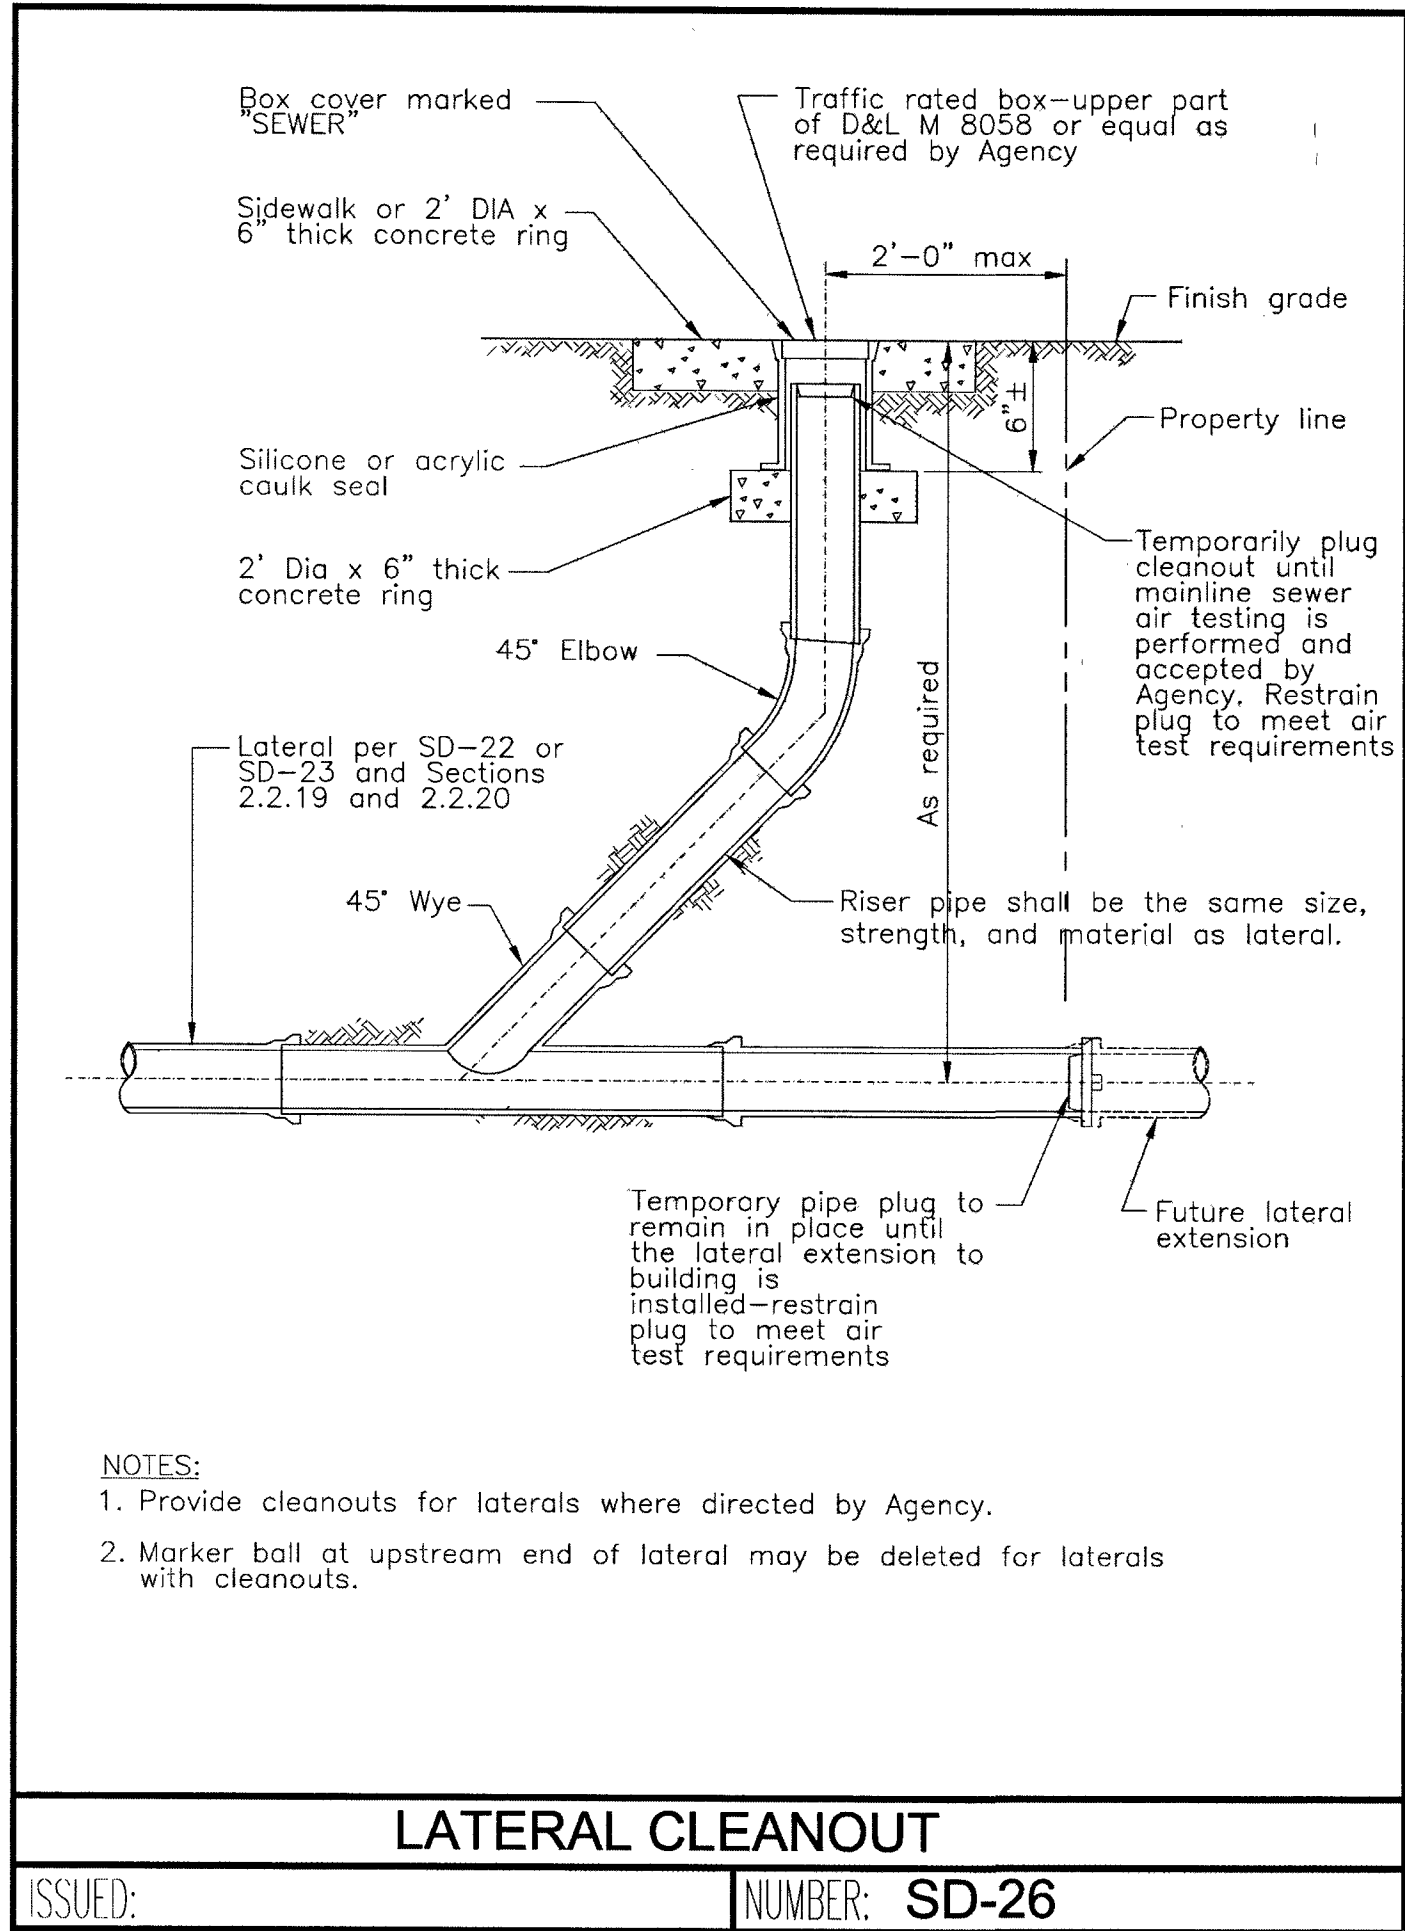


33
C-9

LATERAL CLEANOUT
NOT TO SCALE

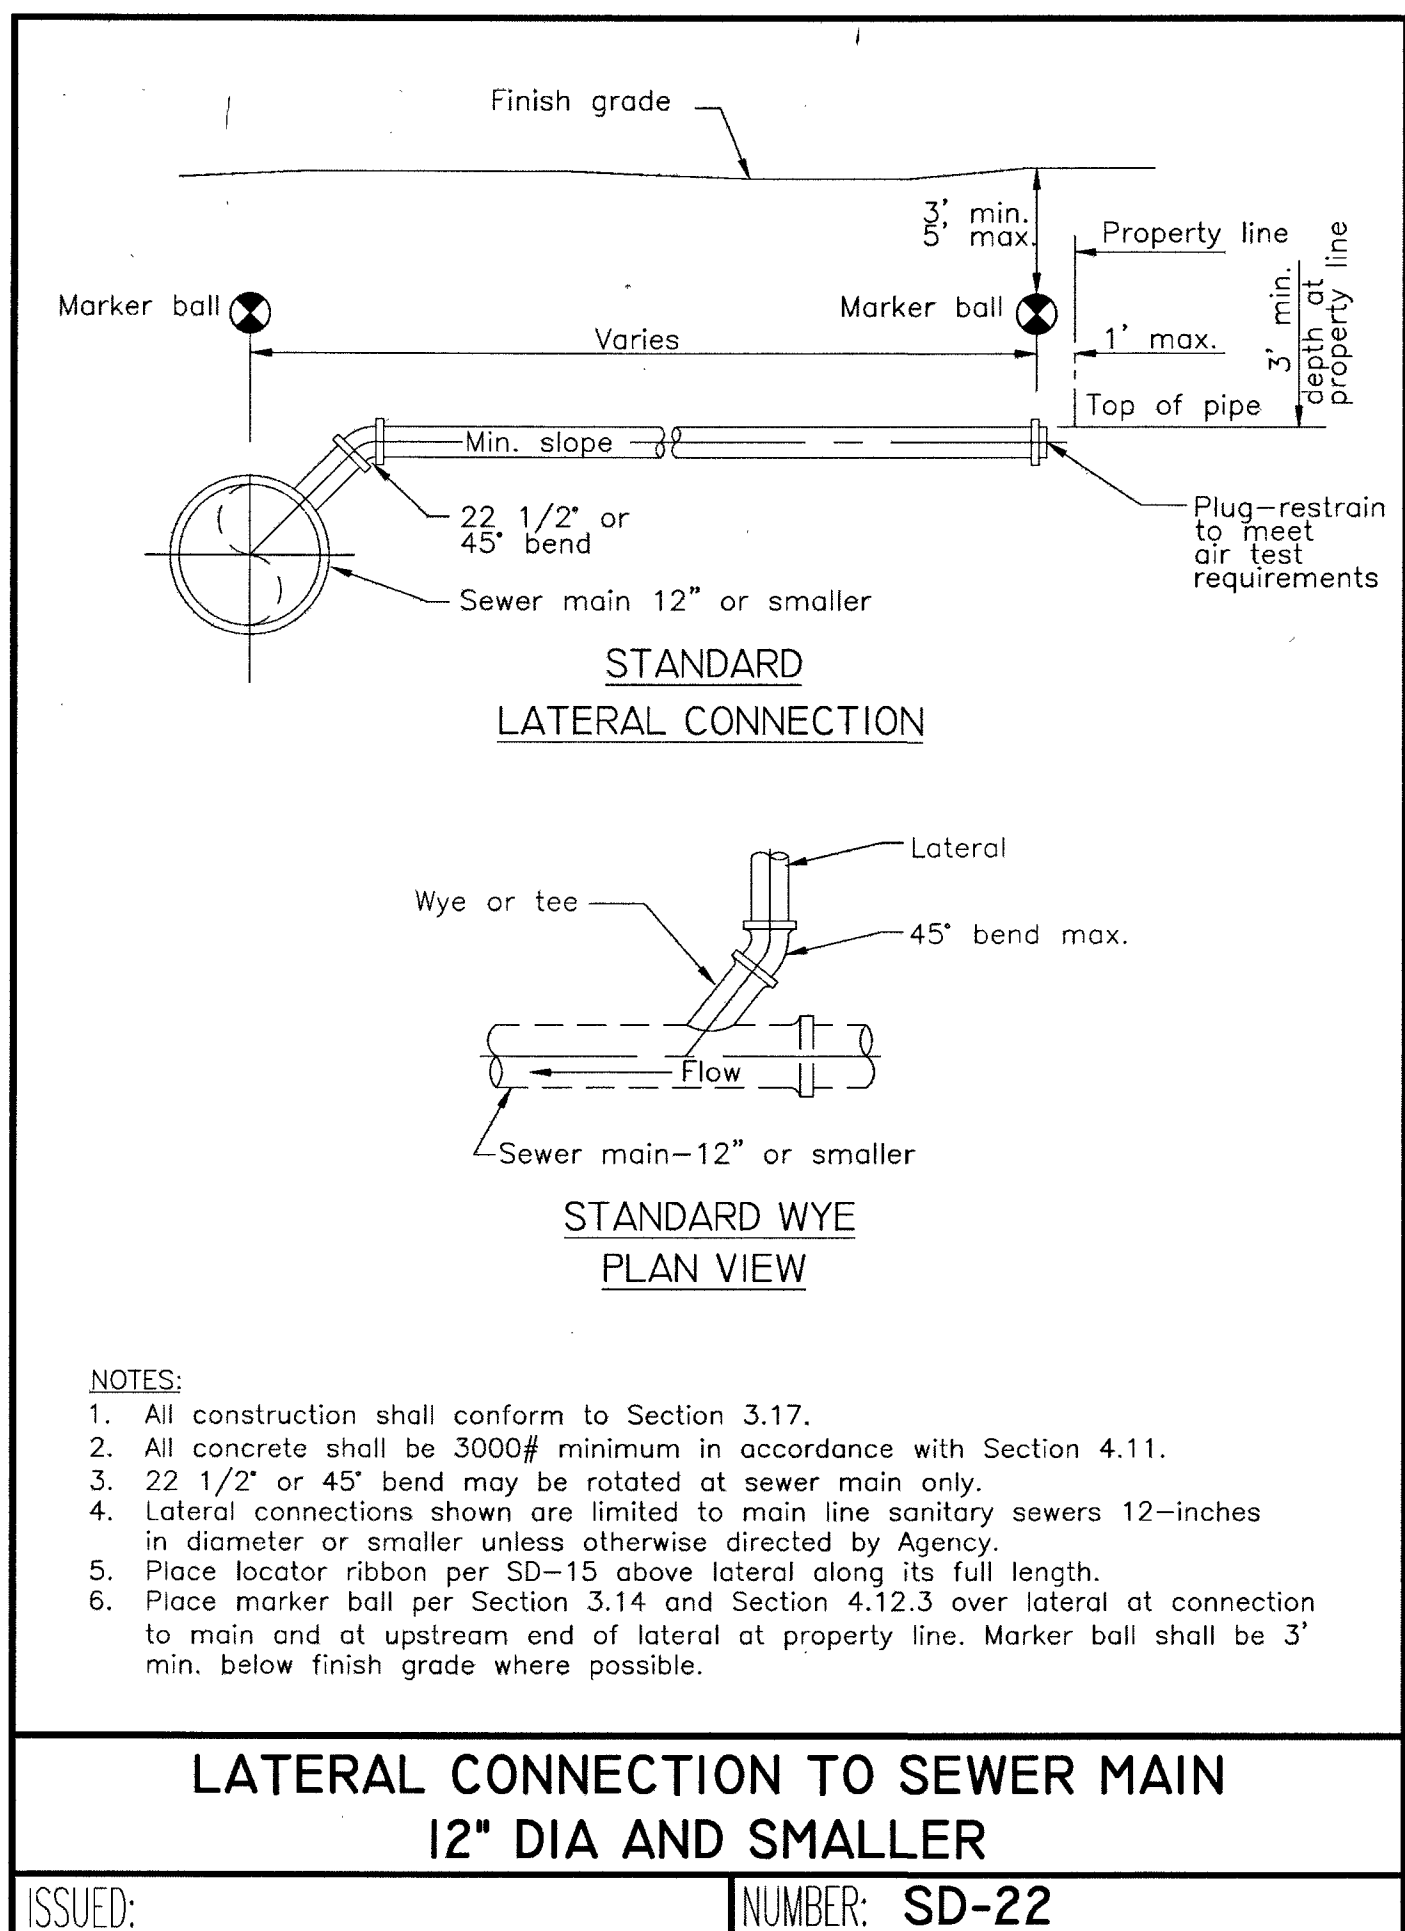


34
C-9

LATERAL CONNECTION
NOT TO SCALE

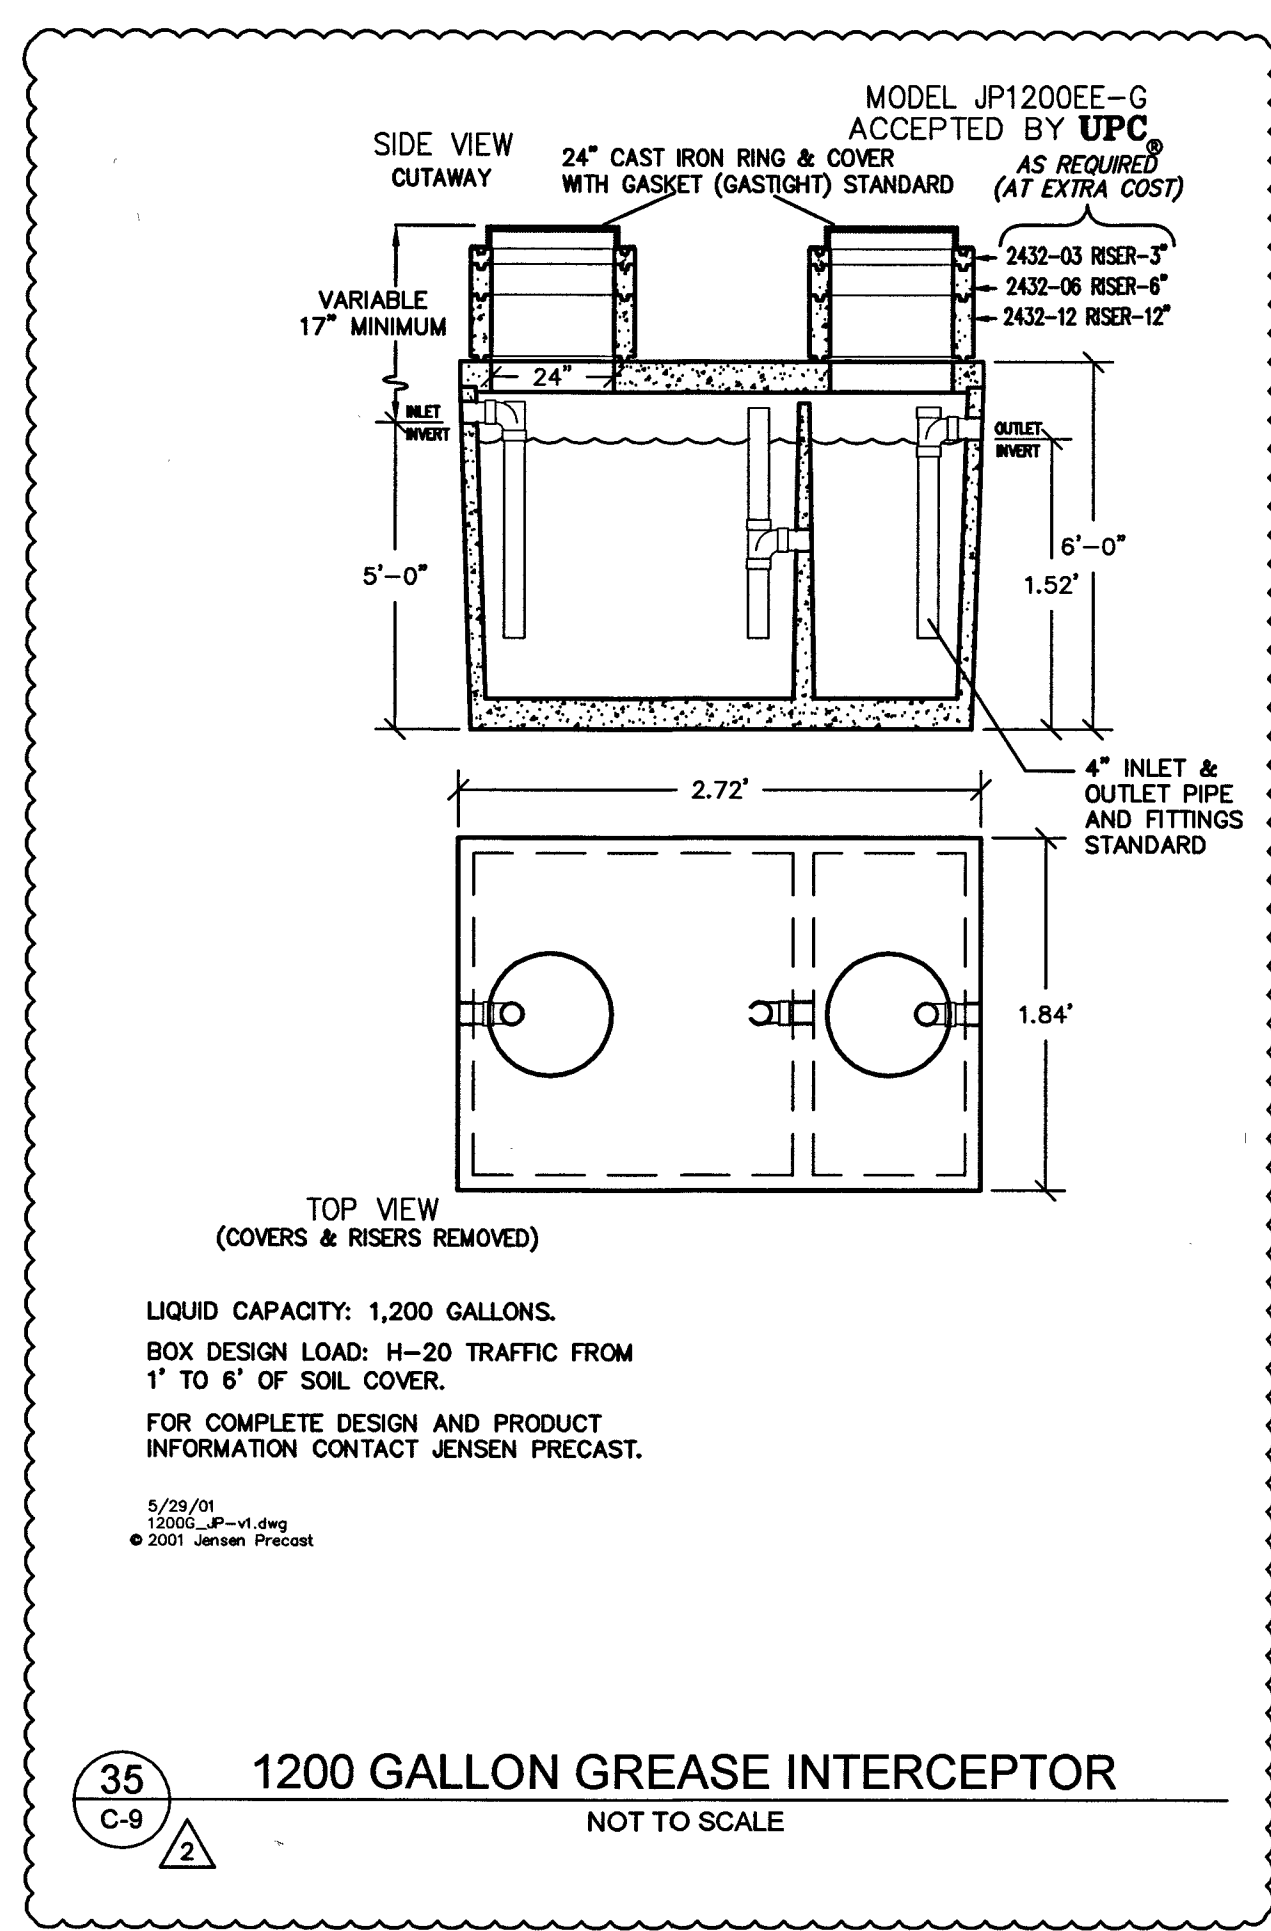


35
C-9

1200 GALLON GREASE INTERCEPTOR
NOT TO SCALE

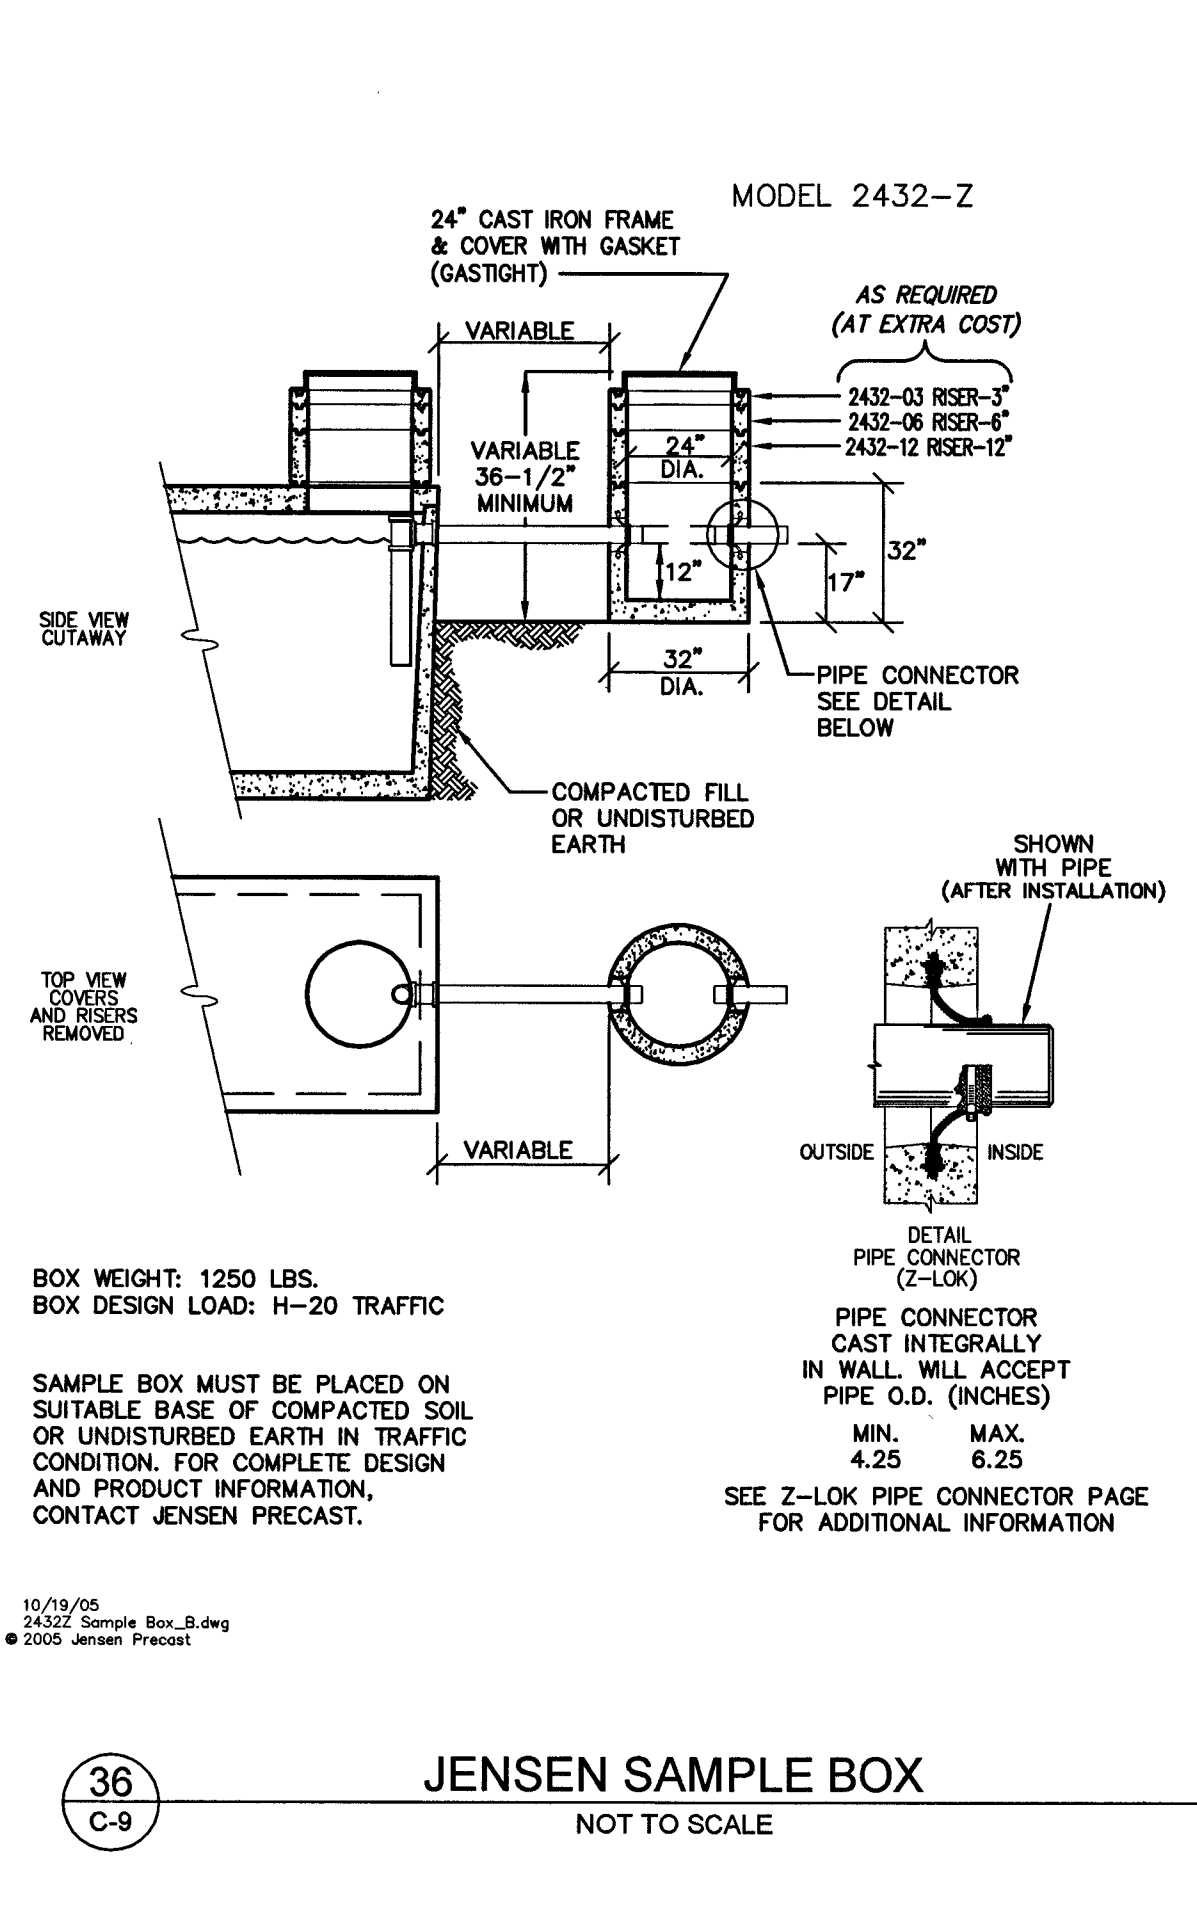

36
C-9

JENSEN SAMPLE BOX
NOT TO SCALE

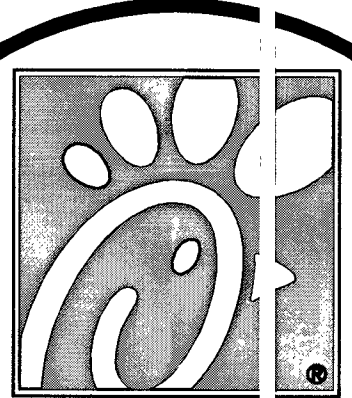

Chick-fil-A

5200 Buffington Rd.
Atlanta, Georgia,
30349-2999


Revisions:

Mark	Date	By
2	6/30/16	MS
CLIENT REV		

10/24/16 LM

Mark	Date	By
1		

Mark	Date	By
1		

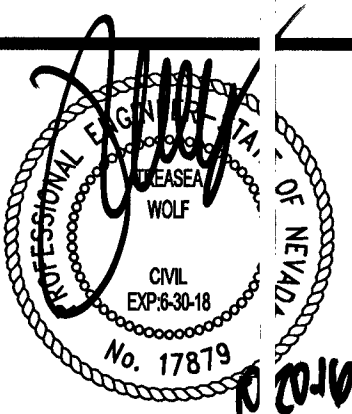

Kimley-Horn
6871 LAS VEGAS BLVD S., SUITE 320, LAS VEGAS, NV 89119
PHONE: 702-882-3600
WWW.KIMLEY-HORN.COM

STORE
SAHARA @ I-15

NEC SAHARA &
S. RANCHO DR.
LAS VEGAS, NV

SHEET TITLE
SITE DETAILS 5

VERSION:
ISSUE DATE:

Job No. : 14-265
Store : 0729
Date : 10/1/16
Drawn By : RC
Checked By : TW

Sheet

C-9

9 OF 10 SHEETS



CLV DRAWING NO. 107V6579 H62229