

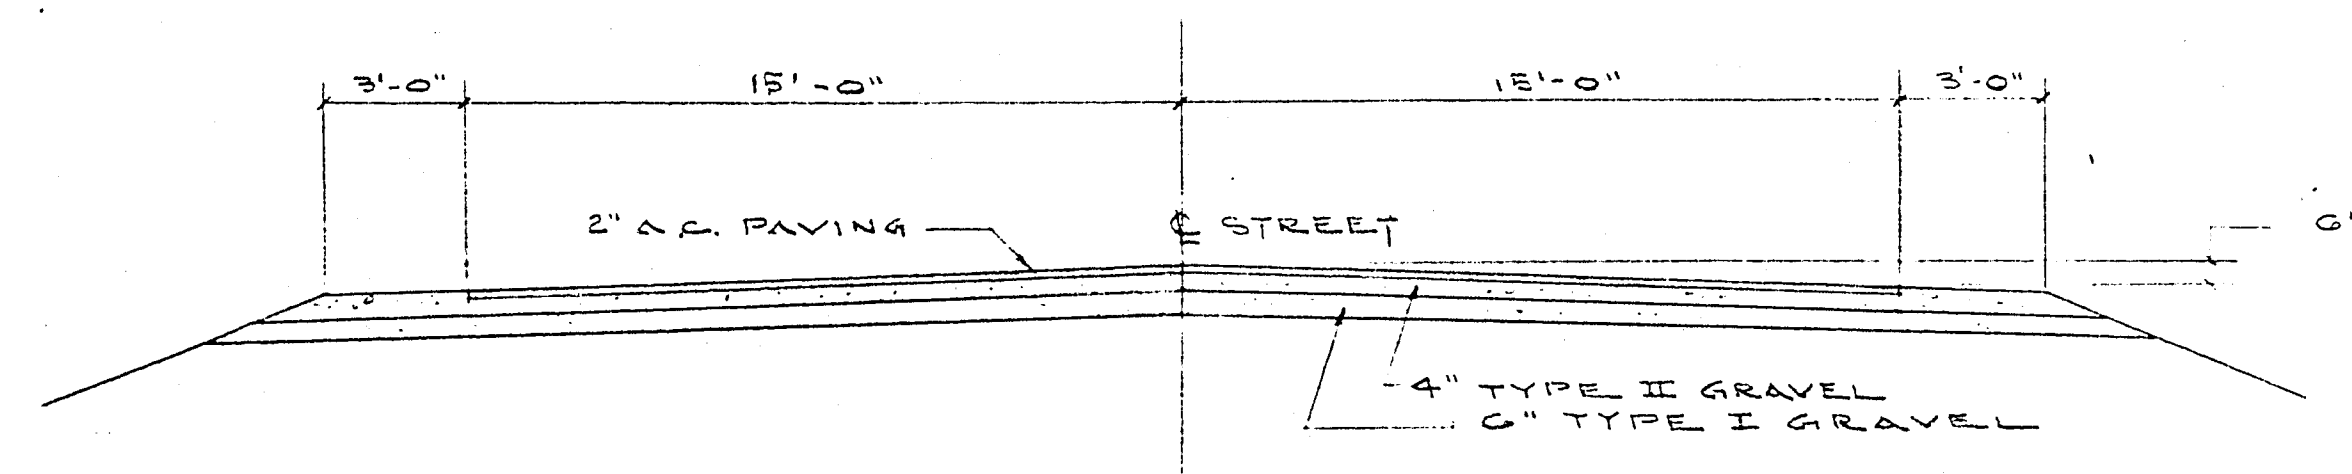


San Francisco #1

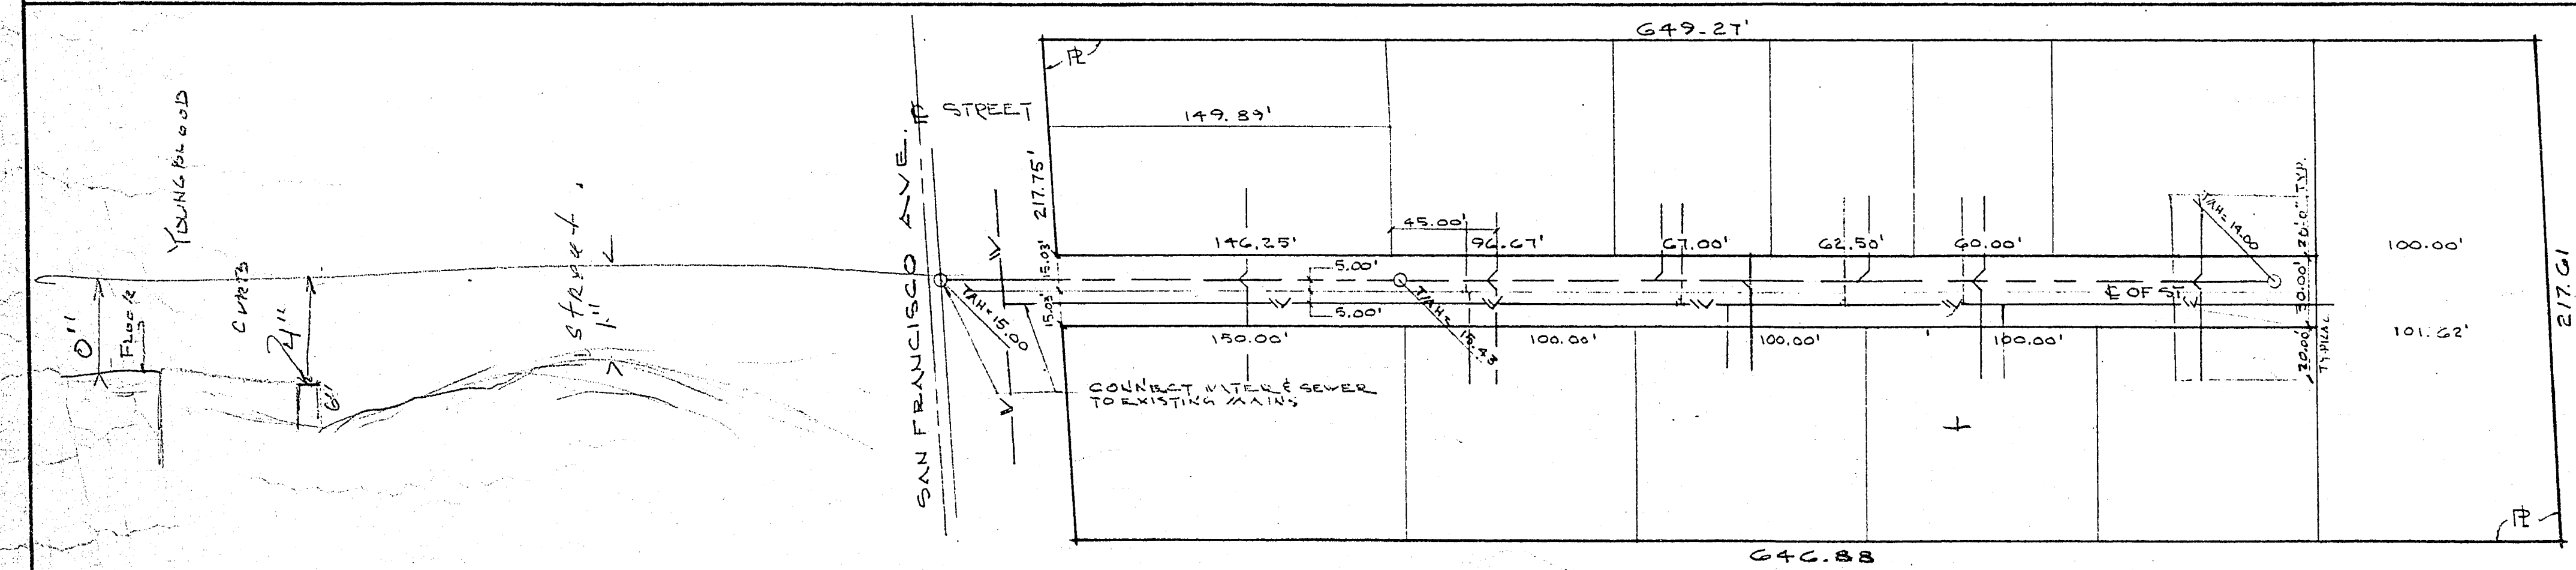


TYPICAL STREET SECTION
NO SCALE

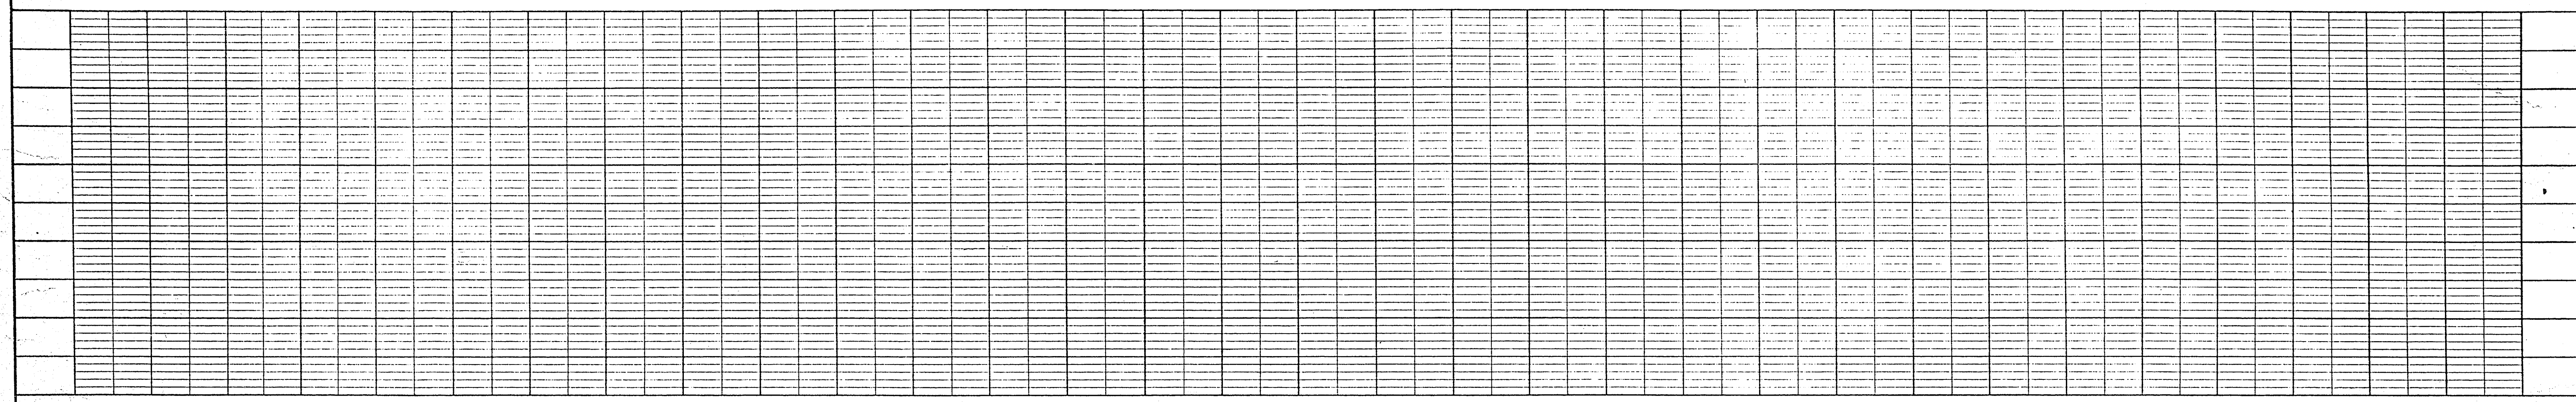

HORIZONTAL SCALE: 1" = 50'-0"
VERTICAL SCALE: 1" = 5'-0"

WATER - 150 SCHEDULE ACP 6" DIA.
SEWER - 8" VITRIFIED CLAY PIPE
NOTE: ALL WORK SHALL BE DONE IN COMPLIANCE
WITH THE CITY OF LAS VEGAS & THE LAS VEGAS
VALLEY WATER DISTRICTS ORDINANCES CODES &
STANDARD SPECIFICATIONS.

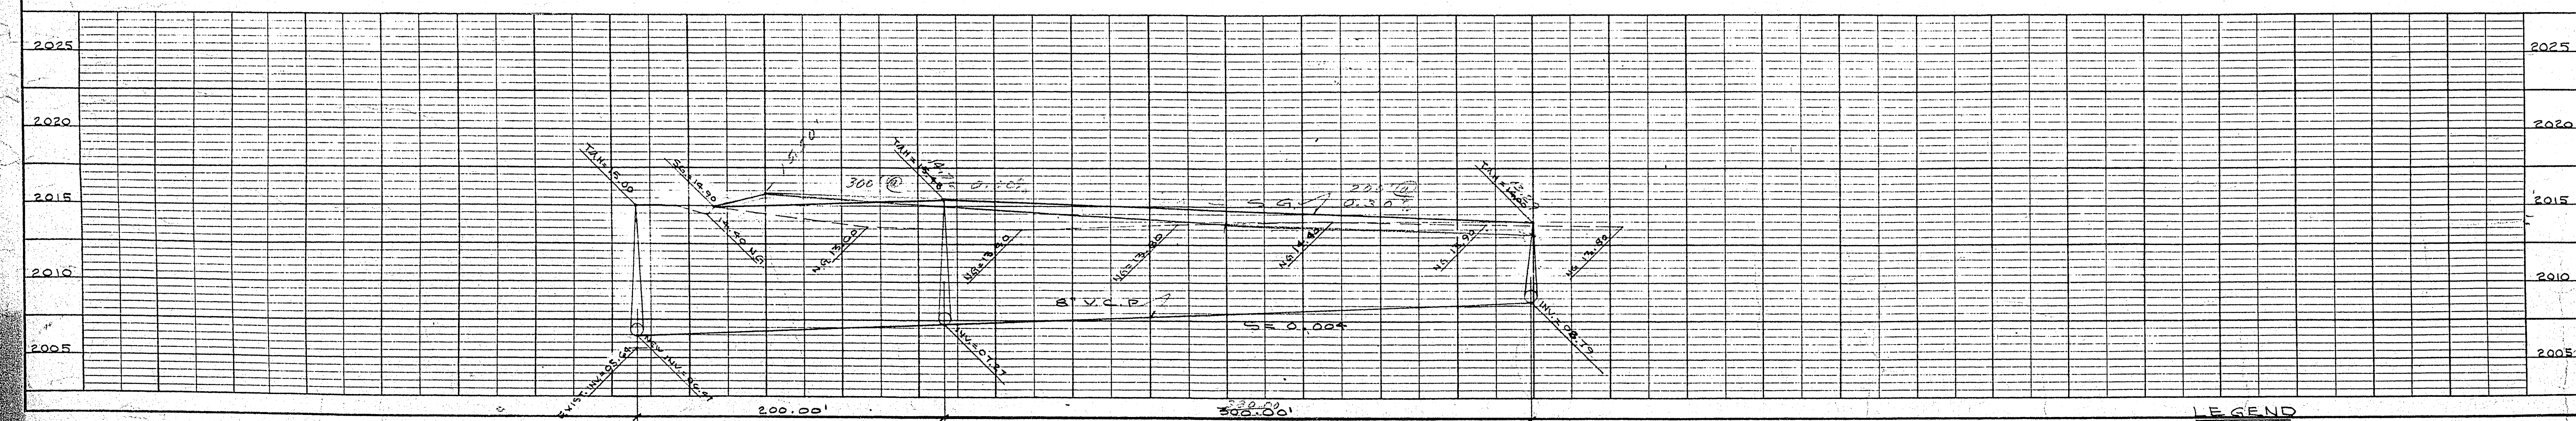

LEGEND
S.G. = STREET GRADE
N.G. = NATURAL GRADE
T.M. = TOP OF MANHOLE
W = WATER LINE
S = SEWER LINE