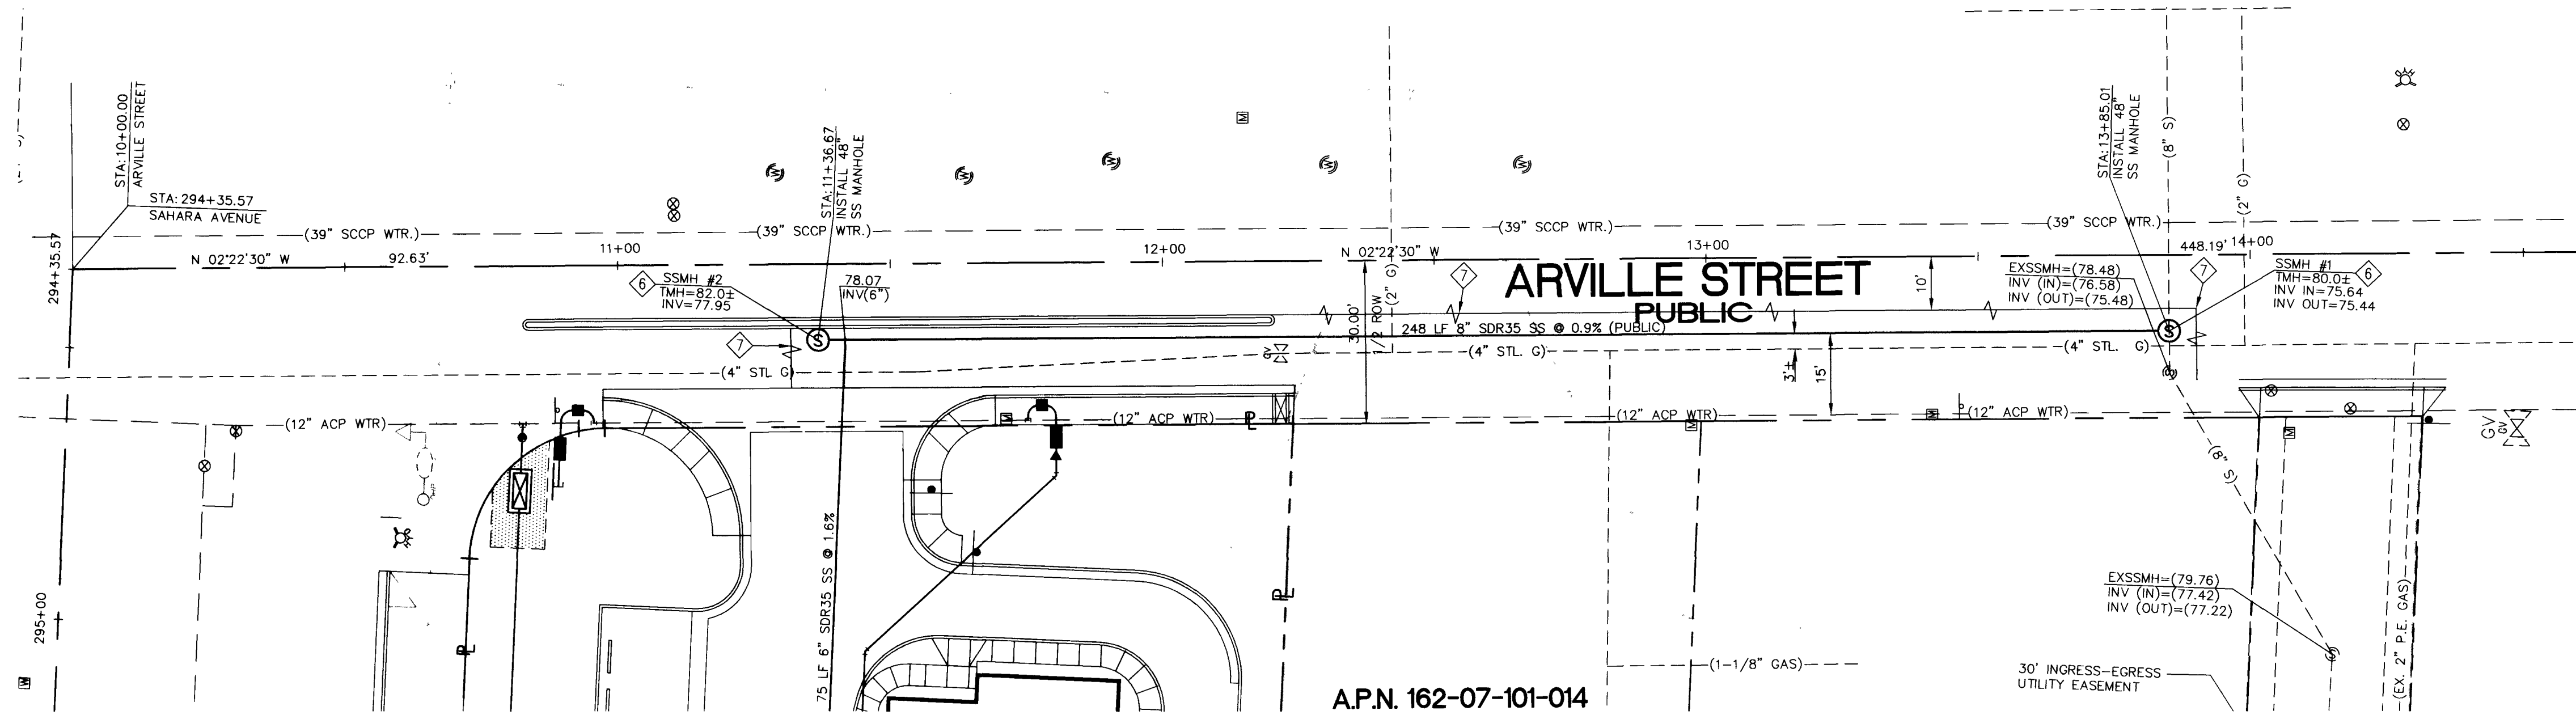


BENCHMARK

CITY OF LAS VEGAS VERTICAL CONTROL POINT "7C11 654" BEING AN NDOT BRASS CAP IN TOP OF CURB, NW RETURN SAHARA AVENUE AND ARVILLE STREET.

ELEVATION = 2182.71 FEET (665.2911 METERS)
NORTH AMERICAN VERTICAL DATUM OF 1988 (NAVD88)

BASIS OF BEARING

NORTH 02°22'30" WEST, BEING THE EAST LINE OF THE NORTHWEST QUARTER (NW 1/4) OF SECTION 7, TOWNSHIP 21 SOUTH, RANGE 61 EAST, M.D.M., AS SHOWN IN FILE 38, PAGE 7 OF SURVEYS ON FILE AT THE CLARK COUNTY RECORDERS OFFICE.

SEWER CONSTRUCTION NOTES

- 6 INSTALL 48" SS MANHOLE
- 7 SAWCUT, TRENCH, BACKFILL AND REPAVE PER CCASD #503

DISCLAIMER NOTE

UTILITY LOCATIONS SHOWN HEREON ARE APPROXIMATE ONLY. IT SHALL BE THE CONTRACTOR'S RESPONSIBILITY TO DETERMINE THE EXACT HORIZONTAL AND VERTICAL LOCATION OF ALL EXISTING UNDERGROUND AND OVERHEAD UTILITIES PRIOR TO COMMENCING CONSTRUCTION. NO REPRESENTATION IS MADE THAT ALL EXISTING UTILITIES ARE SHOWN HEREON. THE ENGINEER ASSUMES NO RESPONSIBILITY FOR UTILITIES NOT SHOWN OR UTILITIES NOT SHOWN IN THEIR PROPER LOCATION.


PLAN VIEW
HORIZONTAL: 1" = 20'
VERTICAL: NONE

AVOID CUTTING UNDERGROUND UTILITY LINES. IT'S COSTLY.

Call before you Dig.
1-800-227-2600
UNDERGROUND SERVICE (USA)

AVOID HITTING OVERHEAD POWER LINES. IT'S COSTLY.


CALL BEFORE YOU CRANE
1-702-227-2929

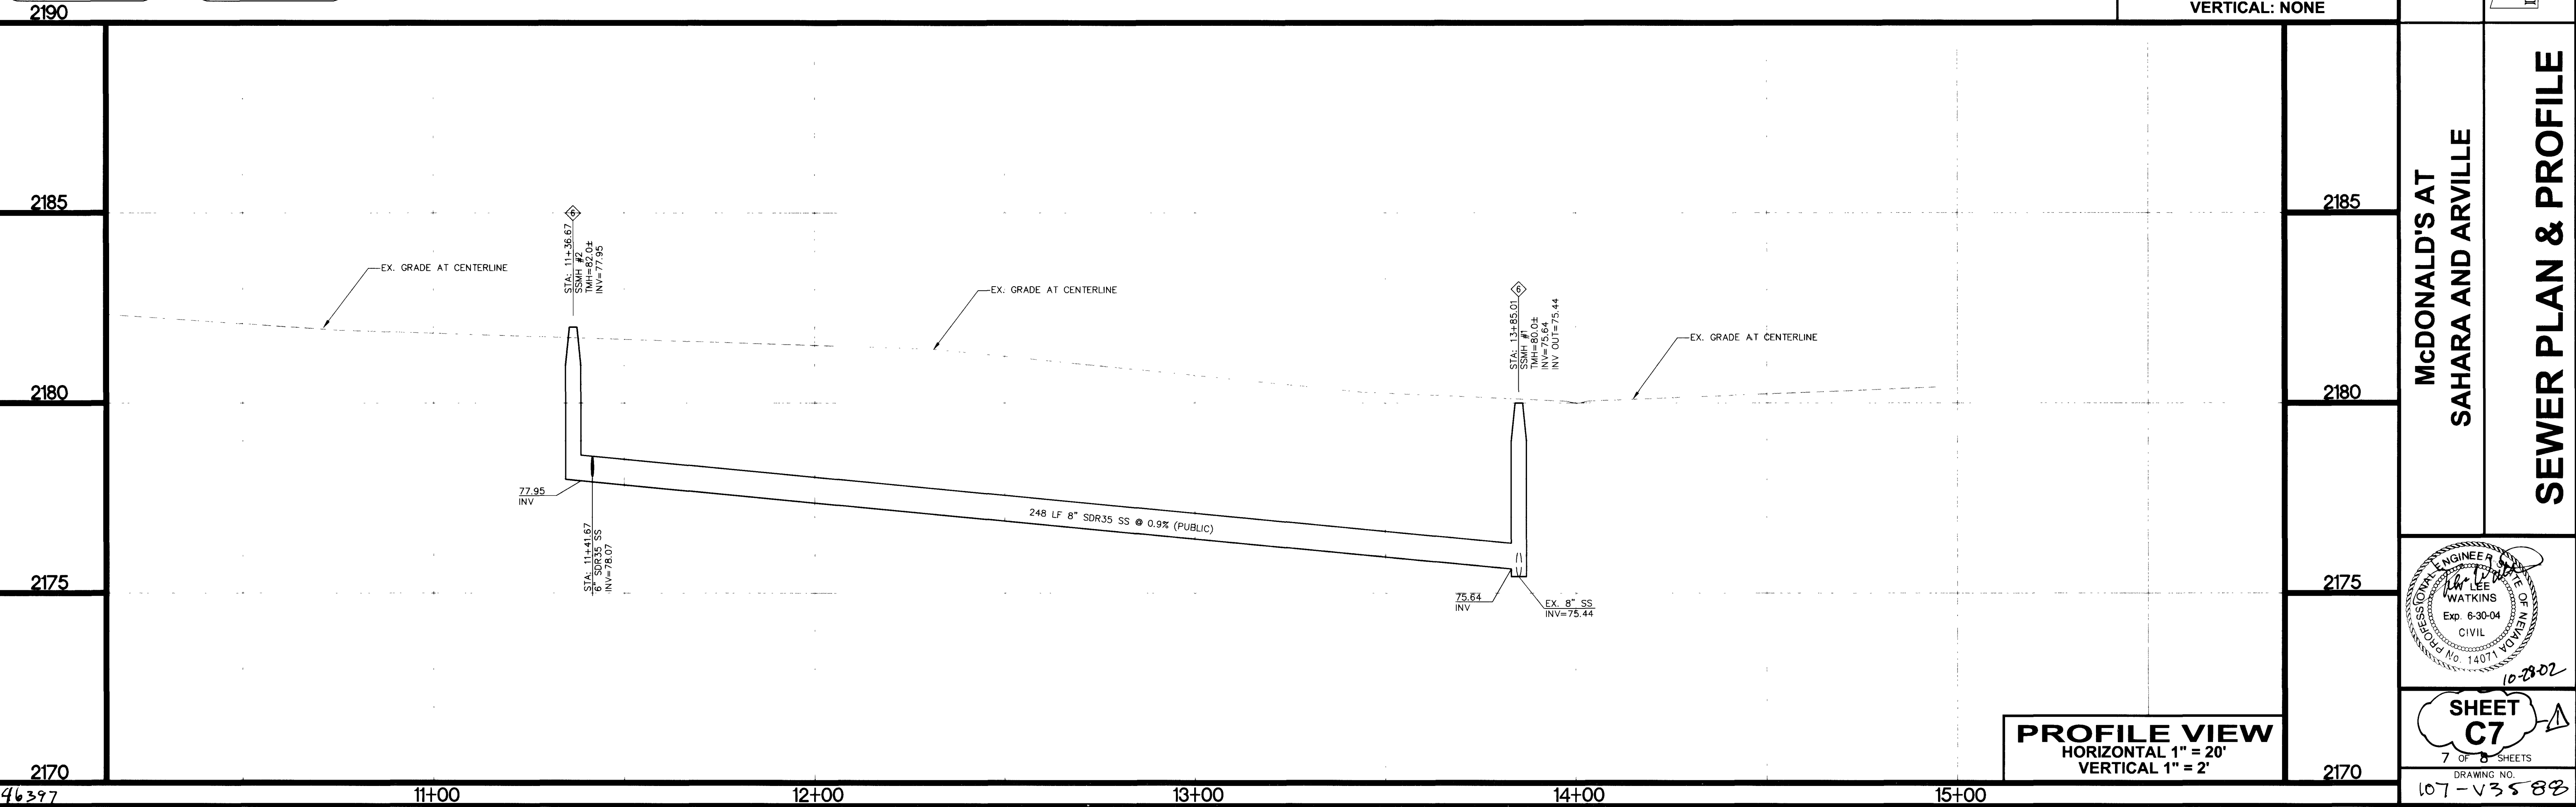

PROFILE VIEW
HORIZONTAL 1" = 20'
VERTICAL 1" = 2'

**McDONALD'S AT
SAHARA AND ARVILLE**

SEWER PLAN & PROFILE

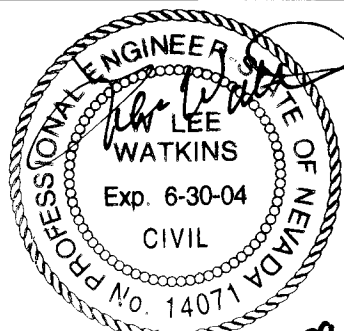

SHEET C7
7 OF 8 SHEETS

DRAWING NO. 107-V3588

INTEGRITY
ENGINEERING

2480 E. Tompkins Ave.
Suite # 232
Las Vegas, NV 89121
Phone: 702.456.4664
Fax: 702.456.4919

CHECKED BY:	WLV				DESIGNER'S INITIALS
SUBMITTAL DATE:					
JOB NO:	17-103				
REVISION APPROVAL BLOCK					
	REV. #	BY	DATE	DESCRIPTION	
	1	WLV	10-14-22	REMOVE & REPLACE SEWER PROFILE	YES