

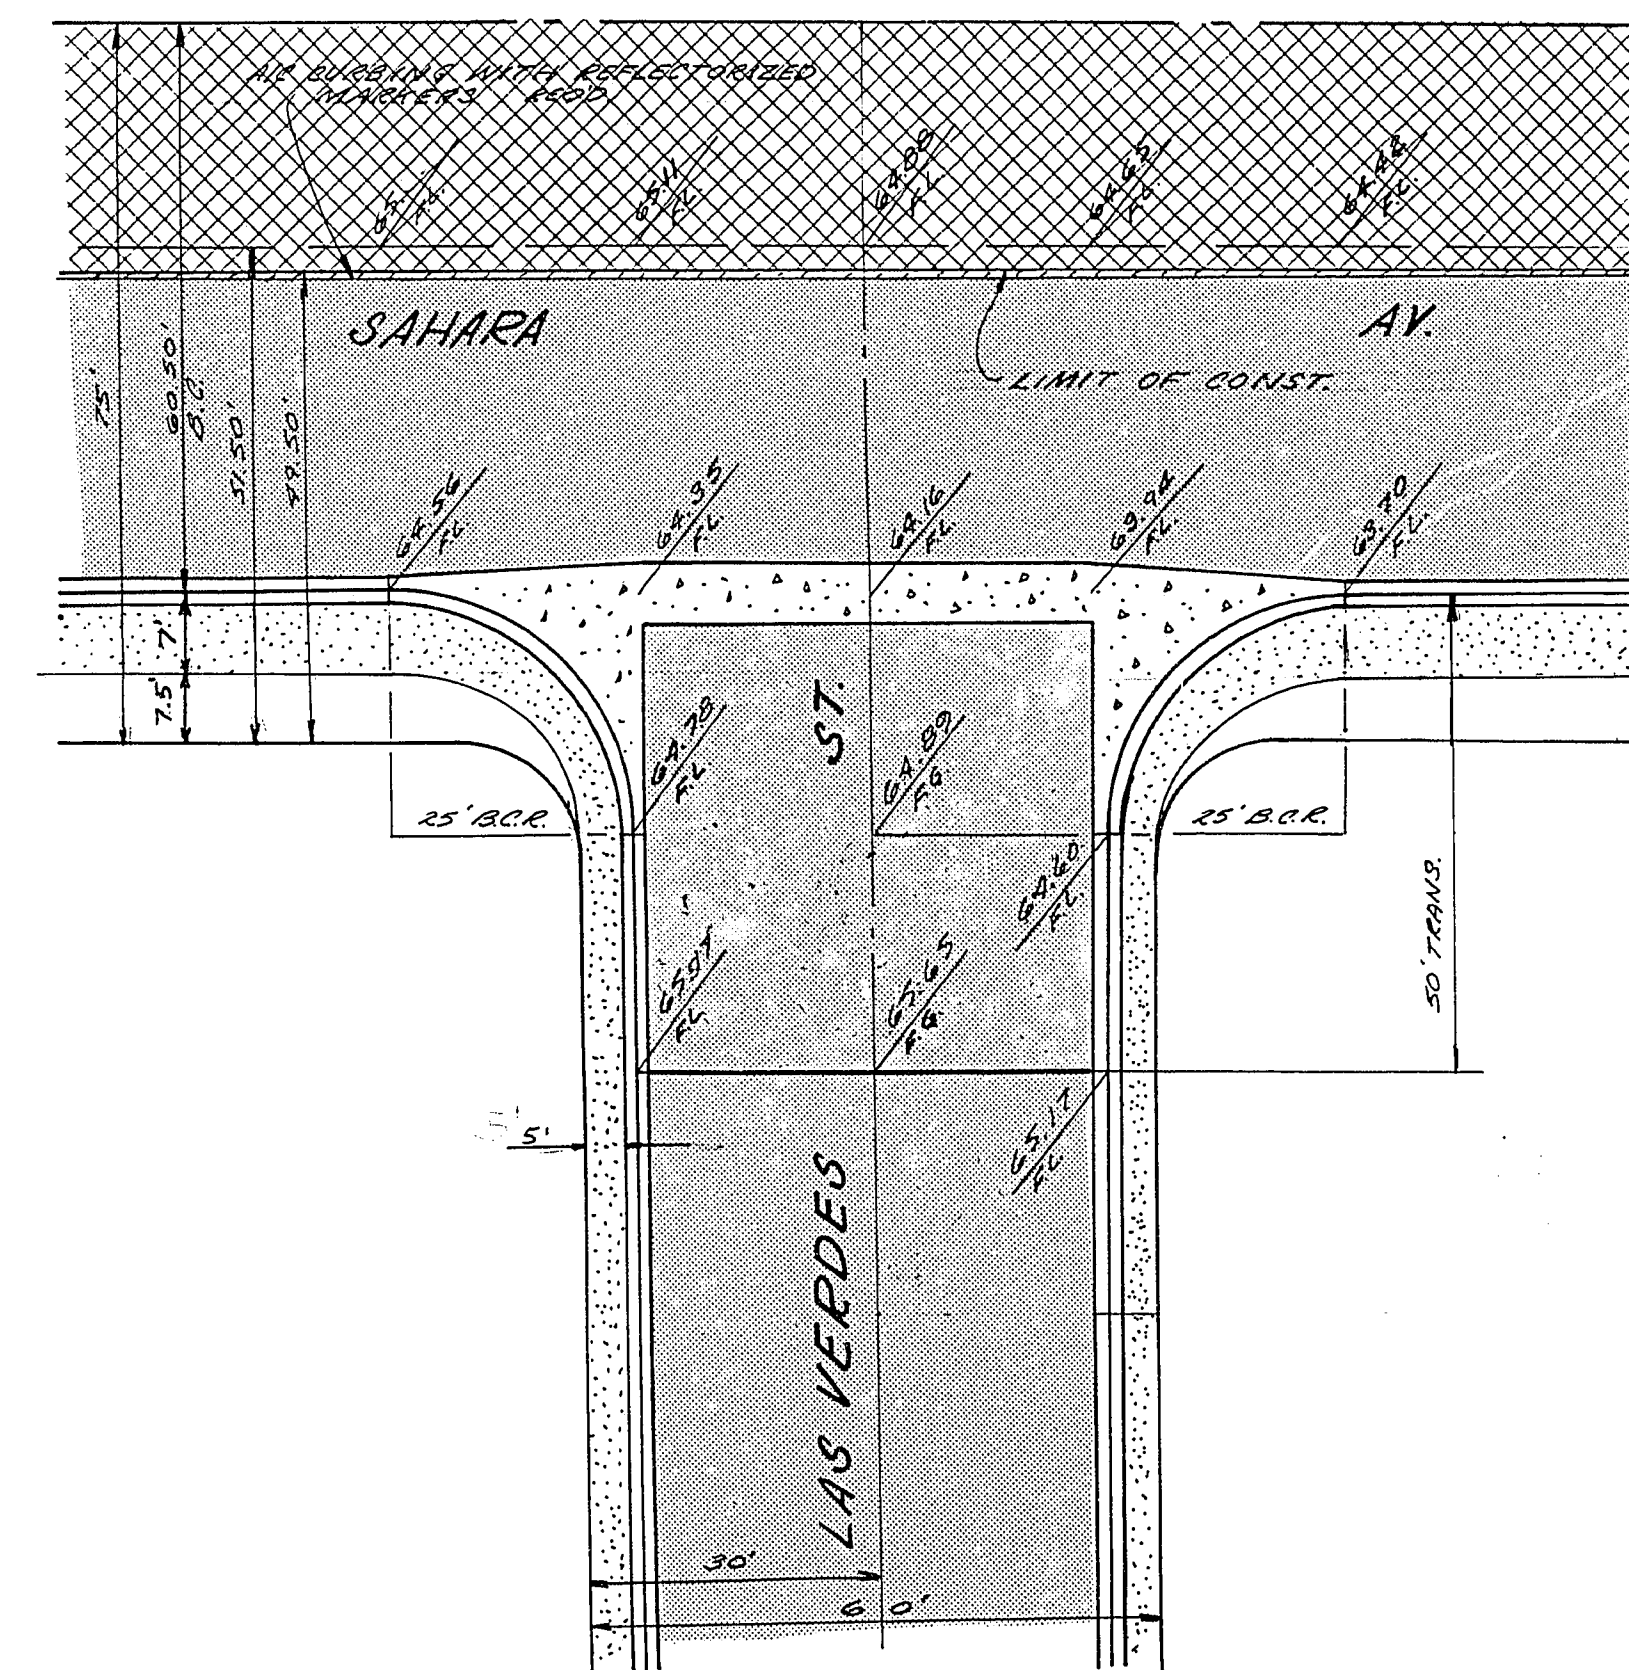
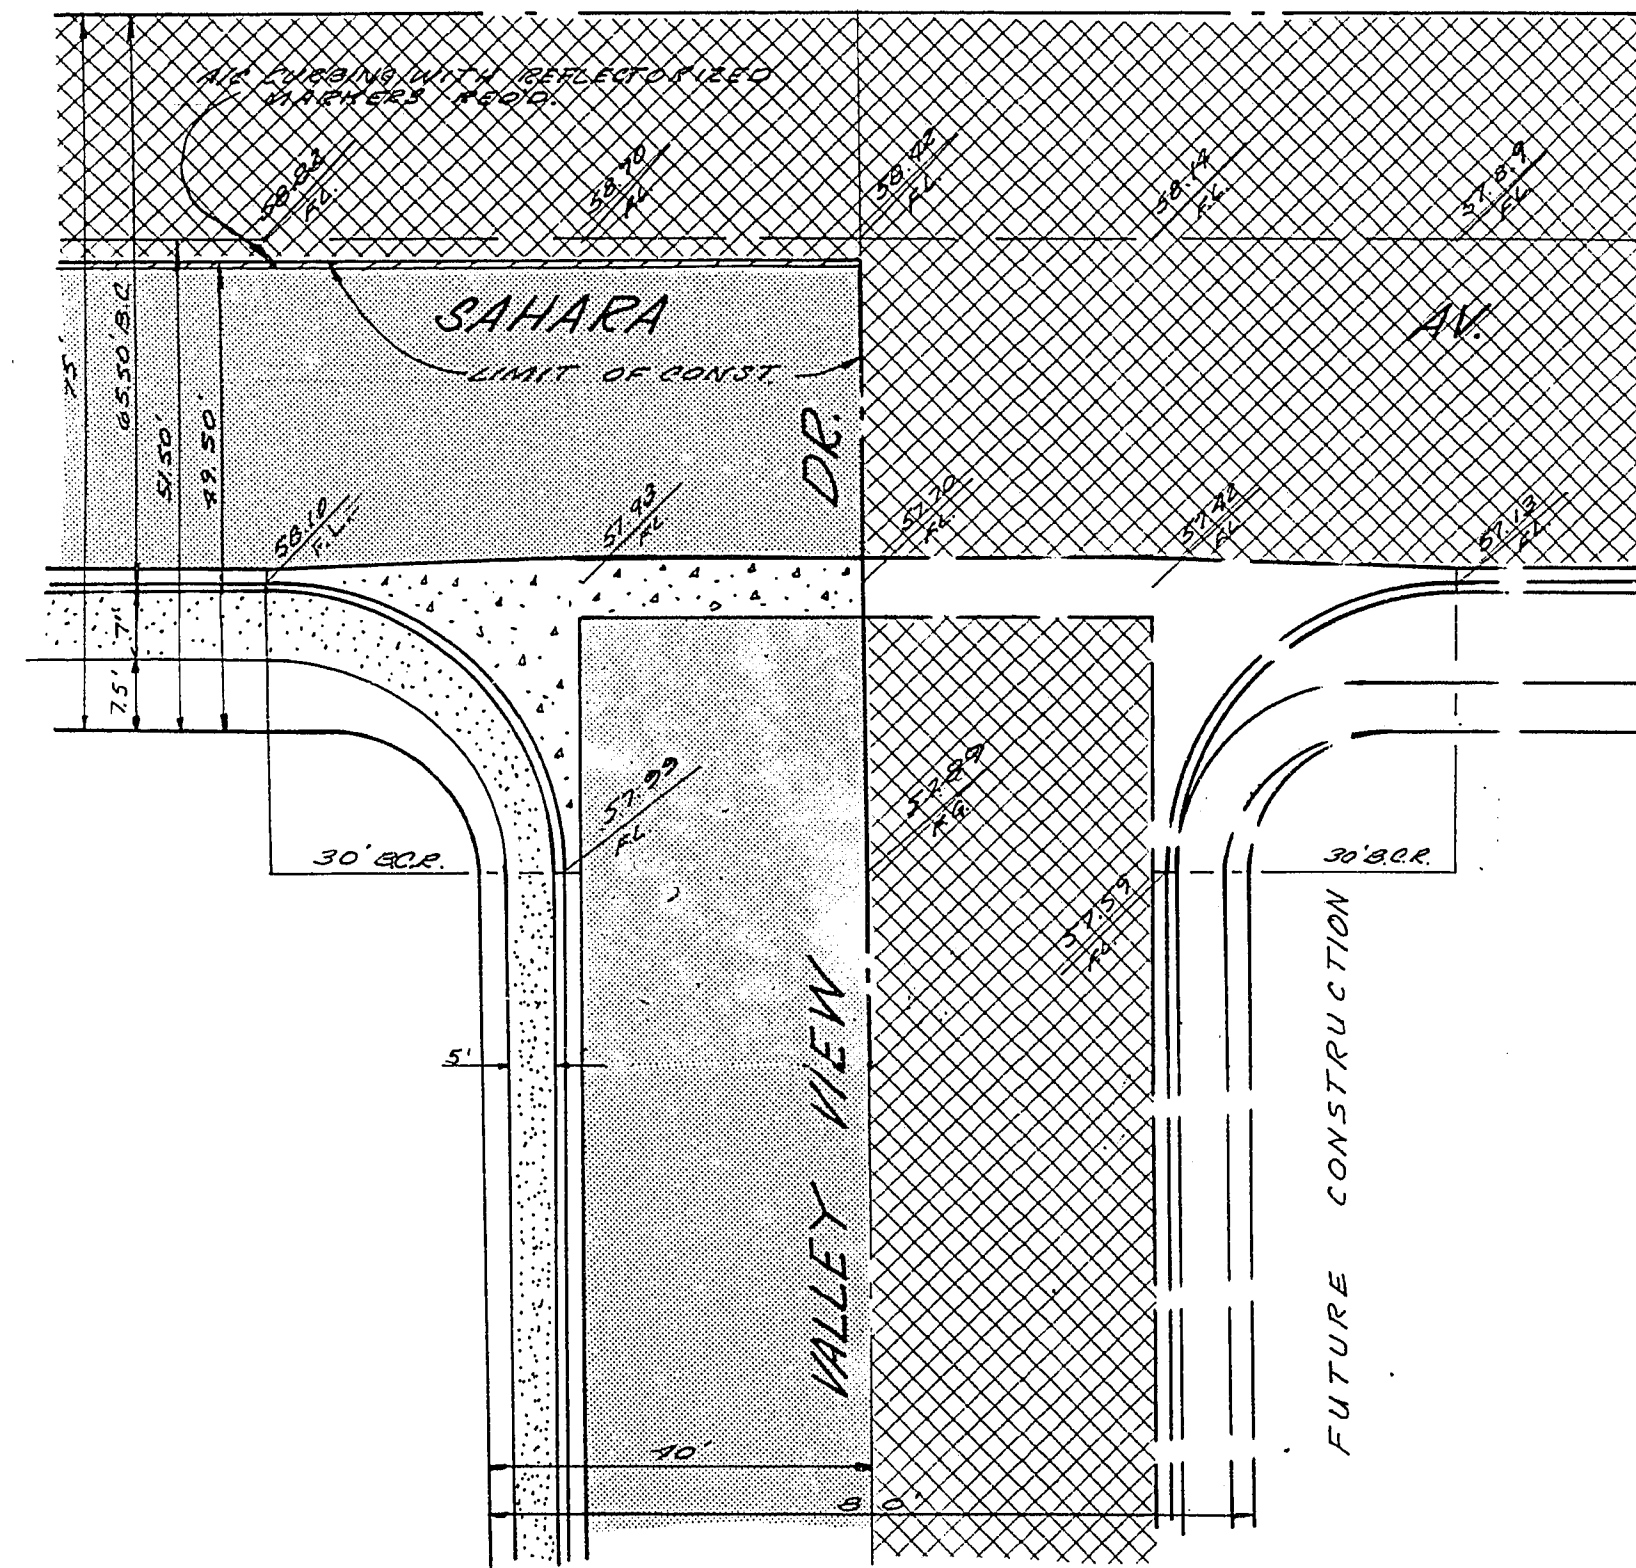
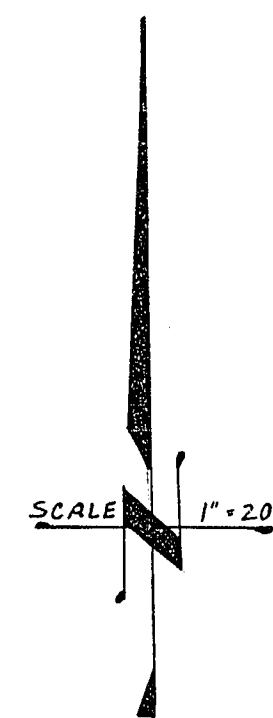
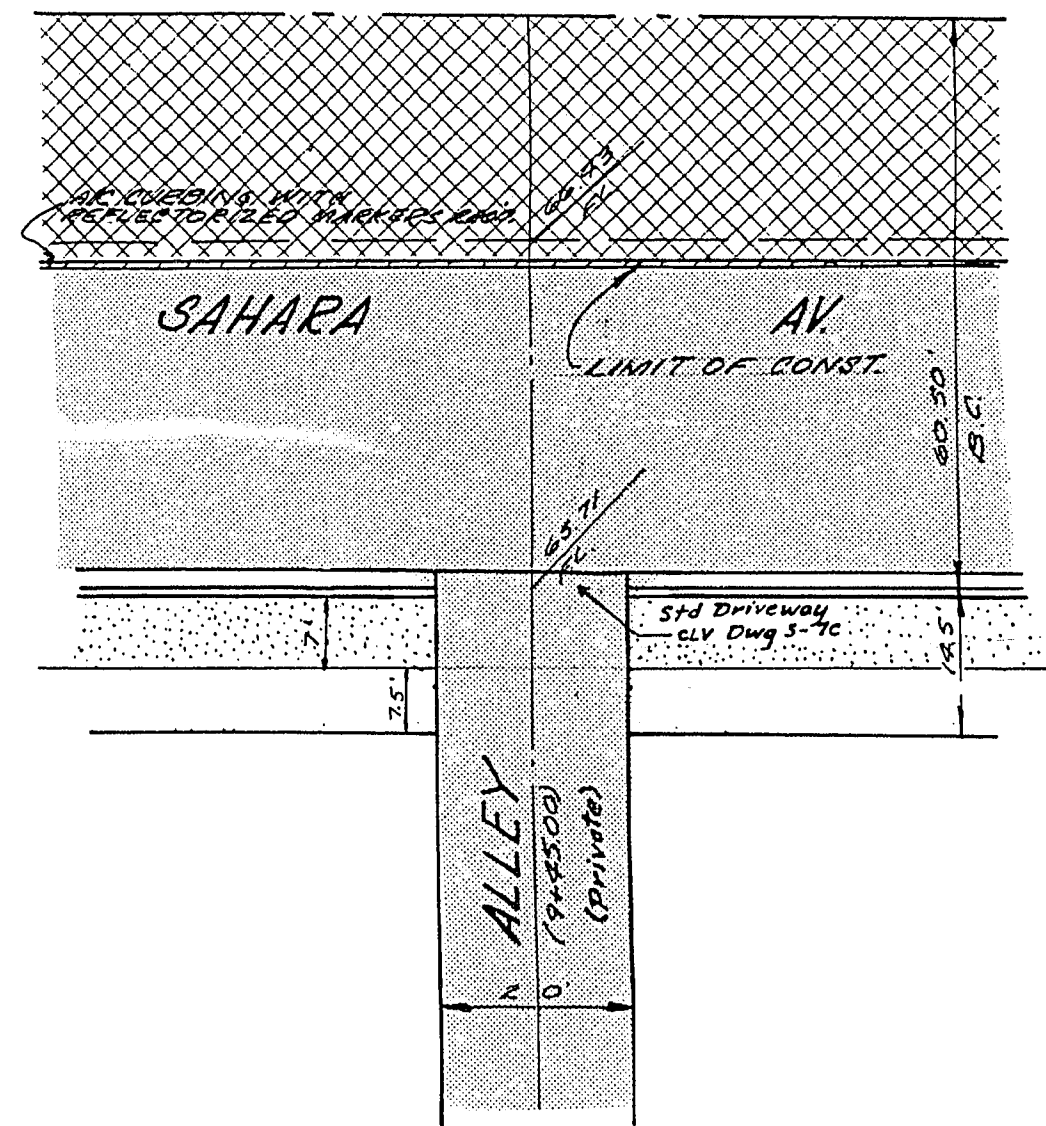
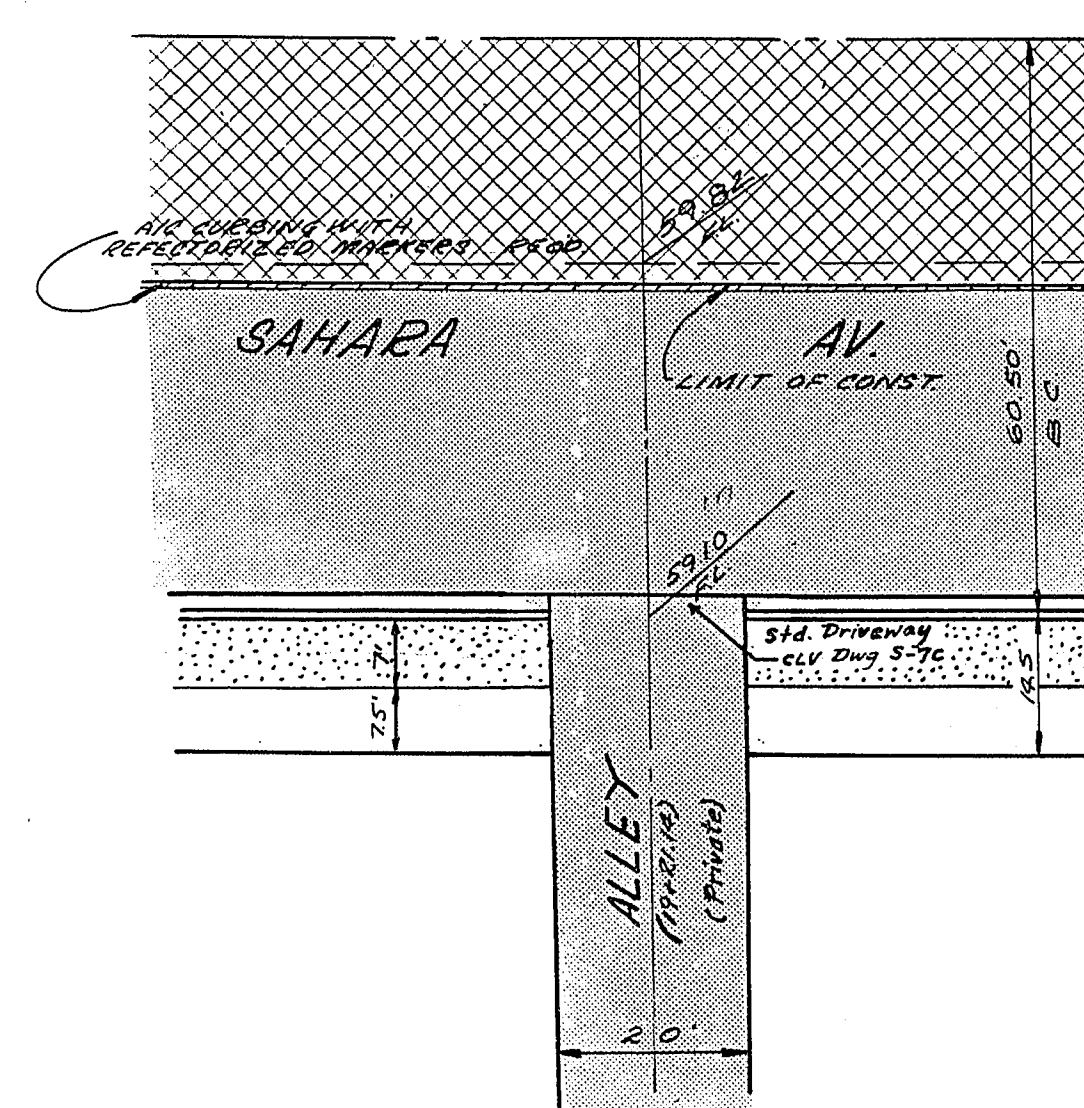


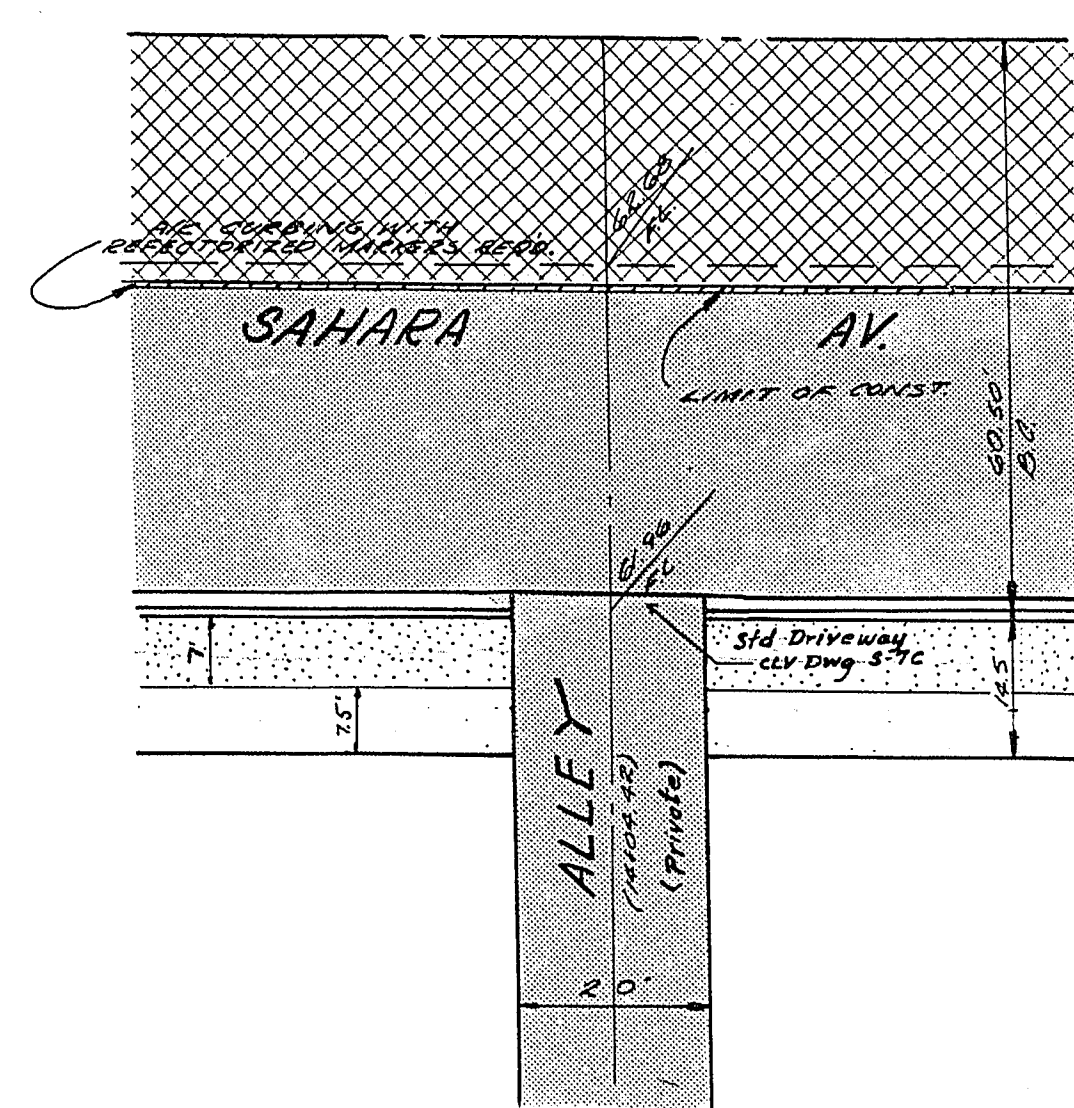

NOTE:
Make necessary transition
to existing grades.

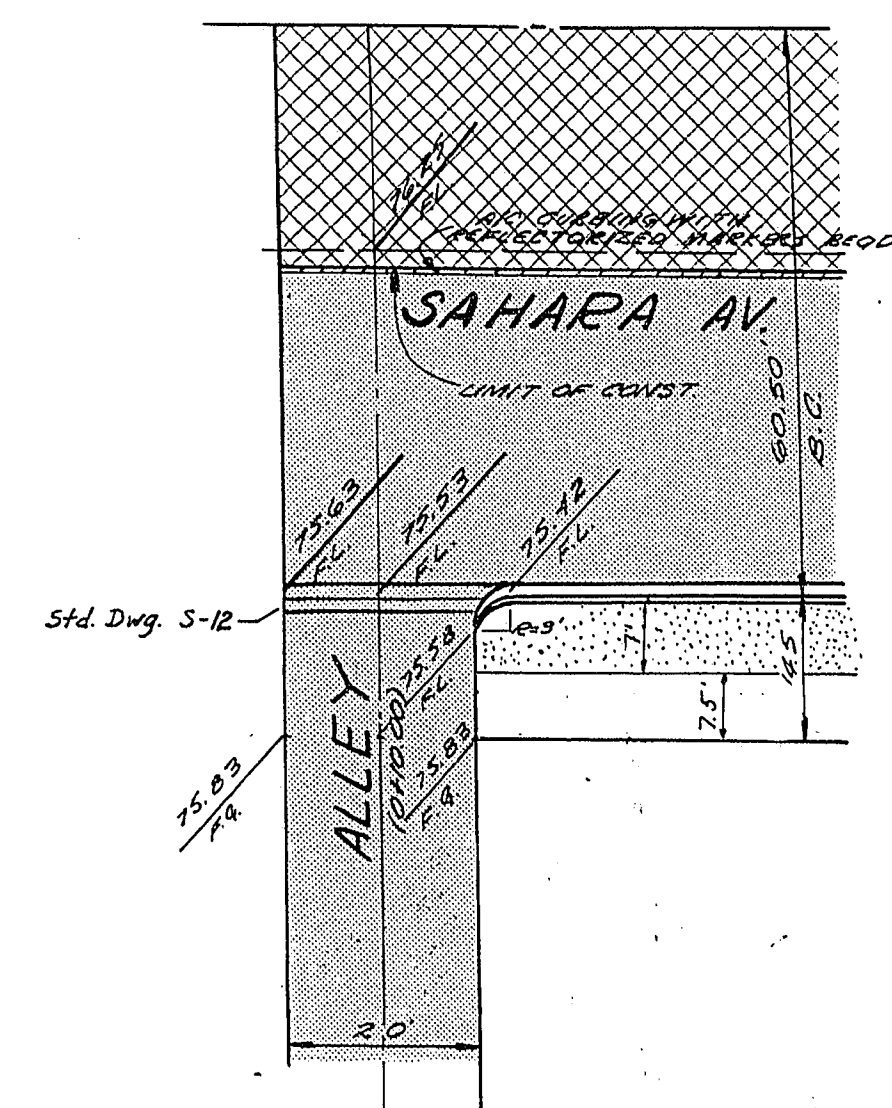

City Engineer
Date
Field Engineer
Date

D					
C					
B					
A	3-19-65	Replace 5' x 5' w with 7' x 7'			
REV.	DATE	DESCRIPTION	BY	APPR.	
SAHARA AV. IMPROVEMENT FROM WEST END LAS VERDES HTS. 6 UNIT 4 TO EAST END LAS VERDES HTS. 6 UNITS INTERSECTION DETAILS					
DESIGNED	TROJAN ENGINEERING, INC.				
DRAWN	LAS VEGAS, NEVADA				
CHECKED	APPROVED DATE 12-23-65				
					SHEET 2 OF 3

64-8

107 V-617