5-2-84

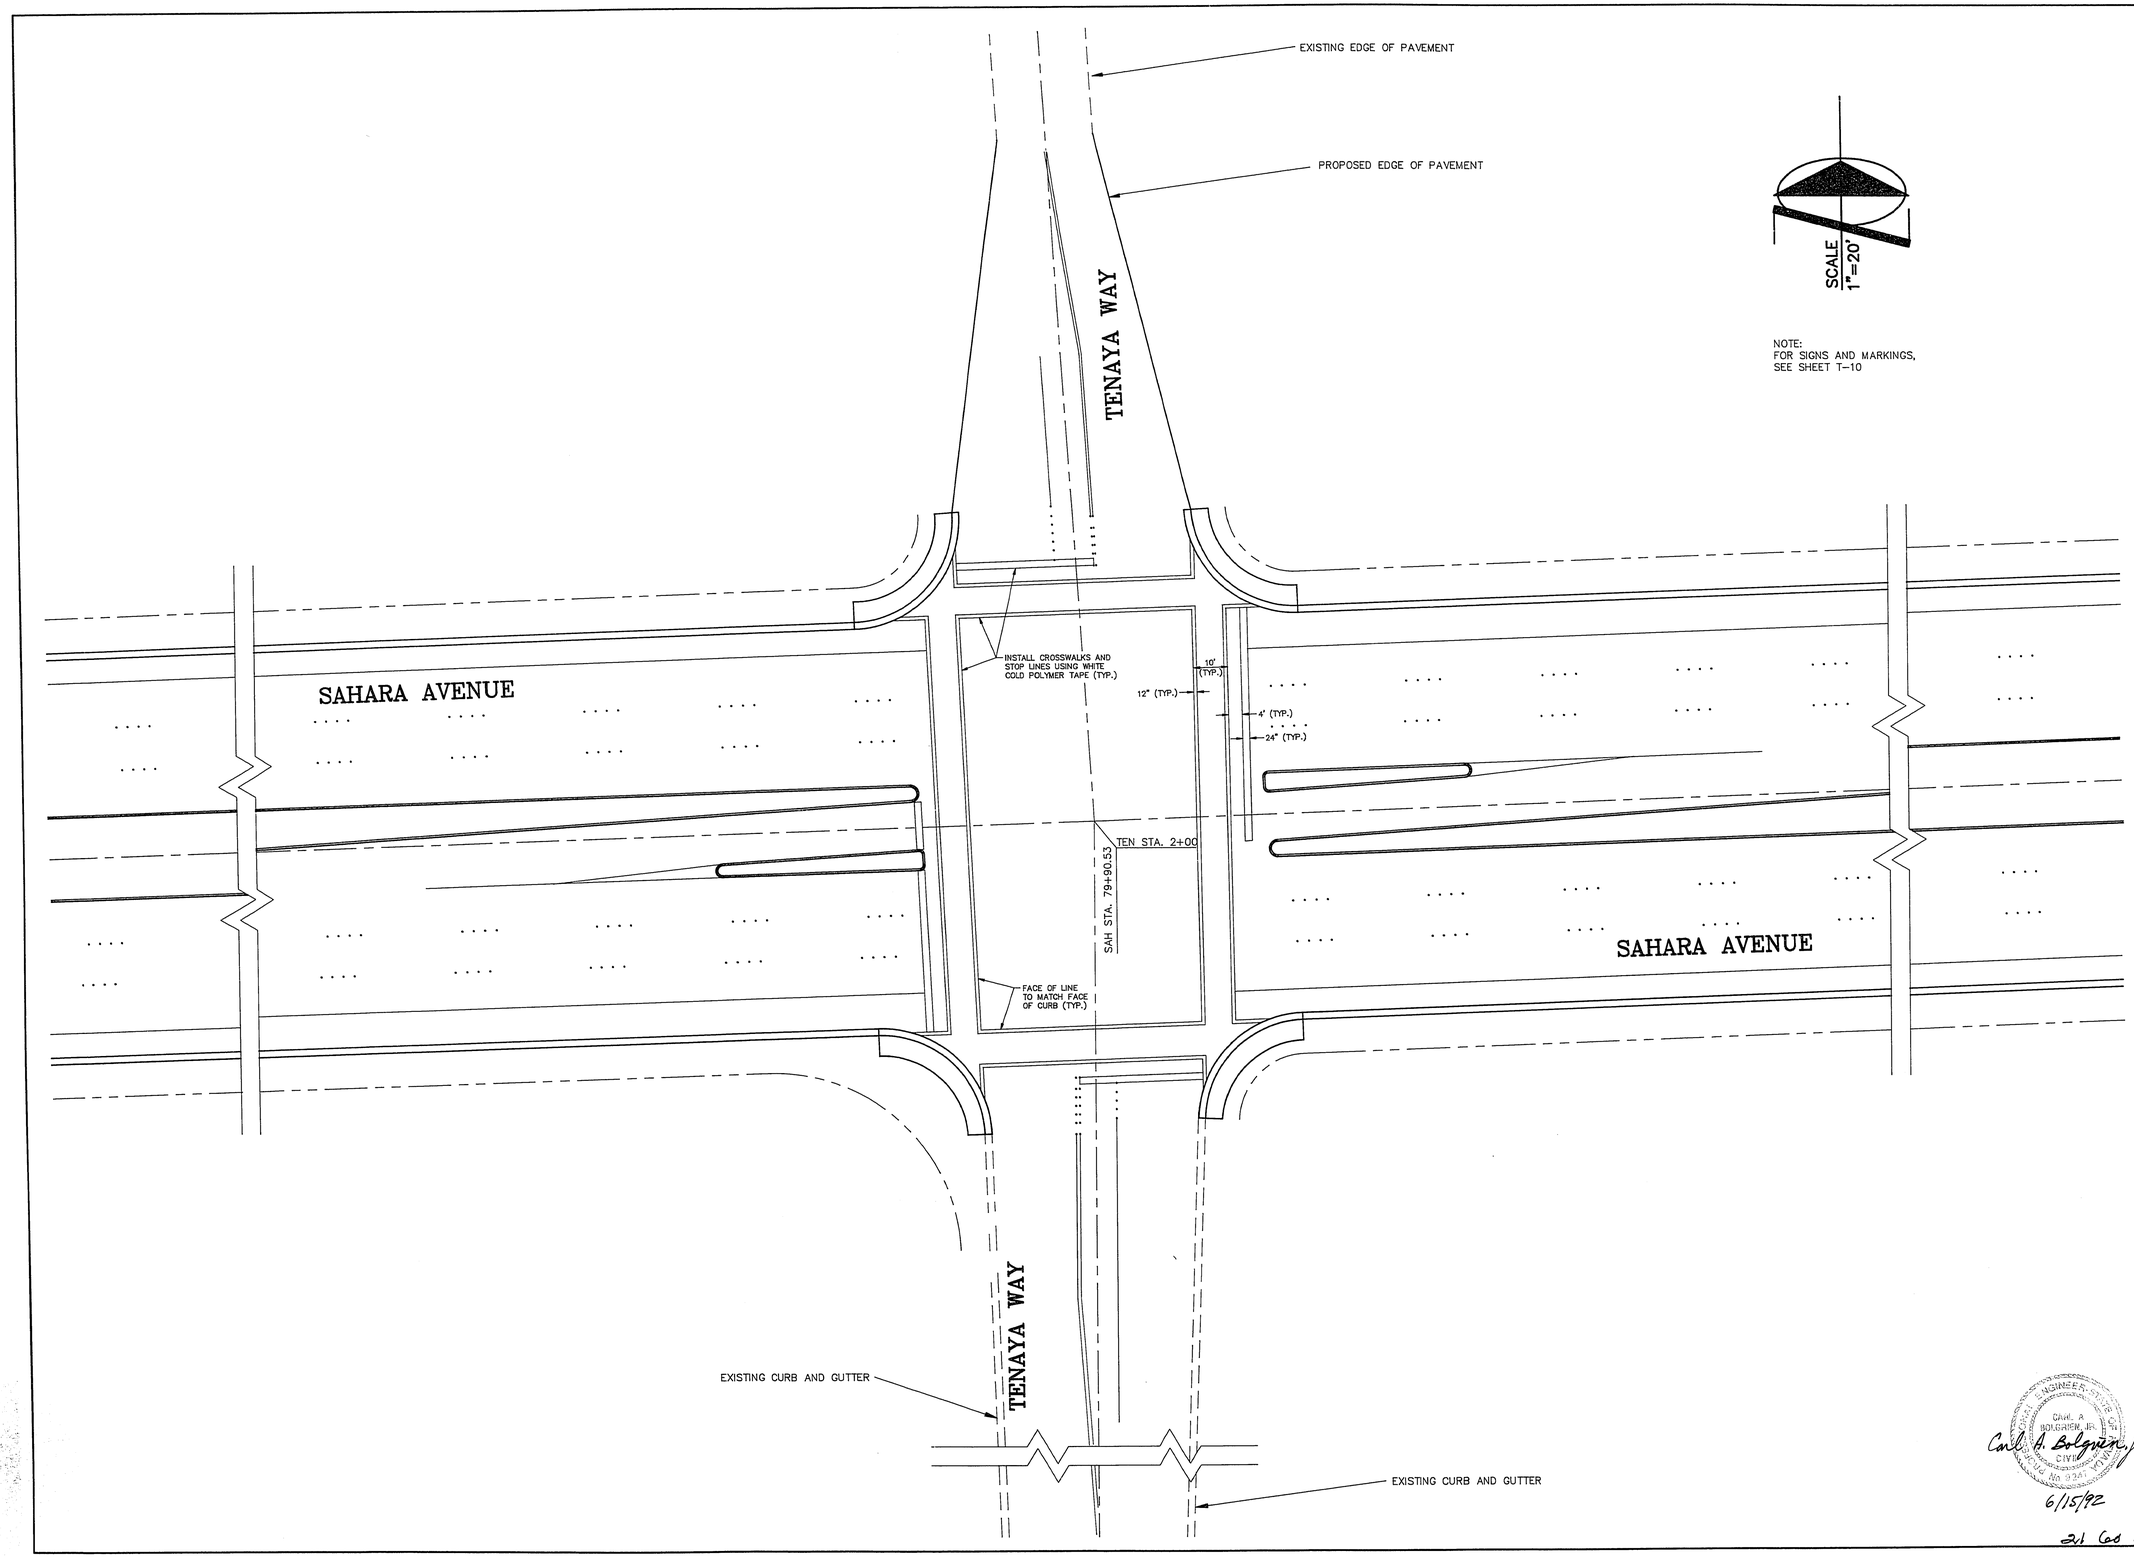


| APPRVL | REV | DATE | BY | REVISION |
|---|---|---|---|---|
| | | | | |

ESI ENGINEERS & SURVEYORS, INC.
7018 W. PRESTON BLVD.
LAS VEGAS, NEVADA 89117
(702) 363-7500
FOREST E. GREEN
CIVIL
STATE OF NEVADA
REGISTERED PROFESSIONAL ENGINEER
No. 9341
6/25/92

SUBMITTED BY:

TITLE: CROSSWALKS AND STOP LINES SAHARA AVENUE AT TENAYA WAY

PROJECT: SAHARA AVENUE

| | |
|---|---|
| W.O. # | L1S117 |
| BY: | J.D.T./J.S.T. |
| DATE: | 06/15/92 |
| SCALE: | 1" = 20' |

CARL A. BOLGUREN, JR.
CIVIL
No. 9341
STATE OF NEVADA
Carl A. Bolguren, Jr.
6/15/92

C.L.V. DRAWING NO. 107-V-2036

T-7 39/43

21 Cad 3

"As Built" 107-V2036