

2250

TOP OF MANHOLE
ELEVATIONS


2240

2230

2220

2210

2200

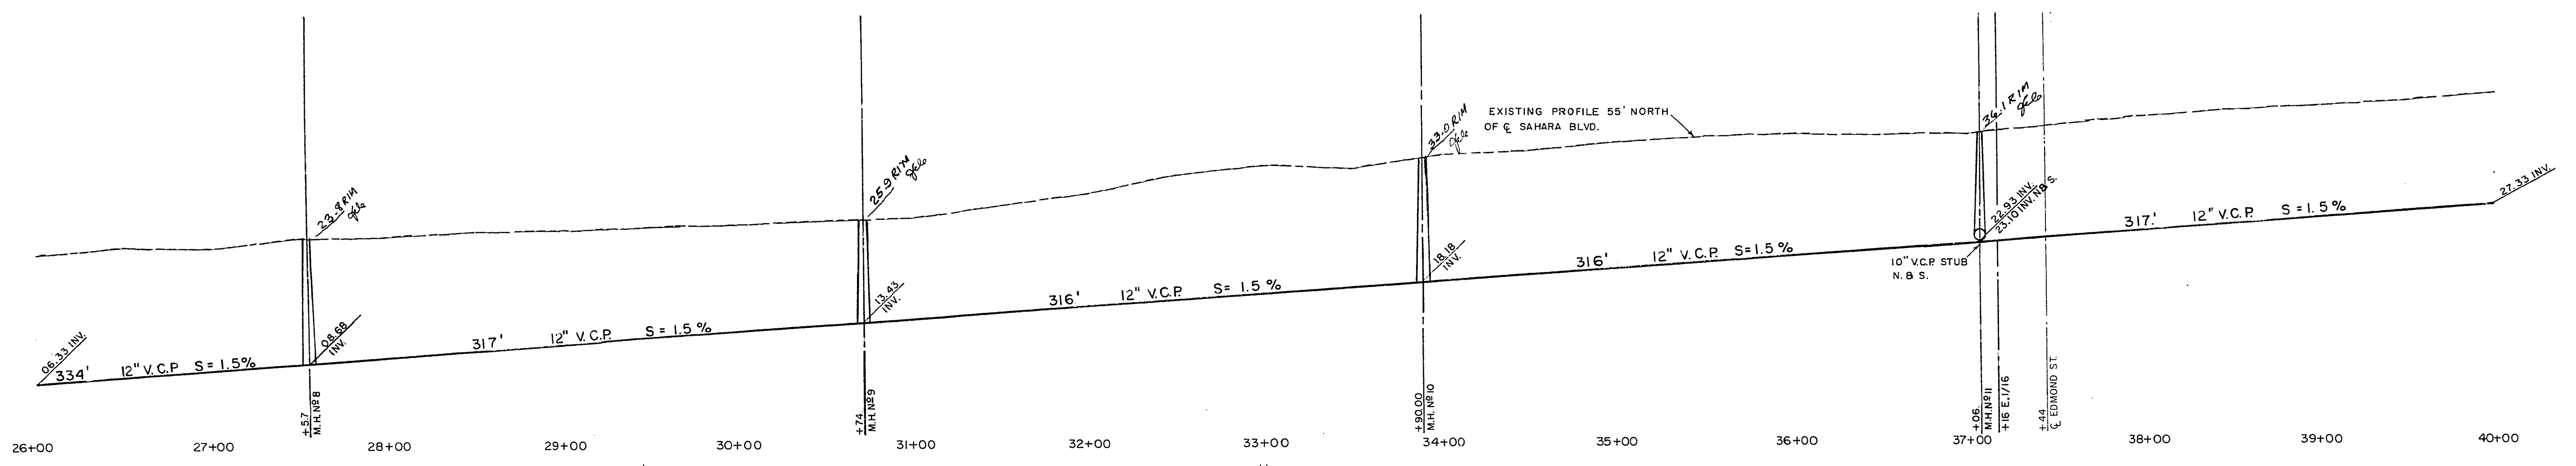

2250


2240

2230

2220

2210

2200

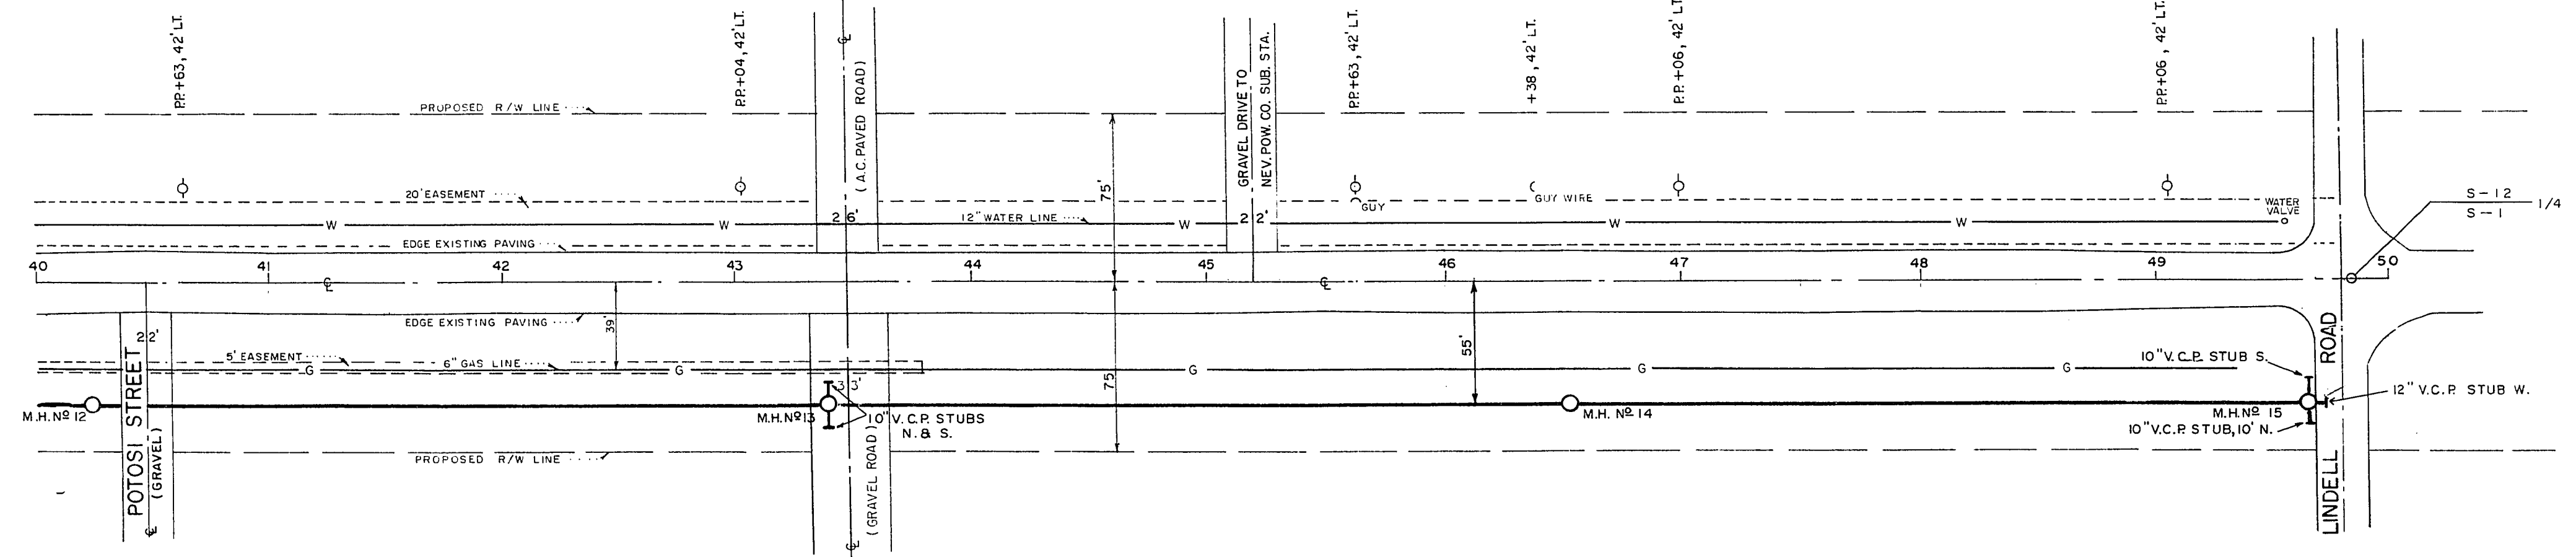

- NOTES
- 1. INSTALL 6" WYE TO THE NORTH AT EVERY 100' STA. BETWEEN STA. 13+25 AND STA. 49+63 (SEE SEWER LATERAL CONNECTION DETAIL ON SHEET 5)
 - 2. 10" STUBS TO THE NORTH SHALL BE 10' LONG. 10" STUBS TO THE SOUTH SHALL BE 5' LONG.

PLAN & PROFILE
SCALE: HOR. 1" = 50'
VERT. 1" = 10'

2270

TOP OF MANHOLE
ELEVATIONS


2260

2250

2240

2230

2220

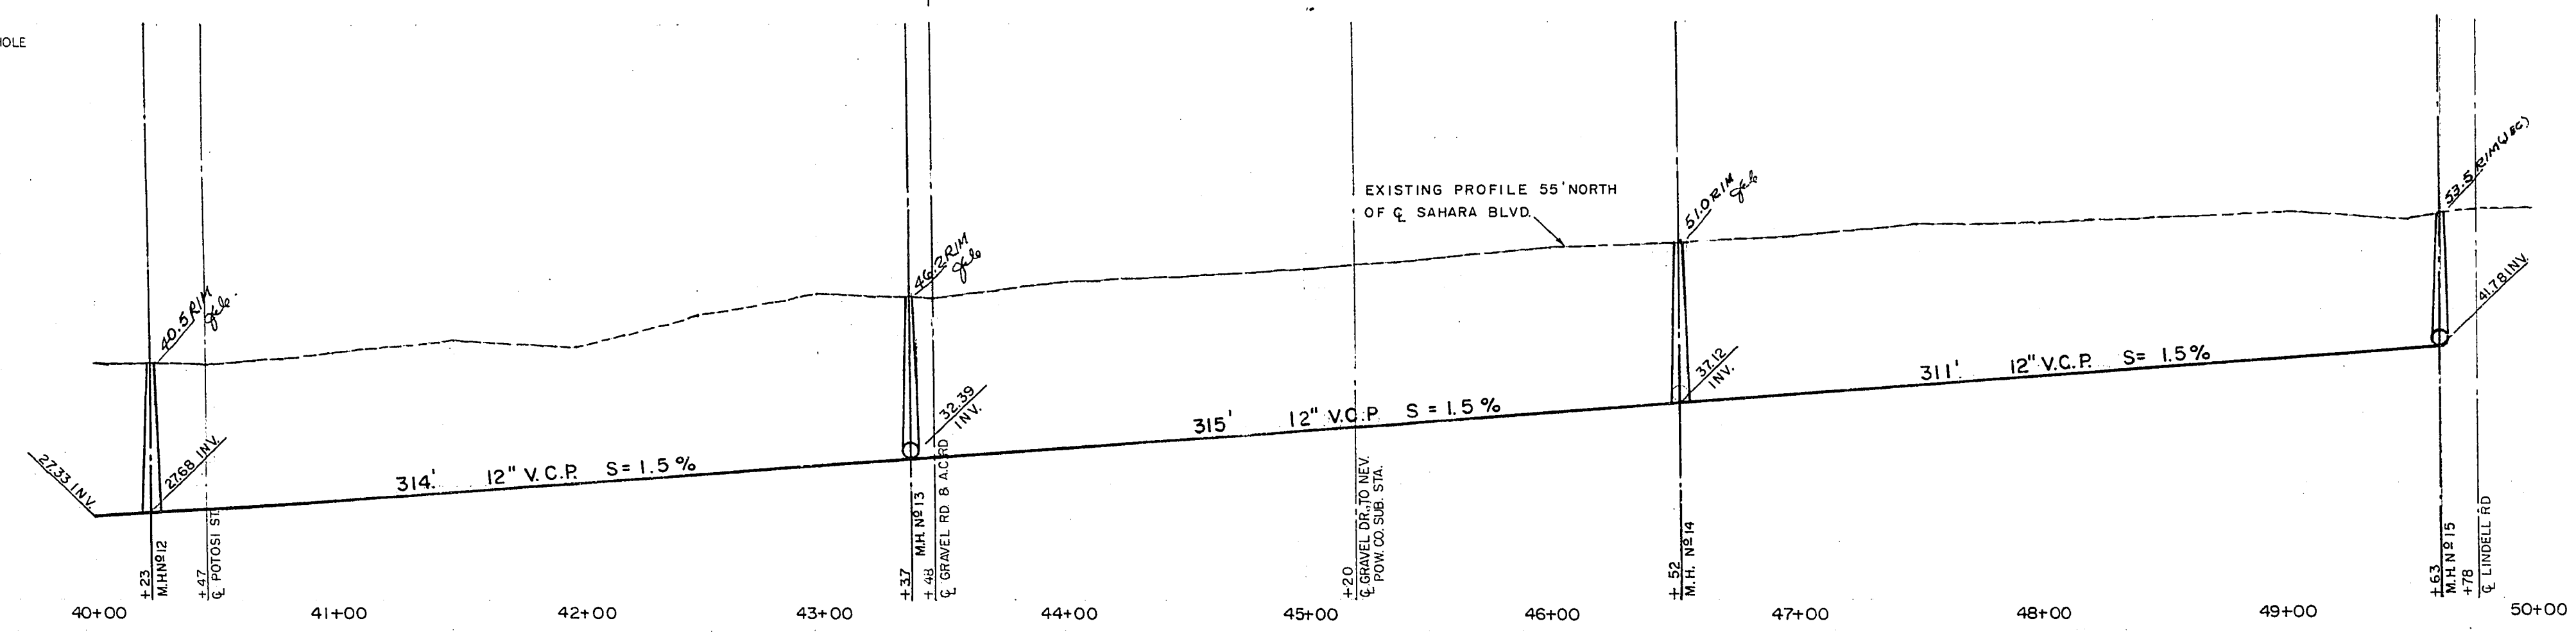

2270

2260

2250

2240

2230

2220

SAHARA AVENUE
INTERCEPTOR SEWER EXTENSION
DATE 1/24/64
DRAWN BY Mike Prince
CHKD. & APPR. Supt. San. Eng. 1/24/64
APPROVED BY [Signature] 1/24/64

SAHARA AVENUE INTERCEPTOR SEWER EXTENSION		DATE	PREPARED BY
CONSULTING ENGINEER	B. G. Vasey	1/24/64	TYS ON
DRAWN BY	Mike Prince	1/24/64	ENGINEERING
CHKD. & APPR. Supt. San. Eng.	[Signature]	1/24/64	COMPANY INC.
APPROVED BY	[Signature]		LAS VEGAS, NEVADA

SHEET 3 OF 5

17-1001-307-V 348