
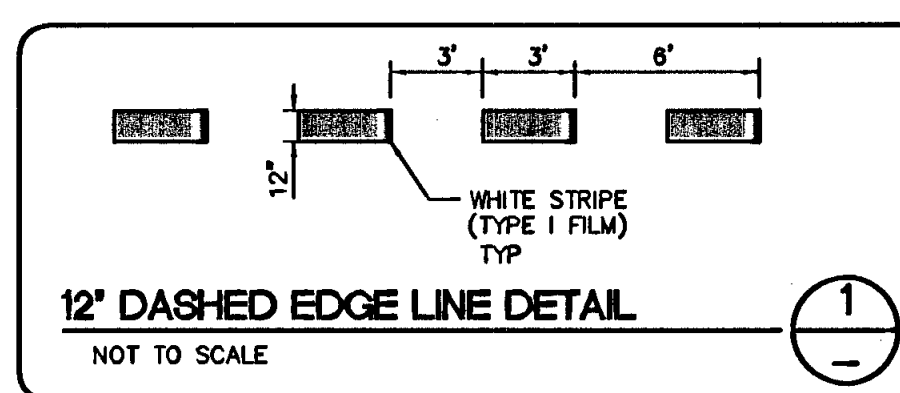
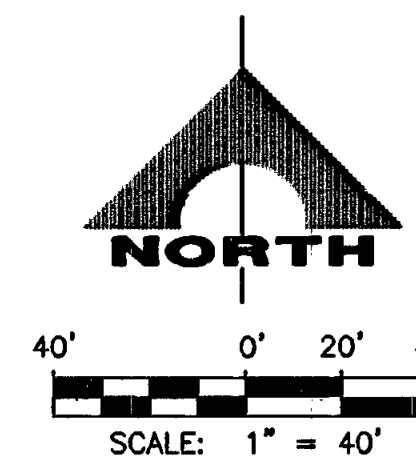


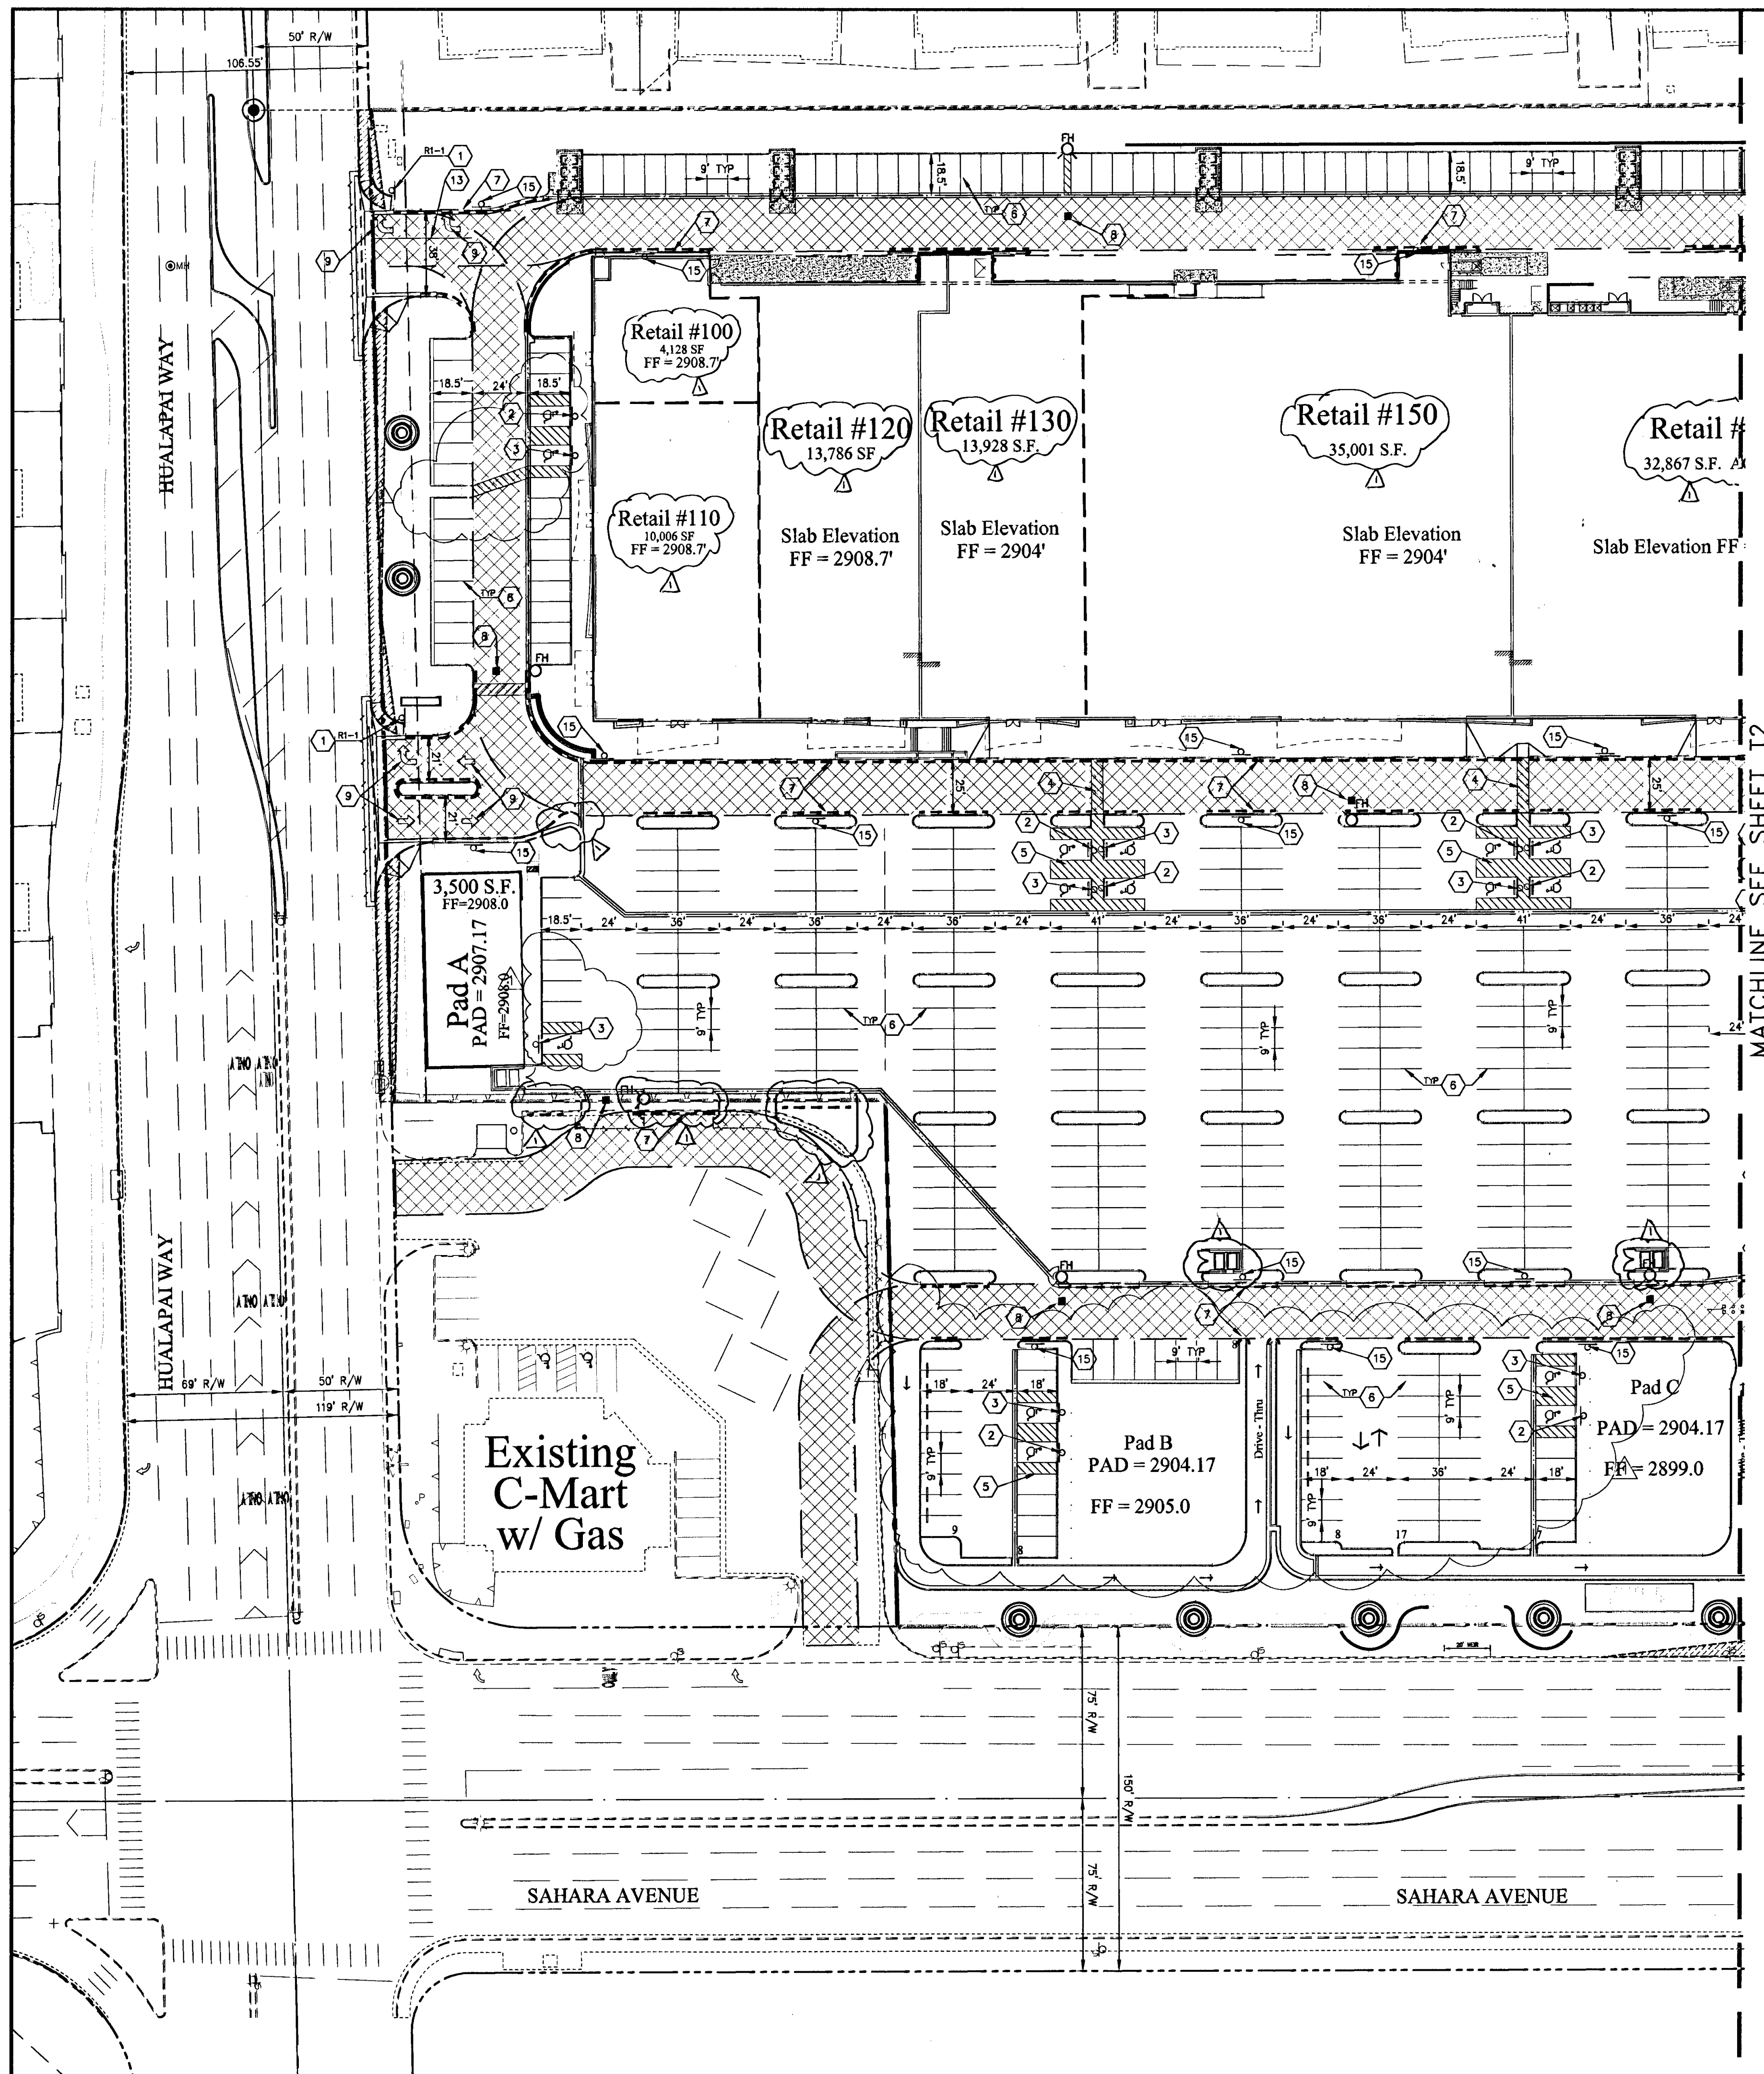

- CONSTRUCTION NOTES:
- INSTALL SIGN AS NOTED.
 - INSTALL R7-8 (12"x12") AND "VAN ACCESSIBLE" SIGN.
 - INSTALL R7-8 (12"x18") "HANDICAP ACCESSIBLE" SIGN.
 - CONTRACTOR TO STRIPE 5' WIDE PATH FOR HANDICAP ACCESS.
 - CONTRACTOR TO STRIPE ACCESSIBLE STALLS.
 - INSTALL WHITE PAINTED PARKING STALL (TYP.).
 - PAINT CURB RED AND STENCIL "NO PARKING - FIRE LANE" AT 50' O.C. (TYP.) PER FIRE CODE.
 - INSTALL A BLUE REFLECTIVE MARKER AT CENTERLINE OF ROAD ADJACENT TO HYDRANT.
 - INSTALL PAVEMENT LEGEND AS INDICATED USING TYPE I FILM.
 - INSTALL 8" YELLOW LINE AND DIAGONALS @ 15' O.C. TYPE I FILM.
 - INSTALL TYPE I CENTERLINE, USD DWG #241 (RPM).
 - INSTALL TYPE 4 LANE LANE, USD DWG #241.1 (RPM).
 - INSTALL 8-INCH WHITE STORAGE LANE LINE, USD DWG #248 (TYPE I FILM).
 - INSTALL 12-INCH WHITE DASHED EDGE LINE (SEE DETAIL).
 - INSTALL "NO PARKING - FIRE LANE" SIGN PER DETAIL 2 ON SHEET T1.

Call before you Dig
1-800-227-2800
CLARK COUNTY TRAFFIC OPERATIONS
1-702-455-7544

CALL BEFORE YOU DO OVERHEAD
1-702-227-2929

FAST
Call before you Under Ground.
1-702-432-5300

FIRE LANE SIGNAGE

MINIMUM SPECIFICATIONS OF "NO PARKING FIRE LANE SIGNS"

SIZE: 1' WIDE X 1 1/2' LONG OR 2' WIDE X 2 1/2' LONG AS REQUIRED

COLOR: RED AND BLACK ON WHITE LUMINOUS BACKGROUND (SEE ABOVE EXAMPLE)

SYMBOL: INTERNATIONAL NO PARKING SYMBOL

HEIGHT: TO BE INSTALLED NOT LESS THAN SEVEN (7) FEET NOR MORE THAN TEN (10) FEET FROM GROUND

R1-1 30"x30"
R1-2 36"x36"x36"
R6-5P 30"x30"

FIRE DEPARTMENT ACCESS

TURNING RADIUS OF FIRE APPARATUS ACCESS ROAD AS SHOWN SHALL BE NO LESS THAN 52 FT OUTSIDE AND 28 FT INSIDE, AND SHALL HAVE A MINIMUM UNOBSTRUCTED WIDTH OF NOT LESS THAN 24 FT (FLOW LINE TO FLOW LINE).

APPROVED FOR CONSTRUCTION

Scott Jensen
CITY OF LAS VEGAS FIRE DEPARTMENT

DATE: 1/21/14

PROJECT NO. 840-044

DESIGN: HN
DRAWN: HN
CHECK: MAF
PLOT DATE: 01-21-14
PLOT TIME: 09:25:29

G.C. WALLACE COMPANIES
ENGINEERS | PLANNERS | SURVEYORS
155 S. RAINBOW BOULEVARD - LAS VEGAS, NV 89146
T: 702.894.2000 F: 702.894.2299 GCWALLACE.COM

LAS VEGAS

F: Projects\840\840-044\DWG\Production\840-044-T1.dwg
Matthew Burge

SAHARA CENTER LLC

SAHARA CENTER

TRAFFIC AND STRIPING PLAN I

DRAWING T1

23 OF 29 SHITS