
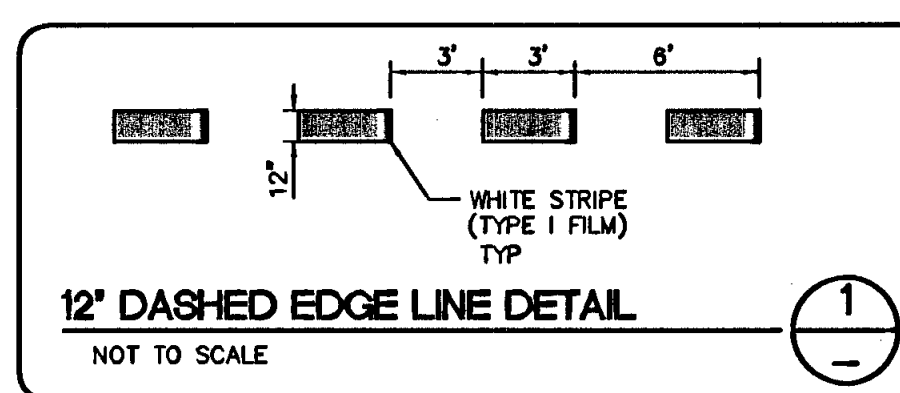
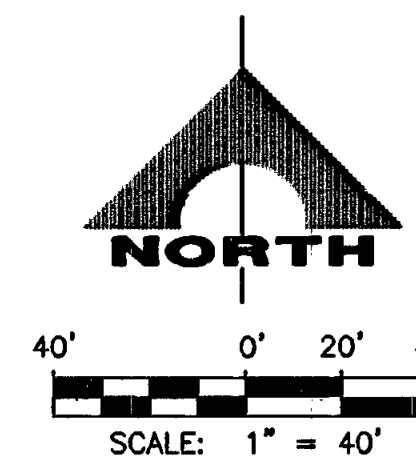


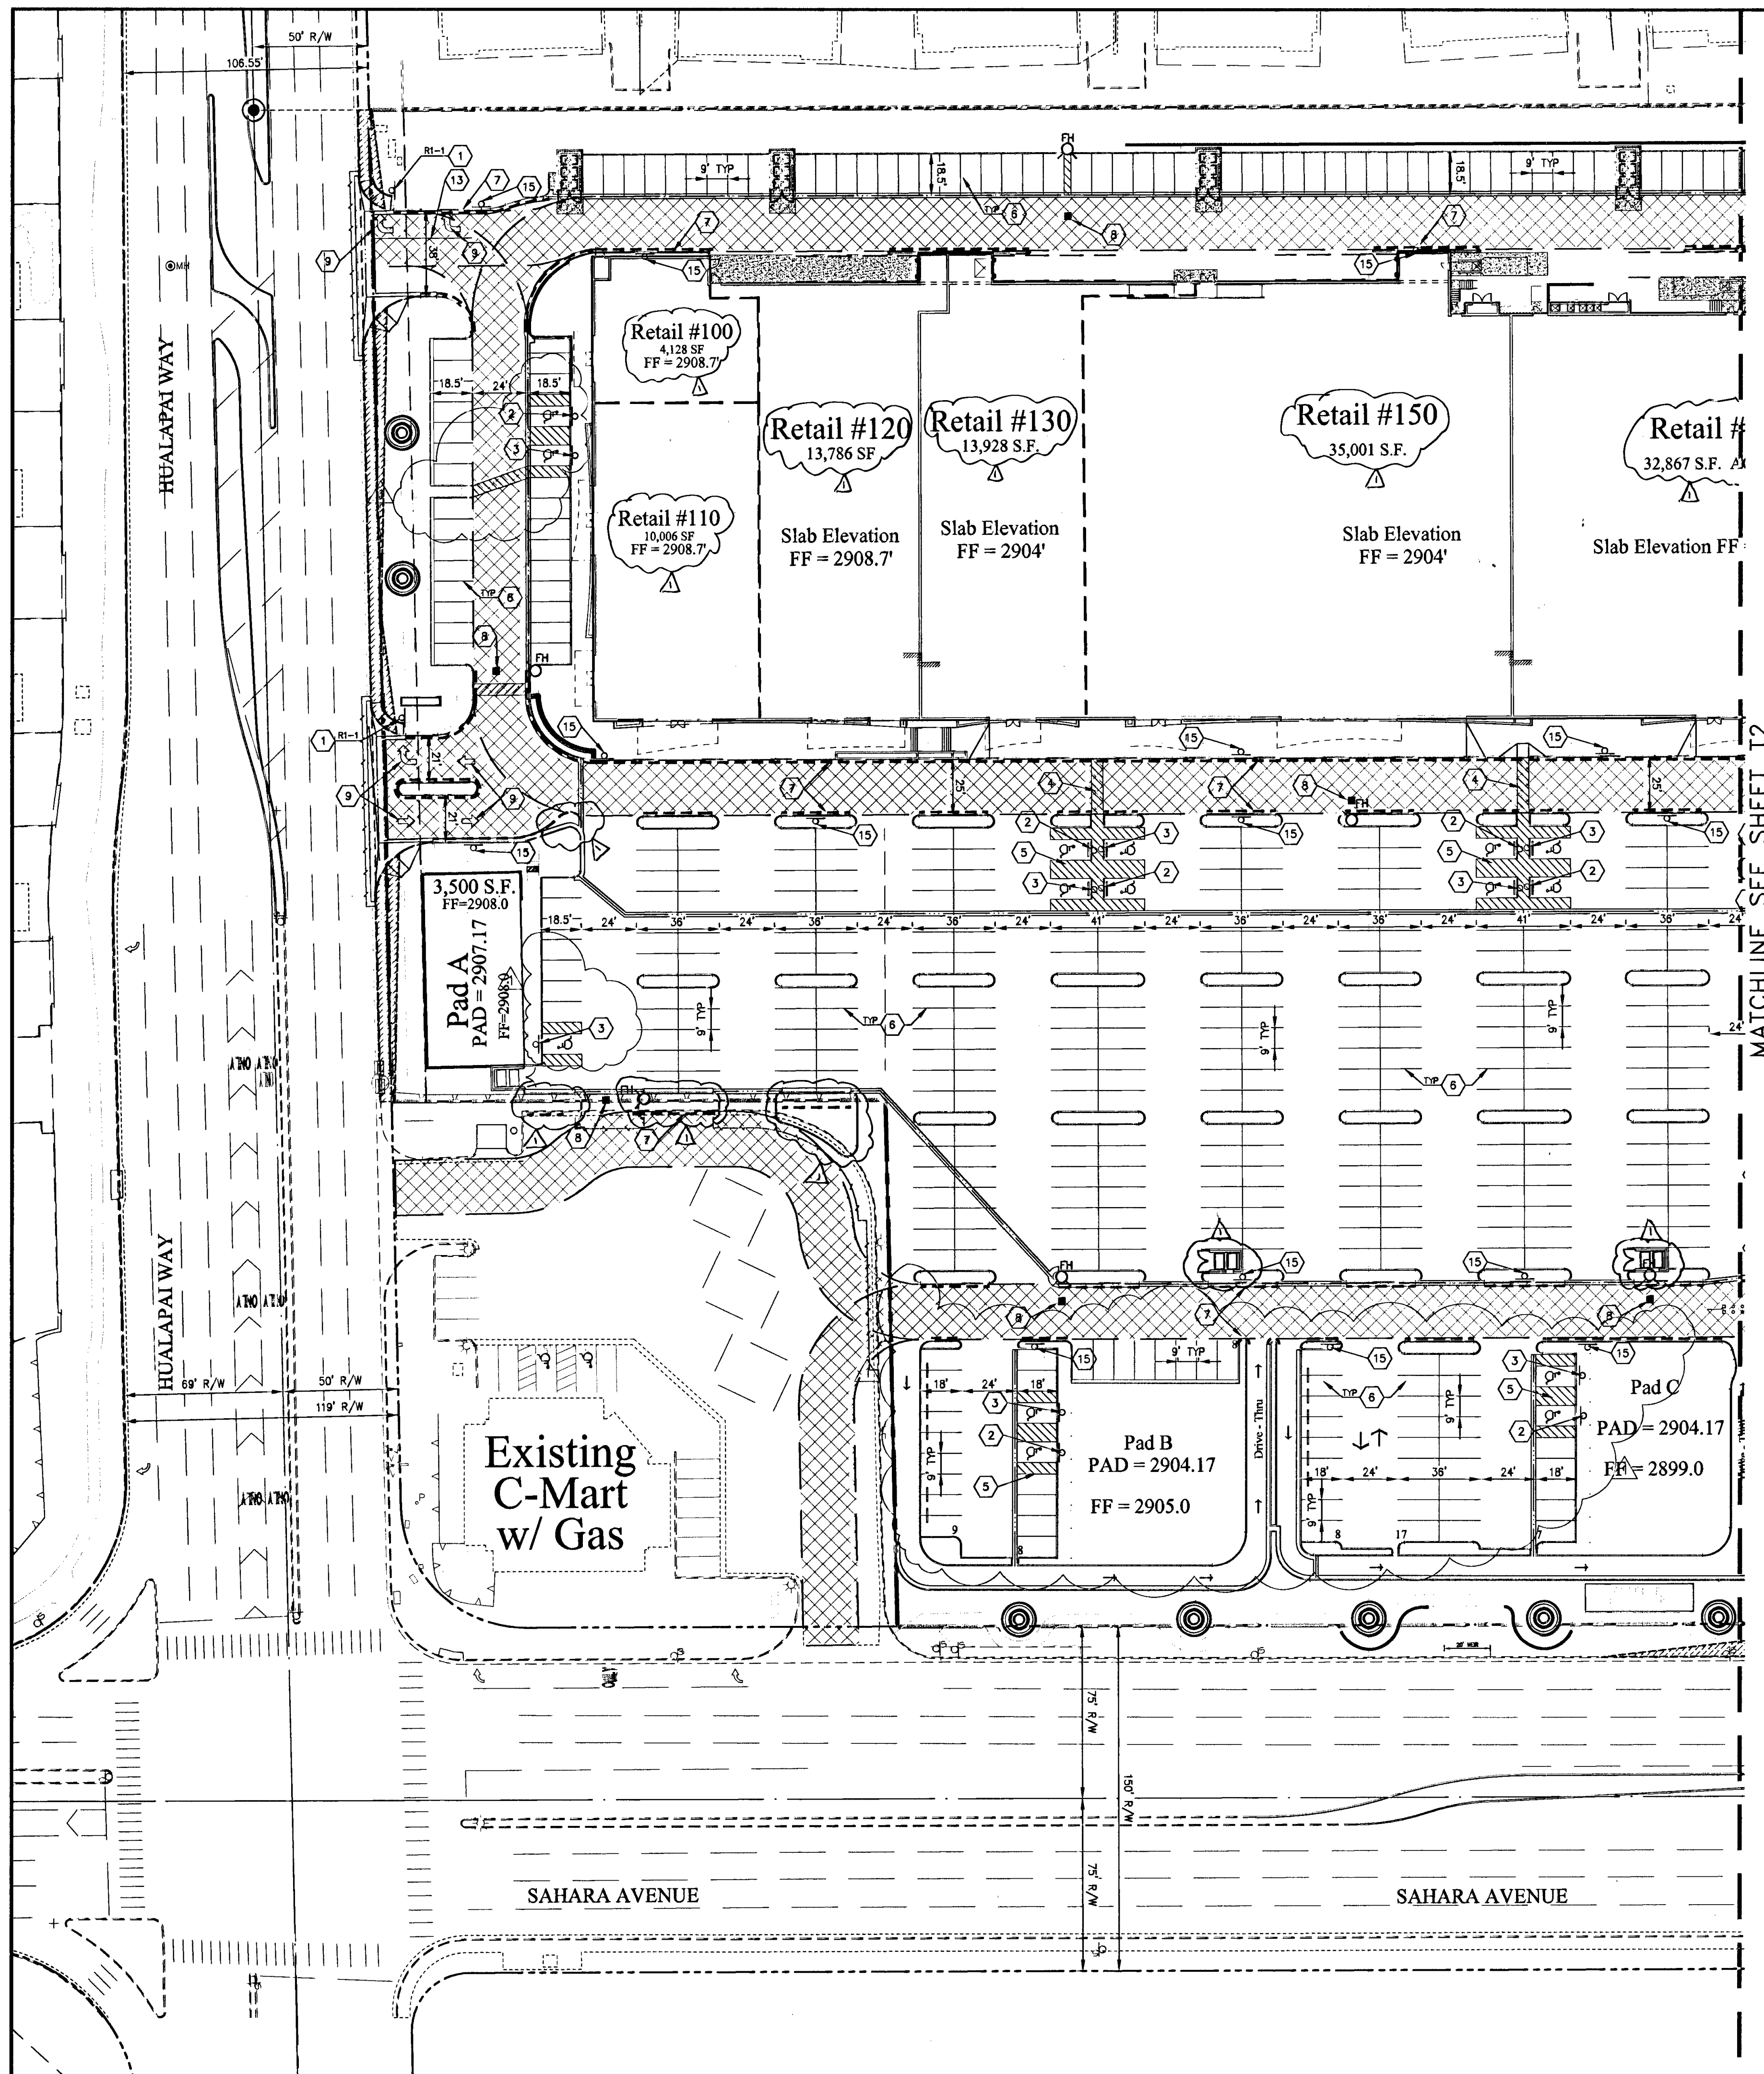

- CONSTRUCTION NOTES:**
1. INSTALL SIGN AS NOTED.
 2. INSTALL R7-8 (12"x12") AND "VAN ACCESSIBLE" SIGN.
 3. INSTALL R7-8 (12"x18") "HANDICAP ACCESSIBLE" SIGN.
 4. CONTRACTOR TO STRIPE 5' WIDE PATH FOR HANDICAP ACCESS.
 5. CONTRACTOR TO STRIPE ACCESSIBLE STALLS.
 6. INSTALL WHITE PAINTED PARKING STALL (TYP.).
 7. PAINT CURB RED AND STENCIL "NO PARKING - FIRE LANE" AT 50' O.C. (TYP.) PER FIRE CODE.
 8. INSTALL A BLUE REFLECTIVE MARKER AT CENTERLINE OF ROAD ADJACENT TO HYDRANT.
 9. INSTALL PAVEMENT LEGEND AS INDICATED USING TYPE I FILM.
 10. INSTALL 8" YELLOW LINE AND DIAGONALS @ 15' O.C. TYPE I FILM.
 11. INSTALL TYPE I CENTERLINE, USD DWG #241 (RPM).
 12. INSTALL TYPE 4 LANE LANE, USD DWG #241.1 (RPM).
 13. INSTALL 8-INCH WHITE STORAGE LANE LINE, USD DWG #248 (TYPE I FILM).
 14. INSTALL 12-INCH WHITE DASHED EDGE LINE (SEE DETAIL).
 15. INSTALL "NO PARKING - FIRE LANE" SIGN PER DETAIL 2 ON SHEET T1.

Call before you Dig

Call 811

1-800-227-2800

AND

CLARK COUNTY TRAFFIC OPERATIONS

1-702-455-7544

CALL BEFORE YOU DO OVERHEAD

1-702-227-2929

FAST

Call before you Under Ground.

1-702-432-5300


FIRE LANE SIGNAGE

MINIMUM SPECIFICATIONS OF "NO PARKING FIRE LANE SIGNS"

SIZE: 1' WIDE X 1 1/2' LONG OR 2' WIDE X 2 1/2' LONG AS REQUIRED

COLOR: RED AND BLACK ON WHITE LUMINOUS BACKGROUND (SEE ABOVE EXAMPLE)


SYMBOL: INTERNATIONAL NO PARKING SYMBOL

HEIGHT: TO BE INSTALLED NOT LESS THAN SEVEN (7) FEET NOR MORE THAN TEN (10) FEET FROM GROUND

R1-1
30"x30"

R1-2
36"x36"x36"

R6-5P
30"x30"

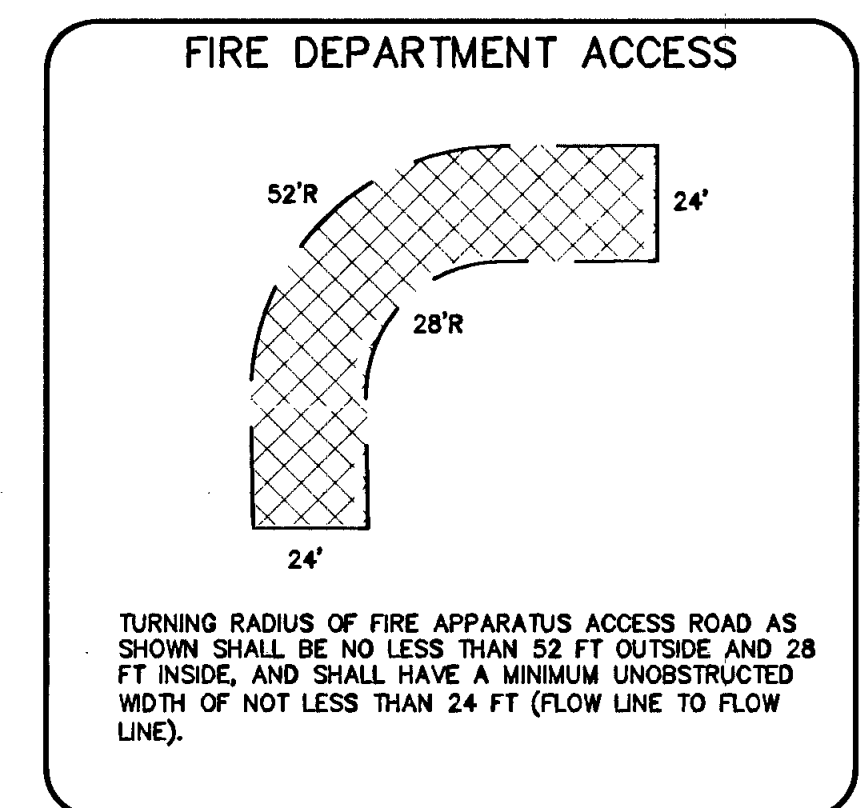

APPROVED FOR CONSTRUCTION

Dec Jernin 1/21/14
CITY OF LAS VEGAS FIRE DEPARTMENT DATE

SAHARA CENTER LLC

SAHARA CENTER

TRAFFIC AND STRIPING PLAN I

G.C. WALLACE COMPANIES
ENGINEERS | PLANNERS | SURVEYORS
1555 S. RAINBOW BOULEVARD - LAS VEGAS, NV 89146
P: 702.894.2000 F: 702.894.2299 GCWALLACE.COM

PROJECT NO. 840-044

DESIGN: HN
DRAWN: HN
CHECK: MAF
PLOT DATE: 01-21-14
PLOT TIME: 09:25:29

REVISIONS:

NO.	DATE	DESCRIPTION
1	10/17/13	REVISIONS - REVISED PAD B & C LAYOUT, ADD TRASH ENCLOSURES, PAVEMENT LEGEND, ADD 8" YELLOW LINE AND DIAGONALS, HANDICAP ACCESS, VAN & PARKING STALLS

DATE: 1/21/14

H# 50009

CLV DRAWING NO. 107V6070

DRAWING

T1

23 OF 29 SHTS