


CURVE	RADIUS	LENGTH	TANGENT	DELTA
C1	3.00	2.85	900.000	90.000
C2	1.75	5.49	1331.01	1795.50
C3	15.00	18.26	10.45	69.9442
C4	2.00	3.85	2.87	1071.95
C5	2.00	3.85	2.87	11015.46
C6	15.00	18.26	10.45	69.9444
C7	1.75	5.49	1273.98	17950.33
C8	12.00	16.66	15.43	85.58
C9	3.00	4.71	3.00	89.5858
C10	3.00	4.71	3.00	90.0000
C11	2.75	8.66	633.22	1802.55
C12	2.75	8.66	748.16	1802.55
C13	3.00	4.71	3.00	90.0000
C14	3.00	1.84	1.31	10519.97
C15	18.00	23.46	13.73	71440.33
C16	12.00	9.85	9.22	4702.56
C17	1.00	2.32	2.30	1325.704
C18	1.00	2.15	1.84	1230.921
C19	11.93	11.93	1.84	35.5610
C20	1.00	1.86	1.34	106.3606
C21	8.00	10.25	5.96	7323.54
C22	1.00	2.00	1.58	1151.958
C23	8.00	9.01	6.44	6440.02
C24	15.00	23.03	14.48	6758.24
C25	1.00	1.61	1.04	9201.36
C26	1.00	1.84	1.43	11035.32
C27	1.00	1.75	1.20	10026.38
C28	12.00	16.66	9.98	79.3128
C29	15.00	18.08	10.32	69.943
C30	4.00	6.21	6.21	89.5858
C31	14.50	15.55	8.61	61.2541
C32	3.00	6.21	5.03	11834.19
C33	2.00	3.14	2.00	90.0000
C34	2.00	39.27	25.00	90.0000
C35	3.50	5.91	3.93	96.4039
C36	25.00	36.36	22.24	8319.21
C37	308.00	135.89	69.06	2511.51
C38	261.00	114.78	58.33	2511.51
C39	3.00	4.71	3.00	90.0000
C40	15.00	25.64	17.23	67.5541
C41	3.00	18.20	10.78	71.2438
C42	15.00	5.92	4.54	11302.56
C43	12.00	14.02	5.94	66.5700
C44	3.00	4.71	3.00	89.5853
C45	3.00	4.71	3.00	90.0000
C46	25.00	39.27	25.00	90.0000
C47	1.00	1.73	1.20	1002.63
C48	8.00	8.38	4.62	60.0000
C49	25.00	38.76	24.49	88.9428
C50	25.00	33.07	20.00	90.0000
C51	25.00	39.27	25.00	90.0000
C52	3.95	12.41	<infinity>	180200.00
C53	3.95	12.41	272.02	181.4035
C54	2.54	7.45	<infinity>	<infinity>

LINE	DIRECTION	DISTANCE
L1	N0019°14'E	16.26
L2	N0019°14'E	16.71
L3	N0019°14'E	3.00
L4	N0019°14'E	15.20
L5	S89°40'45"E	9.00
L6	S89°40'45"E	9.00
L7	N0019°14'E	15.20
L8	N0019°14'E	3.00
L9	N0019°14'E	16.71
L10	N0019°14'E	16.26
L11	N0019°14'E	4.51
L12	S89°40'45"E	14.71
L13	S0019°15'W	15.76
L14	S0019°15'W	15.73
L15	S0019°15'W	13.50
L16	N0019°15'E	13.48
L17	S89°40'45"E	6.50
L18	S89°40'45"E	6.50
L19	S89°40'45"E	14.71
L20	S89°40'45"E	14.55
L21	N0019°15'E	9.00
L22	N0019°15'E	9.00
L23	S89°40'45"E	16.39
L24	S89°40'45"E	16.03
L25	N89°40'45'W	3.15
L26	N89°40'45'W	31.95
L27	N89°40'45'W	3.15
L28	N89°40'45'W	3.15
L29	S0019°15'W	9.50
L30	S89°40'45"E	16.83
L31	S89°40'45"E	16.83
L32	N89°40'45'W	13.00
L33	N89°40'45'W	13.00
L34	S89°40'45"E	16.48
L35	S89°40'45"E	16.48
L36	N89°40'45'W	32.89
L37	N89°40'45'W	32.89
L38	N89°40'45'W	9.00
L39	N89°40'46'W	14.00
L40	N0019°15'E	3.13
L41	N0019°15'E	3.13
L42	N0019°15'E	16.70
L43	S89°40'45'E	1.00
L44	S0019°15'W	14.85
L45	N0019°15'E	39.31
L46	N0019°15'E	15.01
L47	S0019°15'W	15.01
L48	S89°40'45"E	12.85
L49	S0019°15'W	18.05
L50	N0019°15'E	14.28
L51	N0019°15'E	15.01
L52	S89°40'44'E	16.00
L53	S0019°15'W	17.08
L54	S0019°15'W	17.08
L55	S0019°15'W	20.58
L56	S0019°15'W	20.52
L57	S0019°15'W	15.50
L58	S0019°15'W	15.50
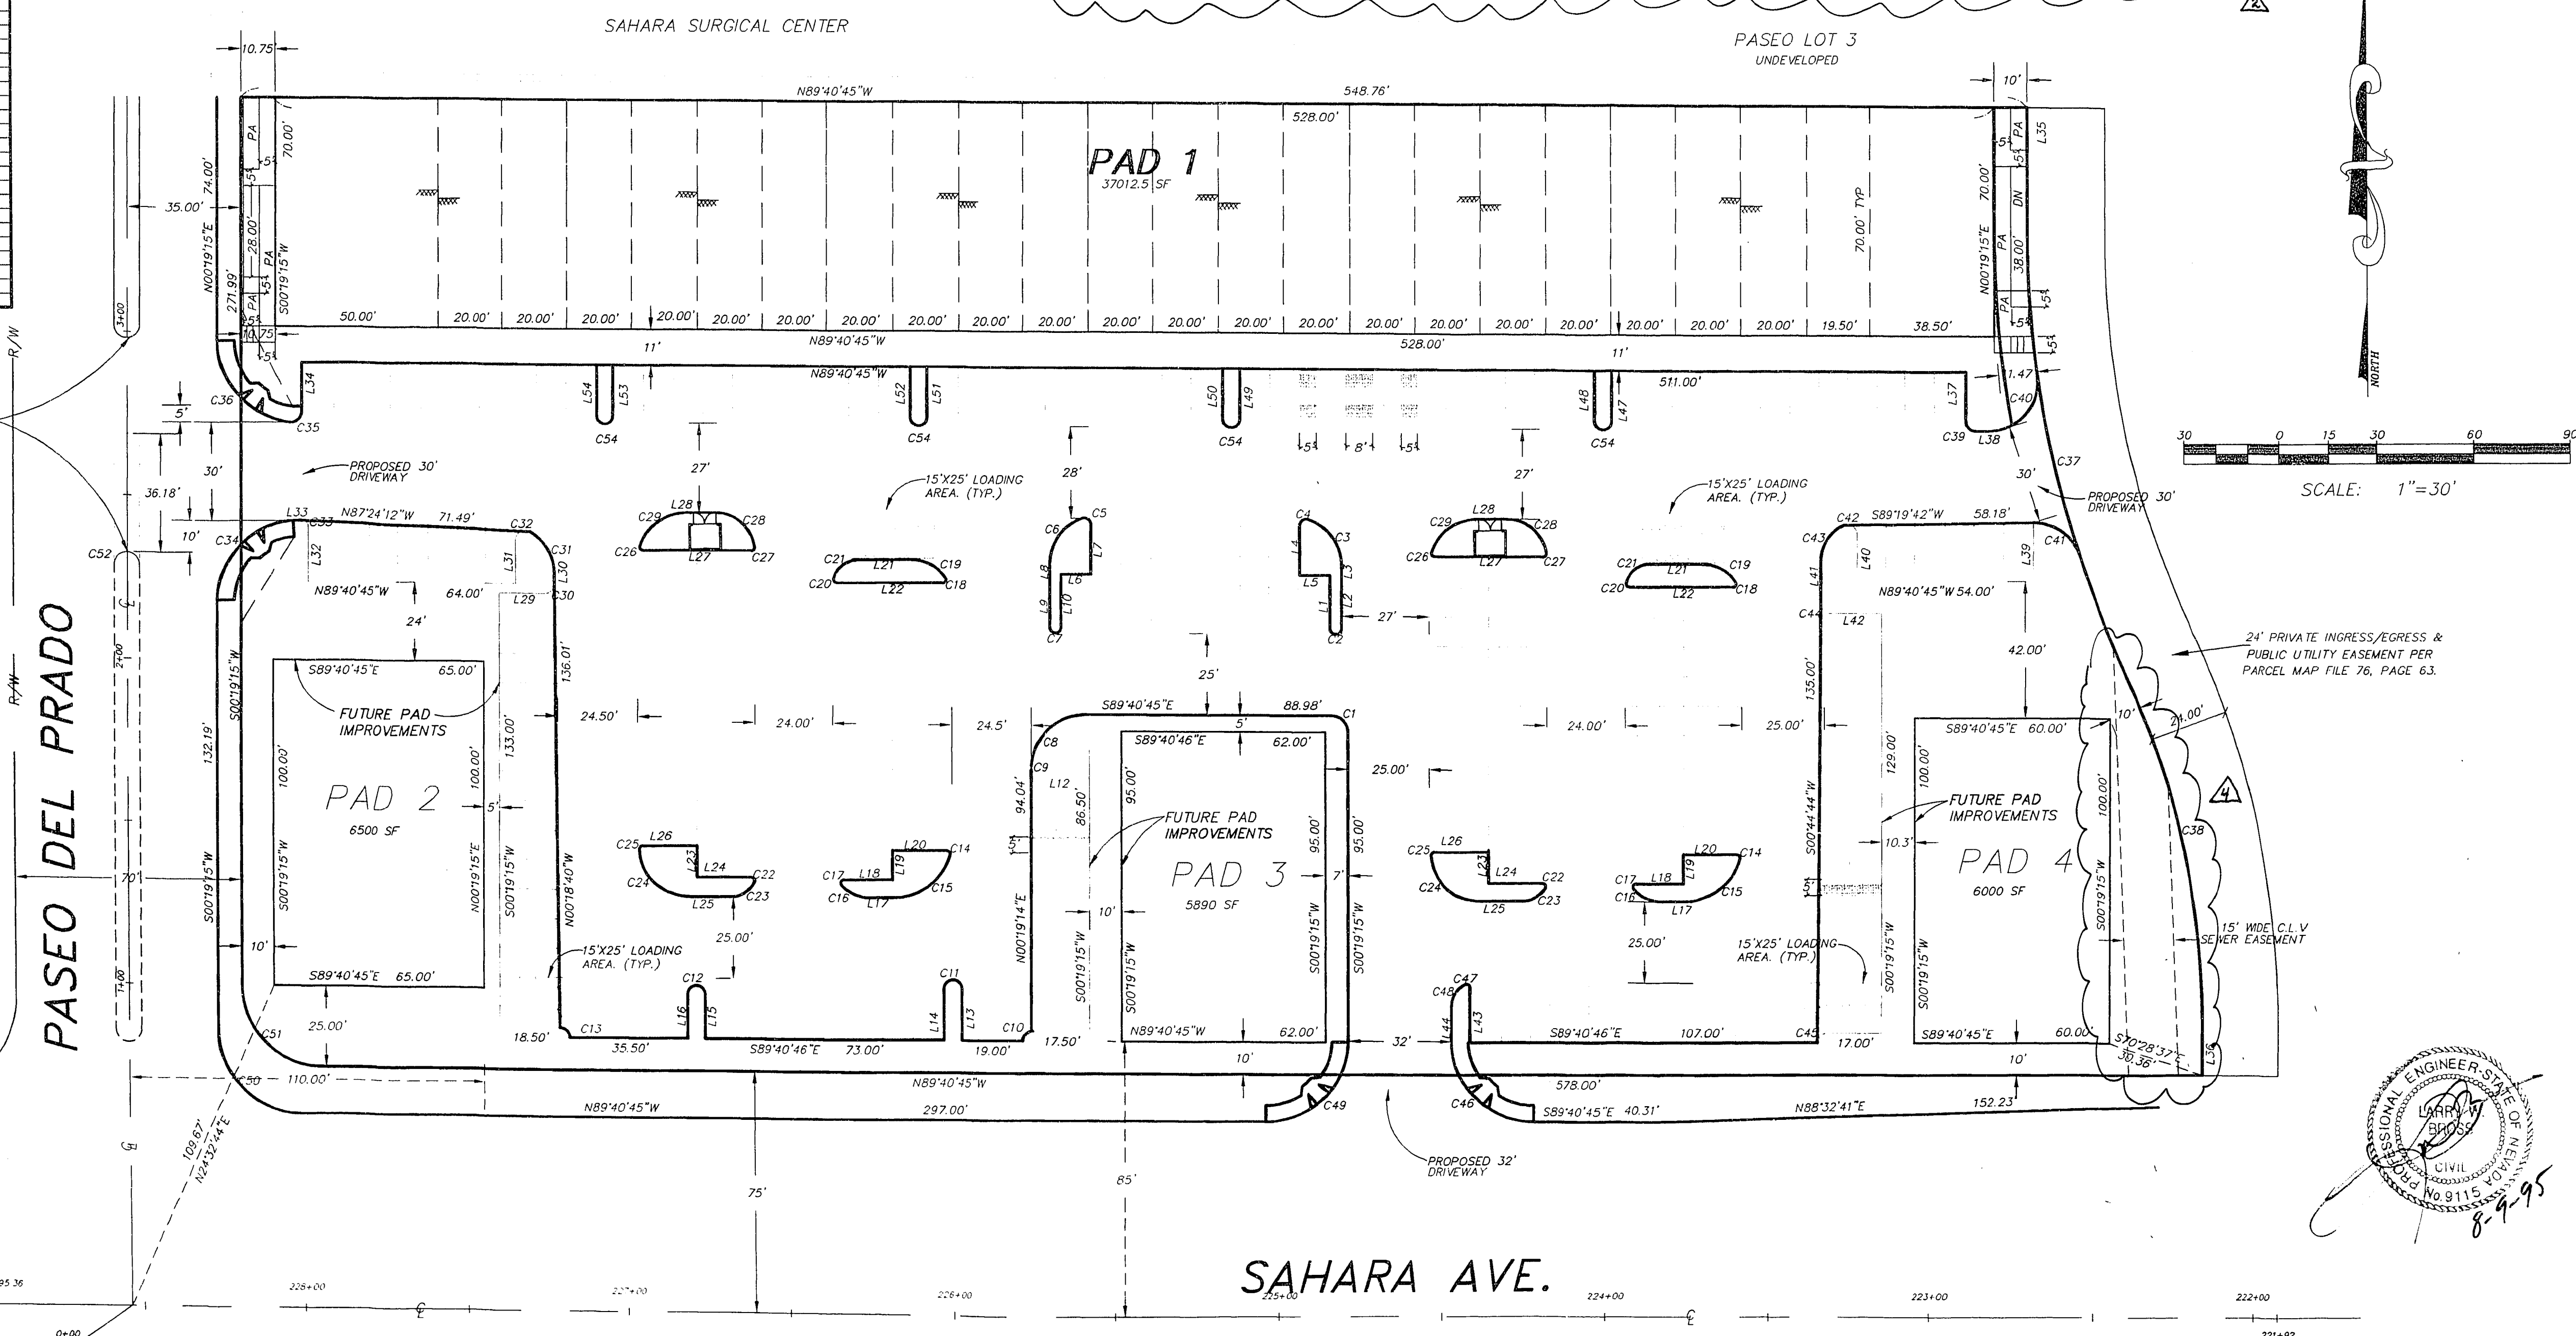

Avoid cutting underground utility lines. It's costly
Call before you Dig
1-800-227-2600
UNDERGROUND SERVICE (USA)

PREPARED BY:

GLI PREPARE

HORIZONTAL CONTROL/ SEWER PLAN & PROFILE	SAHARA COMMERCIAL CENTER - PHASE I LAS VEGAS, NEVADA
--	--

SCALE(H): 1" = 30'
SCALE(V): 1" = --
DES.BY: MPV
DWN.BY: PAS
DATE: 06/94
PROJECT NO.
1500-3

SHEET
2 OF 5

• *Engineering • Surveying*
3101 WEST POST ROAD
LAS VEGAS, NEVADA 89118
(702) 897-4233













