



- NOTE:
1. REFER TO ARCHITECTURAL PLANS FOR HEAVY DUTY PAVEMENT AREAS, SIGNAGE AND STRIPING.
 2. IMPROVEMENTS WITHIN SAHARA RIGHT-OF-WAY REQUIRE AN N.D.O.T. ENCROACHMENT PERMIT PRIOR TO INITIATING CONSTRUCTION OF SUCH IMPROVEMENTS.

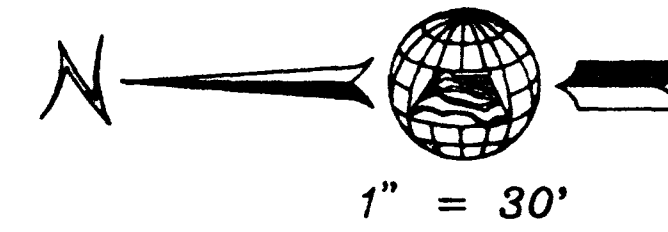

MATCHLINE SHT. 6 OF 12

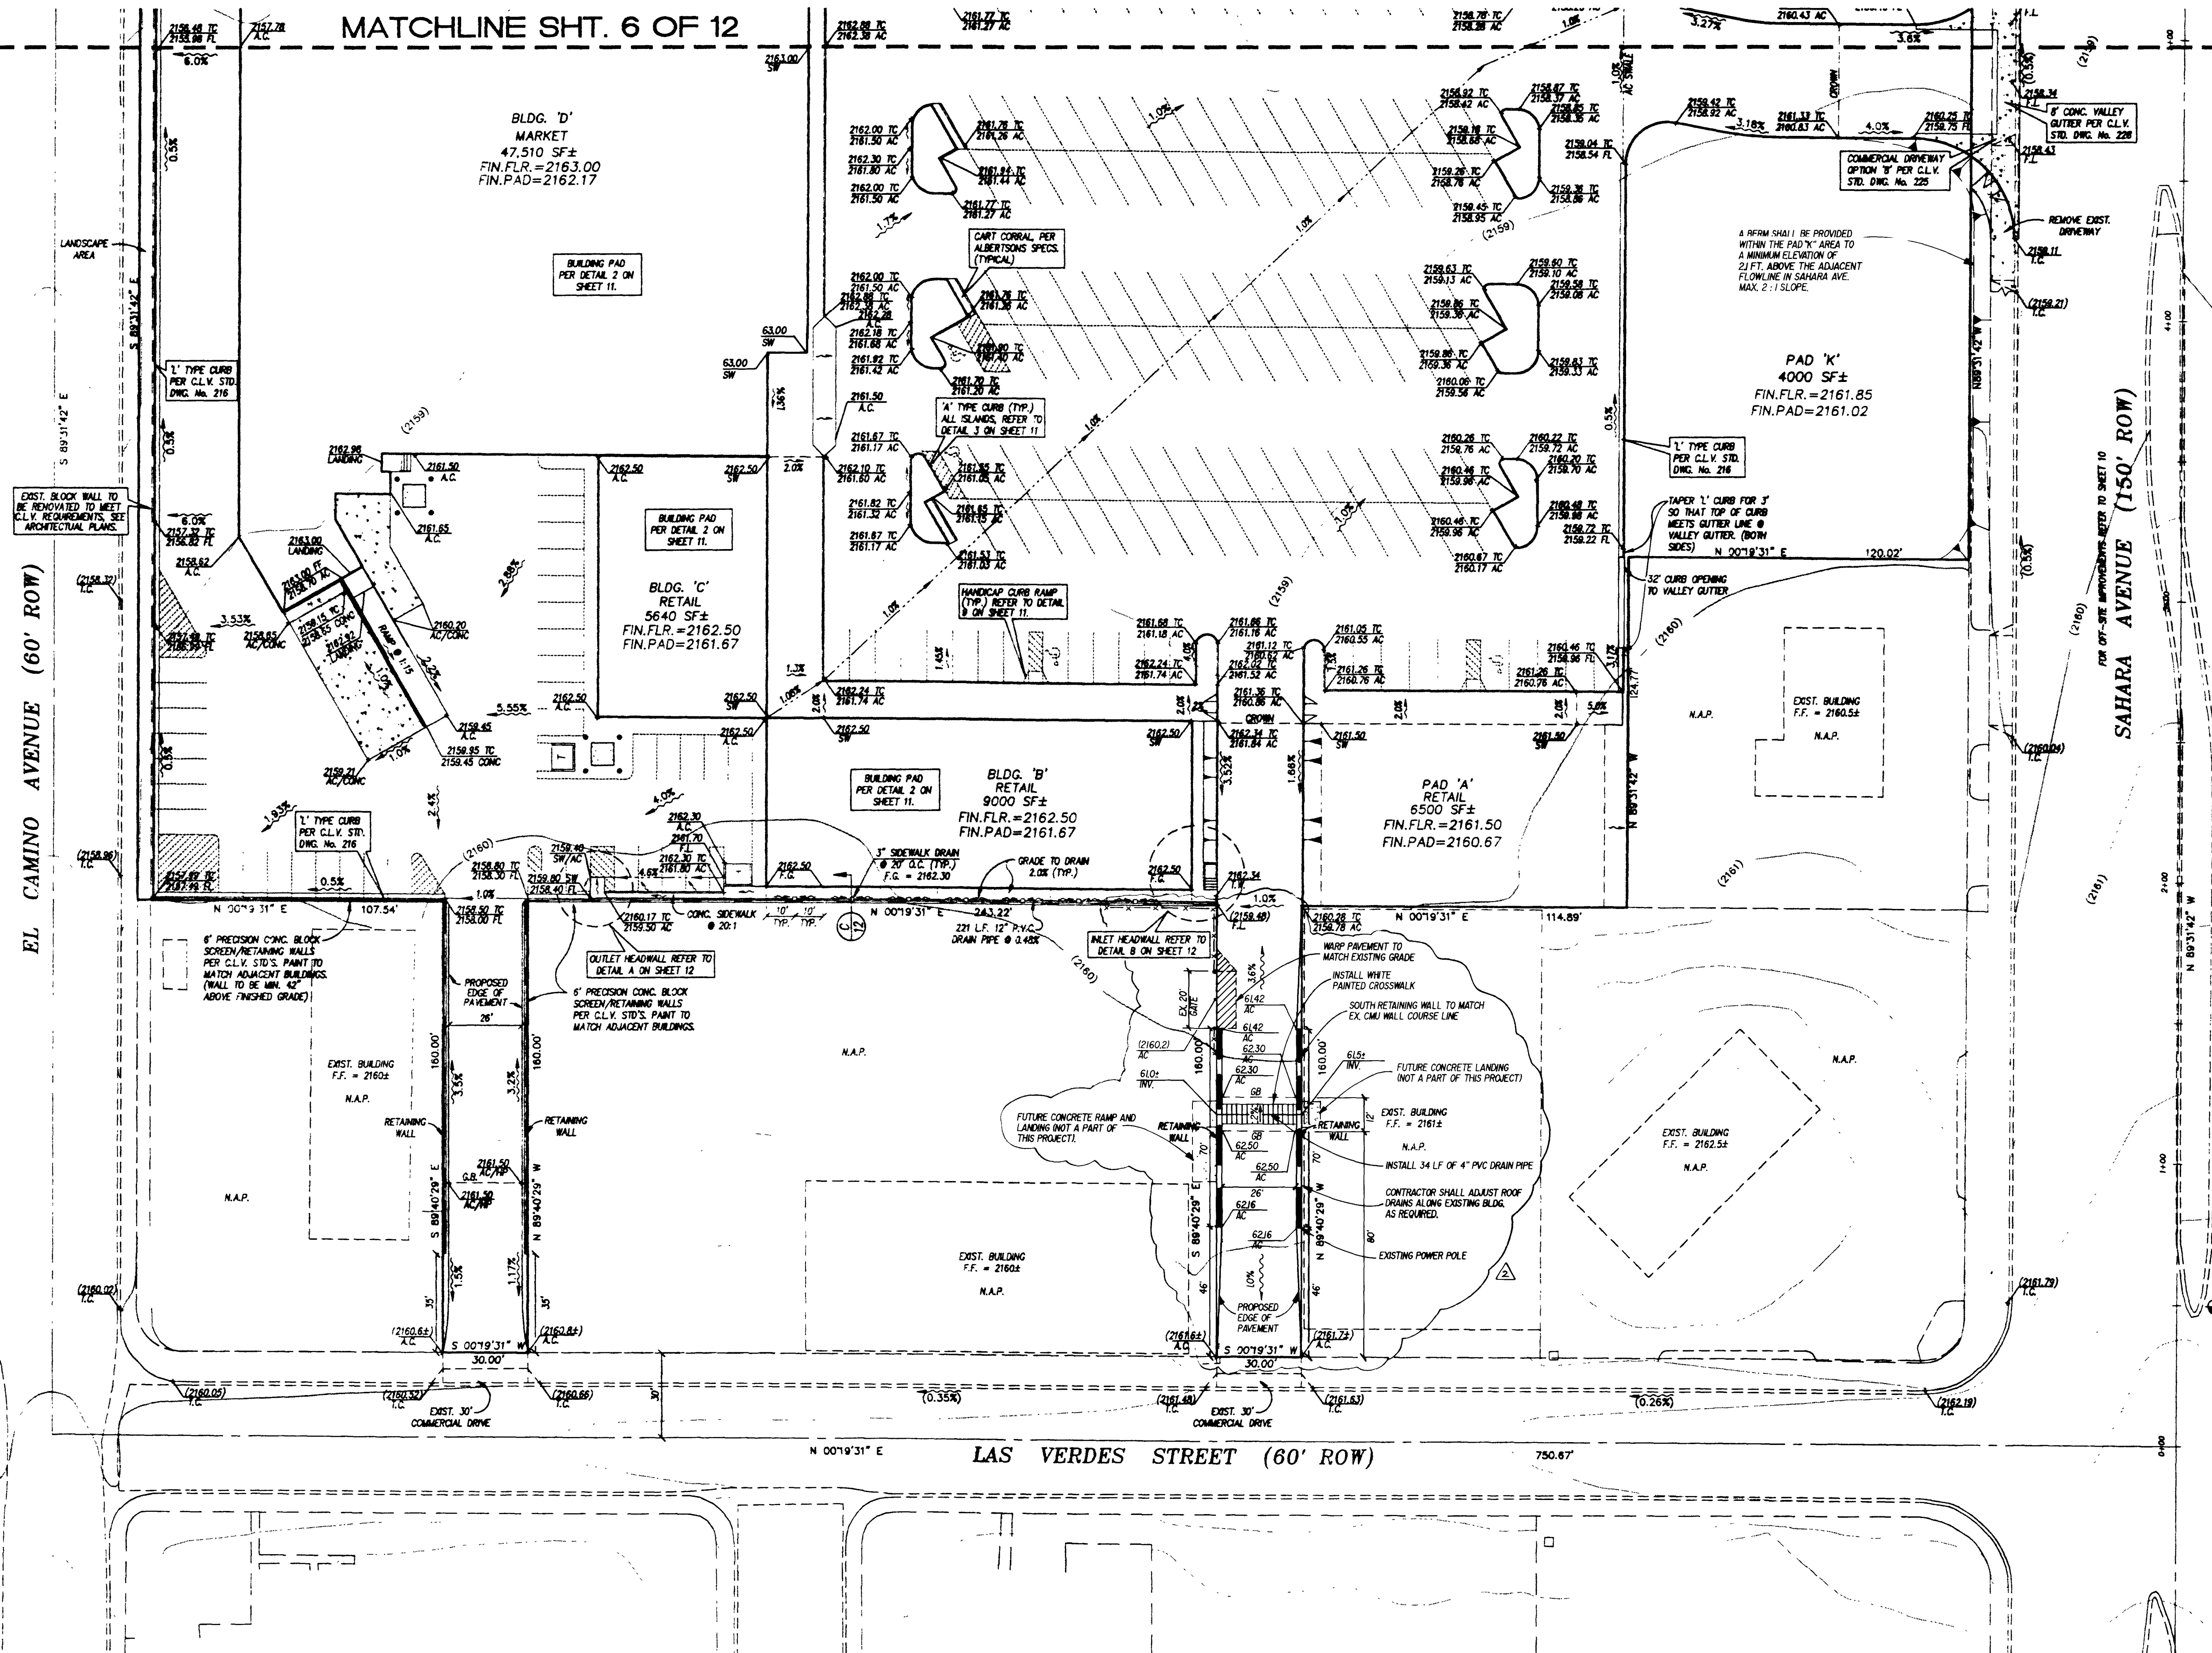

BENCHMARK

SET DRIVE RIVET IN A 2"x2" ALUMINUM PLATE, IN DRILLED HOLE WITH EPOXY GLUE, IN TOP OF CURB, NORTHEAST CORNER OF SAHARA AVE. & VALLEY VIEW BLVD. NEAR THE P.C. OF SAHARA AVE. ELEVATION = 2155.348

WE CERTIFY THAT THIS GRADING PLAN IS IN CONFORMANCE WITH THE APPROVED DRAINAGE STUDY ON FILE AT THE CITY OF LAS VEGAS FOR THIS PROJECT.

ENGINEERS SEAL

3-20-92

387MP

Job Number	Drawn by	Scale	File No.	Sheet Number
7154.387	MP	1" = 30'	387MP	5 OF 12

Church Engineering of Nevada, Inc.
8800 W. Charleston Blvd.
Suite 140
Las Vegas, NV 89102
(702) 878-6244

PayLess / Albertsons
A COMMERCIAL PROPERTY
CITY OF LAS VEGAS CLARK COUNTY NEVADA

GRADING PLAN
WEST PORTION

Job Number 7154.387
Sheet Number 5 OF 12
Drawn by MP
Checked by SR
Date 03-16-92
Scale 1" = 30'
File No. 387MP