



MATCHLINE - 14+00 (FARM ROAD) - SEE SHEET 5

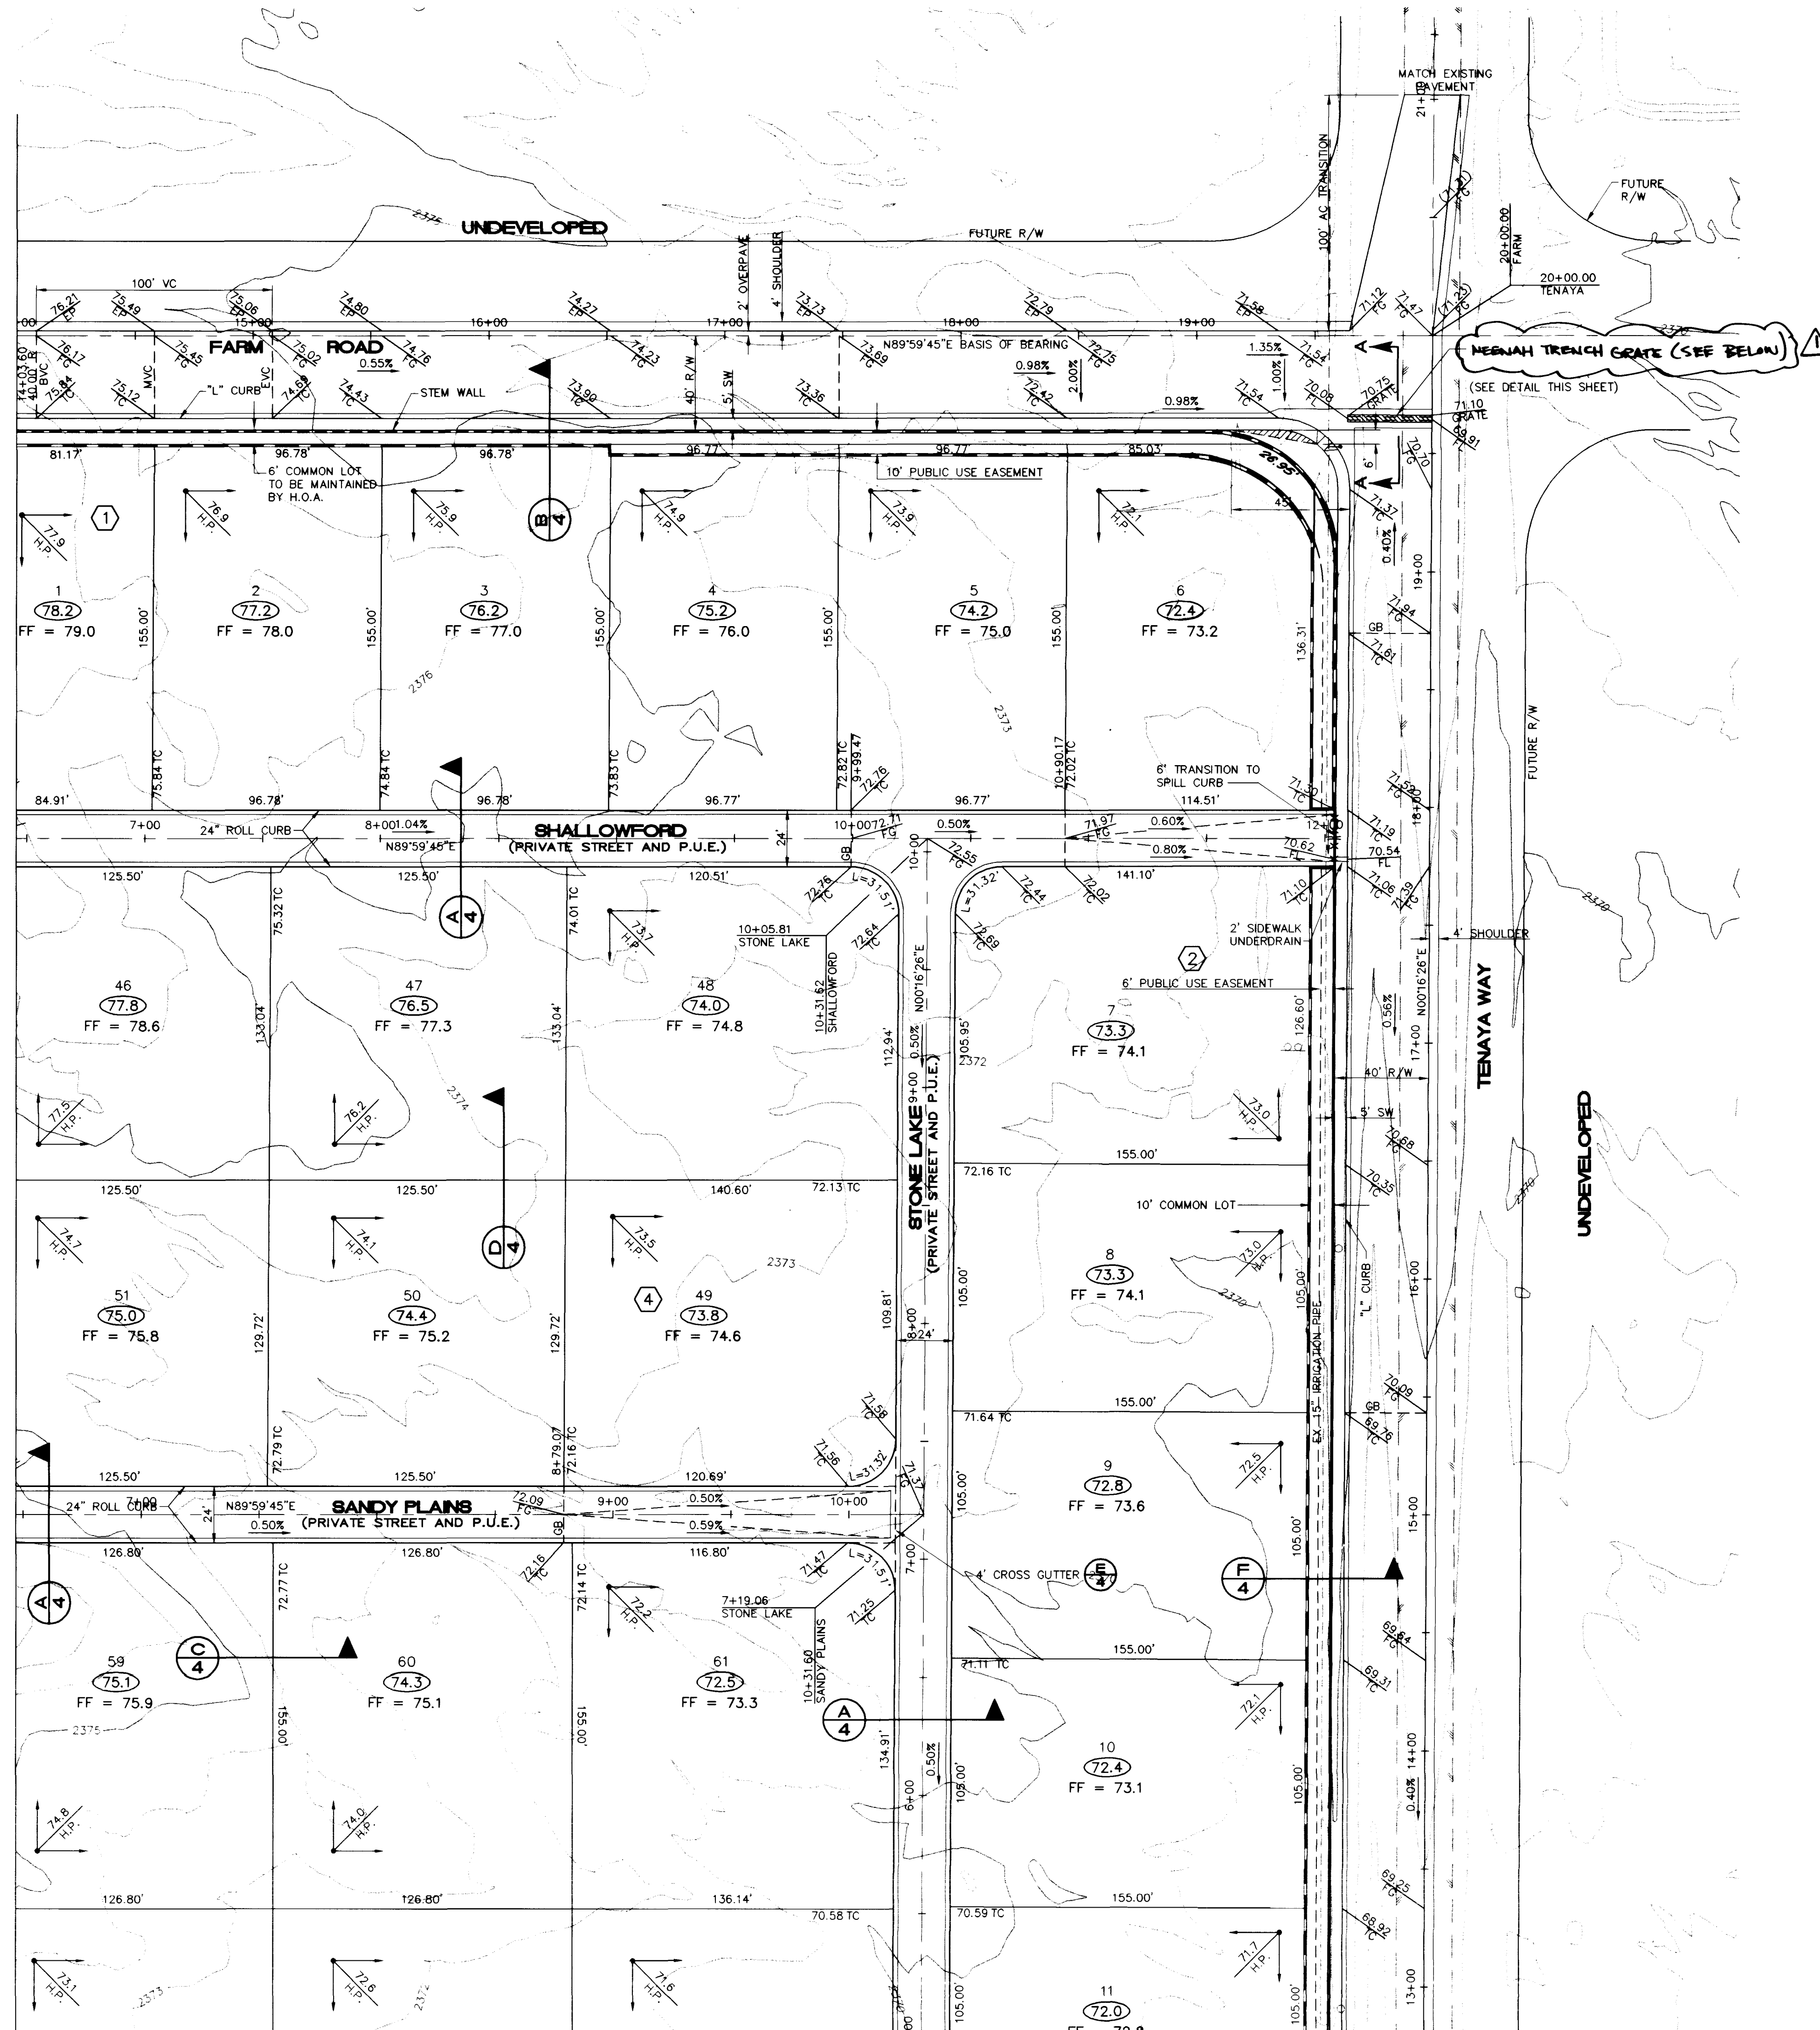

MATCHLINE - 5+00 (STONE LAKE) - SEE SHEET 8

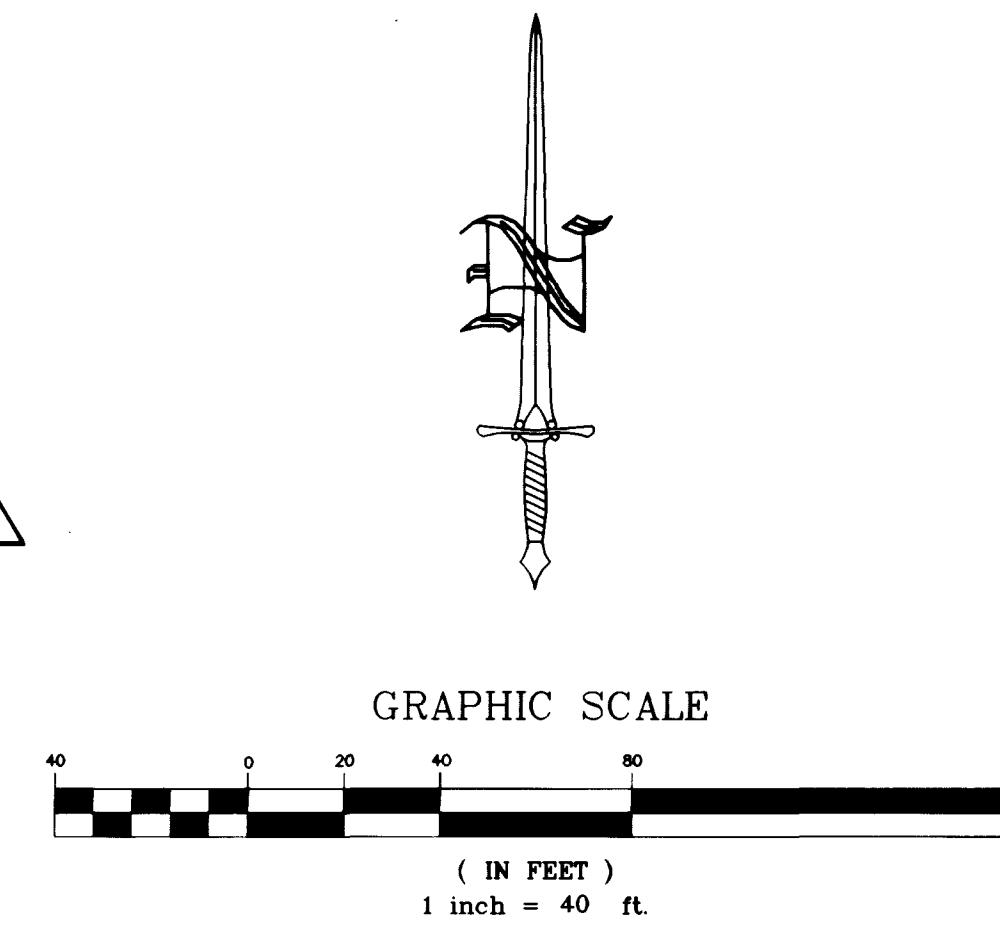

SEE SHEET 5 FOR GRADING LEGEND AND NOTES.

#### DISCLAIMER NOTE

UTILITY LOCATIONS SHOWN HEREON ARE APPROXIMATE ONLY. IT SHALL BE THE CONTRACTOR'S RESPONSIBILITY TO DETERMINE THE EXACT HORIZONTAL AND VERTICAL LOCATION OF ALL EXISTING UNDERGROUND OR OVERHEAD UTILITIES PRIOR TO COMMENCING CONSTRUCTION. NO REPRESENTATION IS MADE THAT ALL EXISTING UTILITIES ARE SHOWN HEREON. THE ENGINEER ASSUMES NO RESPONSIBILITY FOR UTILITIES NOT SHOWN OR UTILITIES NOT SHOWN IN THEIR PROPER LOCATION.

Call before you Dig  
1-800-227-2600

Call before you Overhead  
1-702-593-6111

#### LEGAL DESCRIPTION




A PORTION OF THE SOUTHWEST (SW 1/4) QUARTER OF SECTION 15, TOWNSHIP 19 SOUTH, RANGE 60 EAST, M.D.M. IN THE CITY OF LAS VEGAS, CLARK COUNTY, NEVADA

#### BENCHMARK

CITY OF LAS VEGAS BENCHMARK #1190155WS  
CLARK COUNTY GIS BRASS CAP #805-19-60  
N.E. CORNER ELKHORN ROAD AND BUFFALO DRIVE  
ELEVATION = 2412.9623 FEET (NAVD 88)  
ELEVATION = 735.7409 METERS (NAVD 88)

#### BASIS OF BEARING

BEING THE NORTH LINE OF THE NORTHEAST QUARTER (NE 1/4) OF THE SOUTHWEST QUARTER (SW 1/4) AS DEPICTED UPON A RECORD OF SURVEY FILED OF RECORD IN FILE 34 PAGE 37 OF SURVEYS, OFFICIAL RECORDS, CLARK COUNTY, NEVADA. SAID LINE BEARS N.89°59'45"E.

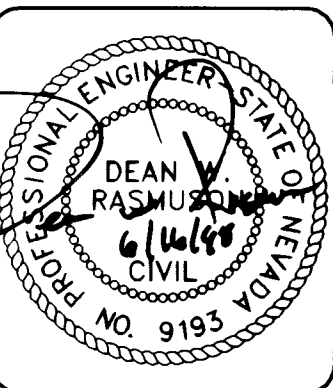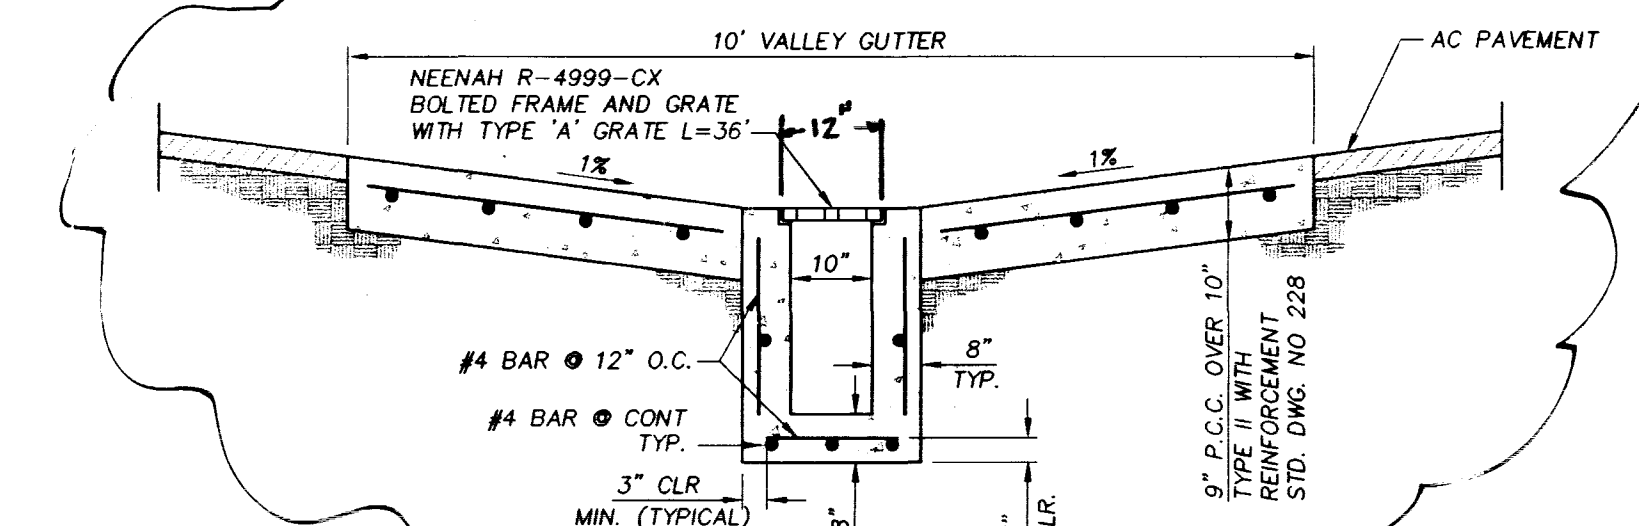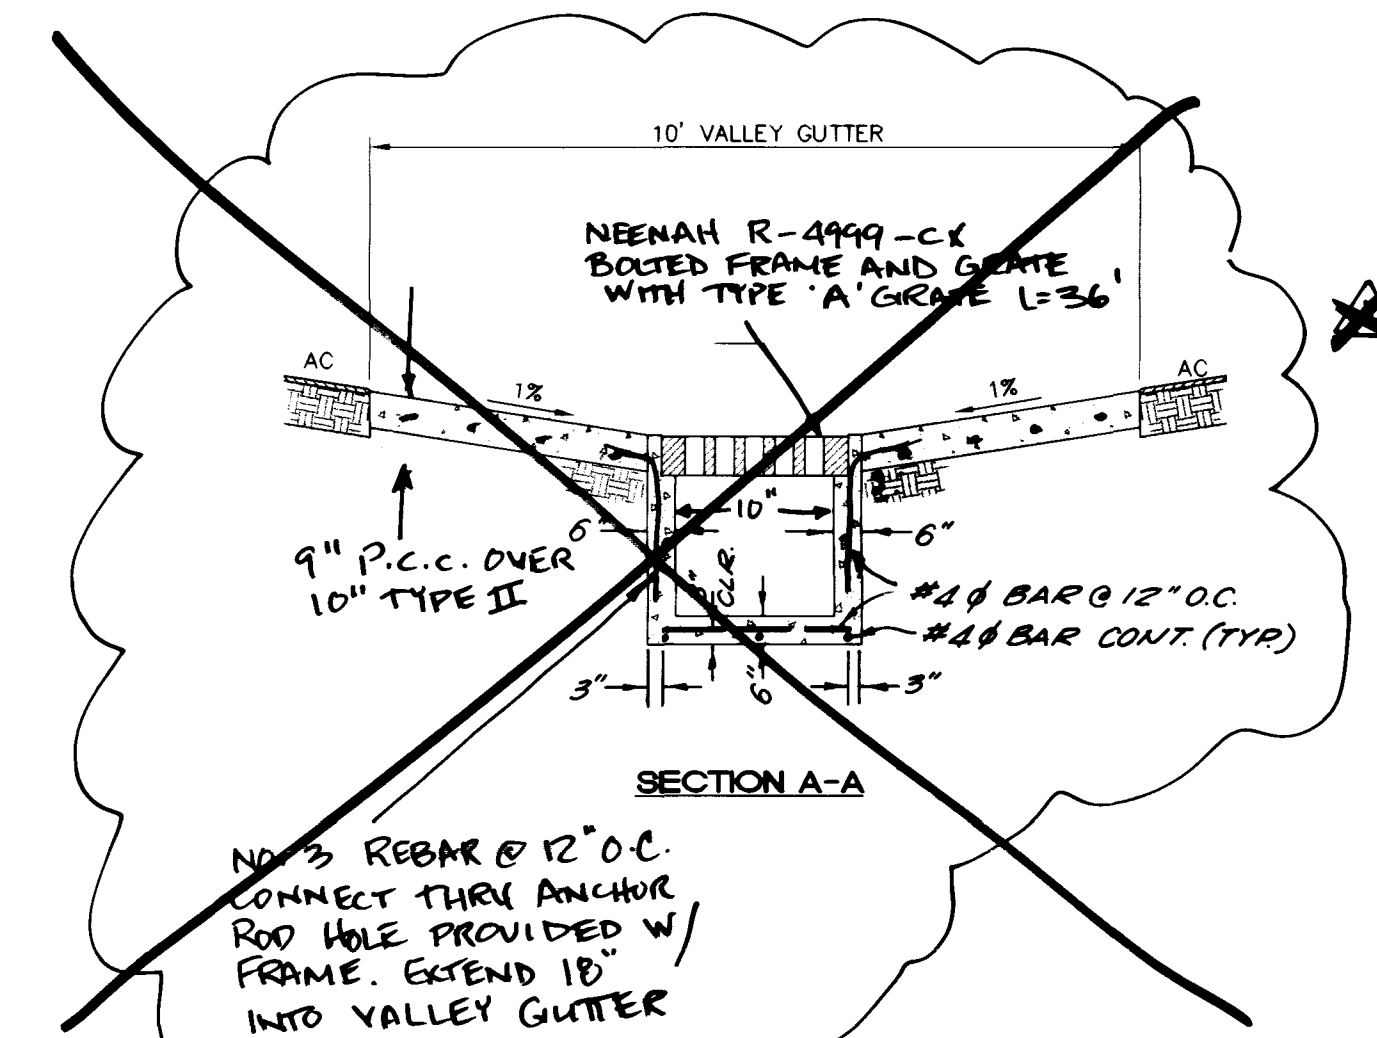

|              |                     |       |
|--------------|---------------------|-------|
| DESIGNED BY: | DRAWN BY:           | DATE: |
| CHECKED BY:  | JOB NUMBER: 0016007 | BY:   |
| NO.          | REVISION            | DATE  |


CLARIFY GRADE/TRENCH/ VALLEY GUTTER DETAIL

#### GRADING PLAN

SALT CREEK - CUSTOM HOME COMMUNITY  
WATT HOMES - NEVADA DIVISION

CITY OF LAS VEGAS

ORION ENGINEERING AND SURVEYING, INC.  
3068 E. SUNSET ROAD, SUITE 9  
LAS VEGAS, NEVADA 89120  
(702) 739-5921 FAX (702) 739-5929

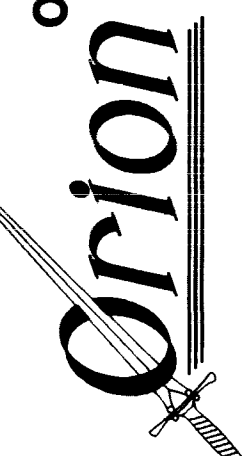

SHEET 6  
of 19

