


LEGEND

CL OR SURVEY LINE	EASEMENT LINE	DEMO. SURFACE	MANHOLES & DESCRIPTIONS		CAP	DESCRIPTION	BO VALVE	CLEAN OUT	FDC	FIRE HYDRANT	GATE VALVE	REDUCER	100w HPS STREETLIGHT	150w HPS STREETLIGHT	200w HPS STREETLIGHT	250w HPS STREETLIGHT	400w HPS STREETLIGHT	5' CONTOUR LINE	1' CONTOUR LINE	EDGE OF P.W.T.	"A" TYPE CURBS	"L" TYPE CURBS	WALLS	FENCES	SPOT ELEVATIONS	SIGNS
PROPERTY LINE	SAWCUT LINE	LIGHT AC P.W.T.	⑤ = SANITARY SEWER	⑥ = ELECTRICAL		EXISTING:	⬇	○	⦿	⦿	⦿	▶	⦿	⦿	⦿	⦿	⦿	---	---	---	---	---	---	---	---	
ROW LINE	SCARP LINE	TENNIS COURT	⑦ = STORM DRAIN	⑧ = TELEPHONE		PROPOSED:	⬇	○	⦿	⦿	⦿	▶	⦿	⦿	⦿	⦿	⦿	---	---	---	---	---	---	---	---	
																		12.34 BC								

112114

U.P.P.R.

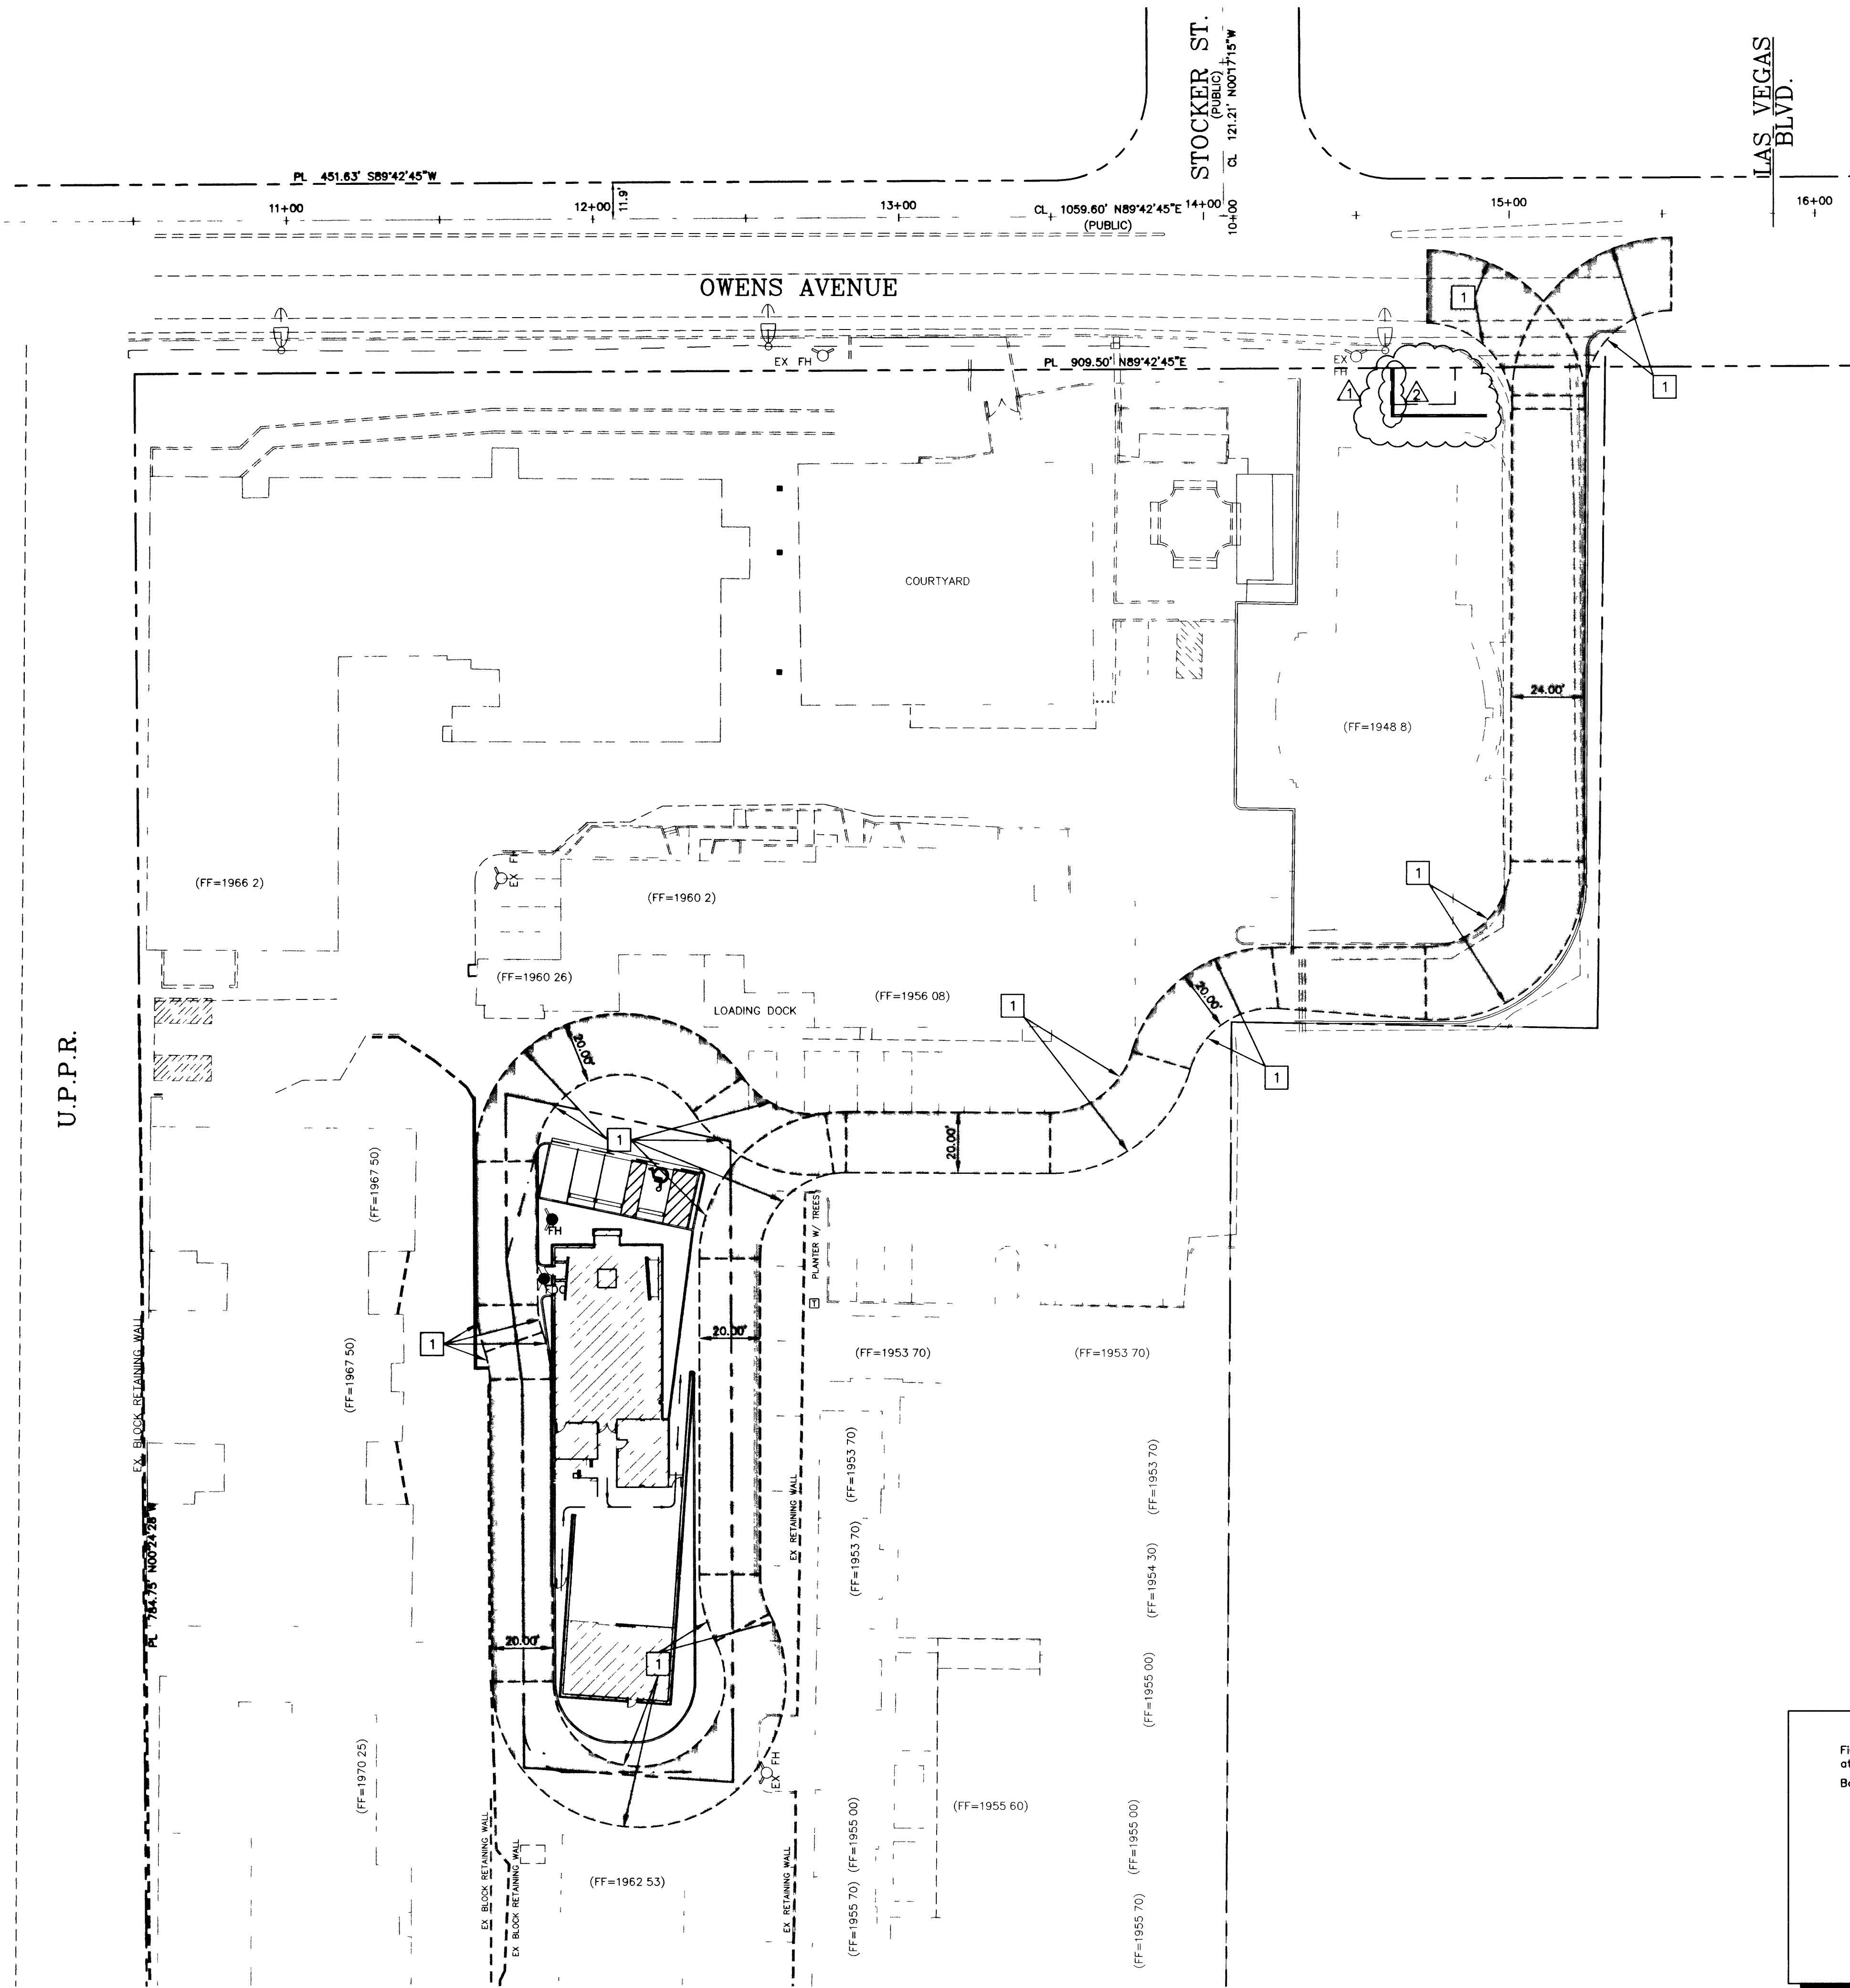

LEGEND:

PROPOSED FIRE/EMERGENCY VEHICLE TRAVEL PATH.

1 FIRE TRUCK TURNING RADIUS

NOTE:

MAINTAIN FIRE ACCESS DURING CONSTRUCTION.

FIRE FLOW CALCULATIONS:

Fire Flow Requirement is 1,500 gallons per minute at 20 psi residual pressure

Based on: Square Footage: 4,820 square feet

Largest area between 4-Hour area separation walls: N/A square feet

Building height: 40'-0" feet

Number of Stories: ONE (1) floors

Type of Construction: V-B


Occupancy: A3

Full Automatic Fire Sprinkler System: Yes No

Reviewed By: [Signature] Date: 4/27/08

NBD
NORTH

GRAPHIC SCALE

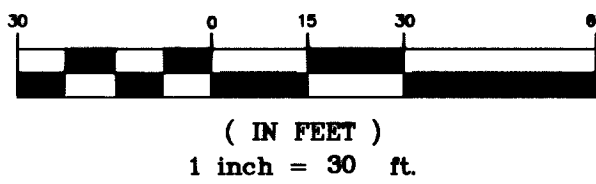

PROJECT
SITE

OWENS AVE.

STOCKER ST.

UNION PACIFIC BR.

LAS VEGAS BLVD.

VICINITY MAP

N.T.S.

Nevada By Design

CLARK COUNTY TRAFFIC OPERATIONS
3015 East Flamingo Ave., Suite 100
Las Vegas, NV 89119
www.nvbydesign.com

DRAWN BY: DMS SCALE: 1"=30'
DESIGNED BY: DMS JOB NUMBER: 06564
CHECK BY: BAR DATE: 04/08/08

SALVATION ARMY CHAPEL

FIRE ACCESS PLAN

BENCHMARK:

CITY OF LAS VEGAS BENCHMARK No. 7C01 22SSE6

BEING A RIVET AND PLATE IN TOP OF CURB AT THE NORTHEAST CORNER OF OWENS AVENUE AND DAVIS PLACE.

ELEVATION = 585 4462 METERS NAVD 88
ELEVATION = 1920.75 U.S. FEET NAVD 88

BASIS OF BEARINGS:

ASSUMED NORTH 89°42'45" EAST BEING THE BEARING OF OWENS AVENUE BETWEEN MAIN STREET AND DAVIS PLACE.

Call before you Dig
UnderGround
1-702-455-7511
CLARK COUNTY TRAFFIC OPERATIONS
1-702-455-7540
CLARK COUNTY ROAD AND MAINTENANCE MANAGEMENT
1-702-432-5300

Call before you Dig
OVERHEAD
1-702-593-6111
NEVADA POWER ENVIRONMENT AND SAFETY SERVICES DEPARTMENT

Call before you Dig
811
ON 1-800-227-2600
CLARK COUNTY TRAFFIC OPERATIONS
1-702-455-7544

SEAL:
BOLESLO A. ROMERO
EXP. 12/31/08
CIVIL
15816

SHEET NO.:
C5.00
RELOT
SHEET 7 OF 8
DRAWING NUMBER
107V4912