


APPROVED: _____
CITY ENGINEER DATE

SCALE
Horizontal 1"=40'
Vertical 1"=4'

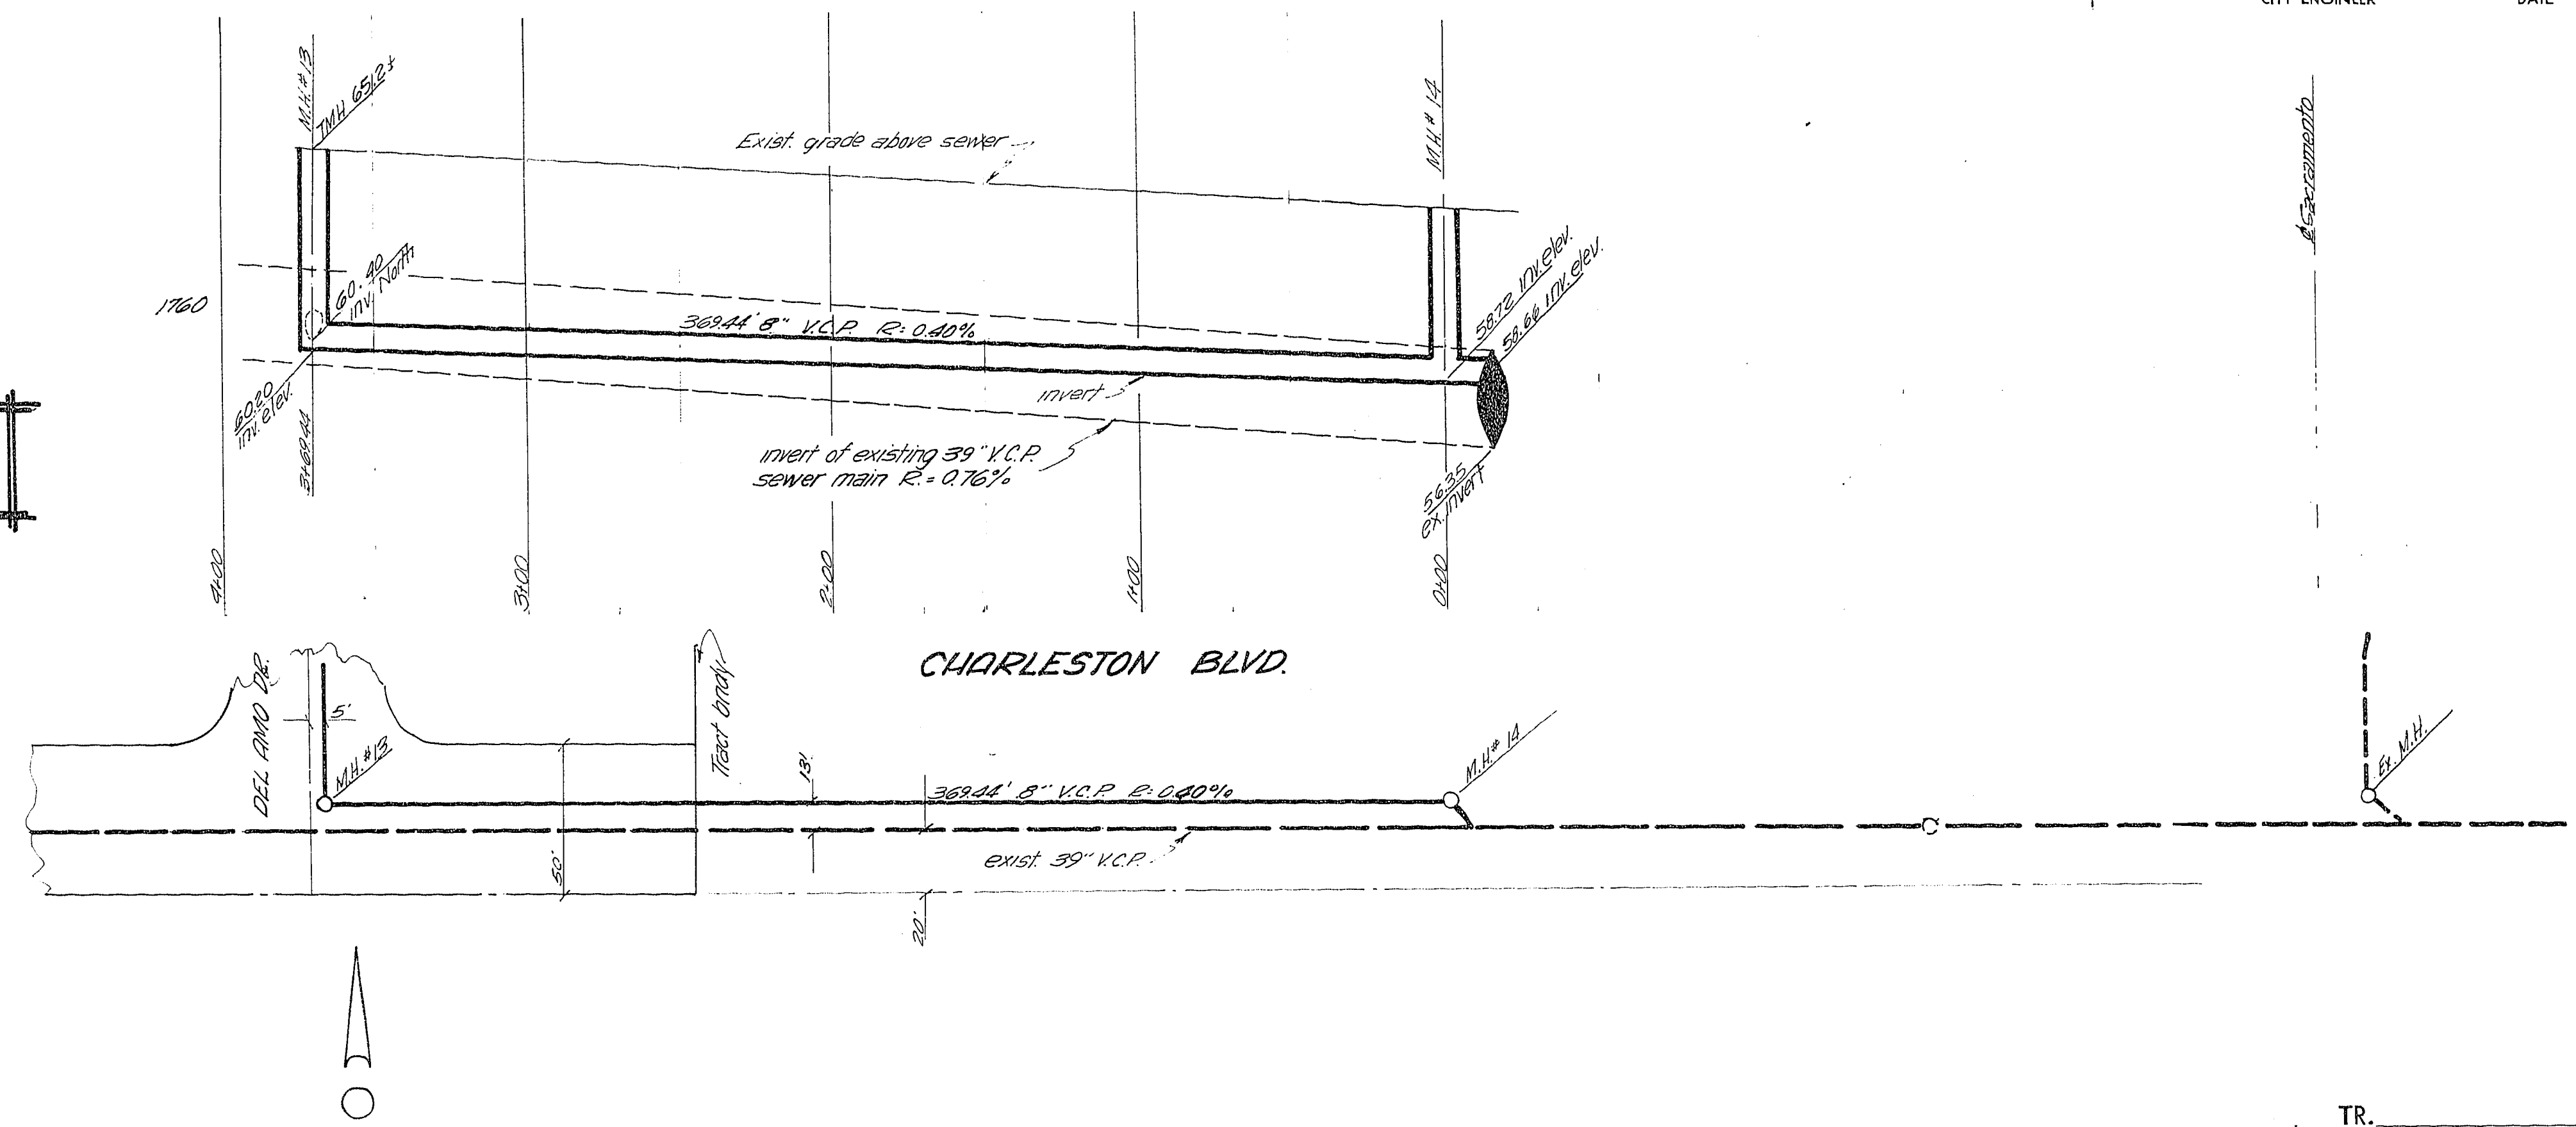

SEE PLAN NO. FOR BENCH MARK, STD. NOTES & KEY MAP

PLAN PREPARED BY: <i>John A. Hamilton</i> RCE	DATE 7/1/69	PLAN NO.
---	----------------	----------

TR.

Sht. of Shts.

APPROVED: _____
CITY ENGINEER DATE

APPROVED BY:

[Signature] 9-10-69
Las Vegas City Engineer date

[Signature] 9-2-69
City of Las Vegas Field Engineer date

[Signature] 9-8-69
Supt. of Sanitation date

VCT Nevada	2209 Paradise Road Las Vegas, Nevada	
SANDHILL ESTATES UNIT N° 1 SEWER PLAN & PROFILE CHARLESTON BLVD.		
PLAN PREPARED BY: <i>John A. Hamilton</i> RCE	DATE 7/1/69	PLAN NO. 9 of 11

Re: grade & pipe size between MM#13 & 15
7/12/69 J.L.M.

SEE PLAN NO. FOR BENCH MARK, STD. NOTES & KEY MAP

Sht. of Shts.