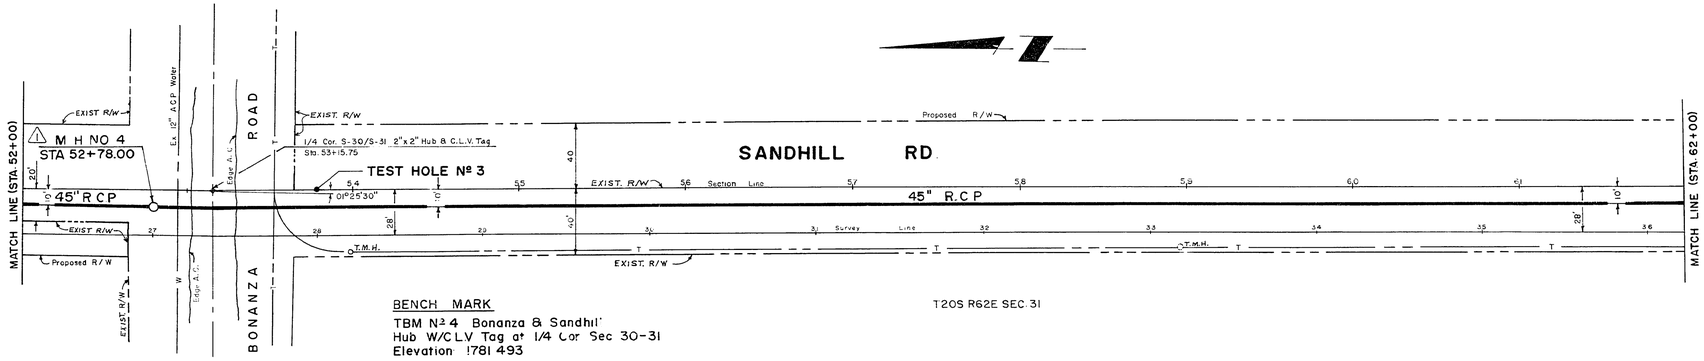

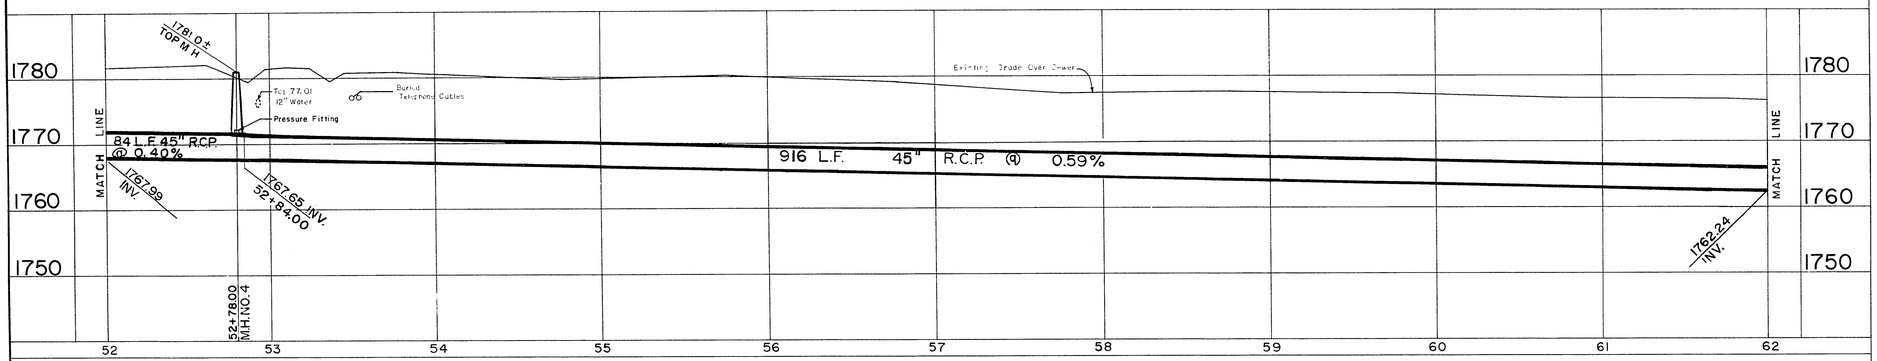

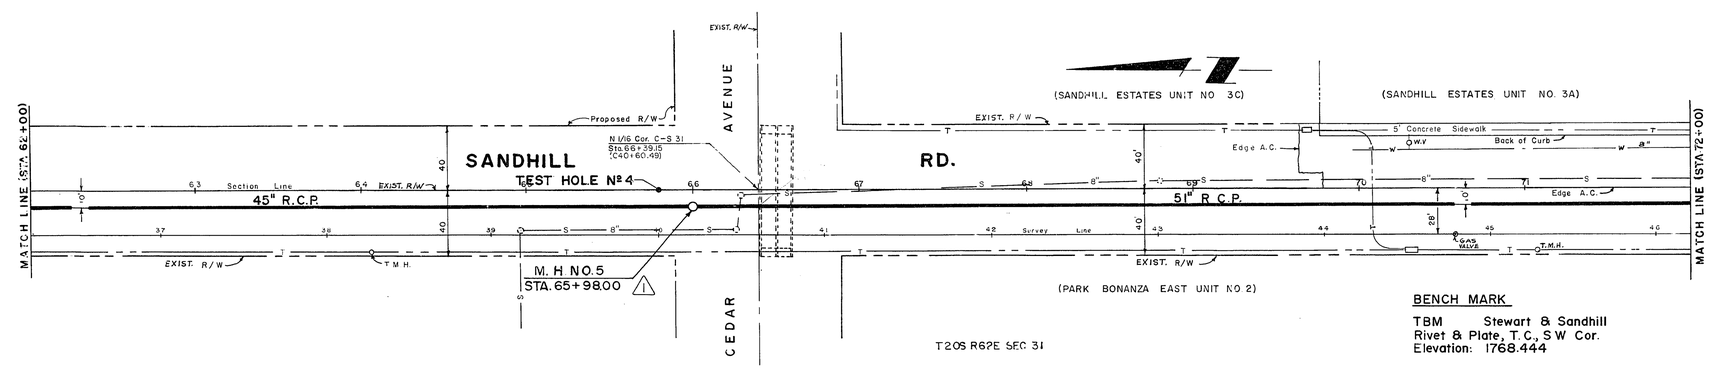

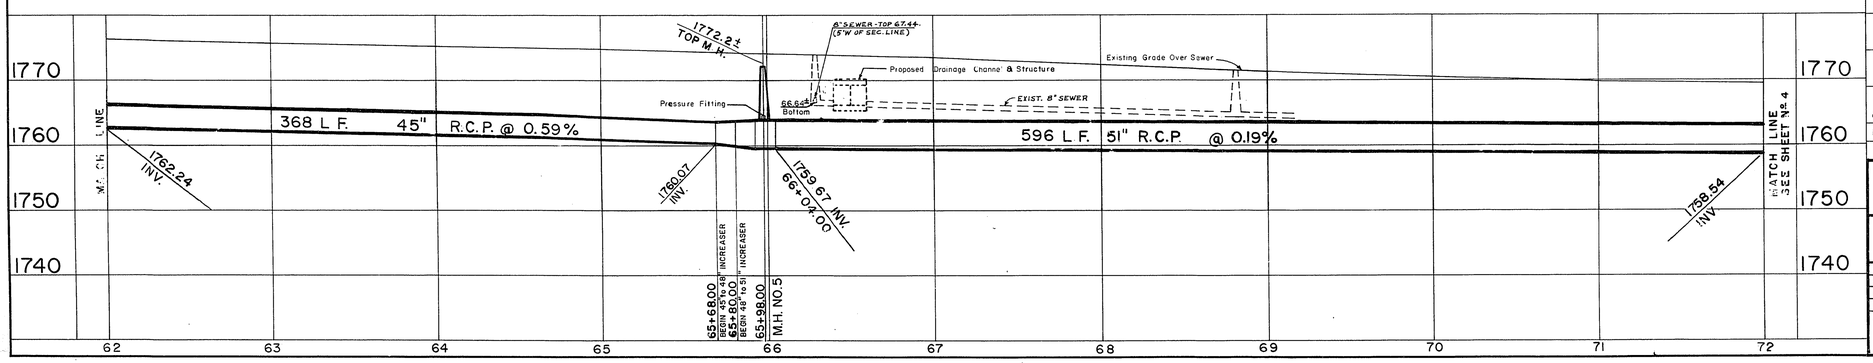

APPROXIMATE QUANTITIES - THIS SHEET

ITEM	DESCRIPTION	UNIT	QUANTITY
121 245C	45" R.C.P.	L.F.	1356
121 251C	51" R.C.P.	L.F.	596
121 951R	45" TO 51" R.C.P. INCREASER 24' LG.	E.A.	1
	MANHOLE NO. 4	L.S.	
	MANHOLE NO. 5	L.S.	

EXISTING UTILITIES ARE LOCATED ON THE PLANS FOR THE CONVENIENCE OF THE CONTRACTOR ONLY. THE CONTRACTOR [illegible] FULL RESPONSIBILITY FOR PROTECTING [illegible] UTILITIES AND THE CITY BEARS NO RESPONSIBILITY FOR UTILITIES NOT SHOWN ON THE PLANS OR NOT IN THE LOCATION SHOWN ON THE PLANS.

CONTRACT DRAWING

I CERTIFY THAT THIS PLAN WAS PREPARED UNDER MY SUPERVISION.

DATE 23 MAR 72

BID NO 72.63 ~~72.13~~ CONTRACT NO 963 ~~913~~

NO.	DESCRIPTION	BY	DATE	APPROVAL
1	CHANGE M.H. #4 & 5 STATIONING CHANGE QUANTITY 45" R.C.P. CHANGE GRADE 45" R.C.P.	M.G.	8-3-72	

REVISIONS

CITY OF LAS VEGAS NEVADA
DEPARTMENT OF PUBLIC WORKS
SERVICES DIVISION

SANDHILL INTERCEPTOR
WASHINGTON (ON SANDHILL) TO
CHARLESTON (1/5 MILE WEST OF LAMB)

W.O. NO. 3170	F.BK. NO. 70-3X	DATE	DRAWING NO.
SC. (H) 1" = 40'	SC. (V) 1" = 10'		
DES. Dave McGonegle			
DR. S J Arnoud		3-7-72	FILE NO. 307-V445
APPROVED BY DIRECTOR OF PUBLIC WORKS		3-24-72	SHEET 3 OF 10

20-1-9