


12-1-45

PLAN	DATE
NO. 1	12-1-45
NO. 2	
NO. 3	
PROFILE	DATE
NO. 1	12-1-45
NO. 2	
NO. 3	
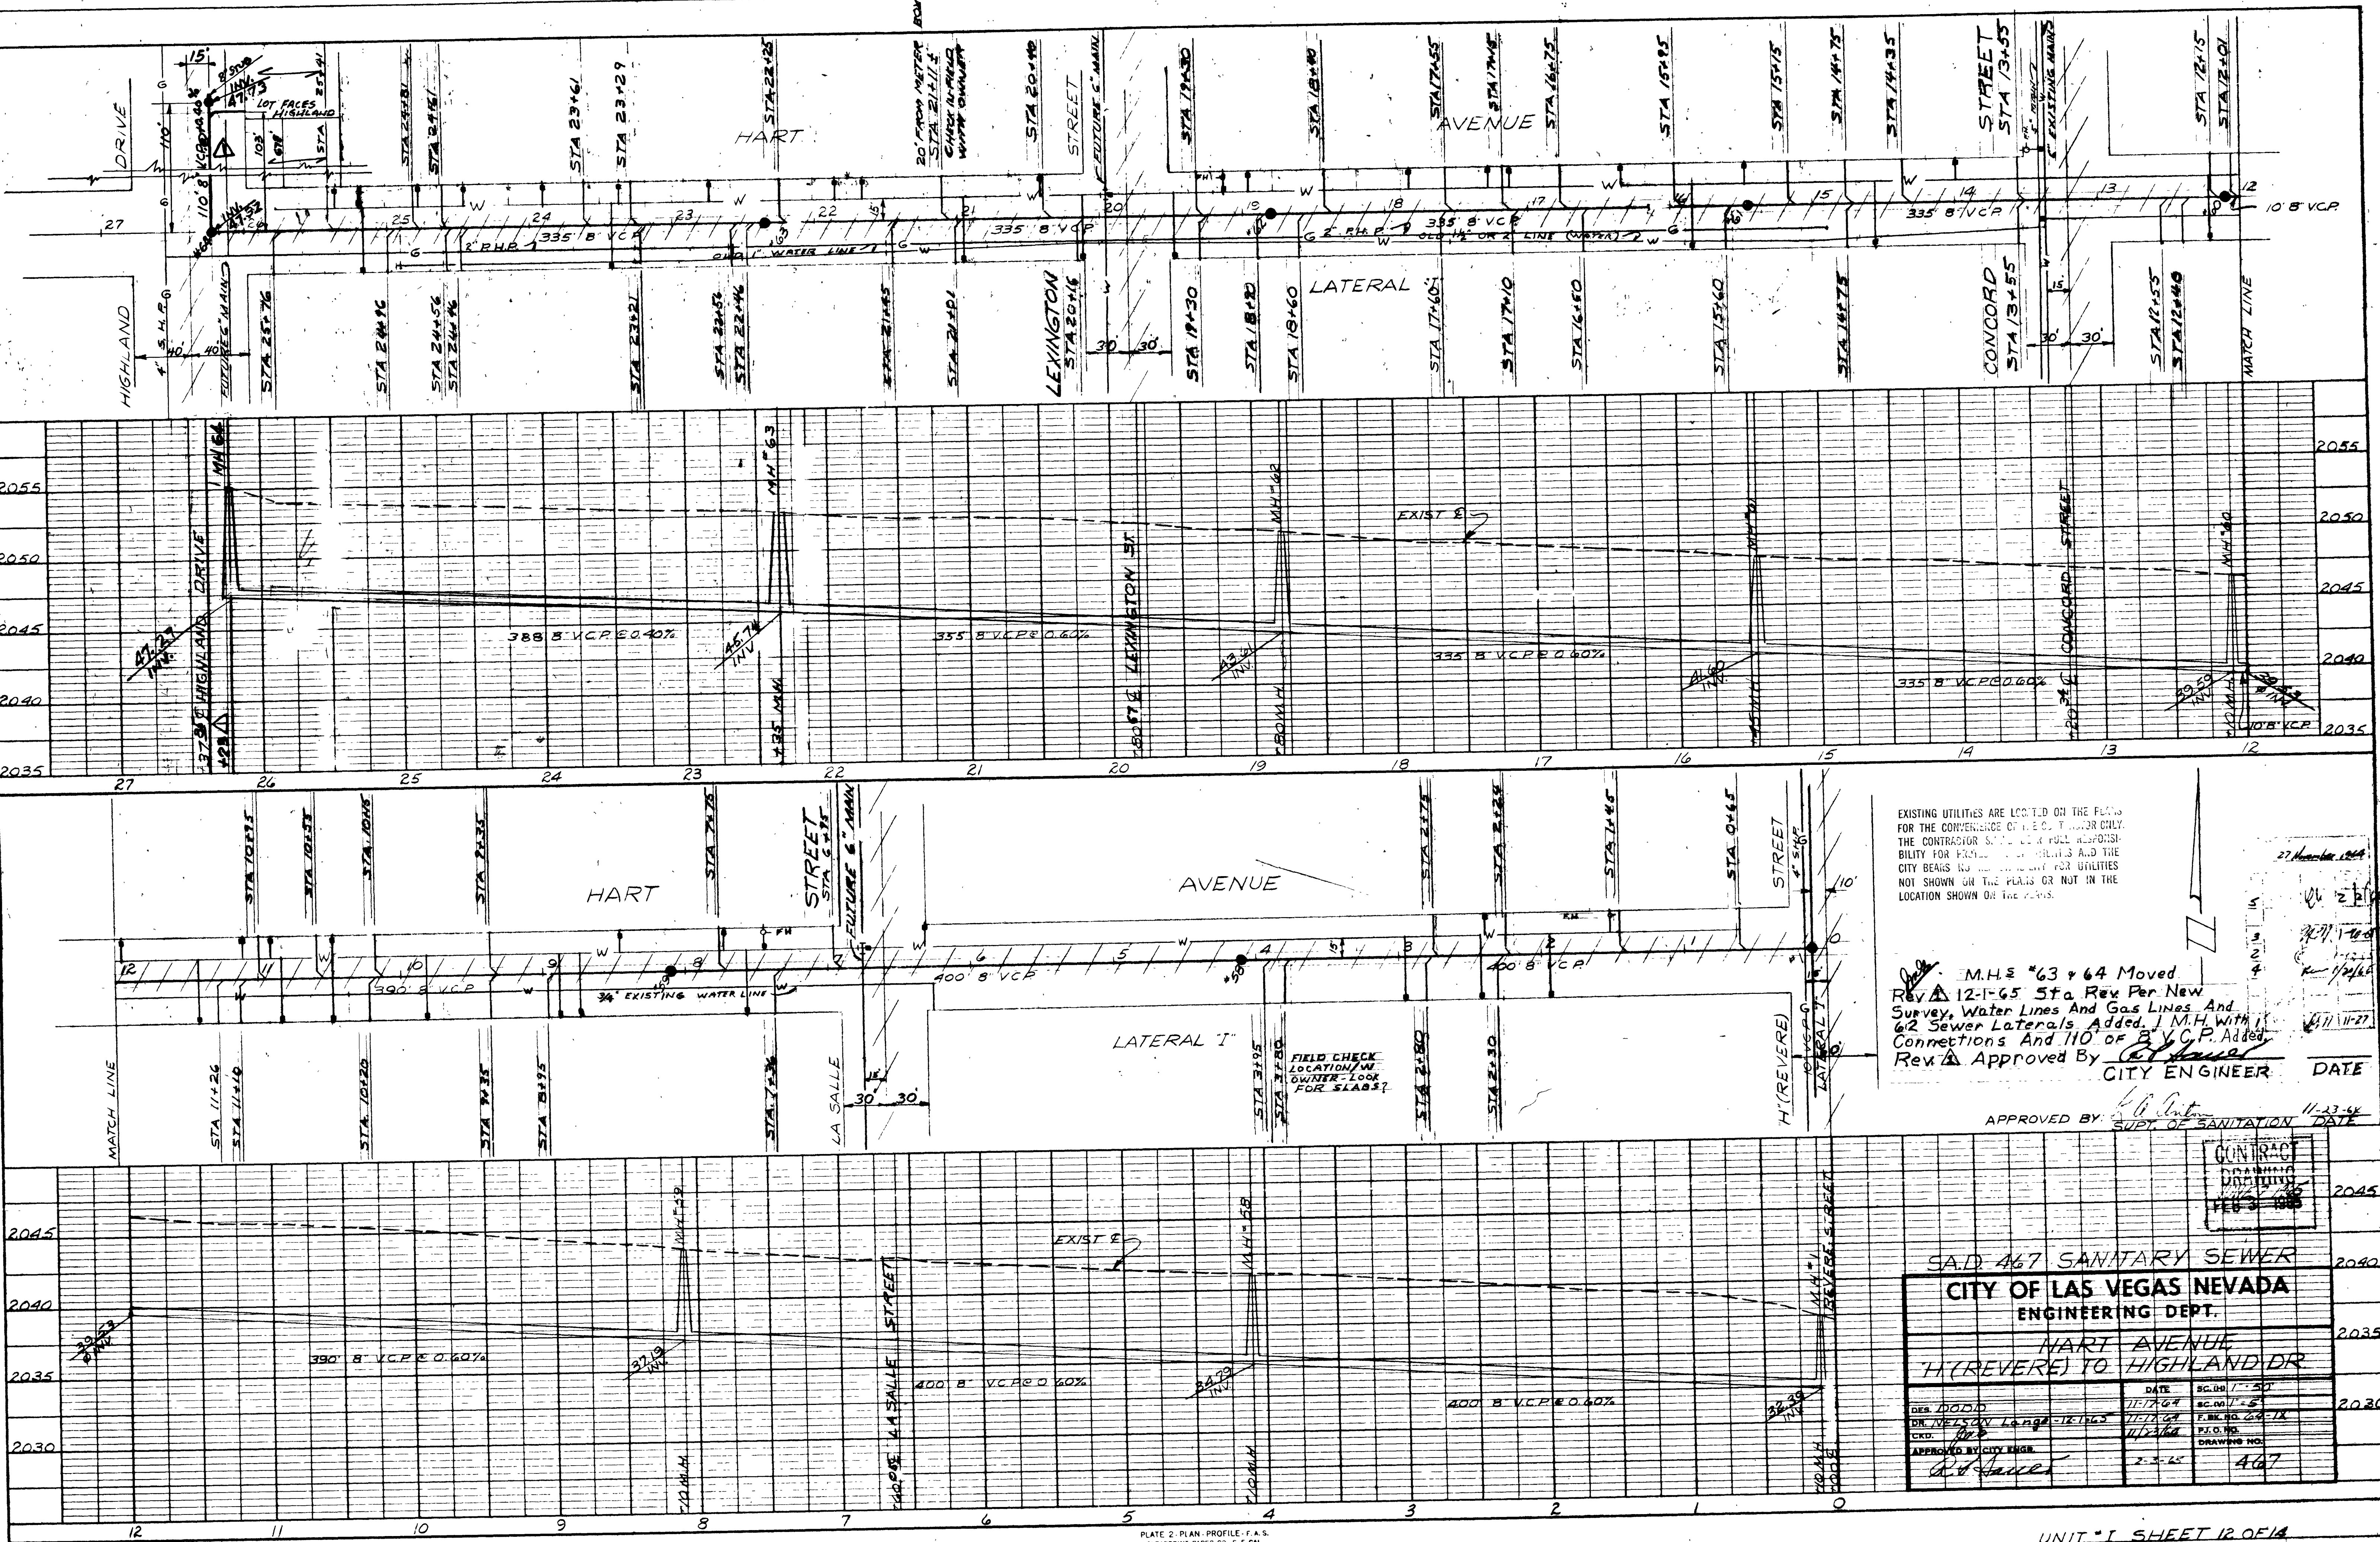

EXISTING UTILITIES ARE LOCATED ON THE PLANS FOR THE CONVENIENCE OF THE CONTRACTOR ONLY. THE CONTRACTOR SHALL BE FULLY RESPONSIBLE FOR THE LOCATION AND DEPTH OF ALL UTILITIES NOT SHOWN ON THE PLANS OR NOT IN THE LOCATION SHOWN ON THE PLANS.


M.H. 63 & 64 Moved
Rev. 12-1-45 Sta. Rev. Per New
Survey, Water Lines And Gas Lines And
62 Sewer Laterals Added, 1 M.H. with 1
Connections And 110' of B.V.C.P. Added
Rev. A Approved By *[Signature]* DATE 11-23-44
CITY ENGINEER

APPROVED BY: *[Signature]* DATE 11-23-44
Supt. of Sanitation

CONTRACTOR
DRAWING
NO. 467

SAD 467 SANITARY SEWER
CITY OF LAS VEGAS NEVADA
ENGINEERING DEPT.
HART AVENUE
H (REVERE) TO HIGHLAND DR

DATE 11-23-44
SCALE 1" = 20'
BY *[Signature]*
CHECKED *[Signature]*
APPROVED BY CITY ENGINEER *[Signature]*
DRAWING NO. 467

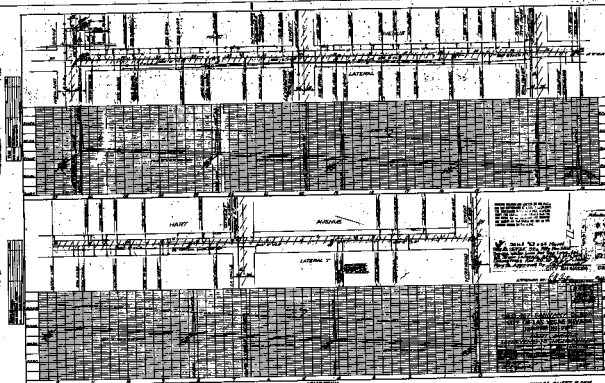



