

PLAN	DATE
	BY
NOTE BOOK	NO.
	NO.

PROFILE	DATE
	BY
NOTE BOOK	NO.
	NO.

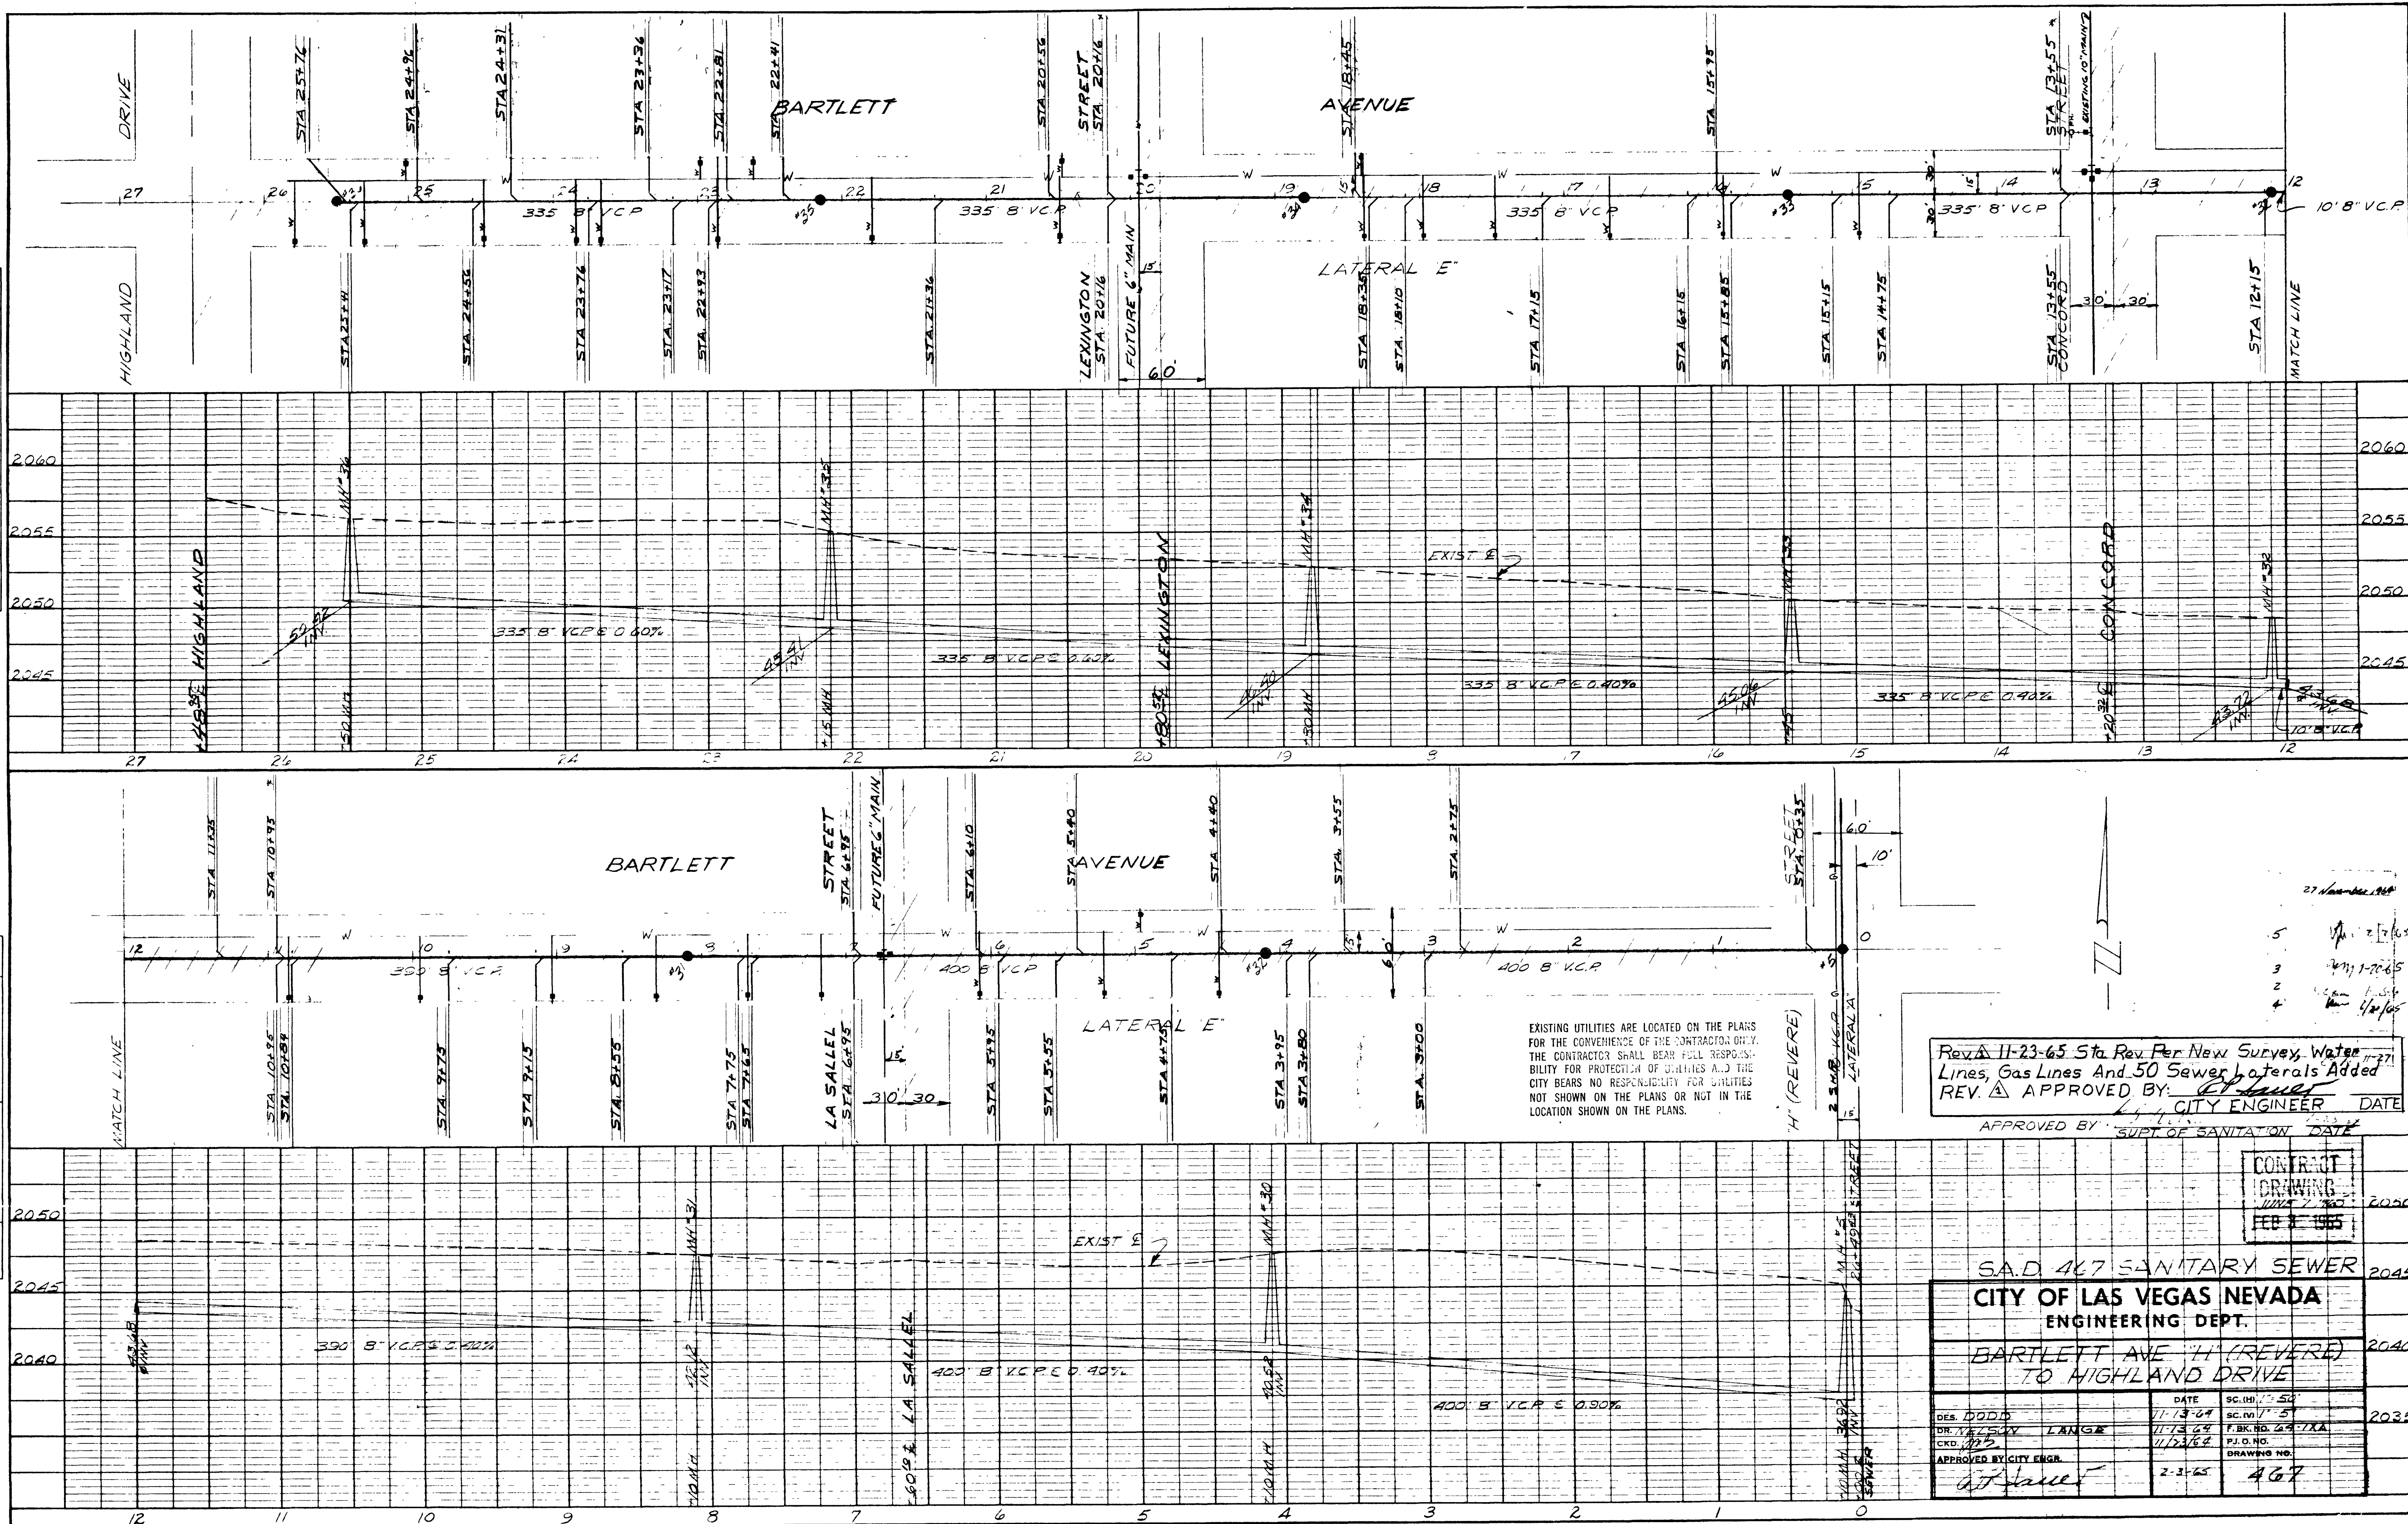


PLATE 2 PLAN PROFILE F.A. 2
1" = 40' HORIZ. 1" = 10' VERT.

UNIT 1 SHEET 8 OF 14

