

CHARLESTON BLVD.

BLDG. INFORMATION

1. TYPE OF CONSTRUCTION - TYPE V-1 HOUR
2. TOTAL SQUARE FOOTAGE - BLDG. 'A' - 7200 SF
 - BLDG. 'C' - 5488 SF
 - BLDG. 'D' - 6840 SF
 - BLDG. 'E' - 6692 SF
 - BLDG. 'M' - 1866 SF
3. NO. OF STORIES - 2 STORIES 'A', 'C', 'D' & 'E' BLDGS.
 - 1 STORY 'M'
4. USE - APARTMENTS
5. FIRE RESISTIVE RATINGS - 1 HOUR
6. NS - NON SPRINKLED


UTILITY QUANTITIES

WATER	
8" ACP	1451 L.F.
6"X3" FMCT	2 EACH (BY CONTRACTOR)
6" ACP	160 L.F.
6"X6"X6" TEE	
W/GATE VALVE	1 EACH
2" WATER SERVICE	1056 L.F.
1" WATER SERVICE	235 L.F.
FIRE HYDRANT	3 EACH
8"X6"X8" TEE	
W/GATE VALVE	4 EACH
8"X8" ELBOW	6 EACH
8"X6" REDUCER	2 EACH
8" GATE VALVE	4 EACH
3" PLASTIC MAIN	192 L.F.
SEWER	
60" STANDARD MANHOLE	1 EACH
48" STANDARD MANHOLE	3 EACH
8" PVC	1075 L.F.
6" PVC	232 L.F.
4" PVC	902 L.F.
CLEANOUTS	4 EACH

COUNTY OF CLARK
 FIRE DEPARTMENT
 APPROVED
 BY *Allen Nave (sp)* 12/16/87
 APPROVAL OF THESE PLANS SHALL NOT
 BE CONSTRUED TO BE A PERMIT FOR, OR
 AN APPROVAL OF, ANY VIOLATION OF
 ANY OF THE PROVISIONS OF THE STATE
 OR COUNTY LAWS. FIRE FLOW 2200
 GPM AT 20 P.S.I. RESIDUAL.

570
 CLV CITY ENGINEER
 DATE 3-18-88

NOTE: REFERENCE DRAWING SHEETS
 C3A & B SEWER PROFILE, SANTA FE
 APARTMENTS FOR ADDITIONAL INFO.
 MEA. ENGINEERS 3-8-88

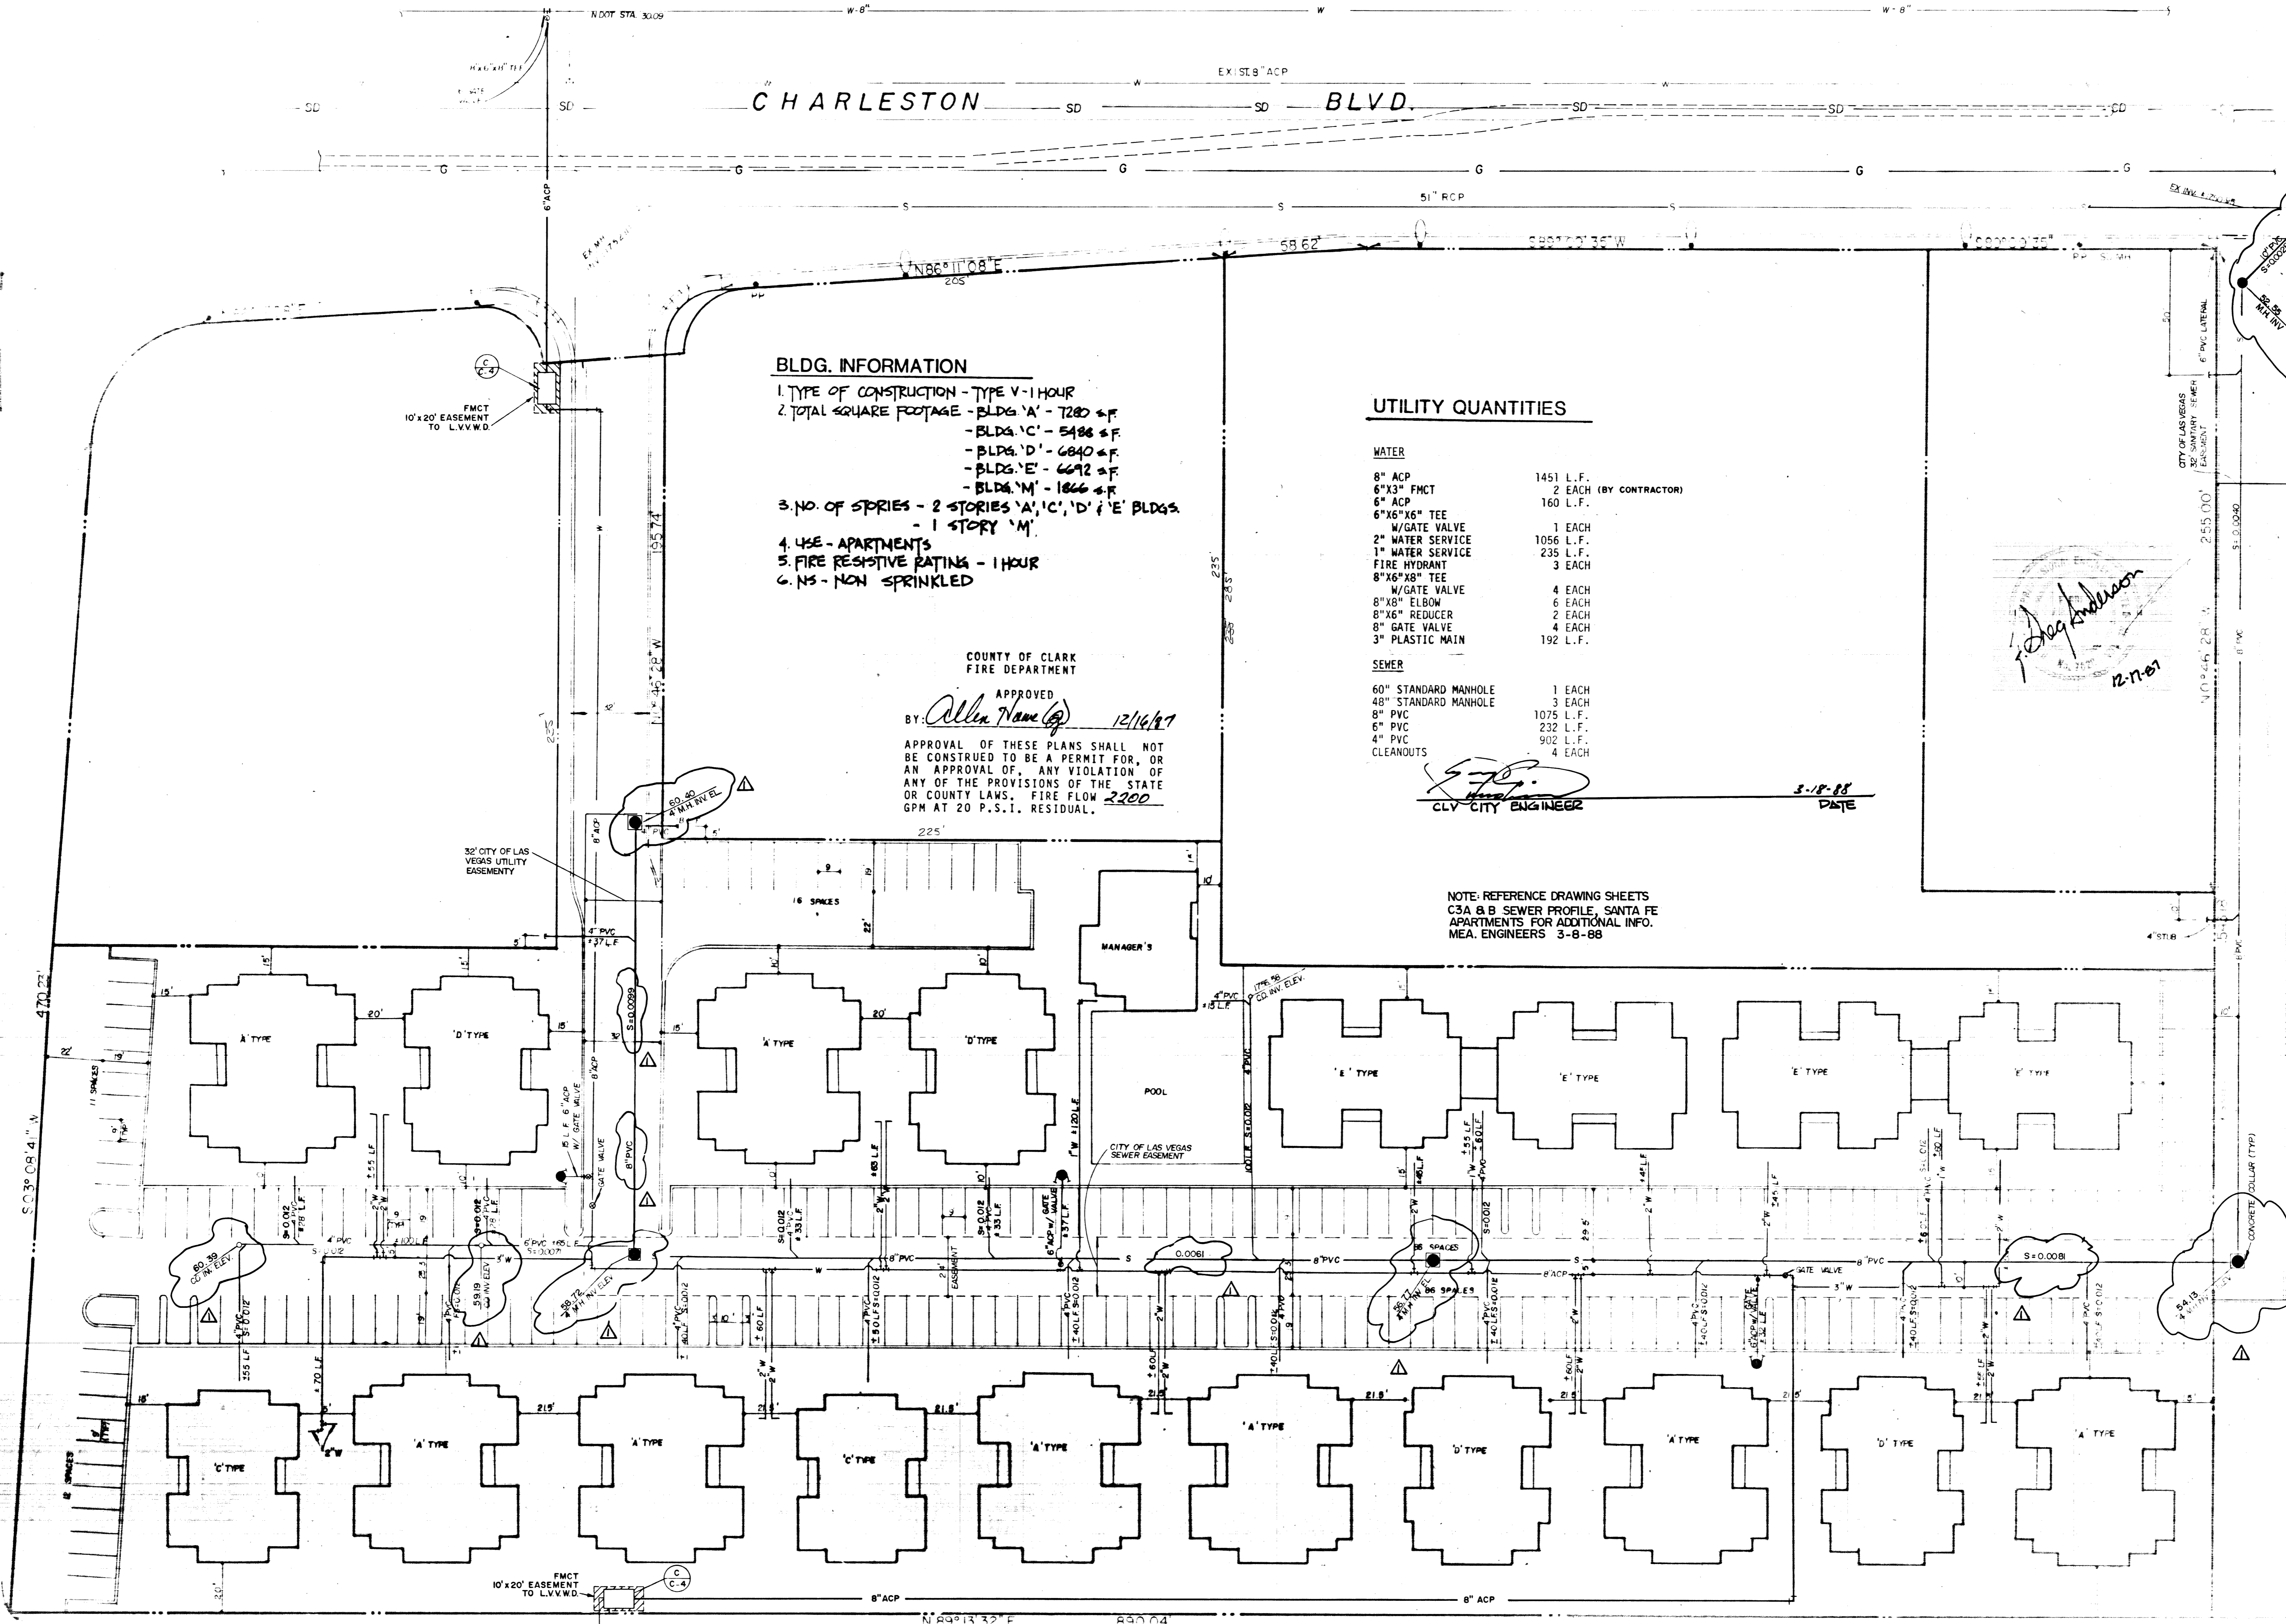

Richard Anderson
 12-17-87

MANING CONSTRUCTION

DATE RECEIVED 11/17/87

MEASUREMENTS
 L.A.S. 11/17/87

SANTA - FE
 APARTMENTS-EAST CHARLESTON
 UTILITIES

Nave & Allen 12/87

231-11
 307-V624