

DISCLAIMER NOTE:



UTILITY LOCATIONS SHOWN HEREON ARE APPROXIMATE ONLY. IT SHALL BE THE CONTRACTOR'S RESPONSIBILITY TO DETERMINE THE EXACT HORIZONTAL AND VERTICAL LOCATION OF ALL EXISTING UNDERGROUND OR OVERHEAD UTILITIES PRIOR TO COMMENCING CONSTRUCTION. NO REPRESENTATION IS MADE THAT ALL EXISTING UTILITIES ARE SHOWN HEREON. THE ENGINEER ASSUMES NO RESPONSIBILITY FOR UTILITIES NOT SHOWN OR UTILITIES NOT SHOWN IN THEIR PROPER LOCATION. CONTRACTOR TO NOTIFY ENGINEER OF ANY CHANGES OR DISCREPANCIES.

Call before you Dig
1-702-227-2929
Nevada Power
Environment and Safety
Services Department

Call before you Dig
1-800-227-2600
CLARK COUNTY TRAFFIC OPERATIONS
1-702-455-7544

NOTE

SEE SHEET P-3 FOR CENTERLINE DATA, CURB DATA AND UTILITY PROFILES.

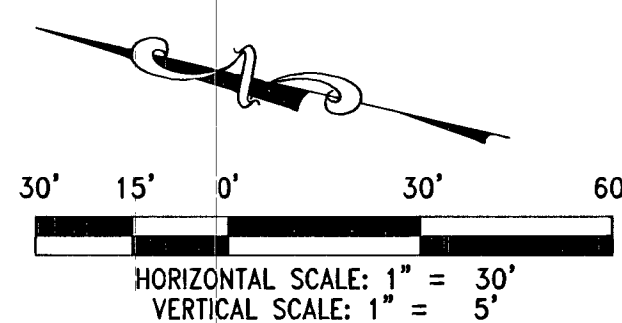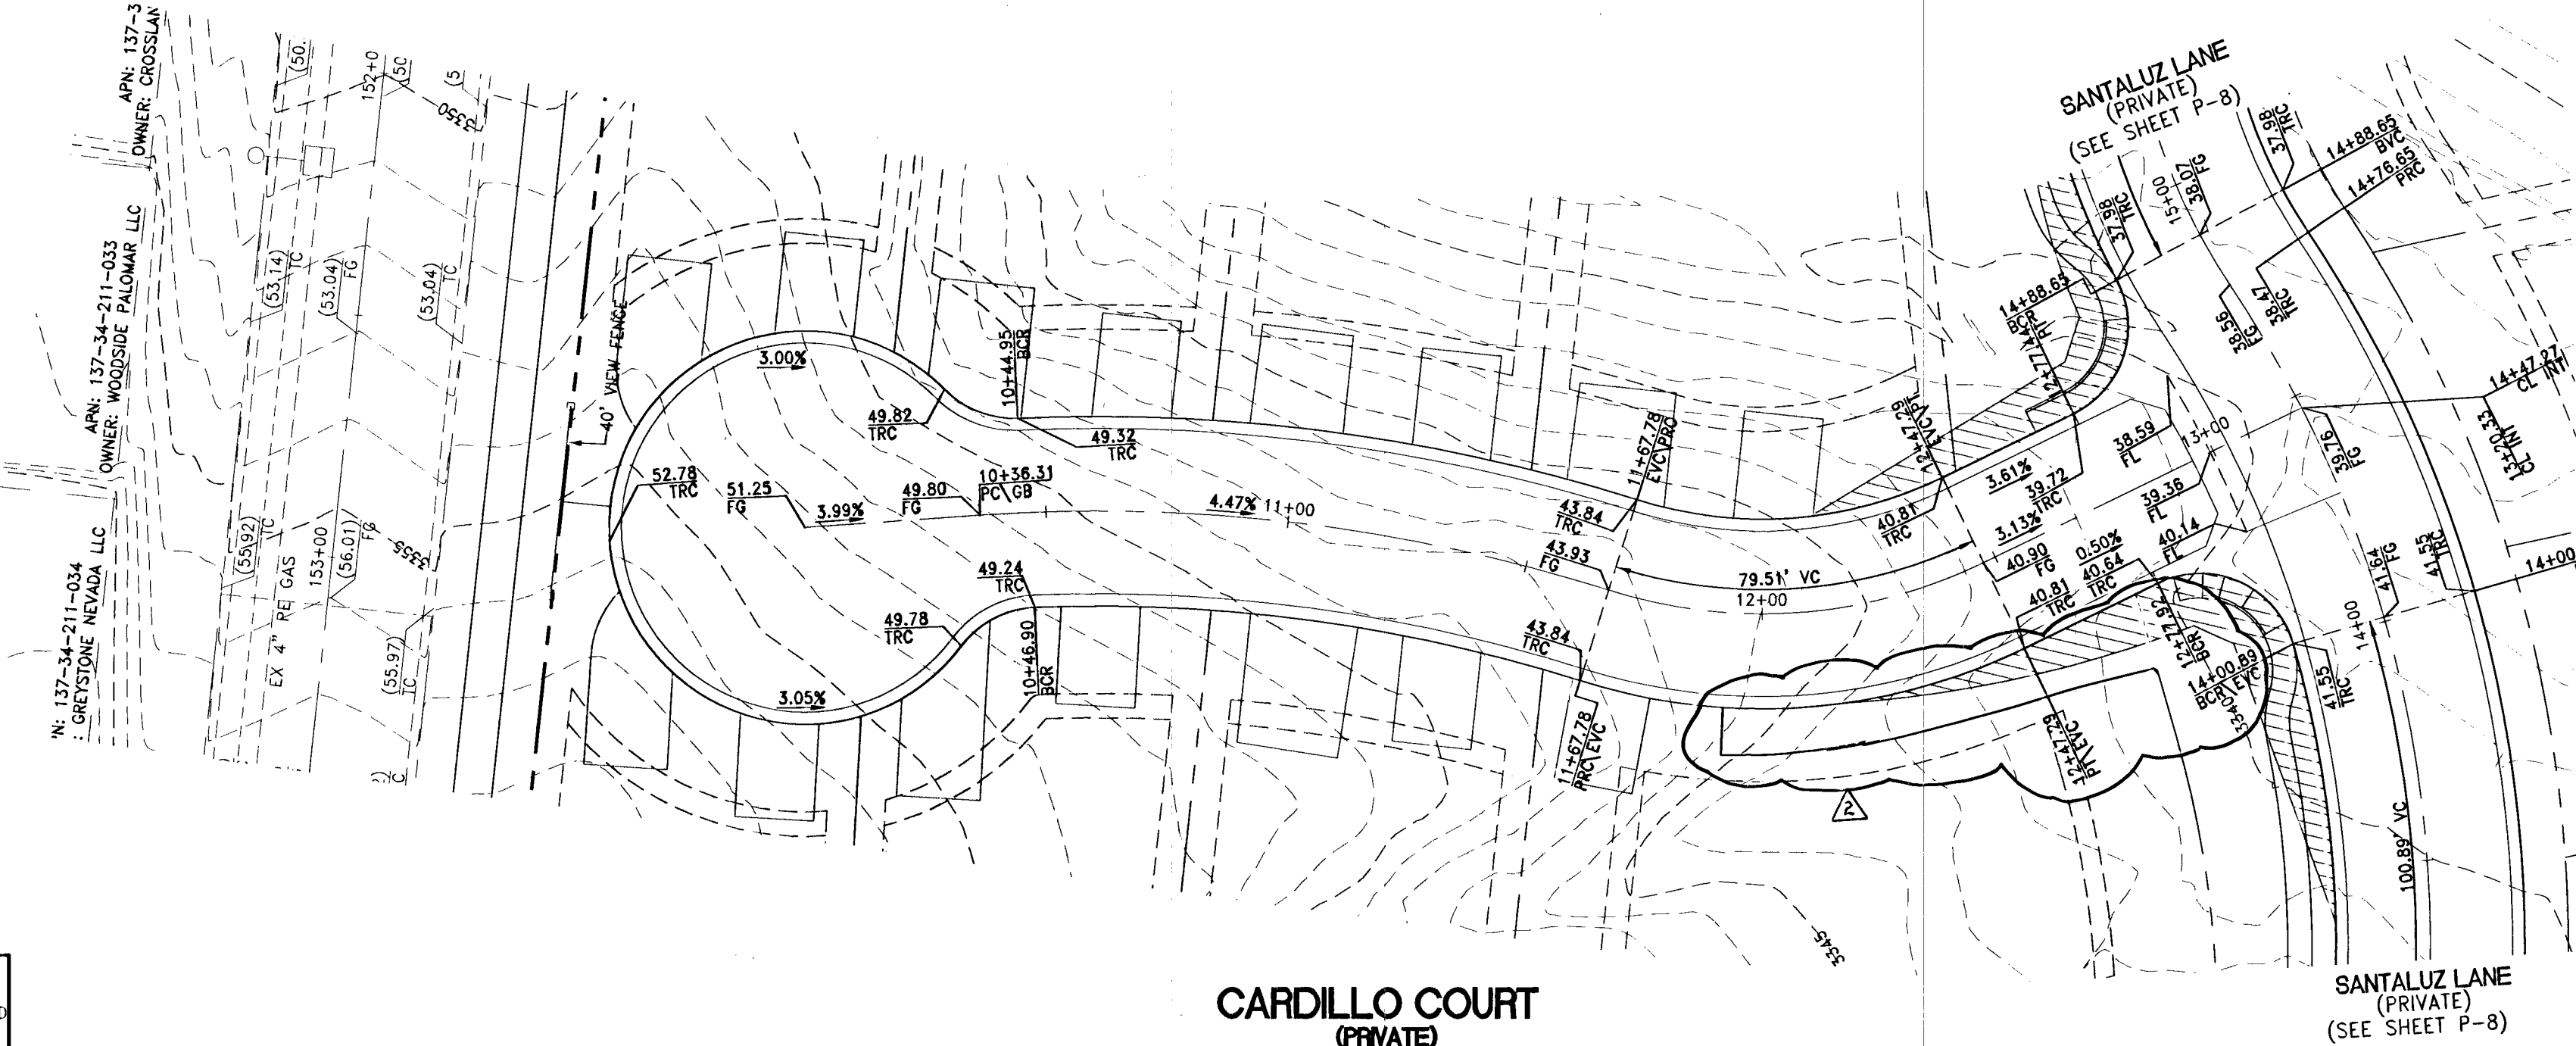



BENCHMARK

CITY OF LAS VEGAS BENCHMARK No. 7LV09 34C4
A RIVET AND PLATE IN THE TOP OF CURB AT THE NORTHEAST CORNER OF PASEO MIST DR AND DESERT MOON DR.

ELEVATION=997.024 METERS (NAVD'88)
ELEVATION=3271.07 US SURVEY FEET (NAVD'88)

BASIS OF BEARINGS

SOUTH 83°00'00" WEST BEING THE BEARING OF THE CENTERLINE OF PASEO BREEZE DRIVE AS SHOWN BY MAP THEREOF ON FILE IN THE CLARK COUNTY RECORDER'S OFFICE IN BOOK 121, PAGE 12 OF PLATS

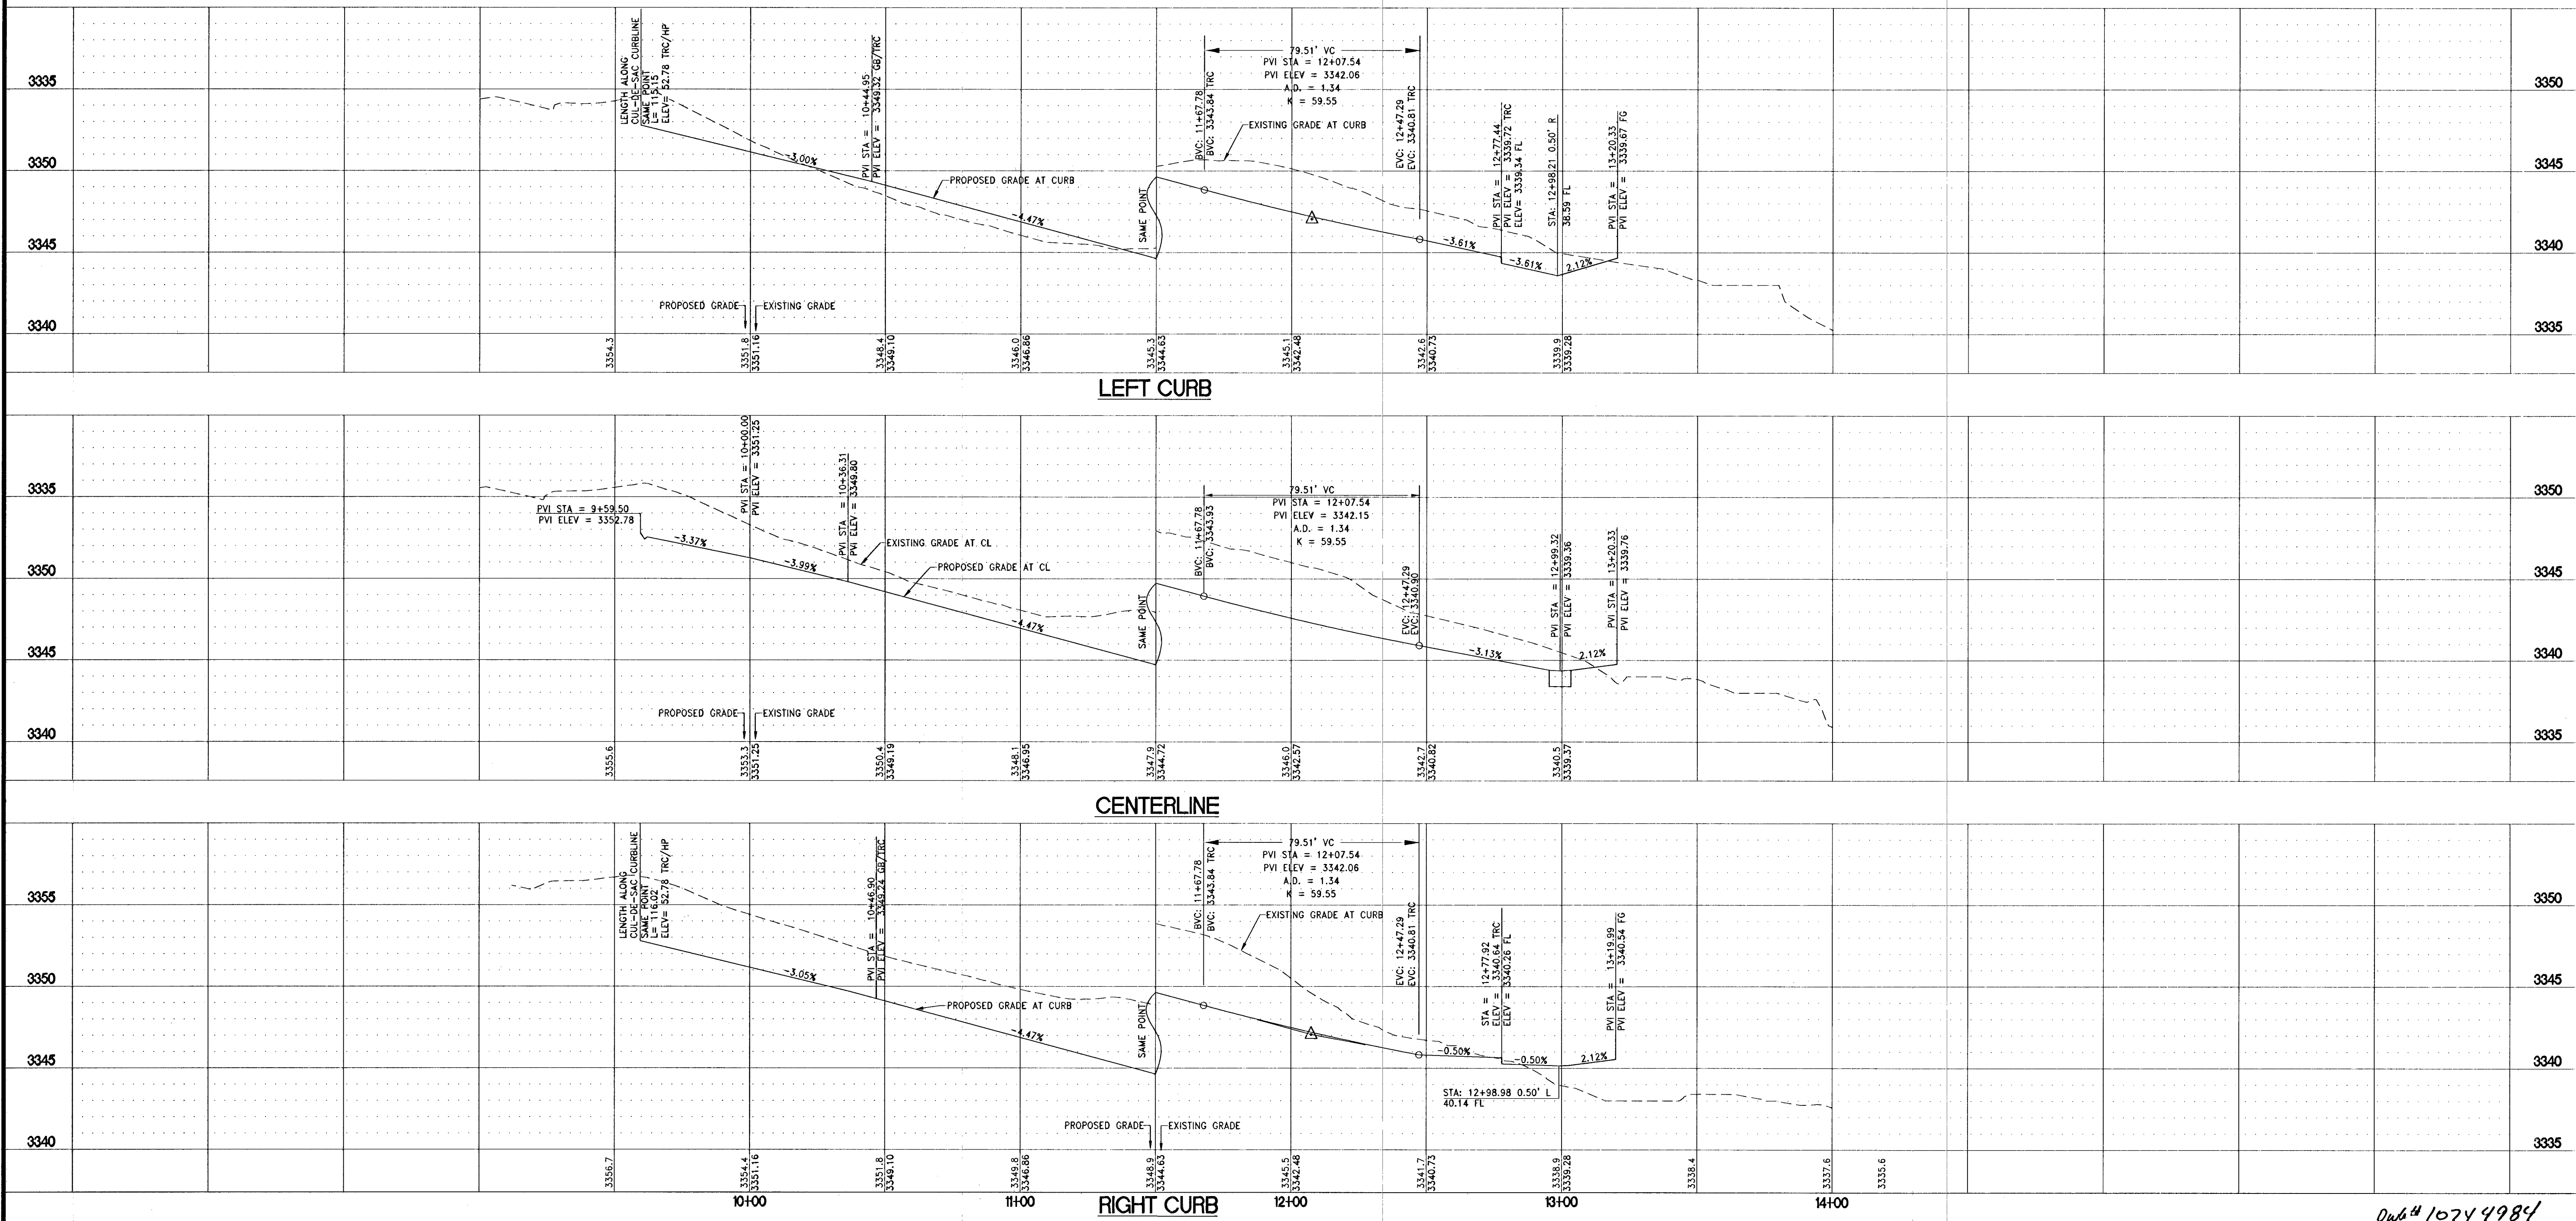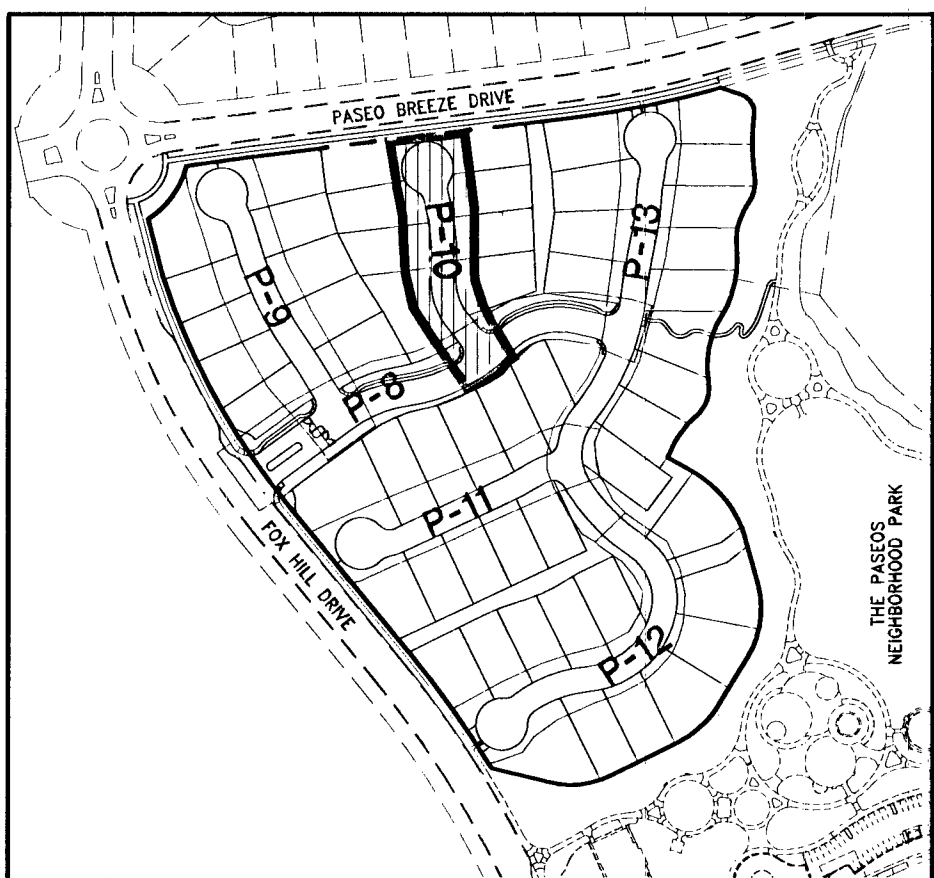

REV	DESCRIPTION	BY	APPD	DATE
1	REVISE CE-3 AREA	JL		4/22/2013

DATE: April 22, 2013
HORIZ. SCALE: 1"=30'
VERT. SCALE: 1"=5'
DRAWN BY: JIL
DESIGNED BY: JIL
CHECKED BY: JIL
APPROVED BY: JIL
PROJECT #: 3110.0013

TOLL BROTHERS INC.
1140 TOWN CENTER DRIVE SUITE 250
LAS VEGAS, NV 89144
PHONE: 702-245-8800 FAX: 702-245-8610
PHOTO: 453.8800 FAX: 702-245-8801

RCI Engineering
3281 South Highland Drive Suite 200, Las Vegas, NV 89109
PHONE: 702-453-8800 FAX: 702-245-8801

NEVADA

SANTALUZ AT SUMMERLIN VILLAGE 23A
PARCELS ES-1 AND WS-1
PLAN AND PROFILE
CARDILLO COURT

CITY OF LAS VEGAS
4/22/13 4:58pm

PROFESSIONAL ENGINEER
JOHN I. LAND
Exp. 12/31/2013
No. 16441

4/22/2013

P-10
SHT 20 OF 39
CLV PROJECT NUMBER
48157

0464 1074 9984