


MONUMENT TIE MAP OF
SANTALUZ AT SUMMERLIN VILLAGE 23A
A COMMON INTEREST COMMUNITY

AS SHOWN ON THAT CERTAIN MAP ON FILE IN THE CLARK COUNTY RECORDER'S OFFICE IN BOOK 145, PAGE 52 OF PLATS,
SITUATE IN THE WEST HALF (W 1/2) OF SECTION 34, TOWNSHIP 20 SOUTH, RANGE 59 EAST, M.D.M.,
CITY OF LAS VEGAS, CLARK COUNTY, NEVADA.

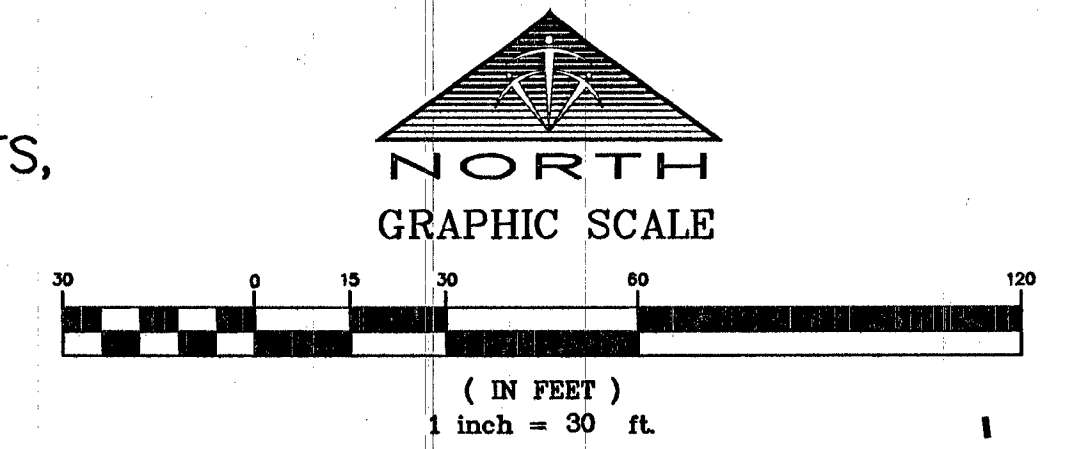

LINE TABLE		
LINE	BEARING	LENGTH
L1	S36°34'16"E	28.65'
L2	N17°03'43"W	36.31'
L3	N14°16'30"W	11.55'
L4	N38°55'45"W	73.04'
L5	N39°28'40"W	297.24'
L6	N83°00'00"E	734.40'

RADIAL LINE TABLE			
RADIAL	BEARING	RADIAL	BEARING
R1	S74°32'55"W	R12	S14°51'19"W
R2	S71°13'31"W	R13	S33°12'08"E
R3	N54°06'43"E	R14	N12°11'52"W
R4	N85°32'25"W	R15	S83°35'02"W
R5	N77°35'57"W	R16	S74°23'49"E
R6	S87°38'59"E	R17	N50°29'40"W
R7	N77°14'43"W	R18	S57°47'20"W
R8	S83°18'28"E	R19	N33°12'14"E
R9	N31°38'17"W	R20	S78°00'13"E
R10	N06°51'33"W	R21	N05°09'36"W
R11	S40°02'56"E	R22	N49°37'36"W

CURVE TABLE				
CURVE	DELTA	RADIUS	LENGTH	TANGENT
C1	21°07'11"	100.00'	36.86'	18.64'
C2	3°19'24"	885.00'	51.33'	25.67'
C3	4°15'00"	500.00'	37.09'	18.55'
C4	26°40'33"	100.00'	46.56'	23.71'
C5	10°03'02"	250.00'	43.85'	21.98'
C6	10°24'16"	250.00'	45.40'	22.76'
C7	6°03'45"	1000.00'	105.81'	52.96'
C8	29°16'31"	250.00'	127.74'	65.30'
C9	4°29'46"	250.00'	19.62'	9.81'
C10	24°46'44"	250.00'	108.12'	54.92'
C11	40°03'42"	245.00'	171.31'	89.32'
C12	33°11'23"	245.00'	141.92'	73.01'
C13	6°52'19"	245.00'	29.38'	14.71'
C14	43°23'20"	105.00'	79.51'	41.77'
C15	59°45'00"	125.00'	130.35'	71.81'
C16	40°03'38"	89.50'	62.58'	32.63'
C17	7°59'48"	200.00'	27.91'	13.98'
C18	21°00'16"	200.00'	73.32'	37.08'
C19	8°54'39"	350.00'	54.43'	27.27'
C20	71°43'01"	95.00'	118.91'	68.66'
C21	45°55'18"	95.00'	76.14'	40.25'
C22	25°47'42"	95.00'	42.77'	21.75'
C23	24°35'05"	300.00'	128.73'	65.37'
C24	68°47'32"	100.00'	120.07'	68.46'
C25	72°50'38"	133.00'	169.09'	98.13'
C26	44°28'00"	200.00'	155.22'	81.75'
C27	29°05'34"	1150.00'	583.93'	298.40'
C28	3°20'37"	1150.00'	67.11'	33.56'


LEGEND

- BOUNDARY LINE
- - - ASSESSOR'S PARCEL LINE
- - - RIGHT-OF-WAY LINE
- - - STREET CENTERLINE
- 50.00' REFERENCE MONUMENT DISTANCE
- - - MATCH LINE
- FOUND MONUMENT AS DESCRIBED
- SET TYPE III MONUMENT
STAMPED "PLS 17449"
PER BOOK 145, PAGE 52 OF PLATS
- SET TYPE IV-A REFERENCE MONUMENT
STAMPED "PLS 17449"
PER BOOK 145, PAGE 52 OF PLATS

**TRI-CORE
SURVEYING, LLC**


6761 WEST CHARLESTON BLVD.
LAS VEGAS, NEVADA 89146
TEL (702) 821-1554 FAX (702) 870-4378

JOB# 20712.0009

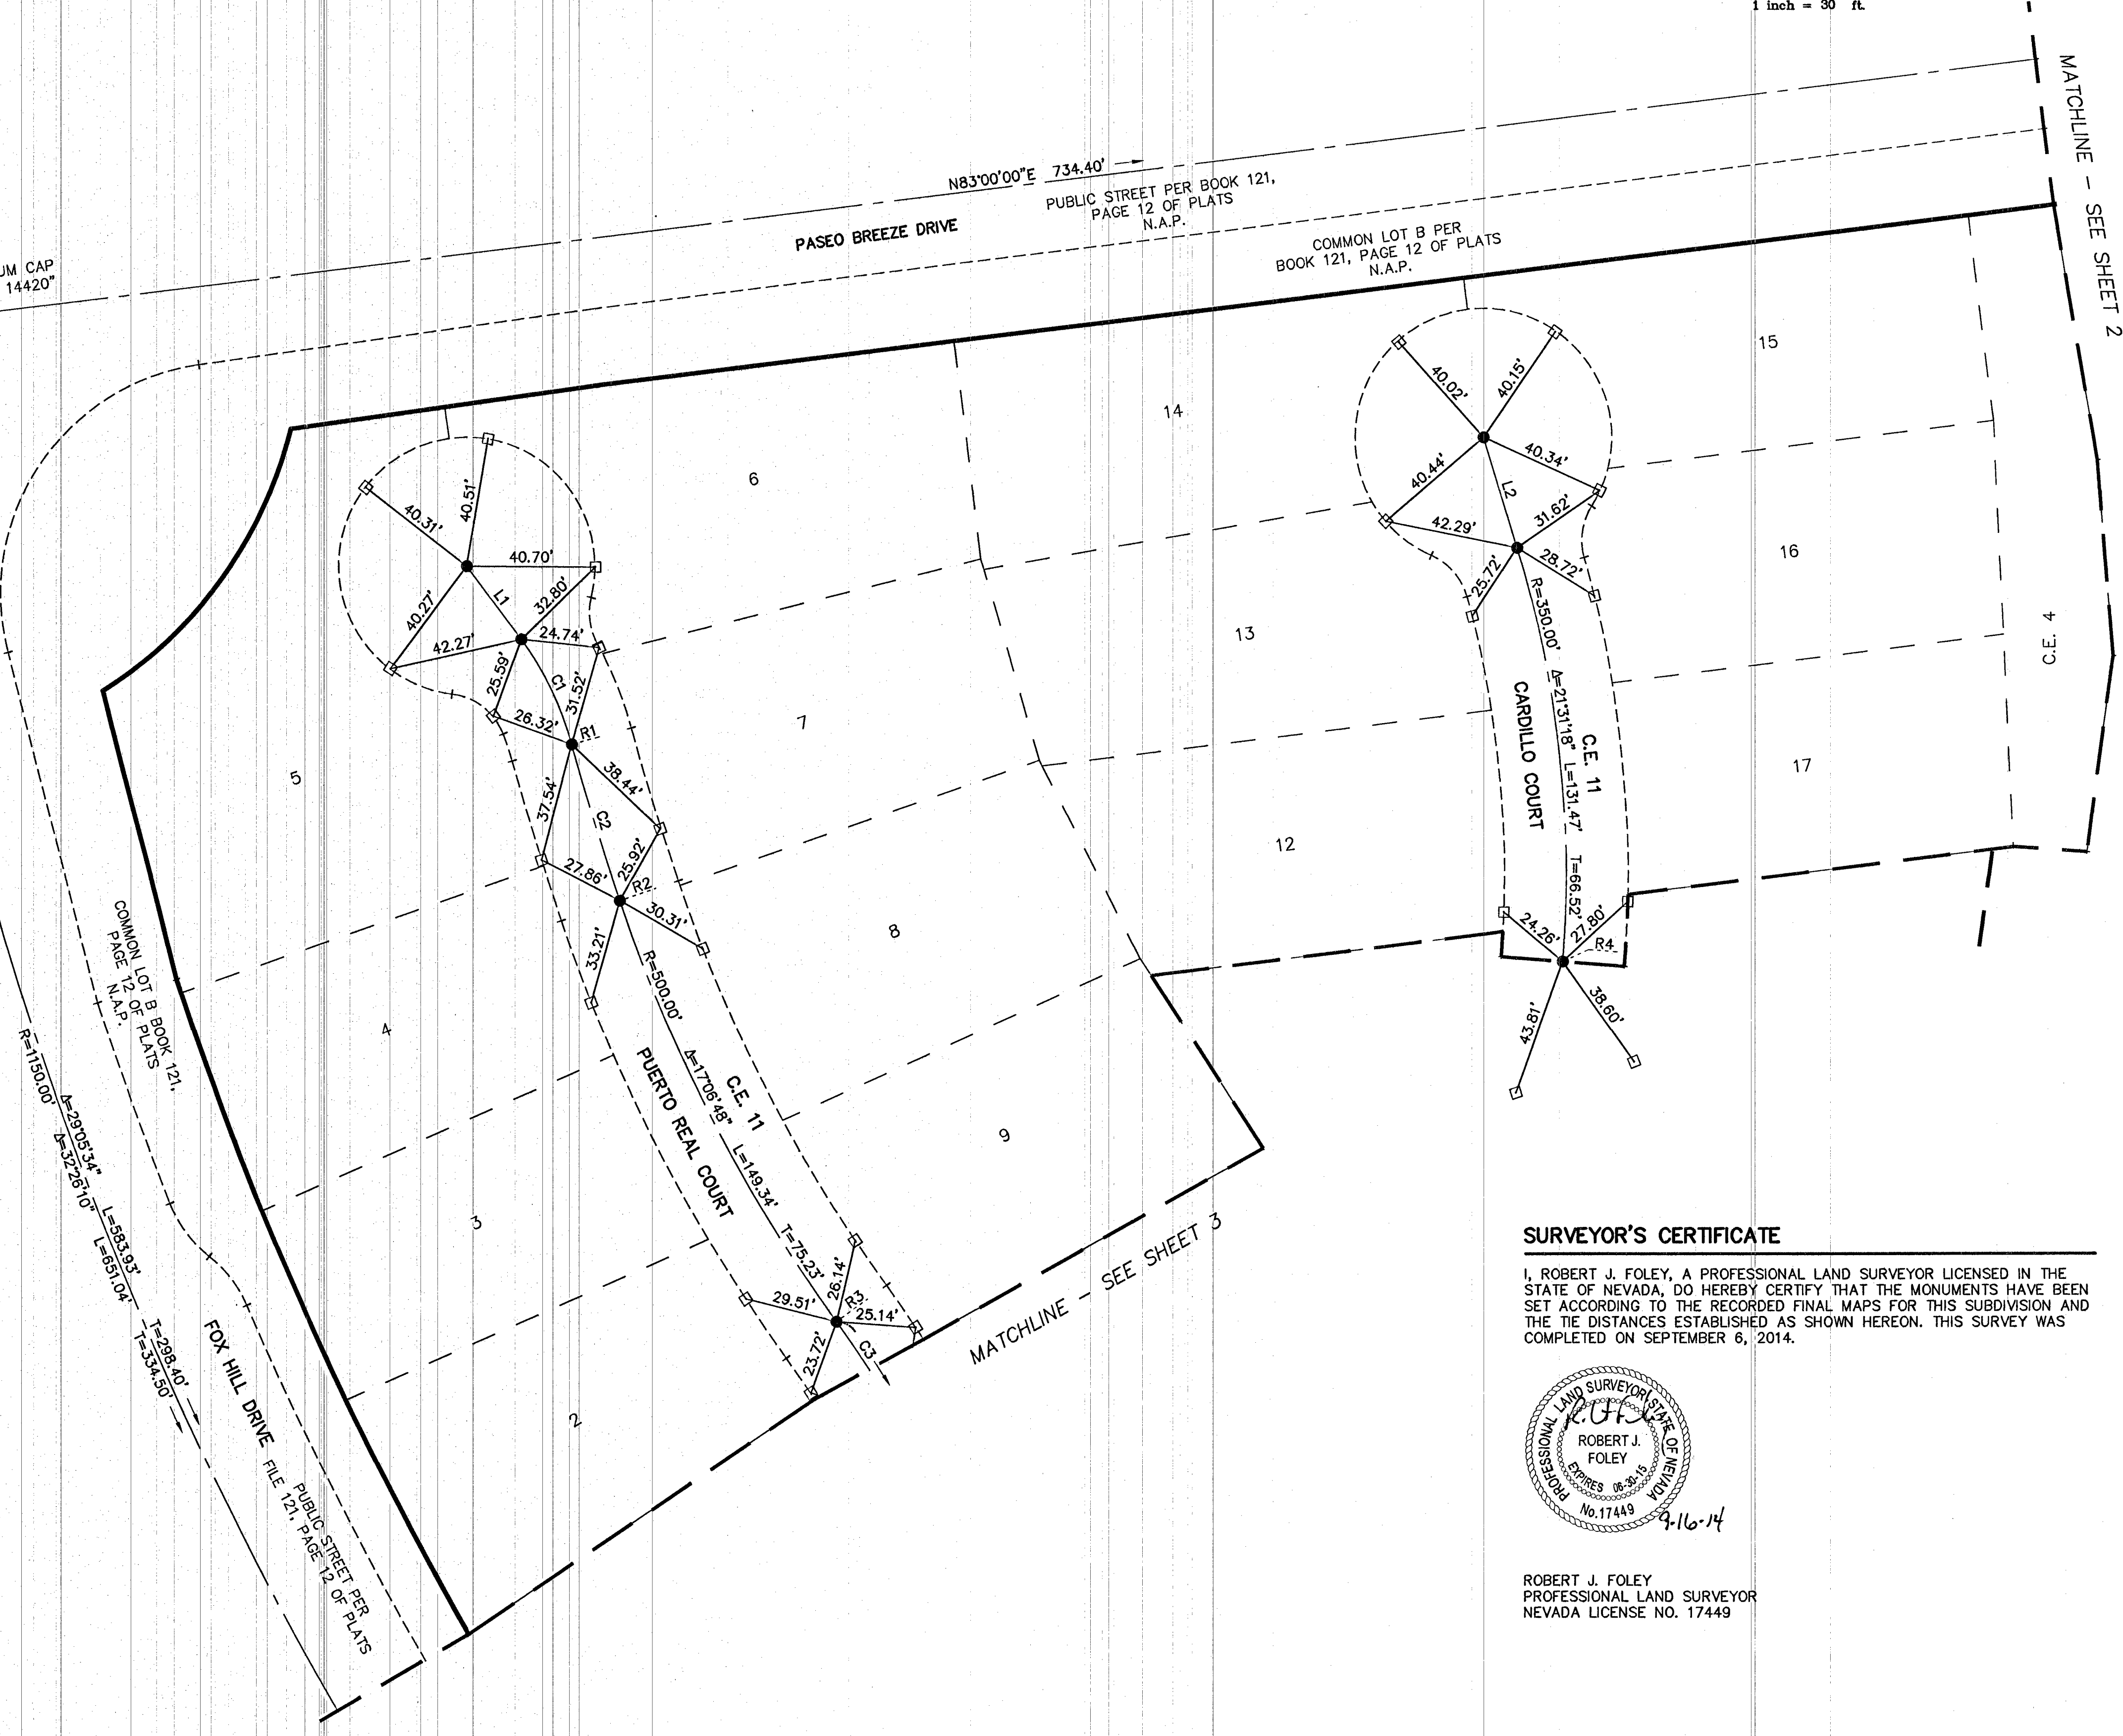

SURVEYOR'S CERTIFICATE

I, ROBERT J. FOLEY, A PROFESSIONAL LAND SURVEYOR LICENSED IN THE STATE OF NEVADA, DO HEREBY CERTIFY THAT THE MONUMENTS HAVE BEEN SET ACCORDING TO THE RECORDED FINAL MAPS FOR THIS SUBDIVISION AND THE TIE DISTANCES ESTABLISHED AS SHOWN HEREON. THIS SURVEY WAS COMPLETED ON SEPTEMBER 6, 2014.

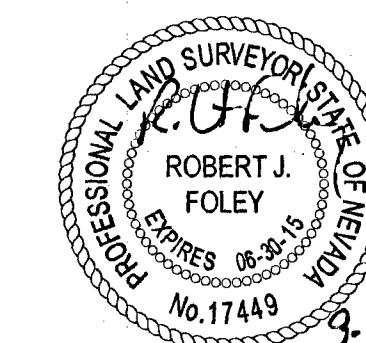

ROBERT J. FOLEY
PROFESSIONAL LAND SURVEYOR
NEVADA LICENSE NO. 17449

058-4984

SHEET 1 OF 5

BOOK 145, PAGE 52 OF PLATS (FMP 48324)

#48157