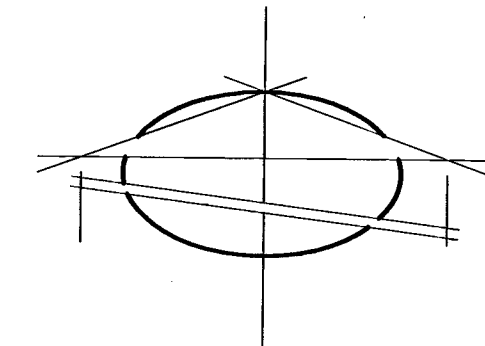
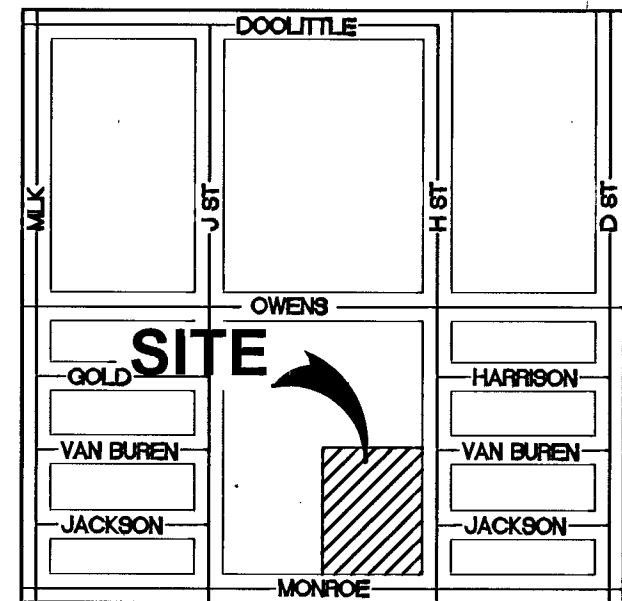
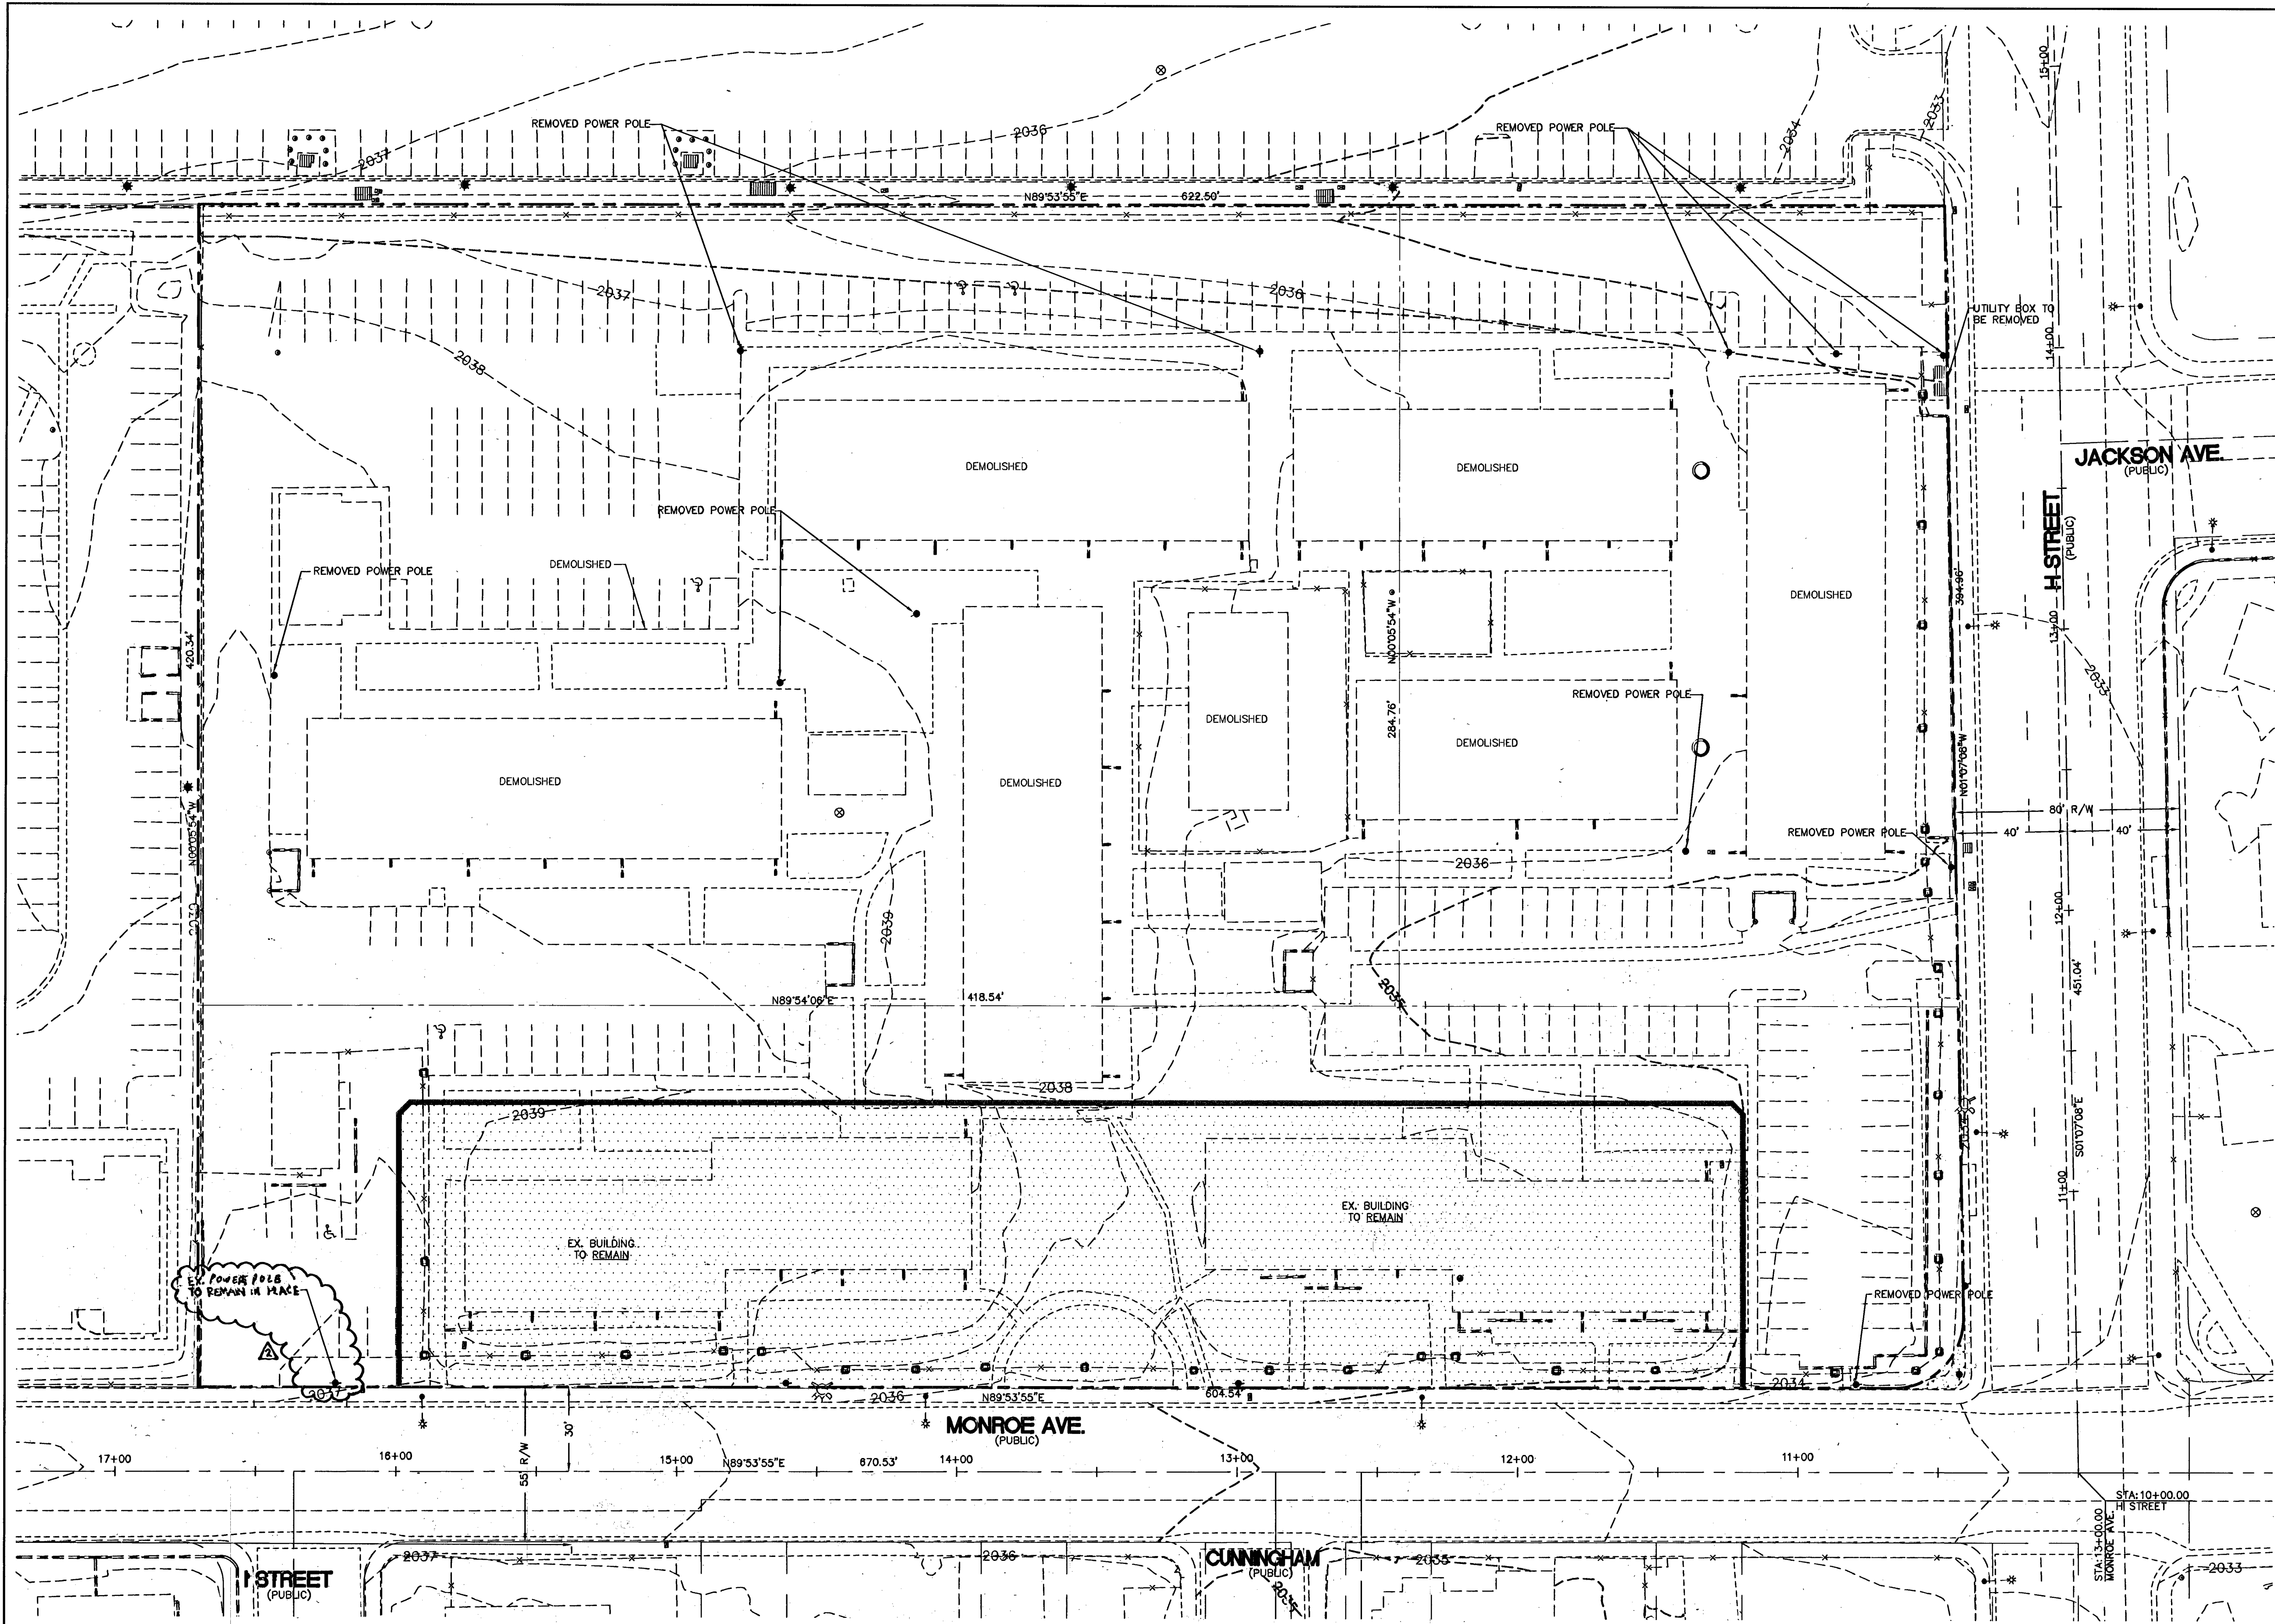


LEGEND


- PROPERTY LINE
- STREET CENTERLINE
- LOT LINE
- PROPOSED "L" CURB & GUTTER
- EXISTING "L" CURB & GUTTER
- PROPOSED "A" CURB & GUTTER
- EXISTING CONTOUR LINES
- EXISTING SCREEN/RETAINING WALL
- PROPOSED FLOW LINE
- EXIST. EDGE OF PAVEMENT
- EX. STRUCTURES TO REMAIN
- REMOVED POWER POLE
- REMOVED ON-SITE LIGHTING
- REMOVED MANHOLE

NOTE:

REMOVE AND RETURN STLT POLE TO CITY OF LAS VEGAS YARD AT 3104 E. BONANZA RD. CALL 24 HOURS BEFORE RETURNING AT 229-6331



DISCLAIMER NOTE

UTILITY LOCATIONS SHOWN HEREON ARE APPROXIMATE ONLY. IT SHALL BE THE CONTRACTOR'S RESPONSIBILITY TO DETERMINE THE EXACT HORIZONTAL AND VERTICAL LOCATION OF ALL EXISTING UNDERGROUND AND OVERHEAD UTILITIES PRIOR TO COMMENCING CONSTRUCTION. NO REPRESENTATION IS MADE THAT ALL EXISTING UTILITIES ARE SHOWN HEREON. THE ENGINEER ASSUMES NO RESPONSIBILITY FOR UTILITIES NOT SHOWN OR UTILITIES NOT SHOWN IN THEIR PROPER LOCATION.

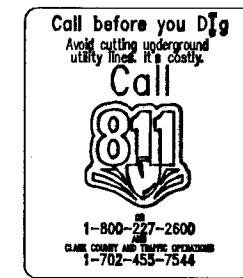

H#28975CLV#

107V5134

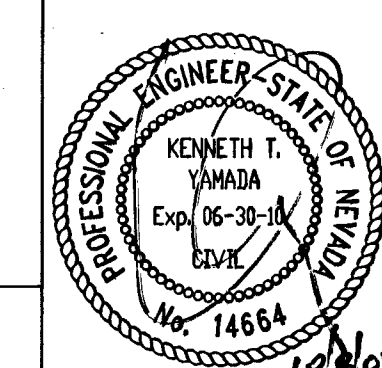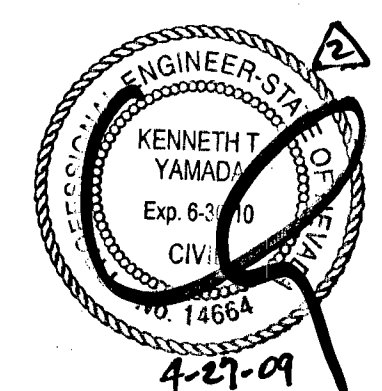

DATE: OCTOBER 2008
DESIGN: MV
DRAWN: OR
CHECK: KTY
SCALE: 1:30

BAUGHMAN & TURNER, INC.
CIVIL ENGINEERS
1210 HINSON STREET
LAS VEGAS, NEVADA 89102
PHONE: (702) 870-8771
FAX: (702) 878-2695

**SARANN KNIGHT
DEMOLITION PLAN**

SECTION 28, TOWNSHIP 20 SOUTH, RANGE 61 EAST, M.D.B. & M.
CITY OF LAS VEGA

H STREET & MONROE AVE.

SHEET
DM1
OF
3 of 10

PROJ. NO.
CDDP-SARANN KNIGHT

N:\CDDP\Sarann Knight\dwg\IMP\DWG\SARANN-07\DEMO.dwg, 10/8/2008 9:51:14 AM, HP DesignJet 1050C by HP pc3