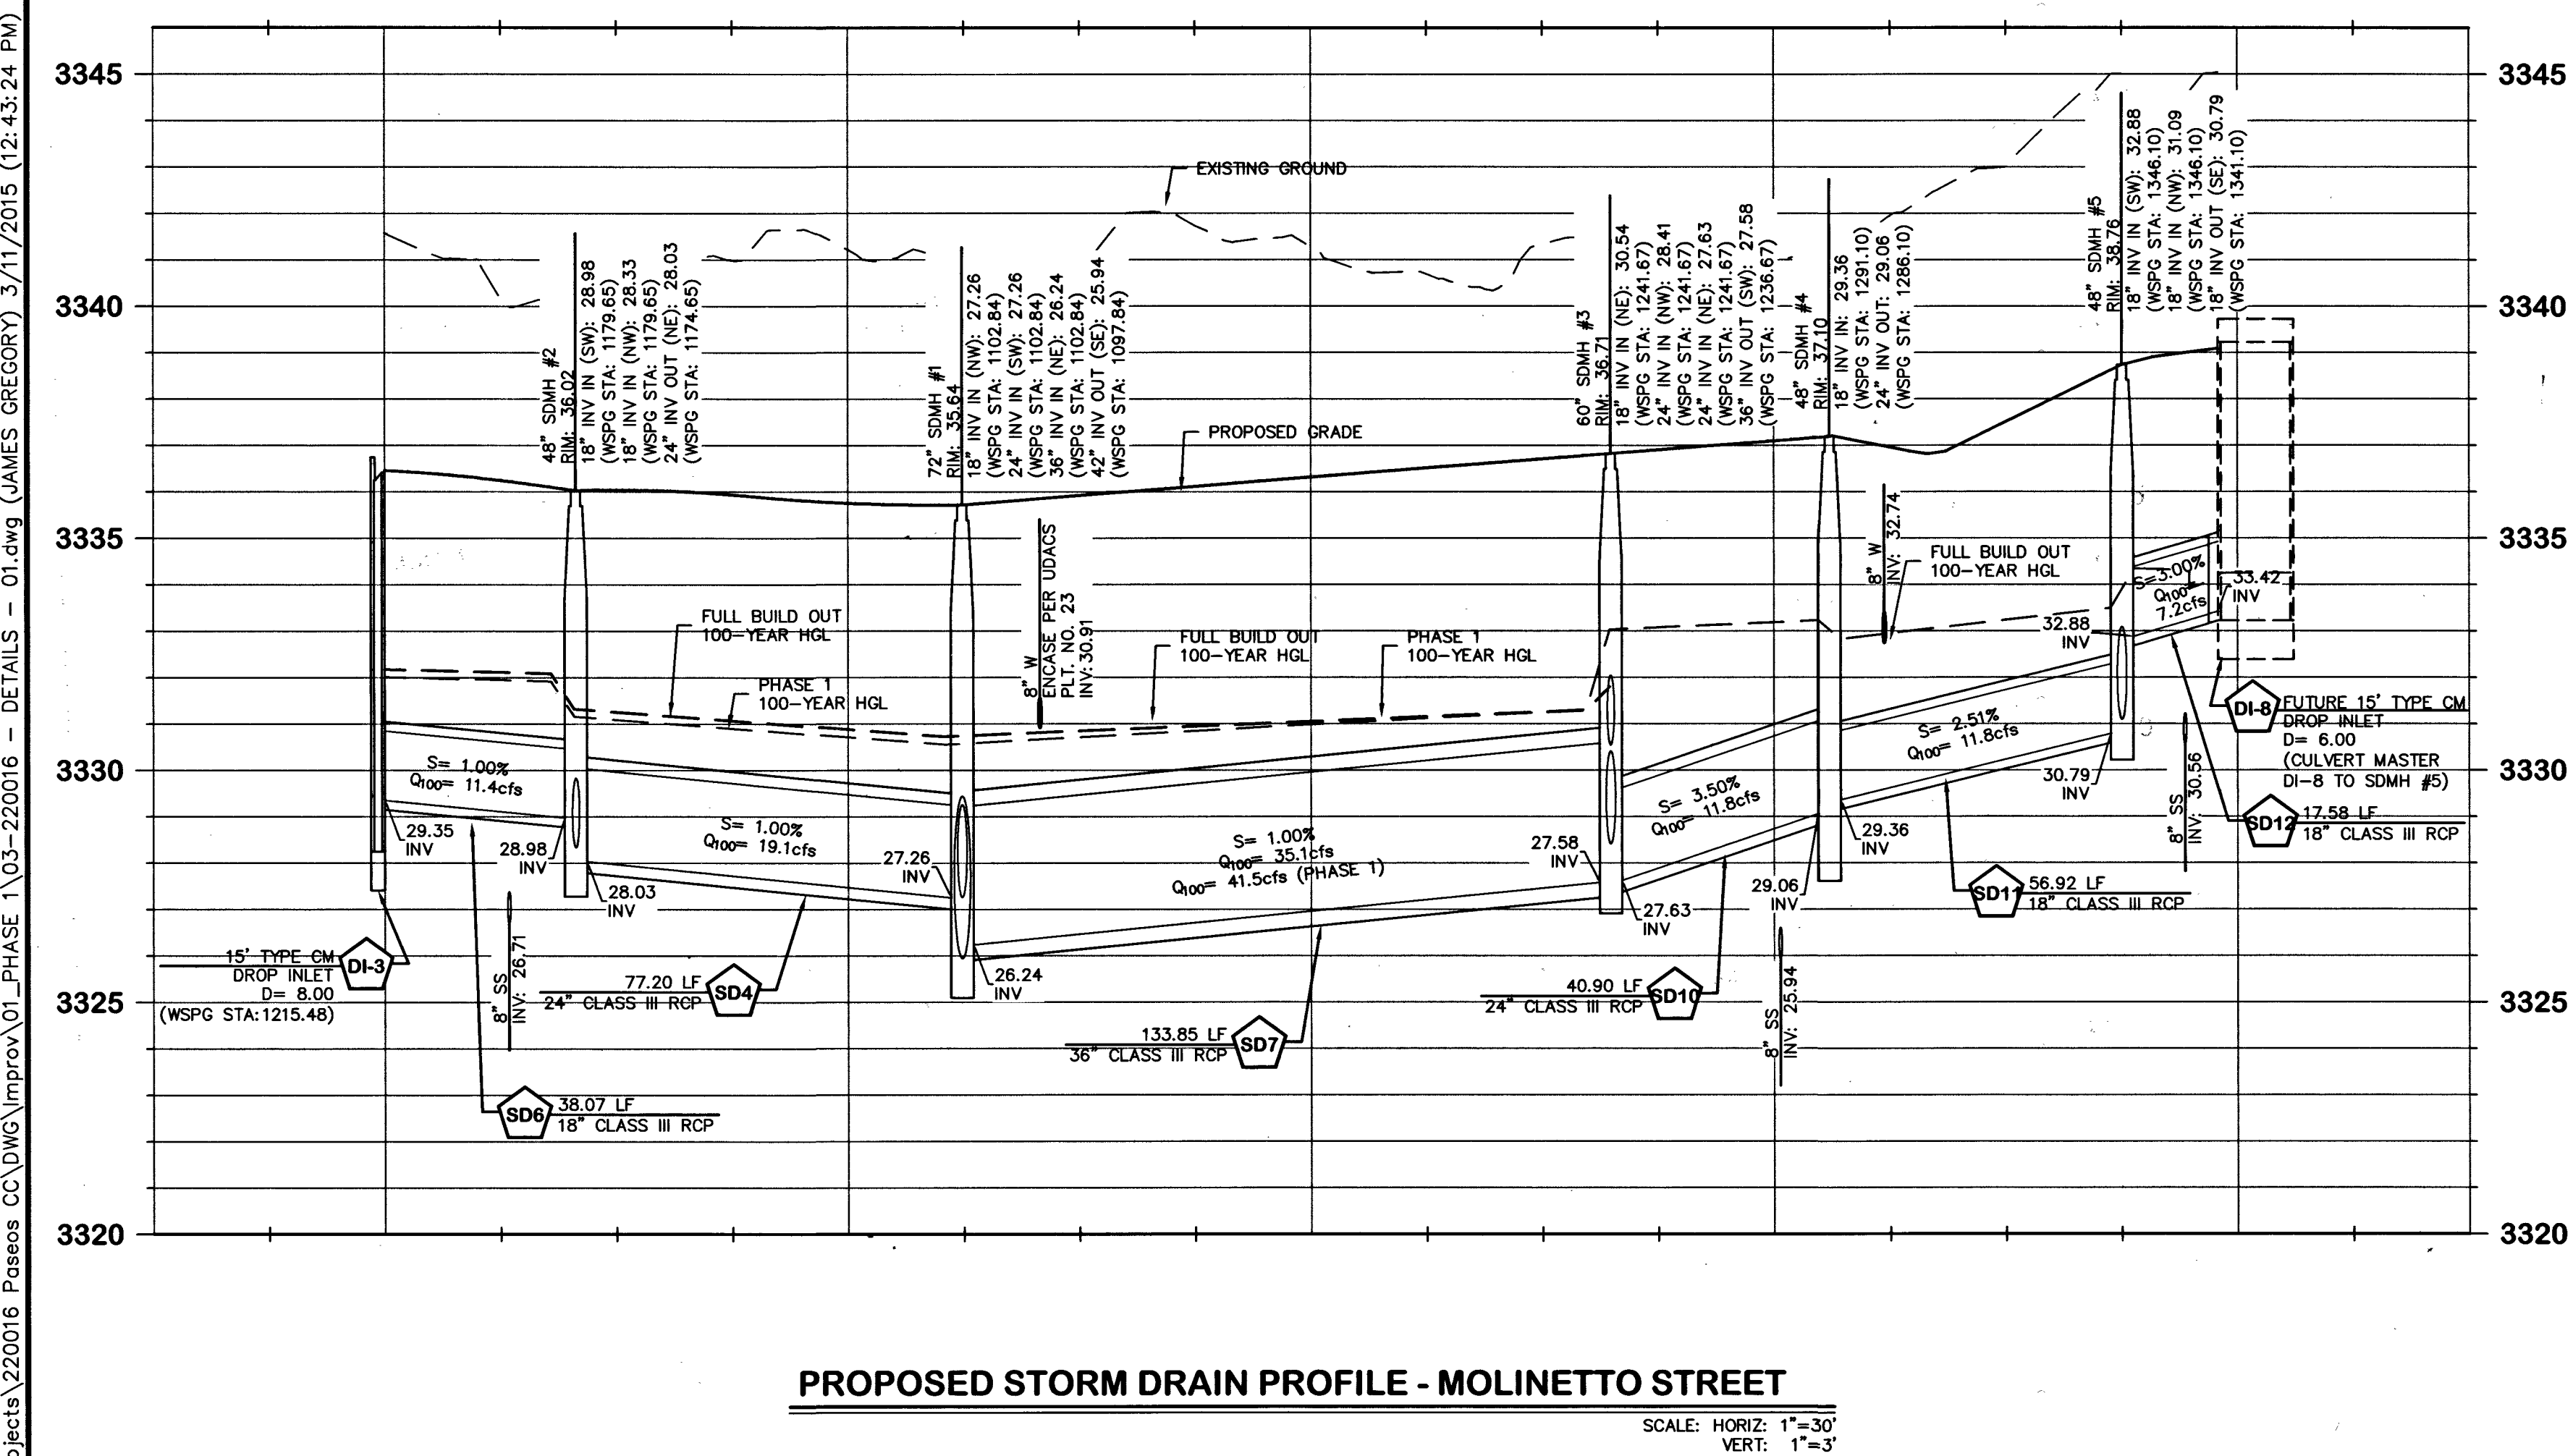
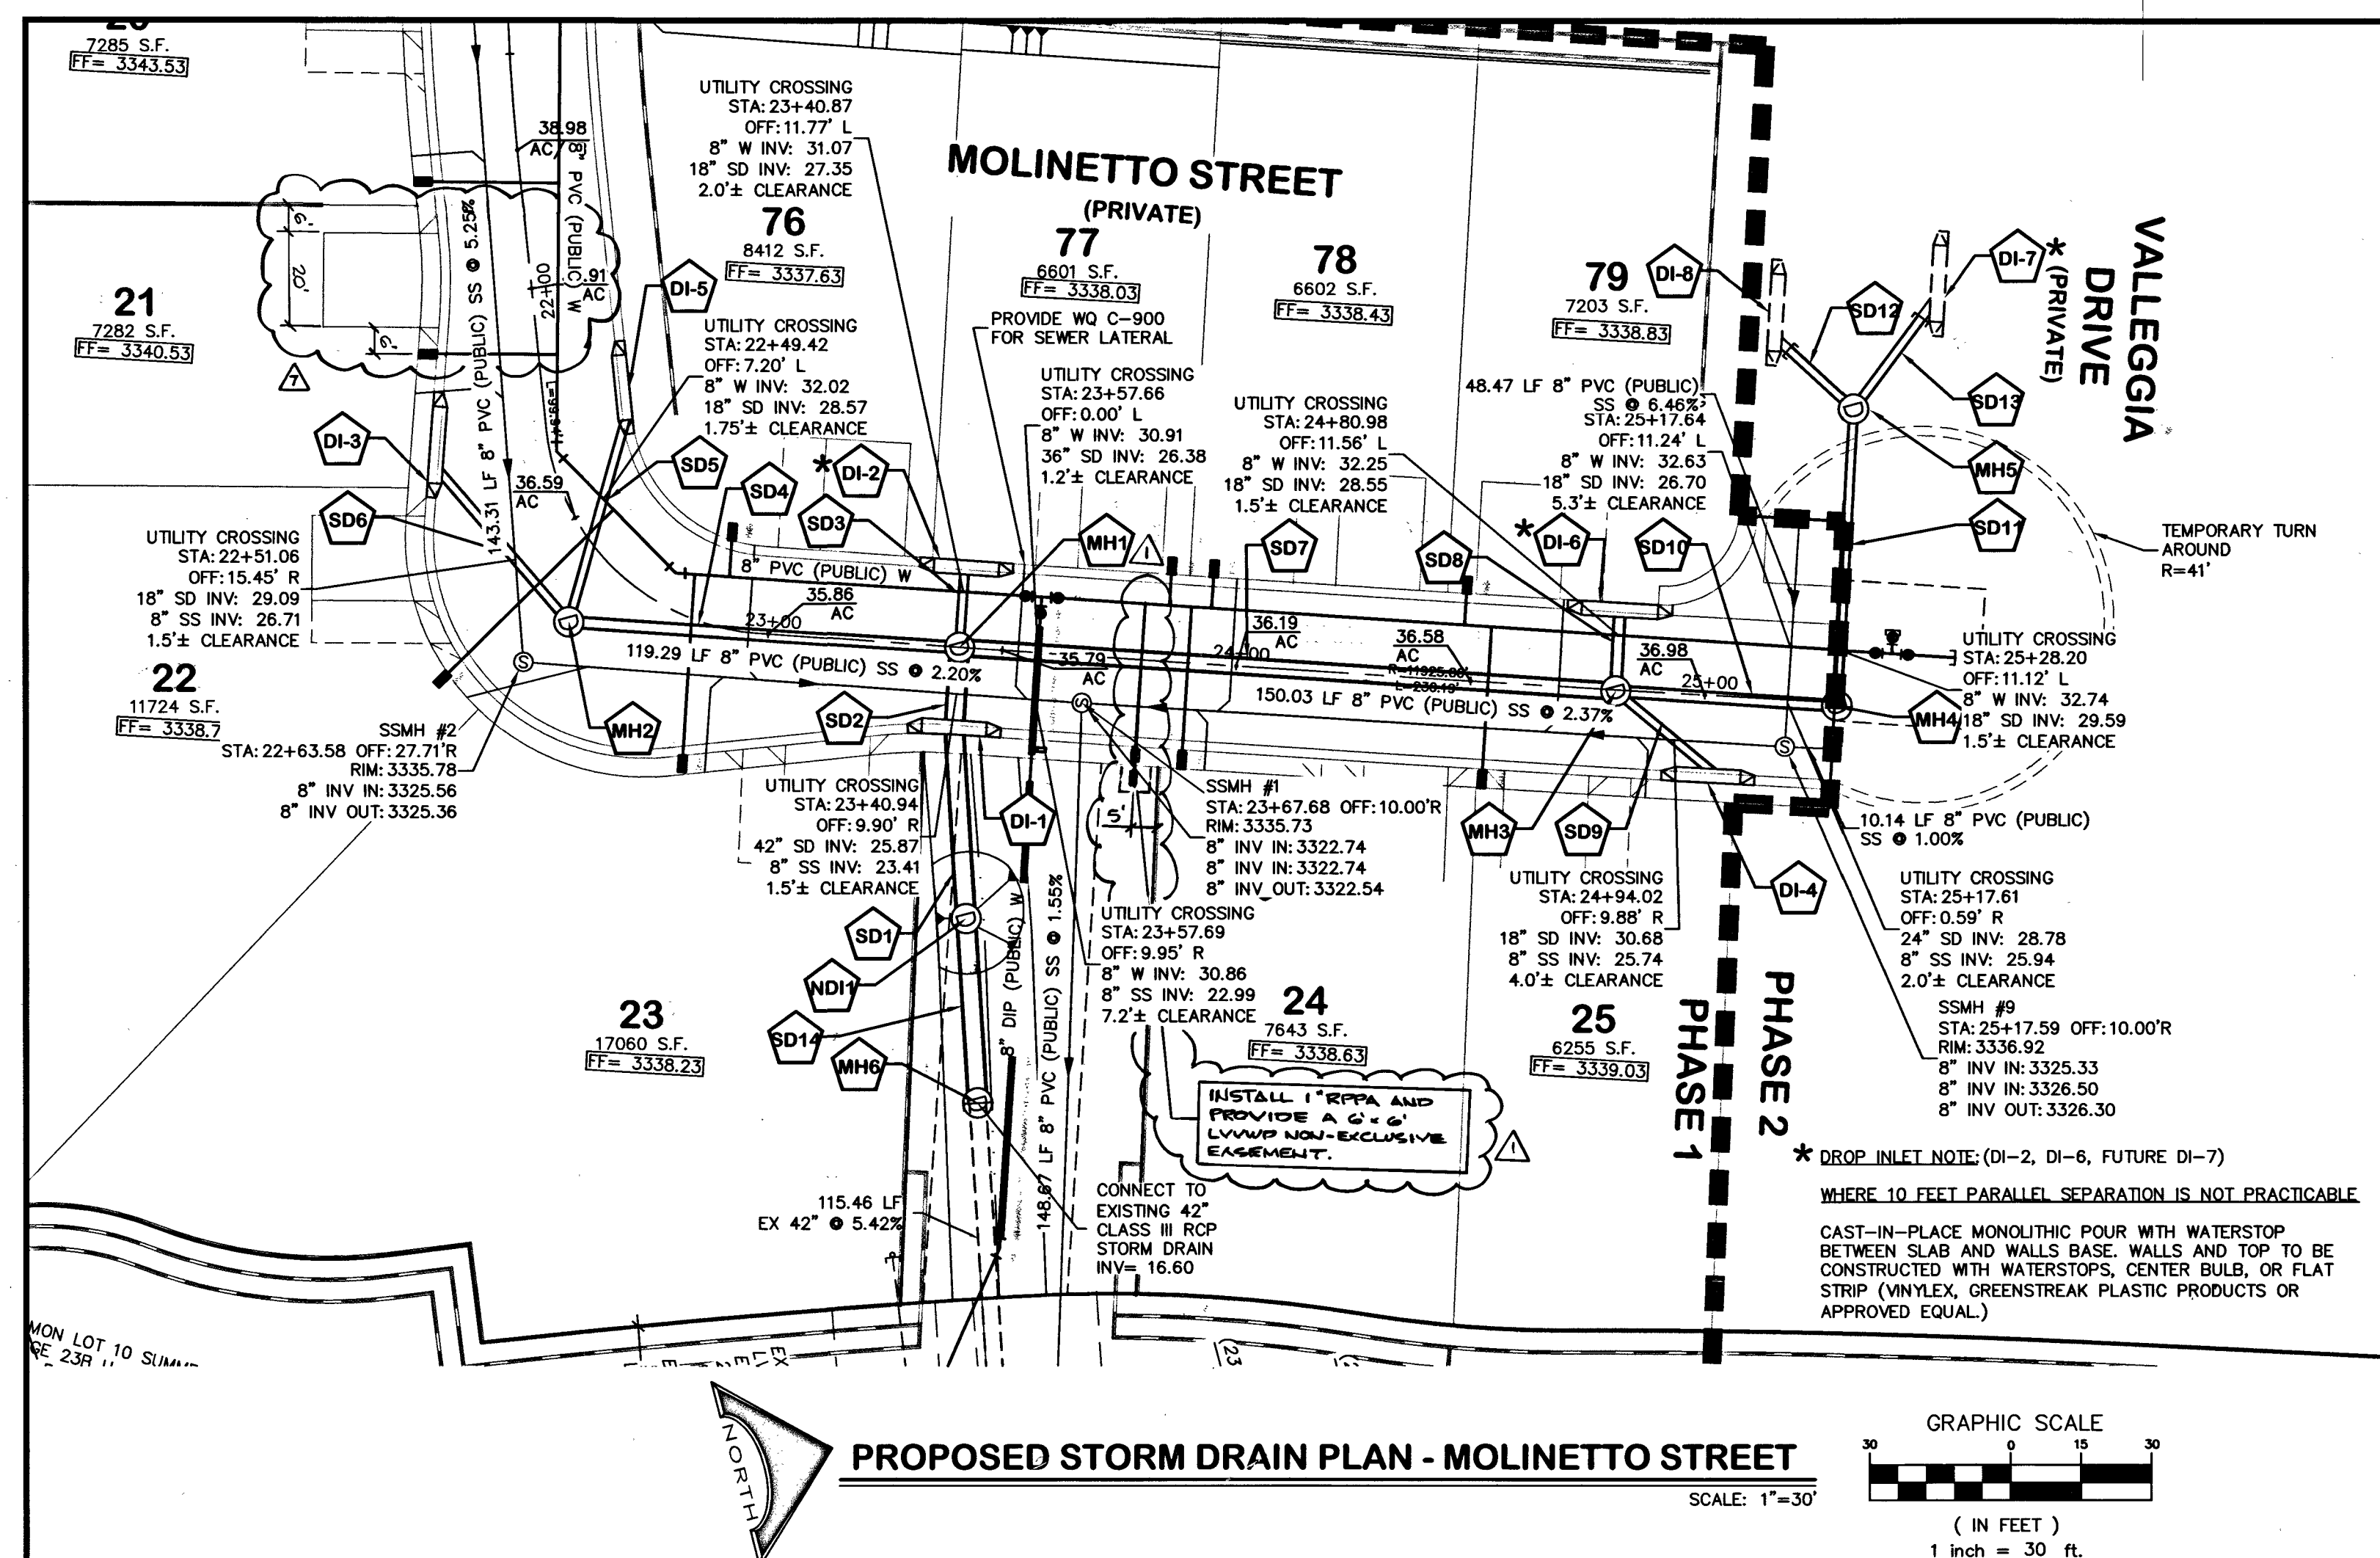
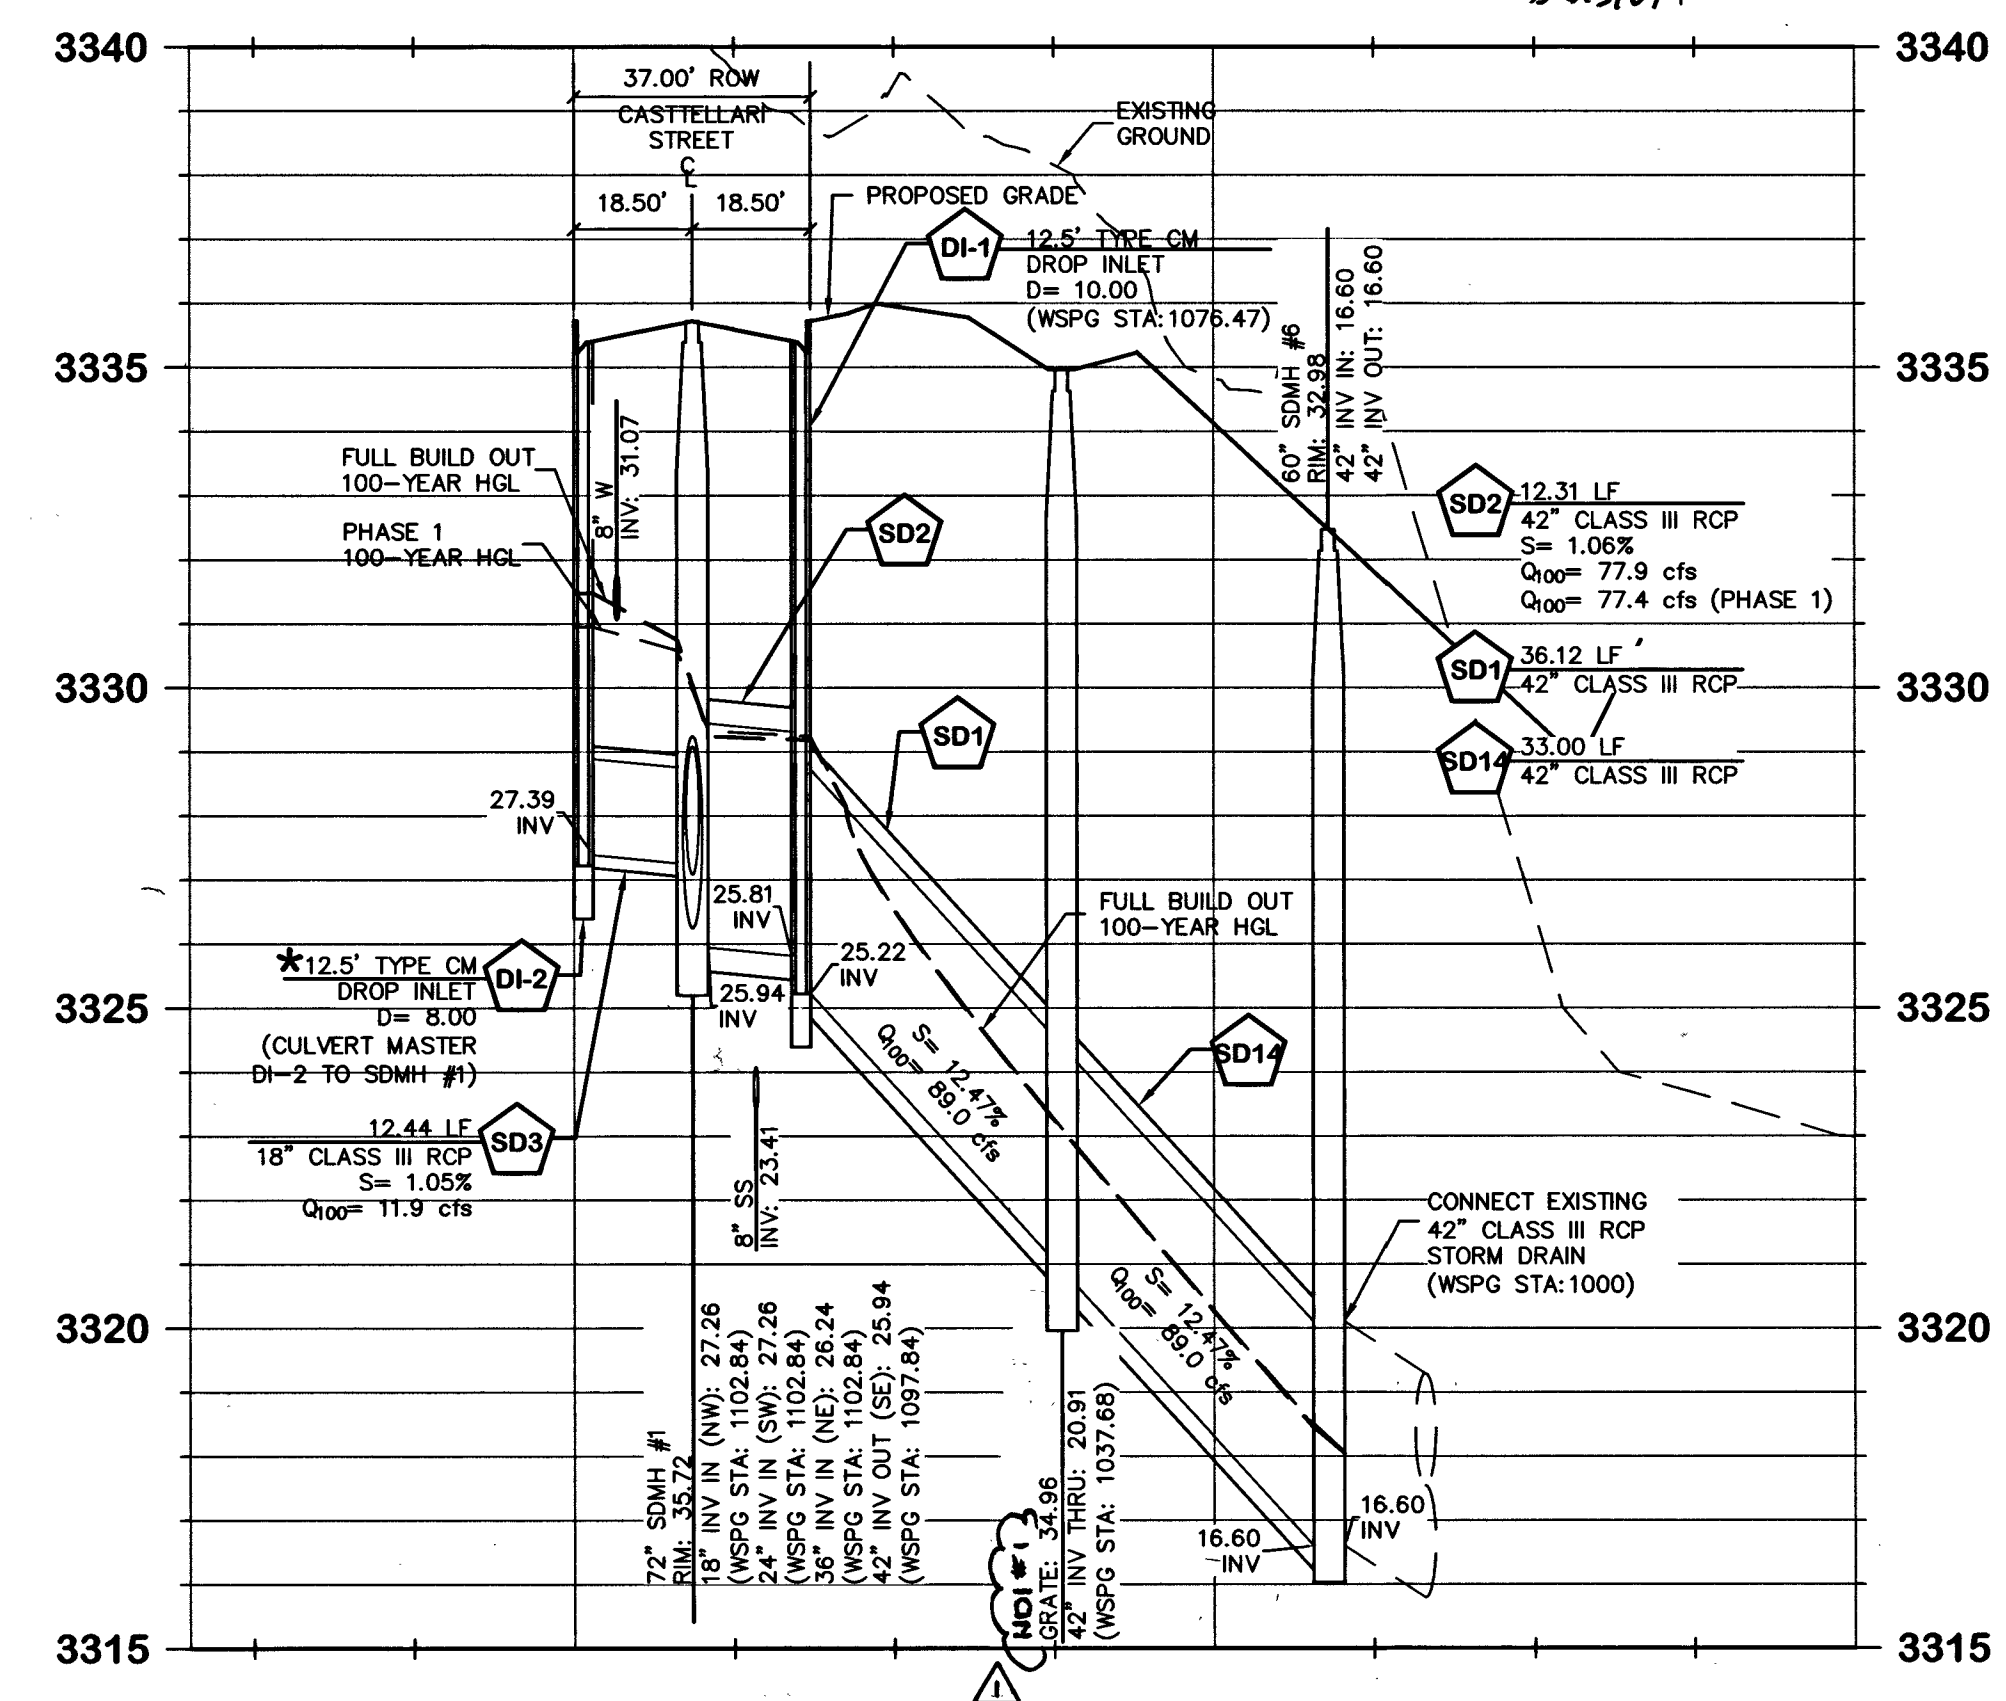



[illegible]

DISCLAIMER NOTE

UTILITY LOCATIONS SHOWN HEREON ARE APPROXIMATE ONLY. IT SHALL BE THE CONTRACTOR'S RESPONSIBILITY TO DETERMINE THE EXACT HORIZONTAL AND VERTICAL LOCATION OF ALL EXISTING UNDERGROUND AND OVERHEAD UTILITIES PRIOR TO COMMENCING CONSTRUCTION. NO REPRESENTATION IS MADE THAT ALL EXISTING UTILITIES ARE SHOWN HEREON. THE ENGINEER ASSUMES NO RESPONSIBILITY FOR UTILITIES NOT SHOWN OR UTILITIES NOT SHOWN IN THEIR PROPER LOCATION.

APPROVED FOR CONSTRUCTION

4, J. SHARP, FOR, J. J. J.
LAS VEGAS VALLEY WATER DISTRICT ENGINEERING SERVICE MANAGER
DATE 3/16/15 PROJECT NO. 123250

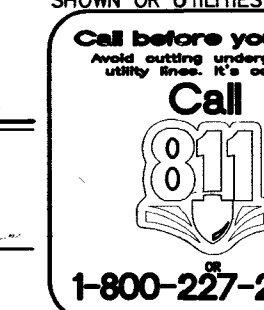

DETAIL SHEET 13

PHASE 1 - SAVONA AT SUMMERLIN
IMPROVEMENT PLANS
CITY OF LAS VEGAS
NEVADA

PROJ#:123250 AGR#: 115344 QS:137-27-SE XC 10937



Woodside Homes
BETTER BY DESIGN

L. R. NELSON CONSULTING ENGINEERS, INC.

6765 West Russell Road, Suite 200
Las Vegas, Nevada 89118

• STRUCTURAL
• CIVIL
• PLANNING
• SURVEY

(702) 798-7978
(702) 451-2296 FAX

NO.	REVISION	DATE	DATE	DATE
1	ADD COMMON ELEMENT WATER METER.	7/30/15	8-16-15	58
2	REVISE LOT 11 MANHOLE & INLET INFO.			
3	RELOCATE WATER METER & SHORTEN DRAIN WIDTH LOT 21.	7/27/16	7/27/16	64



Professional Engineer Seal of Nevada
 JON H. HAVELIN
 EIT 6/30/15
 CIVIL
 No. 12584