30-3-48

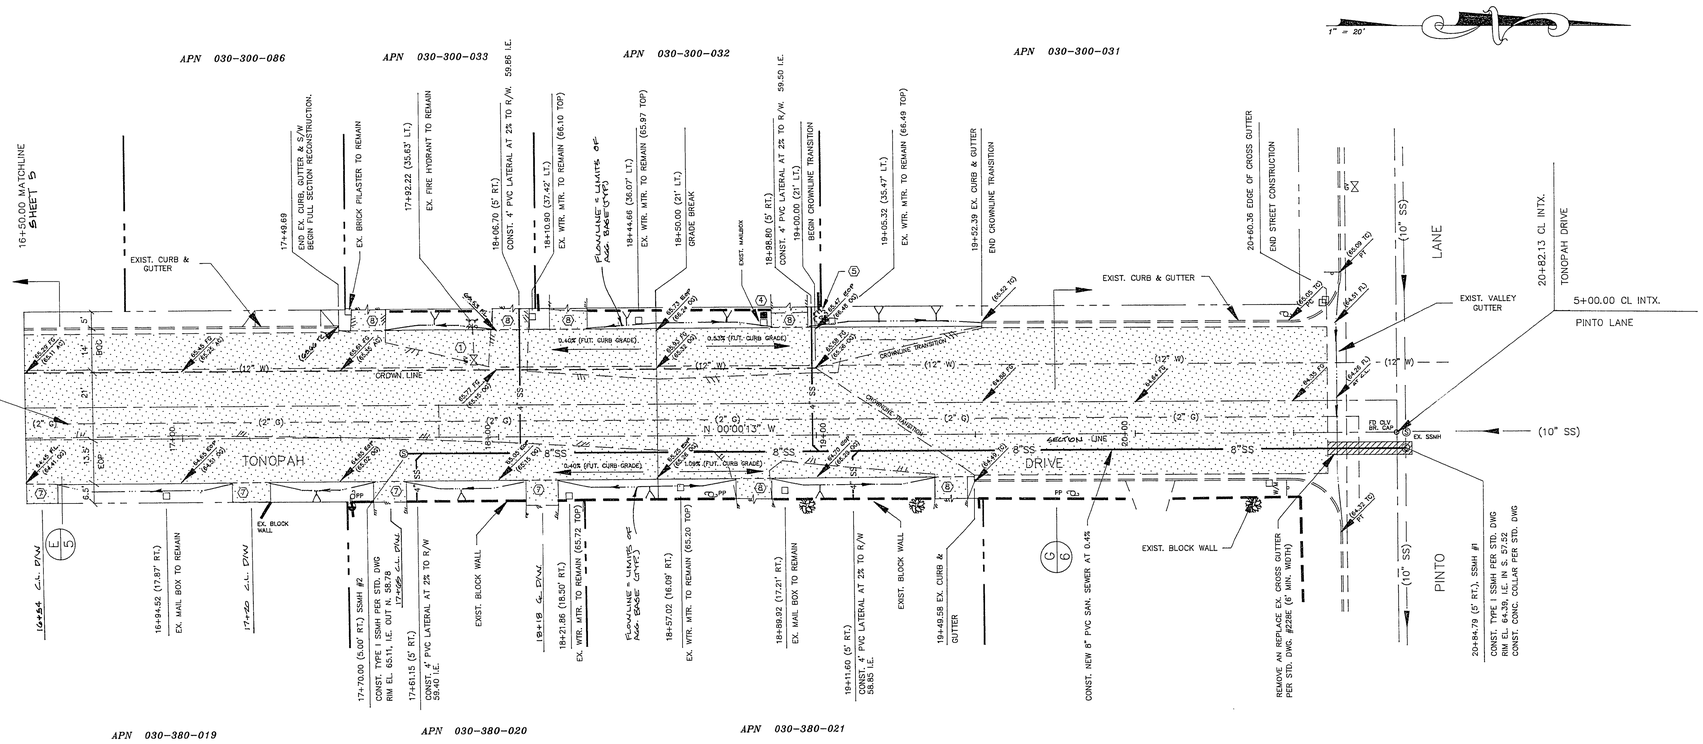

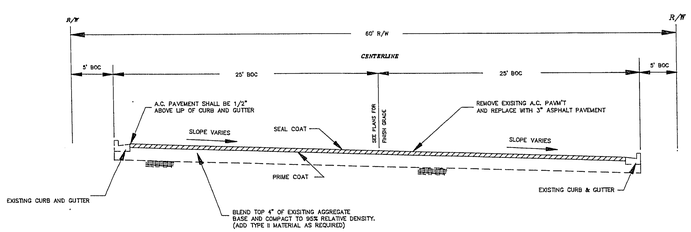

G/6 TYPICAL CROSS SECTION
TONOPAH DRIVE – STA 19+52.39 TO PINTO LANE

CONSTRUCTION NOTES

1. ADJUST VALVE BOX TO F.G. PER C.C.S.D #517.
2. ADJUST S.S.M.H. RIM TO F.G. CONST. NEW CONC. COLLAR PER C.C.S.D #408.
3. RELOCATE WATER METER PER L.V.V.W.D. STANDARD PLATES.
4. RELOCATE MAILBOX TO R/W LINE.
5. REMOVE TREE/SHRUB.
6. RELOCATE TRAFFIC SIGN PER CLV STD. DWGS. #404.1701 AND #404.1702.
7. CONST. 12' A.C. DRIVEWAY; 4½" A.C. ON 6" AGG. BASE. (MATCH EX. GRADE AT R/W)
8. SAWCUT EXIST. D/W AT R/W LINE AND REMOVE. CONST. A.C. DRIVEWAY TO EXIST. WIDTH. 2½" A.C. ON 6" AGG. BASE. (MATCH EX. GRADE AT R/W)

BID GROUP 1

TONO4.DWG

REVISIONS	DATE

W.A. # WU6662
SCALE (V) N/A
DATE AUGUST 1992
DESIGN BY CDN
SCALE (H) 1"=20'
RD. BK. # N/A

ENGINEERING DESIGN DIVISION
CITY ENGINEER: DENNIS ANDERSON, P.E.
SECTION CHIEF: BRIAN P. WALSH, P.E.
DESIGN ENGINEER: EDWARD C. NETTERSTROM, P.E.

12-2-92

DEPARTMENT OF PUBLIC WORKS

PROJECT: SAWTOOTH STREET IMPROVEMENTS
PHASES 2 AND 3
S.I.D. No. 1409

SHEET: TONOPAH DR. STREET PLAN
STA 16+50 TO PINTO LANE

CITY OF LAS VEGAS NEVADA

DRAWING NO. 107-V1994

6/16